

11/5/63

PERMIT

P 07652

A 06944

SEWAGE DISPOSAL SYSTEM

MARYLAND STATE DEPARTMENT OF HEALTH

HOWARD COUNTY

ELLICOTT CITY

INDEXED

DISTRICT 5

INDEXED

DATE 10/30/63

Elwood Scaggs

IS PERMITTED TO INSTALL ALTER

ADDRESS PHONE

A SEWAGE DISPOSAL SYSTEM LOCATED AT

11806 Wayneridges Street

SUBDIVISION Moorsefield ROAD Cherrytree Dr. LOT 1 A

PROPERTY OWNER Thomas Lacey

ADDRESS

SPECIFICATIONS

DRAIN FIELD DEPTH FEET, BOTTOM AREA SQ. FT.

SEEPAGE PITS ☒ ABSORBENT SIDE-WALL AREA 11' X 12' ^{deep} SQ. FT. below inlet. Locate inlet 3 ft. below original grade
SEPTIC TANK CAPACITY 750 GALLONS

FOR GARBAGE GRINDER, INCREASE DISPOSAL AREA 22% & TANK CAPACITY 50%.


OTHER Locate ~~inlet~~ system 75 ft. from rear lot line and 30 ft. from left lot line as seen when facing lot from Cherrfytree Dr.

PLANS APPROVED BY JEHennigan DATE 7/11/63

FILL SEPTIC TANK AND DISTRIBUTION BOX WITH WATER BEFORE CALLING FOR AN INSPECTION. COVER NO WORK UNTIL INSPECTED AND APPROVED.

NEITHER THE HOWARD COUNTY COMMISSIONERS NOR THE HEALTH DEPARTMENT IS RESPONSIBLE FOR THE SUCCESSFUL OPERATION OF ANY SYSTEM.

A 06944

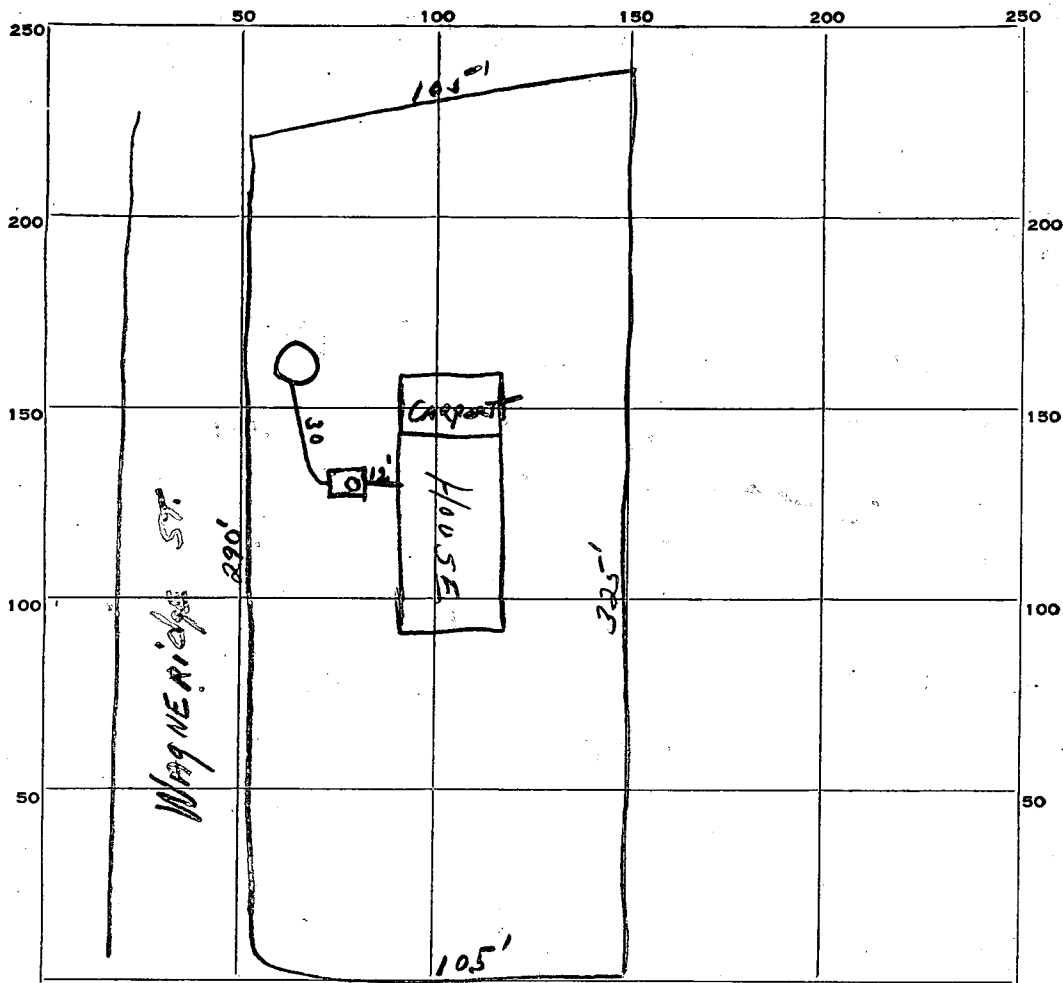

INDICATE NORTH. - NAME ADJOINING ROADWAY AS BASE LINE.

Cherry Tree Drive

PERMIT CARD yes

SEPTIC TANK, LEVEL 750 g.l. concrete

CLEANOUTS 8" stand pipe

DISTRIBUTION BOX, LEVEL none

TILE FIELD, DEPTH _____ FT. TRENCH WIDTH _____ FT.

GRAVEL DEPTH _____ IN. TOTAL LENGTH _____ FT.

NUMBER OF TRENCHES _____ TOTAL BOTTOM AREA _____

SEEPAGE PITS, INSIDE DIAMETER 14 FT. DEPTH BELOW INLET 9 1/2 FT.

ABSORBENT AREA _____ SQ. FT.

REMARKS _____

DATE SYSTEM APPROVED 11-5-63

INSPECTOR J. H. Horgan