


THOMAS E. MCGUNIGAL
L. 724 F. 578

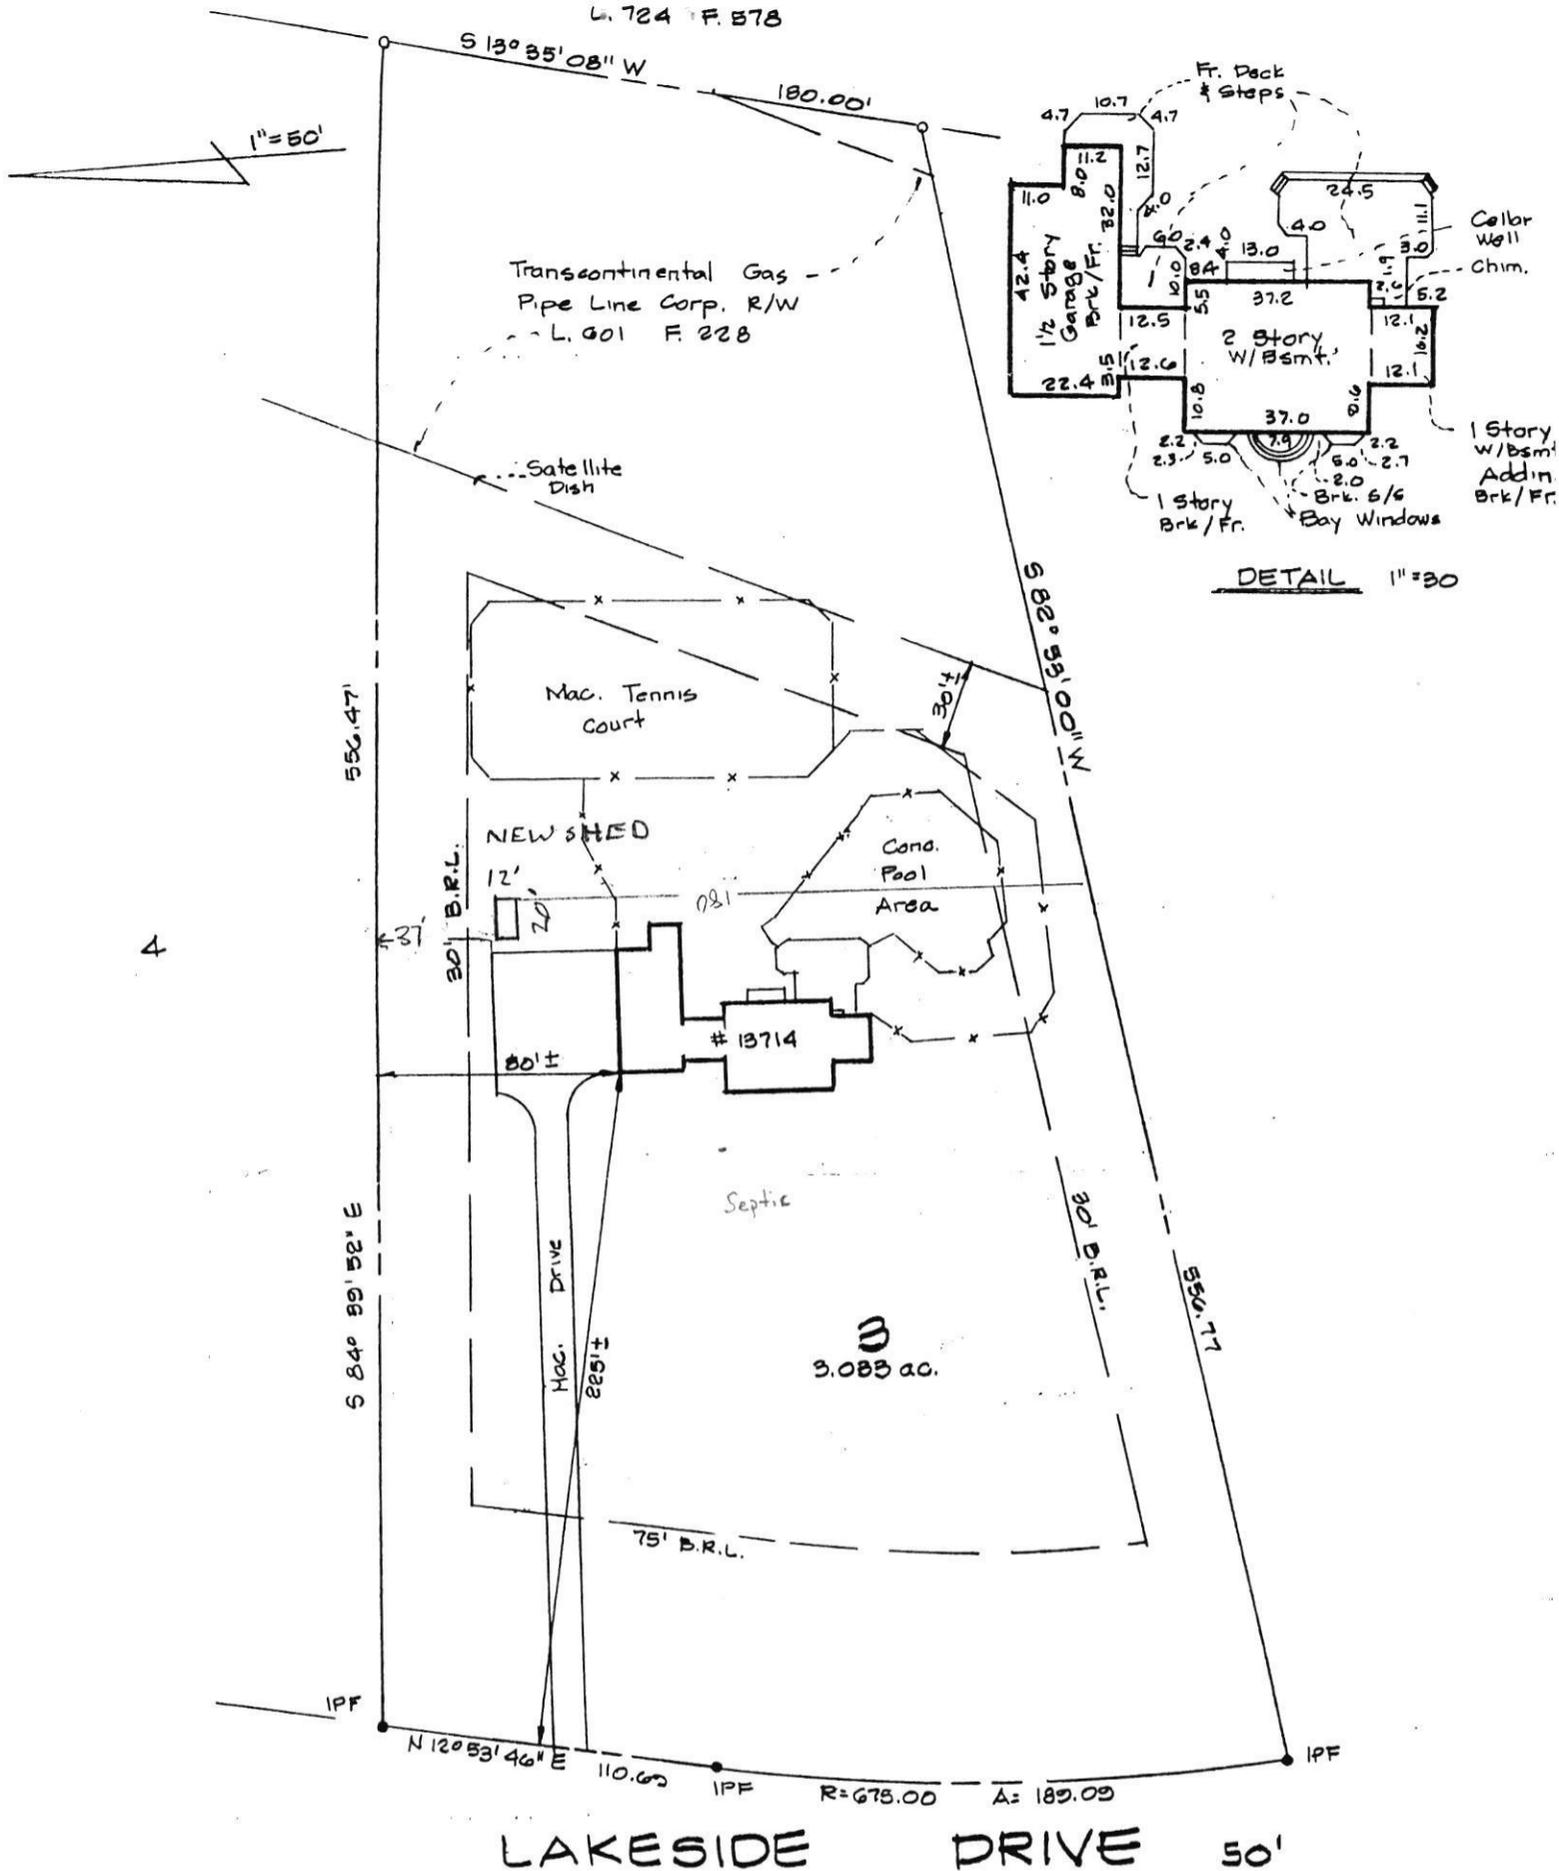

4

NOTES:

- Prepared without the benefit of a title report.
- Lot not in flood plain as per: 240044 0032B
- Not to be used for construction.
- Lot corners have not been set by this survey unless otherwise indicated.

<p>SURVEYOR'S CERTIFICATE</p> <p>I hereby certify that I have surveyed the property shown hereon for the purpose of locating the improvements only, and the improvements are located as shown. Except as otherwise noted, the corners have not been established and I assume no responsibility for any future changes or encroachments, or unrecorded, and appearing on the record or mentioned in the deed referred to hereon.</p> <p>JOHN KERWIN KEITH No. 10929 SURVEYOR</p> <p>Date: 1/22/92</p>		<p>HOUSE LOCATION SURVEY 13714 Lakeside Drive LOT 3 BLOCK - SECTION 1 Area One BRIGHTON PINES Clarksville ELECTION DISTRICT Howard COUNTY, MARYLAND</p>	
<p>PLAT BOOK CMP</p>	<p>DATE BY 1/23/92 JMK</p>	<p>SCALE 1" = 50'</p>	<p>DRAFTSMAN JCK</p>
<p>PLAT PAGE G011</p>	<p>CASE NUMBER 02100 E & R</p>	<p>DATE 1/23/92</p>	<p>BOOK NUMBER 2595 - 09</p>
<p>Light, Elliott & Associates, Inc. 8808 ADELPHI ROAD ADELPHI, MARYLAND 20783 Telephone 422-8080 Fax 422-6006</p>		<p>953 CHANDLER COURT WALDORF, MARYLAND 20687 Telephone 843-4922 Fax 843-4922</p>	
<p>FILE NUMBER L 0986</p>		<p>FILE NUMBER MB 0216</p>	