

Name: David Edmonds/Atlantic Pools, Inc.  
Street Address: PO Box 148  
City, State, Zip: Mt. Airy, MD 21771  
Date: 07/19/22

**Amendment, Permit #** B22001607

Ms. Debbie Whalen  
Division of Plan Review  
Department of Inspections, Licenses and Permits  
Howard County Government  
3430 Court House Drive  
Ellicott City, MD 21043

*Approved R1E  
8/2/2022*

*Online permit*

Dear Ms. Whalen:

I am requesting to amend **Permit #** B22001607 **at**  
3609 Broadleaf Court, Glenwood, MD 21738 **to**  
shift pool location from originally submitted drawings to new location which falls in better  
proximity to previously permitted/approved pool house per updated pool location drawing  
provided. Pool house will be a future project, not completed at the time of pool construction  
and completed at later date by owner. The new location drawing was provided to George  
Martin, who had ran past zoning, and no issues were seen with the new location.

**Enclosed:**

- Fee: 25.00
- Plot Plans
- Sets of Construction Drawings
- Other: \_\_\_\_\_

If there is anything we can do to assist you, please let me know.

Sincerely,  
David Edmonds

**REVISED**

Name: David Edmonds  
Title: President  
Phone: 443-812-0168  
Email: dedmonds@atlanticpools.net


Date: \_\_\_\_\_  
Comments: \_\_\_\_\_

Comments: Relocate Pool


Date: 7-29-2022

REVISED

ADMENDMENT REQUEST

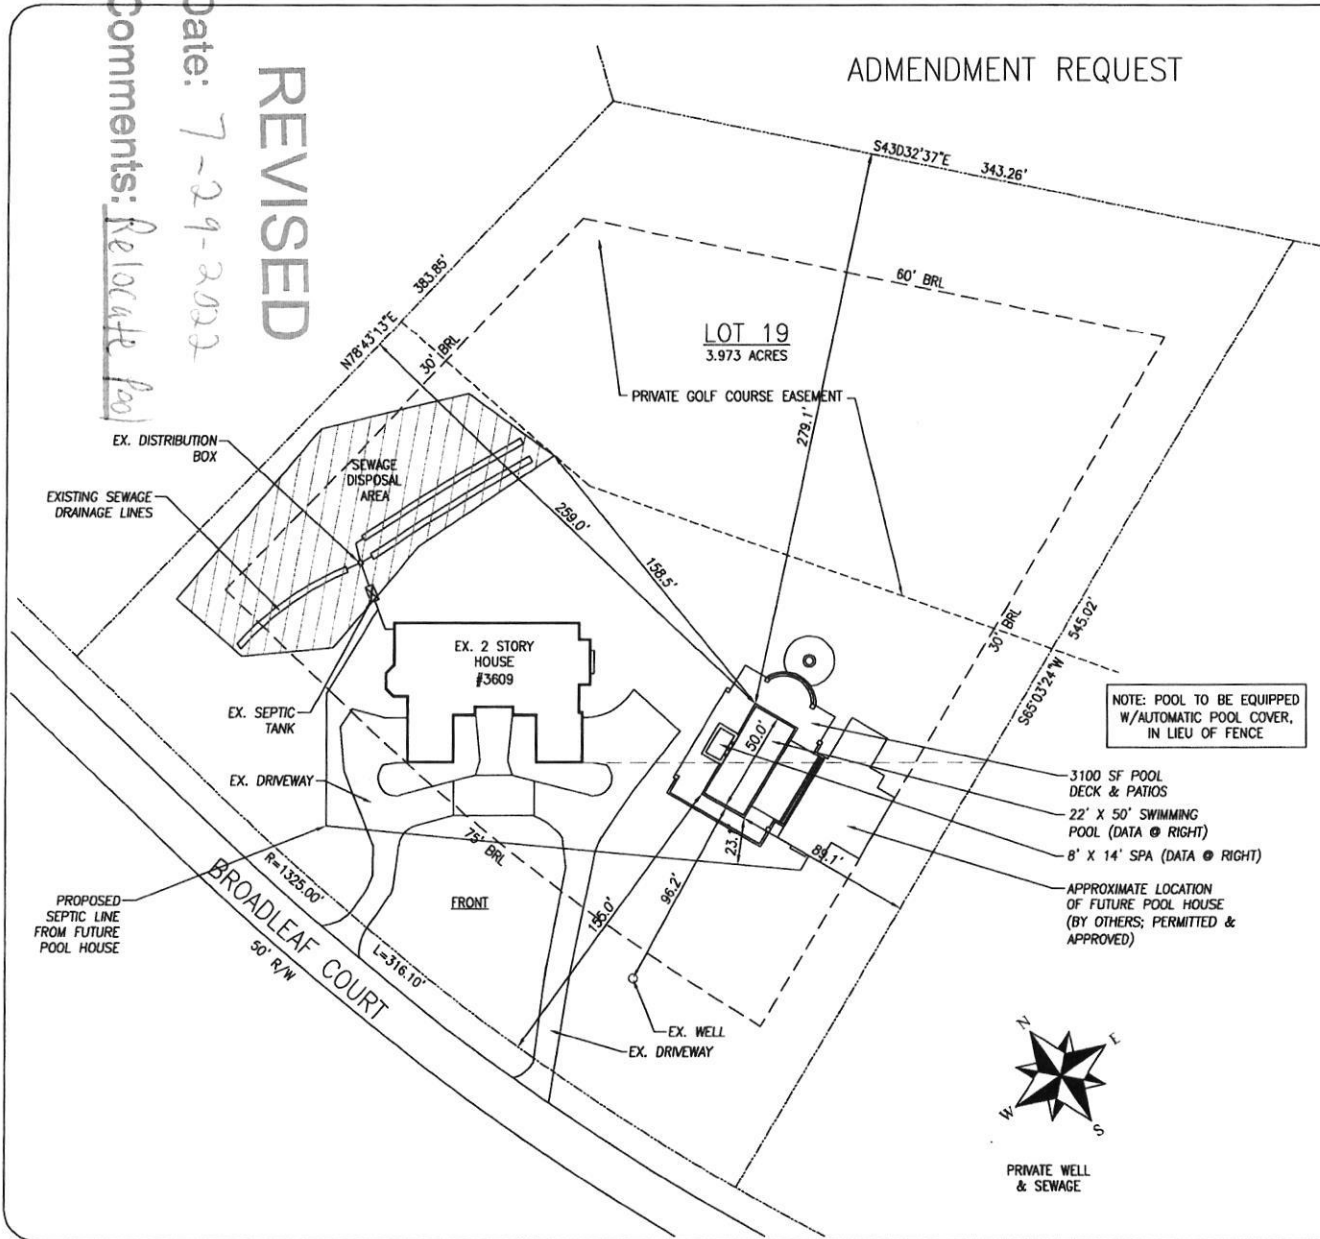

VICINITY MAP

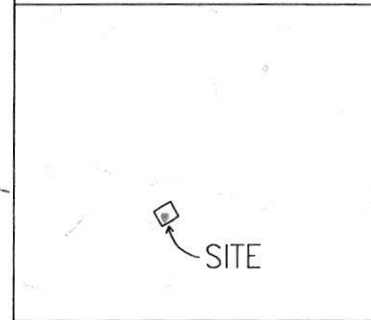

DIRECTIONS TO SITE

I-70 WEST TO EXIT ONTO 1-87 SOUTH. GO APPROXIMATELY 4 MILES TO A L/T ON SYCAMORE VALLEY RUN. FOLLOW TO 1ST L/T ONTO BROADLEAF COURT. GO TO SITE AT ON LEFT. 3609 BROADLEAF COURT.

POOL DATA

DIMENSIONS	22'-0" X 50'-0" RECT.
PERIMETER	154 Ln.Ft.
SURFACE AREA	1100 Sq.Ft.
GALLONAGE	43,375 Gallons
DEPTHS	3'-6" TO 5'-0" TO 8'-0"
FILTER RATE	91 GPM
TURNOVER TIME	8 HOURS
POOL DECK AREA	3100 Sq.Ft.

JOB NOTES

PROPERTY OWNER: PETER & CARRON LAKE  
 PROPERTY OWNER ADDRESS: 3609 BROADLEAF COURT  
 GLENWOOD, MD 21738  
 HOME PHONE: 410-303-4672 (PETER)  
 OFFICE PHONE: ptootejr@fescosales.com  
 CELL PHONE:  
 LOT NUMBER: LOT 19  
 SUBDIVISION NAME: CATAUL CREEK  
 TAX MAP: TAX MAP 21  
 GRID & PARCEL: GRID 9, PARCEL 6  
 TAX ACCOUNT NUMBER: 351096  
 ELECTION DISTRICT: 4  
 ZONING:  
 UTILITIES: PRIVATE WELL & PRIVATE SEWAGE

SITE PLAN

REVISIONS

7/12/22



P.O. Box 148 - Mt. Airy, Maryland 21771  
 Office: 301-829-4004 Fax: 301-829-4770  
 Toll Free: 866-757-POOL  
 www.atlantispools.com

**Laake Residence**  
 3609 Broadleaf Court  
 Glenwood, Maryland 21738  
 4th Election District, Howard County

Date: 4/23/2022

Scale: 1"=60'

Drawn:

Job: ATL2022-0154

Sheet: Of:

1 1