

Record Detail (This section is required.)

Permit Type Building/Residential/Mech/Add Alt Permit Number M24001269 Opened Date 11/08/2024
Description of Work REPLACE EXISTING HVAC SYSTEM WITH A GEOTHERMAL SYSTEM USING (1) WATERFURNACE W5AV048 4-TON SYSTEM USING HORIZONTAL GEOTHERMAL LOOPS AND EXISTING DUCTWORK

Approved
12/10/2024
SP

check spelling

Address (This section is required.)

Search Reset Clear Get Parcel & Owner
Street # 5424 Street Name HARRIS FARM Street Type LN
Unit Type --Select-- Unit # X Coordinate -76.97725 Y Coordinate 39.22362
City CLARKSVILLE State MD Zip Code 21029 Primary Yes

Parcel (This section is required.)

Search Reset Clear Get Address & Owner
GIS ID 915687 Parcel 216 Parcel Area 2.46 Land Value 124600 Improved Value 554900 Exemption Value 191990 Plan Area RURAL
Legal Description P/O PAR 19 2.461 A []5424 HARRIS FARM LN []CLARKSVILLE

check spelling

Block Lot P 19 Census Tract 605101 Council Dist 5 Inspection Dist Supervisor Dist Map # DAP Zone
Plan Area State Tax Id 1405371503 Subdivision Name
Section Area Tax Map 28
Grid Zoning District RR-DEO ADC Map 4933-D5
SDP No. Final Plan No. WP File No.
Record Plat No. WS Contract No. FDP No. Primary Yes
Owner Occupied Year Built 1985 Historic District
Historic District Registry No. Stat Area 5-04A Flood Plain
Building No

Owner (This section is required.)

Search Reset Clear

Name HOSHI
Address Line 1 5424 HARRIS FARM LN
Address Line 2
Address Line 3
Mail City CLARKSVILLE
Mail State MD
Mail Zip Code 21029
Phone 443-610-8498
Primary Yes
E-mail

▼

Cell Number Fax Number

Professionals (This section is required.)

License #
05010006539

License Type
HVACR

Primary
Yes

Business Name
GROUND LOOP HEATING & AIR CONDITIONING, INC

First Name **Middle Name** **Last Name**
▼ MICHAEL E CULLUM

Address Line 1
▼ 1701 WHITEFORD RD

Address Line 2

City **State** **ZIP Code**
DARLINGTON MD 21034-0000

Phone 1 **Phone 2** **Fax**
4108361706 4104570581

E-mail
MIKE@GROUNDLOOP.COM

Applicant (This section is not required.)

Search **As Owner** **As Lic. Prof** **As Contact**

Type
Applicant

Relationship
Applicant

Primary
Yes

First Name **MI** **Last Name**
MICHAEL E CULLUM

Full Name
▼

Organization Name
GROUND LOOP HEATING & AIR CONDITIONING, INC

Street Address
1701 WHITEFORD RD

Address Line 2

City **State** **Zip Code**
DARLINGTON MD 21034-0000

Phone **Cell** **Fax**
4108361706 4104570581


E-mail
MIKE@GROUNDLOOP.COM

HVAC INFORMATION

HVAC INFORMATION

Capital Project-No Fee <input type="radio"/> Yes <input checked="" type="radio"/> No	Capital Project Number	Fee Exempt (Text) <input type="radio"/> Yes <input checked="" type="radio"/> No	Building Permit No N/A	Existing Use (Text) SFD	Geothermal ▼ <input checked="" type="radio"/> Yes <input type="radio"/>
Number of Zones 1	Number of MF Units ZONES (Number) 0	HVACR System UNITS (Number) Heating and Air Conditioning	Water Supply ▼ Private ▼	Sewage Disposal Private	Expiration Date ▼ 5/18/2025

Submit **Cancel**

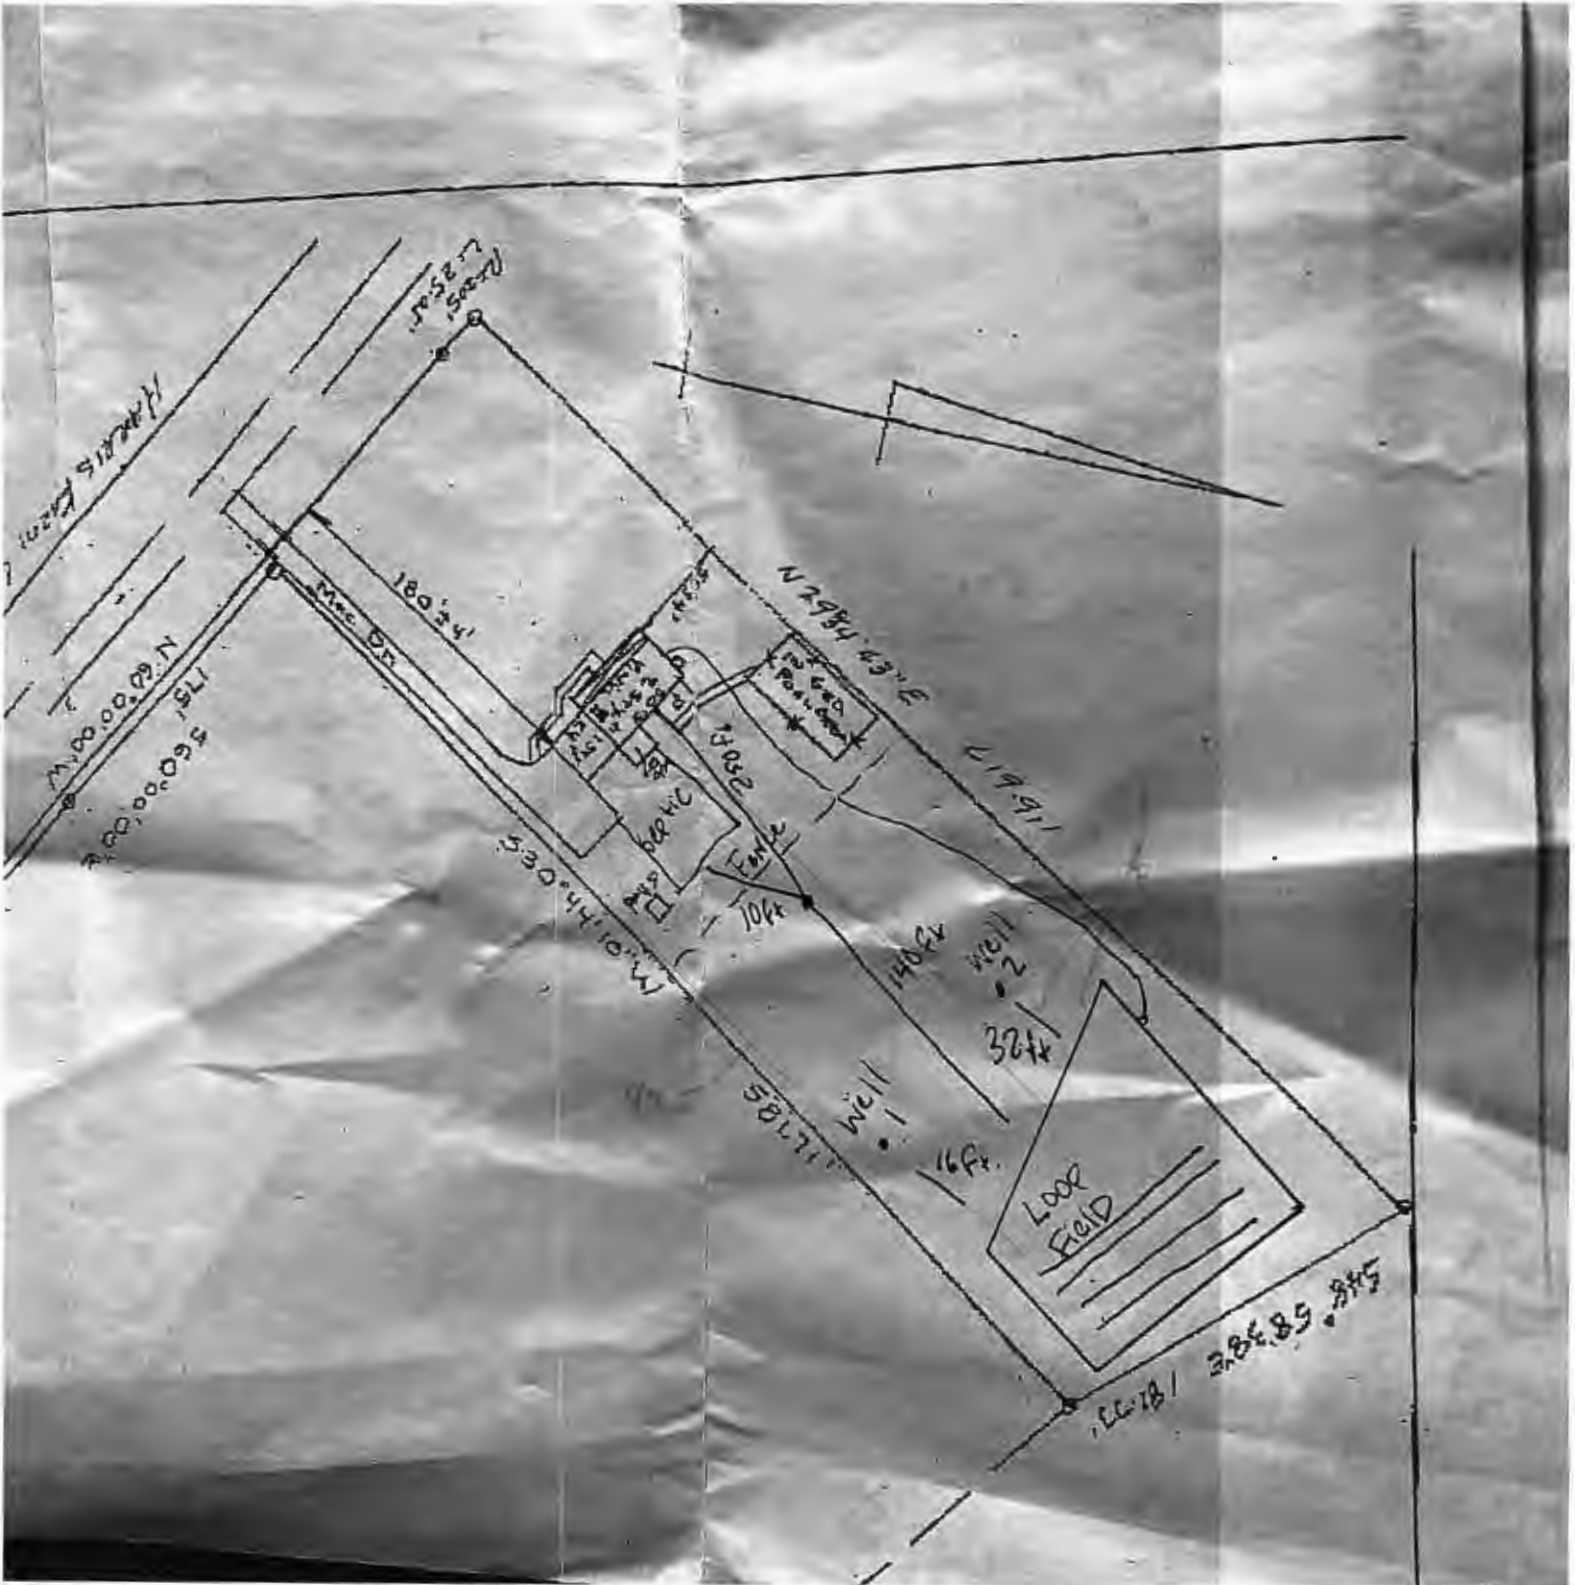

11/26/2024
 Loop Field needs to be moved.
 Field > 20' from portable wells. SP

Disapproved / Needs revisions

Horizontal Geothermal Field

M24001269

Approved

12/10/2024

(SP)

