05-407559 PERMIT

DISTRICT 5th

44624

34972

MARYLAND STATE DEPARTMENT OF HEALTH

HOWARD COUNTY

BUREAU OF ENVIRONMENTAL HEALTH 461-9933


INDEXED

DATE 6/30/89

Jack Fyock	IS PERMITTED TO INSTALL X ALTER
ADDRESS	PHONE 988-9270
SUBDIVISION Waterford	ROAD 12926 Wexford Park LOT 15
PROPERTY OWNER	Werner Henrich
ADDRESS	
F GARBAGE GRINDER IS USED INCREASE SEPTIC TANK CAP	PACITY BY 50% AND ABSORPTION AREA BY 22%
GARBAGE GRINDER? YES X NO NO	
SEPTIC TANK CAPACITY 1500 GALLONS N	UMBER OF BEDROOMS
THIEL 4 TEEL DELOW ORIGINS	ith garbage disposal. Trench to be 3 feet wide. al grade. Bottom maximum depth 6 feet below origins at 4 feet below original grade. 2 feet of s
LOCATION - Starting from the right re	ear (295,40'\\\420.00') lot corper place the
distribution box 245 feet the same lot line as seen	down the rear (420.00°) lot line and 145 feet of when facing the lot from Wexford Park. Run tren
On contour toward the right	nt and front of lot.
and cap to grade or above	on septic tank. or low
LANS APPROVED BYSid Abel	
OVER NO WORK UNTIL INSPECTED AND APPROVED	DATE
EITHER THE HOWARD COUNTY COUNCIL NOR THE HEALTH DEPARTMENT	IS RESPONSIBLE FOR THE SUCCESSFUL OPERATION OF ANY SYSTEM
DTE. CLEANOUT REQUIRED EVERY 70 FEET OF SEWER LINE AND/OR AT	90° SWEEPS IN LINES FROM HOUSE TO DRAIN FIELDS
OTE: ALL PARTS OF SEPTIC SYSTEMS (I.E., TANK, DISTRIBUTION BOX, TREE	NCHES) TO BE 100 FEET FROM WELL (UNLESS OTHERWISE SPECIFICALLY AUTHORIZED)
DTE: IF DEEP TRENCHIES) ARE USED CALL FOR INSPECTION BEFORE AN	ND AFTER PLACING GRAVEL IN TRENCHIES)
OTE: NO DRY WELL SHALL EXCEED 15 FOOT IN DIAMETER NO ABSURPT	
TE: ALL PIPE FROM HOUSE TO SEPTIC TANK MUST BE CAST IRON OR S	
RMIT VOID AFTER TWO YEARS	
OTE: INSTALL STAND PIPE ON SEPTIC TANK AND DRY WELL STAND PIPES ACCEPTED. IF TOP OF SEPTIC TANK IS DEEPER THAN 3 FEET, MANI	S MUST BE 6 INCHES IN DIAMETER. CAST IRON. CONCRETE OR TERRA COTTA OR PVC OR ABS
DTE DISTRIBUTION BOXES MUST HAVE BAFFLES	

*INSTALLER IS RESPONSIBLE FOR OBTAINING FINAL APROVAL ON THIS PERMIT

*CALL 461-9933 FOR INSPECTION OF SEPTIC SYSTEMS.

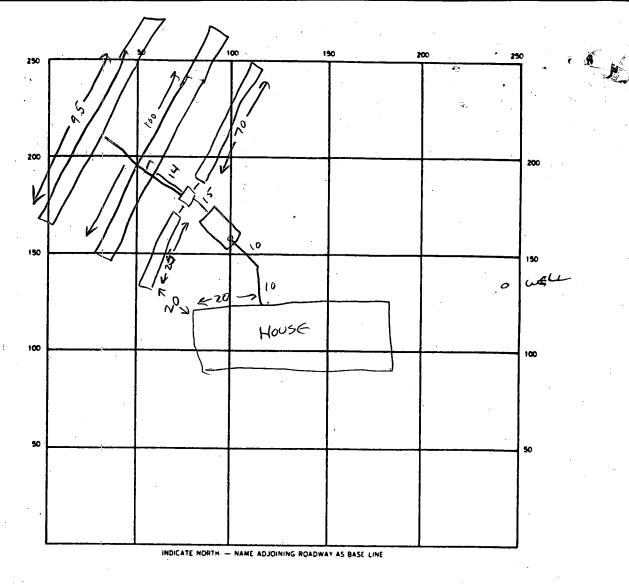

	BOX LEVEL			CLEANOUTS ST			,
					INLET DEPTH	<u></u> 打.	293 × 3
ERFECTIVE GR	RAVEL DEPTH	₂ 9	FT. TOTAL B+1∞+9·7 ONE SU		FT FT	SO FT	879
	ARSOPRENT	ADEA 879	7	•	CWILLI		
							
:							
DATE SYSTEM	APPROVED	1278		INSPECTOR	CWillian	~	