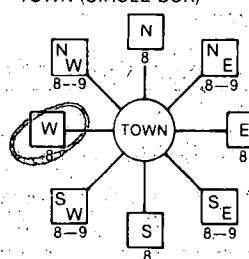
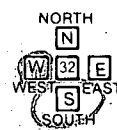
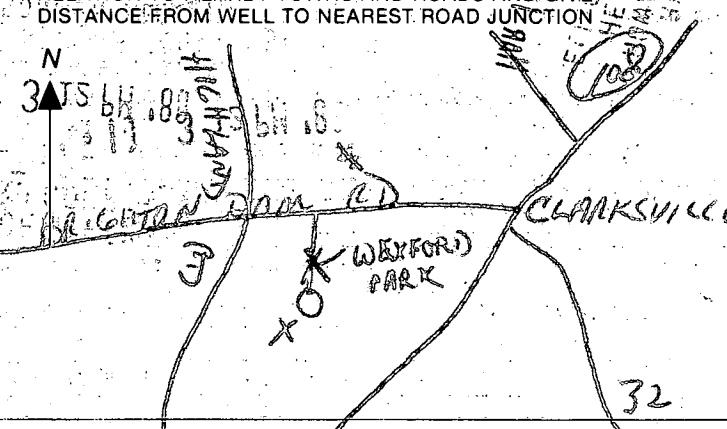


B 1 6968 (THIS NUMBER IS TO BE PUNCHED IN COLS. 3-6 ON ALL CARDS)	SEQUENCE NO. (DP USE ONLY)	STATE OF MARYLAND PERMIT TO DRILL WELL please print or type	STATE PERMIT NUMBER HO-81-2646 fill in this form completely
Date Received (APA) 4/18/88 10130 032388 OWNER INFORMATION WERNER, Werner 15 Last Name 13 Owner 34 First Name 5083 Whitestone Rd 36 Street or RFD 55 Columbia 0091044 57 Town 70 State 72 Zip 76		B 3 LOCATION OF WELL Howard 8 COUNTY 21 WATERFORD 23 SUBDIVISION 42 SECTION 2 LOT 15 44 46 48 50 CLARKSVILLE 52 NEAREST TOWN 71 MILES FROM TOWN (enter 0 if in town) 2 MI 73 75 76 78	
DRILLER INFORMATION George F. Easterday 40 77 License No. 80 Driller's Name L. Franklin Easterday, Inc. 9255 Brown Church Rd., Mt. Airy, Md. 21771 Address George F. Easterday 3-9-88 Signature Date		B 4 DIRECTION OF WELL FROM TOWN (CIRCLE BOX)  ON WHICH SIDE OF ROAD (CIRCLE APPROPRIATE BOX)  WEXFORD PARK (OFF BRIGITON DAM RD) 11 NEAR WHAT ROAD 30 34 2007 37 DISTANCE FROM ROAD ENTER FT or MI FT 38 39	
B 2 WELL INFORMATION APPROX. PUMPING RATE (GAL. PER MIN.) 5 2 8 12 AVERAGE DAILY QUANTITY NEEDED (GAL. PER DAY) 500 14 20		NOT TO BE FILLED IN BY DRILLER HEALTH DEPARTMENT APPROVAL HOWARD A 34772 COUNTY NAME COUNTY NO. STATE SIGNATURE DATE ISSUED 033188 ANorton 10/01/88 43 48 CO SIGNATURE EXP. DATE NORTH GRID 497000 EAST GRID 0810000 50 55 57 63	
USE FOR WATER (CIRCLE APPROPRIATE BOX) ☒ D HOME (SINGLE OR DOUBLE HOUSEHOLD UNIT ONLY) ☐ F FARMING (LIVESTOCK WATERING & AGRICULTURAL IRRIGATION) ☐ I INDUSTRIAL, COMMERCIAL, STATE AND FEDERAL GOV. OTHER (REQUIRES APPROPRIATION PERMIT) ☐ P PUBLIC OR PRIVATE WATER COMPANY (REQUIRES APPROPRIATION PERMIT AND STATE HEALTH DEPARTMENT APPROVAL) ☐ T TEST, OBSERVATION, MONITORING (MAY REQUIRE APPROPRIATION PERMIT)		SHOW MAJOR FEATURES OF BOX & LOCATE WELL WITH AN X SOURCES OF DRILLING WATER 1. well 2. 3. WRITE THE BOX-NUMBER FROM THE MAP HERE  DRAW A SKETCH BELOW SHOWING LOCATION OF WELL IN RELATION TO NEARBY TOWNS AND ROADS AND GIVE DISTANCE FROM WELL TO NEAREST ROAD JUNCTION CLARKSVILLE 32	
APPROXIMATE DEPTH OF WELL 200 FEET 24 28 APPROXIMATE DIAMETER OF WELL 6 INCH 30 32		B 3 METHOD OF DRILLING (circle one) BORED (or Augered) JETTED Jetted & DRIVEN 30 AIR-ROTARY AIR-PERCussion ROTARY (Hydraulic Rotary) 37 CABLE REVERSE-ROTARY DRIVE-POINT other	
REPLACEMENT OR DEEPEMED WELLS (CIRCLE APPROPRIATE BOX) ☒ N THIS WELL WILL NOT REPLACE AN EXISTING WELL ☐ Y THIS WELL WILL REPLACE A WELL THAT WILL BE ABANDONED AND SEALED ☐ S THIS WELL WILL REPLACE A WELL THAT WILL BE USED AS A STANDBY ☐ D THIS WELL WILL DEEPEMED AN EXISTING WELL PERMIT NUMBER OF WELL TO BE REPLACED OR DEEPEMED (IF AVAILABLE) 41 HO-81-2646 52		Not to be filled in by driller (OEP USE ONLY) APPROP. PERMIT NUMBER GAP 54 63 FORCE 16 WRITE INITIALS IN BOX PERMIT No. HO-81-2646 67 68 70 71 72 73 74 75 76 77 78 79	
SPECIAL CONDITIONS			

Review 9.22.88 *SN*

Depth of well 400 4 GPM
Distance of measuring point (M.P.) above ground, 1 1/2'
Static water level (S.W.L.) below M.P. 24'

- Time pump started 4:15 Pumping rate 10 gpm
Total time 30 min to reach pumping water level 164 ft. below M.P.

- II. Recovery pump test data - observations to be recorded every 15 minutes

HD-224

5/19/89

HOWARD COUNTY HEALTH DEPARTMENT
Bureau of Environmental Health
3525-H Ellicott Mills Drive
Ellicott City, MD 21043
461-9933

APPLICATION FOR PITLESS ADAPTER, WELL PUMP AND PRESSURE TANK INSTALLATION

New Installation ☒ Replacement ☐
Receipt # 44213
Date 5/11/89
Name of Installer MARINO PTH INC Telephone 747-5615
License Number M-3095
Certified Well Pump Installer MRS. HEENRICH Well Driller owner Registered Plumber ☒
Name of Property Owner Jim Brumstead Bldr Telephone
Subdivision Waterford Lot # 15 Well Tag # HD - 81 - 2646
Site Address 12926 WEXFORD PARK

Pump
1. Type
a. Deep well jet ☐
b. Shallow well jet ☐
c. Submersible ☒ YES
2. Make Goulds
3. Model # SEOS07412
4. Capacity 5 GPM
5. Pump exceeds well capacity Yes ☐ No ☒
6. If Yes, is low pressure cutoff switch installed? Yes ☒ No ☐
7. What methods are used to protect the pump and electrical wiring from vibrations? Torque arrestors ☒ Cable guards ☒ Other ☐
Motor
1. Horsepower 1/2
2. RPM
3. Voltage 220
a. 110 ☐
b. 220 ☒
Pitless Adapter
1. Make BRASS 1"
2. Model # 1"
3. Depth 42"

Tank
1. Capacity WK 250
2. Pressure relief valve? YES
Piping
1. Type 1" 1601b
2. Size 1"
3. NSF and/or BOCA Code approved YES
4. Depth of supply line 42"
Well data
1. Depth 400' ft.
2. Yield 4 GPM
3. Static water level 50 ft.
4. Will water supply be disinfected by installer? By Bldr.

18" OF COVER TO BE ADDED PER BULLDOG/PLUMBER
WELL LINE 2 1/4" BELOW GROUND IN
SOME SPOTS 5/19/89 CW CNO STICKER

I understand that it is my responsibility to notify the Howard County Health Department when the installation is ready for inspection (otherwise this permit is null and void).

All information given above is true to the best of my knowledge.

Signature of Applicant: Joseph D. Marino
Date: 5/5/89

Note: A sticker indicating approval/status of the installation will be placed on the well casing at the time of the inspection.