

PERMIT APPLICATION

B10001086

Building Address 6604 WHITEGATE RD
CLARKSVILLE MD 21029
Suite/Apt. #: _____ SDP/WP/Petition #: _____
Census Tract 6051.02 Subdivision MEADOWS
Section _____ Area _____ Lot 8
Tax Map 35 Parcel 232 Grid _____
Zoning _____ Map Coordinates _____ Lot Size _____
Existing Use PATIO
Proposed Use GAZEBO OVER PATIO
Estimated Construction Cost \$ 4,500
Description of Work BUILD GAZEBO OVER
EXISTING PATIO APPROX. 324 Sq. Ft
Occupant or Tenant SA
Contact Name _____
Address _____
City _____ State _____ Zip Code _____
Phone _____ Fax _____

Property Owner's Name John D. Coleman
Address 6604 WHITEGATE RD
City CLARKSVILLE State MD Zip Code 21029
Home Phone 301-854-2051 Work Phone SA
Applicant's Name & Mailing Address, (if other than stated herein): _____
Phone 301-854-2051 Fax 301-410-531-3798
Contractor Company NA
Contact Person _____
Address _____
City _____ State _____ Zip Code _____
License No. _____
Phone _____ Fax _____
Engineer or Architect Company _____
Contact Person _____
Address _____
City _____ State _____ Zip Code _____
Phone _____ Fax _____

BUILDING DESCRIPTION - COMMERCIAL

Building Characteristics
Height: _____
No. of stories: _____
Gross area, sq. ft. per floor: _____
Use group: _____
Construction type:
____ Reinforced Concrete
____ Structural Steel
____ Masonry
☒ Wood Frame
____ State Certified Modular

Utilities
Water Supply: _____
Public _____
Private ☒
Sewage Disposal: _____
Public _____
Private ☒
Electric Yes ☒ No ☐
Gas Yes ☐ No ☒
Heating System:
Electric ☒ Oil ☒
Natural Gas ☐
Propane Gas ☐
Sprinkler system: N/A ☒
____ Full
____ Partial
____ Other Suppression
____ # of Heads

BUILDING DESCRIPTION - RESIDENTIAL

Building Characteristics
SF Dwelling ☒ SF Townhouse ☐
Depth _____ Width _____
1st floor: _____
2nd floor: _____
Basement: _____
Finished Basement ☐ Unfinished Basement ☐ Crawl space ☐ Slab on Grade ☐
No. of Bedrooms _____
Multi-family dwellings:
No. of efficiency units: _____
No. of 1 BR units: _____
No. of 2 BR units: _____
No. of 3 BR units: _____
Other Structure: GAZEBO
Dimensions: 17'6" x 17'6"
Footings: NA
Roof: Asphalt
____ State Certified Modular
____ Manufactured Home

Utilities
Water Supply: _____
Public ☒
Private ☒
Sewage Disposal: _____
Public _____
Private ☒
Electric Yes ☒ No ☐
Gas Yes ☐ No ☒
Heating System:
Electric ☒ Oil ☒
Natural Gas ☐
Propane Gas ☐
Sprinkler system: N/A ☒
____ NFPA #13D
____ NFPA #13R
____ Other:

THE UNDERSIGNED HEREBY CERTIFIES AND AGREES AS FOLLOWS: (1) THAT HE/SHE IS AUTHORIZED TO MAKE THIS APPLICATION; (2) THAT THE INFORMATION IS CORRECT; (3) THAT HE/SHE WILL COMPLY WITH ALL REGULATIONS OF HOWARD COUNTY WHICH ARE APPLICABLE THERETO; (4) THAT HE/SHE WILL PERFORM NO WORK ON THE ABOVE REFERENCED PROPERTY NOT SPECIFICALLY DESCRIBED IN THIS APPLICATION; (5) THAT HE/SHE GRANTS COUNTY OFFICIALS THE RIGHT TO ENTER ONTO THIS PROPERTY FOR THE PURPOSE OF INSPECTING THE WORK PERMITTED AND POSTING NOTICES.

John D. Coleman
Applicant's Signature
JOHND.COLEMAN@VERIZON.NET
Email Address

John D. Coleman
Print Name

Title/Company

Date

Checks payable to: DIRECTOR OF FINANCE OF HOWARD COUNTY
PLEASE WRITE NEATLY AND LEGIBLY.

AGENCY DATE SIGNATURE APPROVAL
Land Development, DPZ
State Highways
Building Officials
Dev. Engineering, DPZ
Health 4-29-10 John D. Coleman
Fire Protection

FOR OFFICE USE ONLY

DPZ SETBACK INFORMATION
Front: _____
Rear: _____
Side: _____
Side St.: _____
All minimum setbacks met?
YES ☐ NO ☐
Is Entrance Permit Required?
YES ☐ NO ☐
Historic District?
YES ☐ NO ☐
Lot Coverage for New Town Zone
SDP/Red-line approval date _____

PROPERTY ID #
Filing fee \$
Permit fee \$
Excise tax \$
Add'l per fee \$
TOTAL FEES \$
Sub-total paid \$
Balance due \$
Check #
Validation #
Accepted by _____

Is Sediment Control approval required prior to issuance?
YES ☐ NO ☐

CONTINGENCY CONSTRUCTION START: ☐
ONE STOP SHOP: ☐

Distribution of Copies
Operations/Updated forms

White: Building Officials

Green: LDD, DPZ

Yellow: DED, DPZ

Pink: Health

Gold: SHA

N09°53'E

S'UTIL ESMT

183.75'

NOTE: The lot shown hereon does not lie within the limits of the 100 year flood plain as shown on FIRM Panel No. 33

12.4.86

LOT 8

1.094 Acs

APPROVED PERMIT

WALK-THRU BUILDING PERMIT

BP#

A# P57307

DATE: 4-29-10

DAPP, SAN HS

DESC. OF WORK: gazebo

POOL AREA

ASPHALT


6604 BRICK 1STORY FRAME W/BSMT. 71.1' 23.0' 11.0' 10.5' 23.7' 26.6' 37.1'

Richard Coleman
4/29/10

WHITE GATE ROAD

50' R/W

SCALE: 1" = 40'

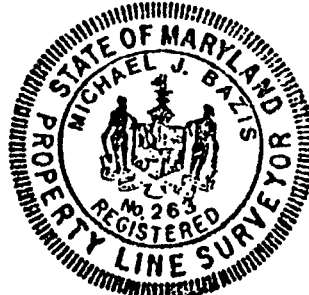

IMPROVEMENT LOCATION SURVEY

SURVEYOR'S CERTIFICATE

LOT 8

CLARKSVILLE RIDGE

I hereby certify that the position of all existing improvements on the above described property has been carefully established by a transit-tape survey; and that, unless otherwise shown, there are no encroachments. Unless