

# PERMIT

SEWAGE DISPOSAL SYSTEM

MARYLAND STATE DEPARTMENT OF HEALTH  
HOWARD COUNTY

P 01517  
A 00990

ELLCOTT CITY

DISTRICT 5

DATE 8/11/59

INDEXED

C. C. Carroll Jr. IS PERMITTED TO INSTALL ☒ ALTER ☐  
ADDRESS Chapin, Md. PHONE \_\_\_\_\_  
A SEWAGE DISPOSAL SYSTEM LOCATED AT White Gate Rd. & Maiden Lane

SUBDIVISION Clarkeville Ridge ROAD Rt. 32 LOT 33

PROPERTY OWNER Harold A. Koubelka

ADDRESS Sheppard Lane, Ellicott City

## SPECIFICATIONS

DRAIN FIELD ☒ DEPTH 3 FEET, BOTTOM AREA 348 SQ. FT.

SEEPAGE PITS \_\_\_\_\_ ABSORBENT SIDE-WALL AREA \_\_\_\_\_ SQ. FT.

SEPTIC TANK CAPACITY 1000 GALLONS

FOR GARBAGE GRINDER, INCREASE DISPOSAL AREA 22% & TANK CAPACITY 50%


OTHER System to be installed in area that passed percolation tests.

PLANS APPROVED BY J. Hennigan DATE 5/14/59

FILL SEPTIC TANK AND DISTRIBUTION BOX WITH WATER BEFORE CALLING FOR AN INSPECTION. COVER NO WORK UNTIL INSPECTED AND APPROVED.

NEITHER THE HOWARD COUNTY COMMISSIONERS NOR THE HEALTH DEPARTMENT IS RESPONSIBLE FOR THE SUCCESSFUL OPERATION OF ANY SYSTEM.

00990

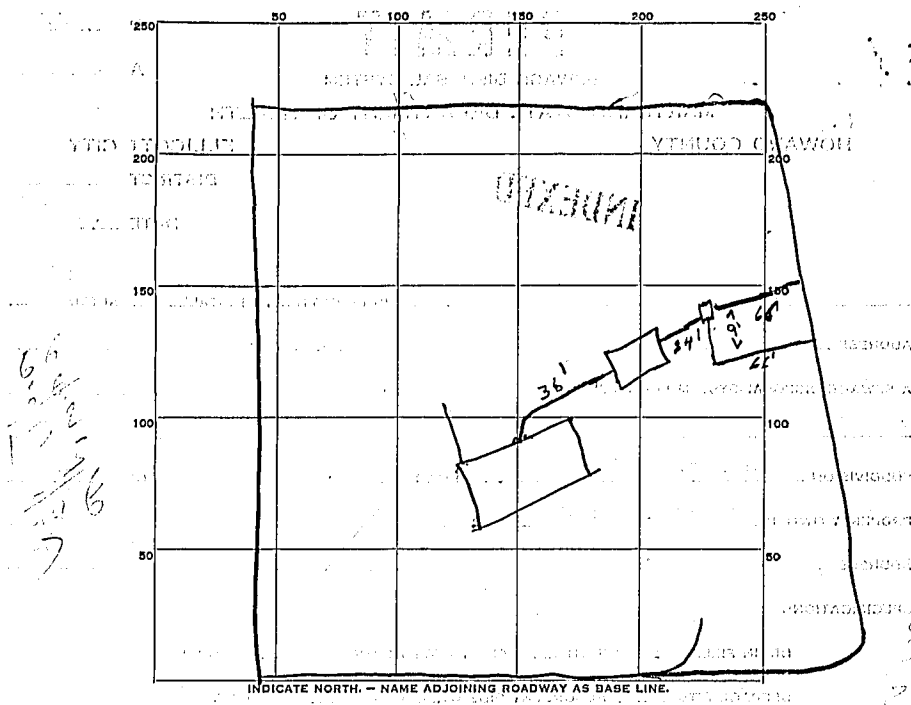

PERMIT CARD Yes man present

SEPTIC TANK, LEVEL OK 1000 CLEANOUTS OK 8"

DISTRIBUTION BOX, LEVEL \_\_\_\_\_

TILE FIELD, DEPTH 3-4 FT. TRENCH WIDTH 3 FT.

GRAVEL DEPTH 10-14 IN. TOTAL LENGTH 132 FT.

NUMBER OF TRENCHES 2 TOTAL BOTTOM AREA 396

SEEPAGE PITS, INSIDE DIAMETER \_\_\_\_\_ FT. DEPTH BELOW INLET \_\_\_\_\_ FT.

ABSORBENT AREA \_\_\_\_\_ SQ. FT.

REMARKS 2" gravel over the pipe

Tile field to be graded within 3'

DATE SYSTEM APPROVED 8/26/59 INSPECTOR Raymond Kodger