

DEPARTMENT OF INSPECTIONS, LICENSES AND PERMITS
3430 COURT HOUSE DRIVE
ELLICOTT CITY, MD 21043
PERMITS (410) 313-2455 INSPECTIONS (410) 313-1810
AUTOMATED INFORMATION (410) 313-3800

HOWARD COUNTY
PERMIT APPLICATION

PERMIT NUMBER
B06006328

Building Address 13310 Wicklow Pl
Clarksville MD 21029
Suite/Apt. #: SDP/WP/Petition #:
Census Tract Subdivision Waterford
Section Area 2 Lot 25
Tax Map 34 Parcel 261 Grid 9
Zoning Map Coordinates Lot size

Property Owner's Name Gerald & Catherine Thompson
Address 13310 Wicklow Place
City Clarksville State MD Zip Code 21029
Home Phone 301 854 0864 Work Phone
Applicant's Name & Mailing Address, (if other than stated hereon):
Phone Fax

Existing Use single family home
Proposed Use same
Estimated Construction Cost \$
Description of Work build (8 x 32) deck off
side of home, replace portion of existing roof
& change pitch (approx 900#)

Contractor Company Starcom Design Build
Contact Person Betty Weickgenannt
Address 8835M Columbia 100 Rwy
City Columbia State MD Zip Code 21045
License No. 24247-01
Phone 410 997 7700 Fax 410 997 7338

Occupant or Tenant
Contact Name
Address
City State Zip Code
Phone Fax

Engineer or Architect Company
Contact Person
Address
City State Zip Code
Phone Fax

| BUILDING DESCRIPTION - COMMERCIAL | | BUILDING DESCRIPTION - RESIDENTIAL | |
|--|--|---|--|
| Building Characteristics Height: No. of stories: Gross area, sq. ft. per floor: Use group: Construction type: Reinforced Concrete Structural Steel Masonry Wood Frame State Certified Modular | Utilities Water Supply: Public Private Sewage Disposal: Public Private Electric Yes No Gas Yes No Heating System: Electric Oil Natural Gas Propane Gas Sprinkler system: N/A Full Partial Other Suppression # of Heads | Building Characteristics SF Dwelling <input checked="" type="checkbox"/> SF Townhouse <input type="checkbox"/> Depth Width 1st floor: 8' 32' 2nd floor: Basement: Finished Basement <input type="checkbox"/> Unfinished Basement <input type="checkbox"/> Crawl space <input type="checkbox"/> Slab on Grade <input type="checkbox"/> No. of Bedrooms Height: Multi-family dwellings: No. of efficiency units: No. of 1 BR units: No. of 2 BR units: No. of 3 BR units: Other Structure: Dimensions: 8 x 32 deck Footings: concrete piers 6x6 Roof Height: State Certified Modular Manufactured Home | Utilities Water Supply: Public Private <input checked="" type="checkbox"/> Sewage Disposal: Public Private <input checked="" type="checkbox"/> Electric Yes No Gas Yes No Heating System: Electric Oil Natural Gas Propane Gas Sprinkler system: N/A NFPA #13D NFPA #13R Other: |

THE UNDERSIGNED HEREBY CERTIFIES AND AGREES AS FOLLOWS: (1) THAT HE/SHE IS AUTHORIZED TO MAKE THIS APPLICATION; (2) THAT THE INFORMATION IS CORRECT; (3) THAT HE/SHE WILL COMPLY WITH ALL REGULATIONS OF HOWARD COUNTY WHICH ARE APPLICABLE THERETO; (4) THAT HE/SHE WILL PERFORM NO WORK ON THE ABOVE REFERENCED PROPERTY NOT SPECIFICALLY DESCRIBED IN THIS APPLICATION; (5) THAT HE/SHE GRANTS COUNTY OFFICIALS THE RIGHT TO ENTER ONTO THIS PROPERTY FOR THE PURPOSE OF INSPECTING THE WORK PERMITTED AND POSTING NOTICES.

Betty L Weickgenannt

Applicant's Signature

Starcom Design Build

Title Company

Betty L Weickgenannt

Print Name

10-19-06

Date

Checks payable to: DIRECTOR OF FINANCE OF HOWARD COUNTY
** PLEASE WRITE NEATLY AND LEGIBLY. **
- FOR OFFICE USE ONLY -

| AGENCY | DATE | SIGNATURE APPROVAL | DPZ SETBACK INFORMATION | PROPERTY ID# |
|--|------|--------------------|--|-------------------|
| Land Development, DPZ | | | Front: | Filing fee \$ |
| State Highways | | | Rear: | Permit fee \$ |
| Building Official | | | Side: | Excise tax \$ |
| Dev. Engineering, DPZ | | | Side St.: | Add'l per. fee \$ |
| Health 10/19/06 | | Halif AGH | All minimum setbacks met? | TOTAL FEES \$ |
| Fire Protection | | | YES <input type="checkbox"/> NO <input type="checkbox"/> | Sub-total paid \$ |
| Is Sediment Control approval required prior to issuance? | | | Is Entrance Permit required? | Balance due \$ |
| YES <input type="checkbox"/> NO <input type="checkbox"/> | | | YES <input type="checkbox"/> NO <input type="checkbox"/> | Check # |
| CONTINGENCY CONSTRUCTION START: <input type="checkbox"/> | | | Historic District? | Valuation # |
| ONE STOP SHOP: <input type="checkbox"/> | | | YES <input type="checkbox"/> NO <input type="checkbox"/> | |
| Distribution of Copies- | | | Lot Coverage for NewTown Zone | |
| White: Building Official | | | SDP/Red-line approval date | Accepted by |
| Green: LDD, DPZ | | | Yellow: DED, DPZ | |
| Pink: Health | | | | |
| Gold: SHA | | | | |

T:\home\PERMIT.FRM

Rev. 11/4/04

N 67° 44' A 2" E

APPROVED

WALK-THRU BUILDING PERMIT


DP# 306006328

A# 3545

APP. SAN *GAC*

DATE: 10/19/00

DESC. OF WORK: DECK 25 Shown
Roof Repairs and alterations

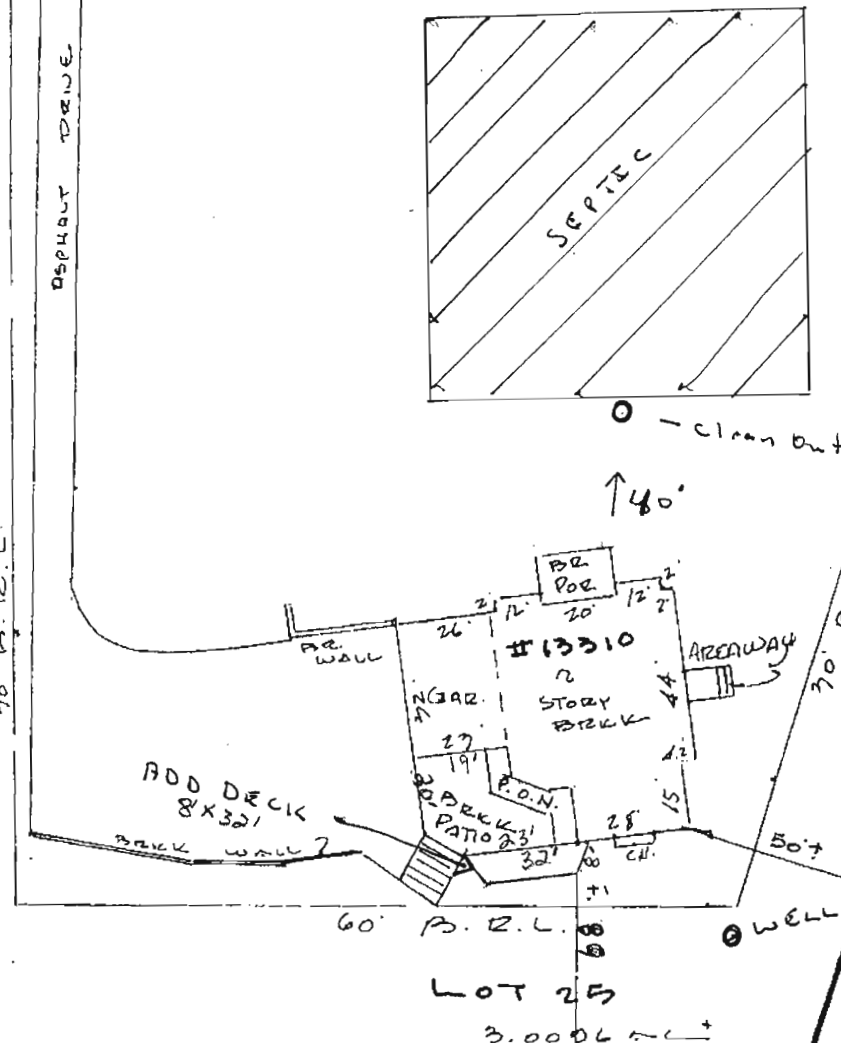

N22°51'00"W 232.00

LOCATION SURVEY PLAT

SUBJECT PROPERTY NOT LOCATED IN A FLOOD PLAIN AREA UNLESS OTHERWISE NOTED

CERTIFICATION

This is to certify that I have surveyed
the property known as: 13310

WICKLOW PLACE
Clarksville, MD

for the purpose of locating the improvements thereon, and the improvements are located as shown.

SEAL



Water face

Thompson Residence

SCALE 1"=50' DATE 3-25-1992

LAND DESIGN ENGINEERING, INC.
SUITE 210 10620 GUILFORD ROAD
JESSUP, MARYLAND 20794

880-0034 (BALT) 604-6264 (WASH)
604-6735 (FAX)