

Record Detail * (This section is required.)

Permit Type Building/Residential/Misc/Pool Spa Permit Number B25000889 Opened Date 03/10/2025
 Description of Work SFD/ INSTALL 24' DIAMETER BY 52" HIGH ABOVE GROUND SWIMMING POOL, FENCE TO CODE

ON HOLD, need a better more complete plot plan. Missing well & septic components as well as pool dimensions - g 5/24/25

[check spelling](#)

Address * (This section is required.)

Search Reset Clear Get Parcel & Owner
 Street # 16333 Street Name OLD FREDERICK Street Type RD
 Unit Type --Select-- Unit # X Coordinate -77.08596 Y Coordinate 39.35132
 City MOUNT AIRY State MD Zip Code 21771 Primary Yes

Approved, applicant called & sorted out gray issues w/ updated attachments. g 6/17/25

Parcel * (This section is required.)

Search Reset Clear Get Address & Owner
 GIS ID * 830646 Parcel 206 Parcel Area 1.51 Land Value 0 Improved Value 321800 Exemption Value 0 Plan Area RURAL
 Legal Description LOT 21 B 1.519 A []16333 OLD FREDERICK RD []MT AIRY

[check spelling](#)

Block	Lot	Census Tract	Council Dist	Inspection Dist	Supervisor Dist	Map #	DAP Zone
	21 B	604001	5				
Plan Area	State Tax Id	Subdivision Name					
	1404332423						
Section	Area	Tax Map					
		2					
Grid	Zoning District	ADC Map					
2-22	RC-DEO	4691-G4					
SDP No.	Final Plan No.	WP File No.					
Record Plat No.	WS Contract No.	FDP No.	Primary Yes				
Owner Occupied	Year Built	Historic District					
<input type="radio"/> Yes <input type="radio"/> No	1982	<input type="radio"/> Yes <input checked="" type="radio"/> No					
Historic District Registry No.	Stat Area	Flood Plain					
	4-02	<input type="radio"/> Yes <input checked="" type="radio"/> No					
Building No							

Owner * (This section is required.)

Search Reset Clear
 Name * Caitlin
 Address Line 1 16333
 Address Line 2
 Address Line 3
 Mail City Mount Airy
 Mail State MD
 Mail Zip Code 21771
 Phone 908-612-7695
 Primary Yes
 E-mail

Cell Number Fax Number

Professionals (This section is not required.)

License # * Business Name
 0 HOME OWNER

License Type * First Name Middle Name Last Name
 Home Owner ✓ CAITLIN ENNIS

Primary Address Line 1
 Yes ✓ 16333 OLD FREDERICK ROAD
 Address Line 2

City State ZIP Code
 MOUNT AIRY MD 21771

Phone 1 Phone 2 Fax
 908-612-7695

E-mail
 caitlin.m.ennis@gmail.com

Applicant (This section is not required.)

Search As Owner As Lic. Prof As Contact

Type * First Name MI Last Name
 Applicant Caitlin Ennis

Relationship Full Name
 Applicant ✓ Caitlin Ennis

Primary Organization Name
 Yes ✓

Street Address
 16333 Old Frederick Road
 Address Line 2

City State Zip Code
 Mount Airy MD 21771

Phone Cell Fax
 908-612-7695

E-mail *
 caitlin.m.ennis@gmail.com

Addtl Info

Est Construction Cost * Housing Units * Number of Buildings * Public Owned
 12000 0 0 No ▼

Construction Type
 649 - All Other Buildings and Structures ▼

POOL INFORMATION

MISCELLANEOUS POOL INFORMATION

Capital Project-No Fee * Capital Project Number Fee Exempt * Water Supply * Sewage Disposal *
 Yes No (Text) Yes No Private ▼ Private ▼


Existing Use * Type of Pool or Spa * Pool Safety Device * Electrical Permit Number Expiration Date
 SFD ▼ Above Ground Pool ▼ Fence ▼ E25001918 (Text) 11/10/2025

Related Records

Showing 1-2 of 2

Permit Number	Record Type/Alias	Status	Number	Street Name	Opened Date	Description
B25000889	Residential Pool or Spa Permit	Review In Process	16333	OLD FREDERICK	03/10/2025	SFD/ INSTALL 24" DIAMETER BY 52" HIGH ABOVE GI
E25001918	Residential Electrical Miscellaneous Permit	Issued	16333	OLD FREDERICK	04/15/2025	Wiring of of above ground pool, trenchless technologies

Submit Cancel

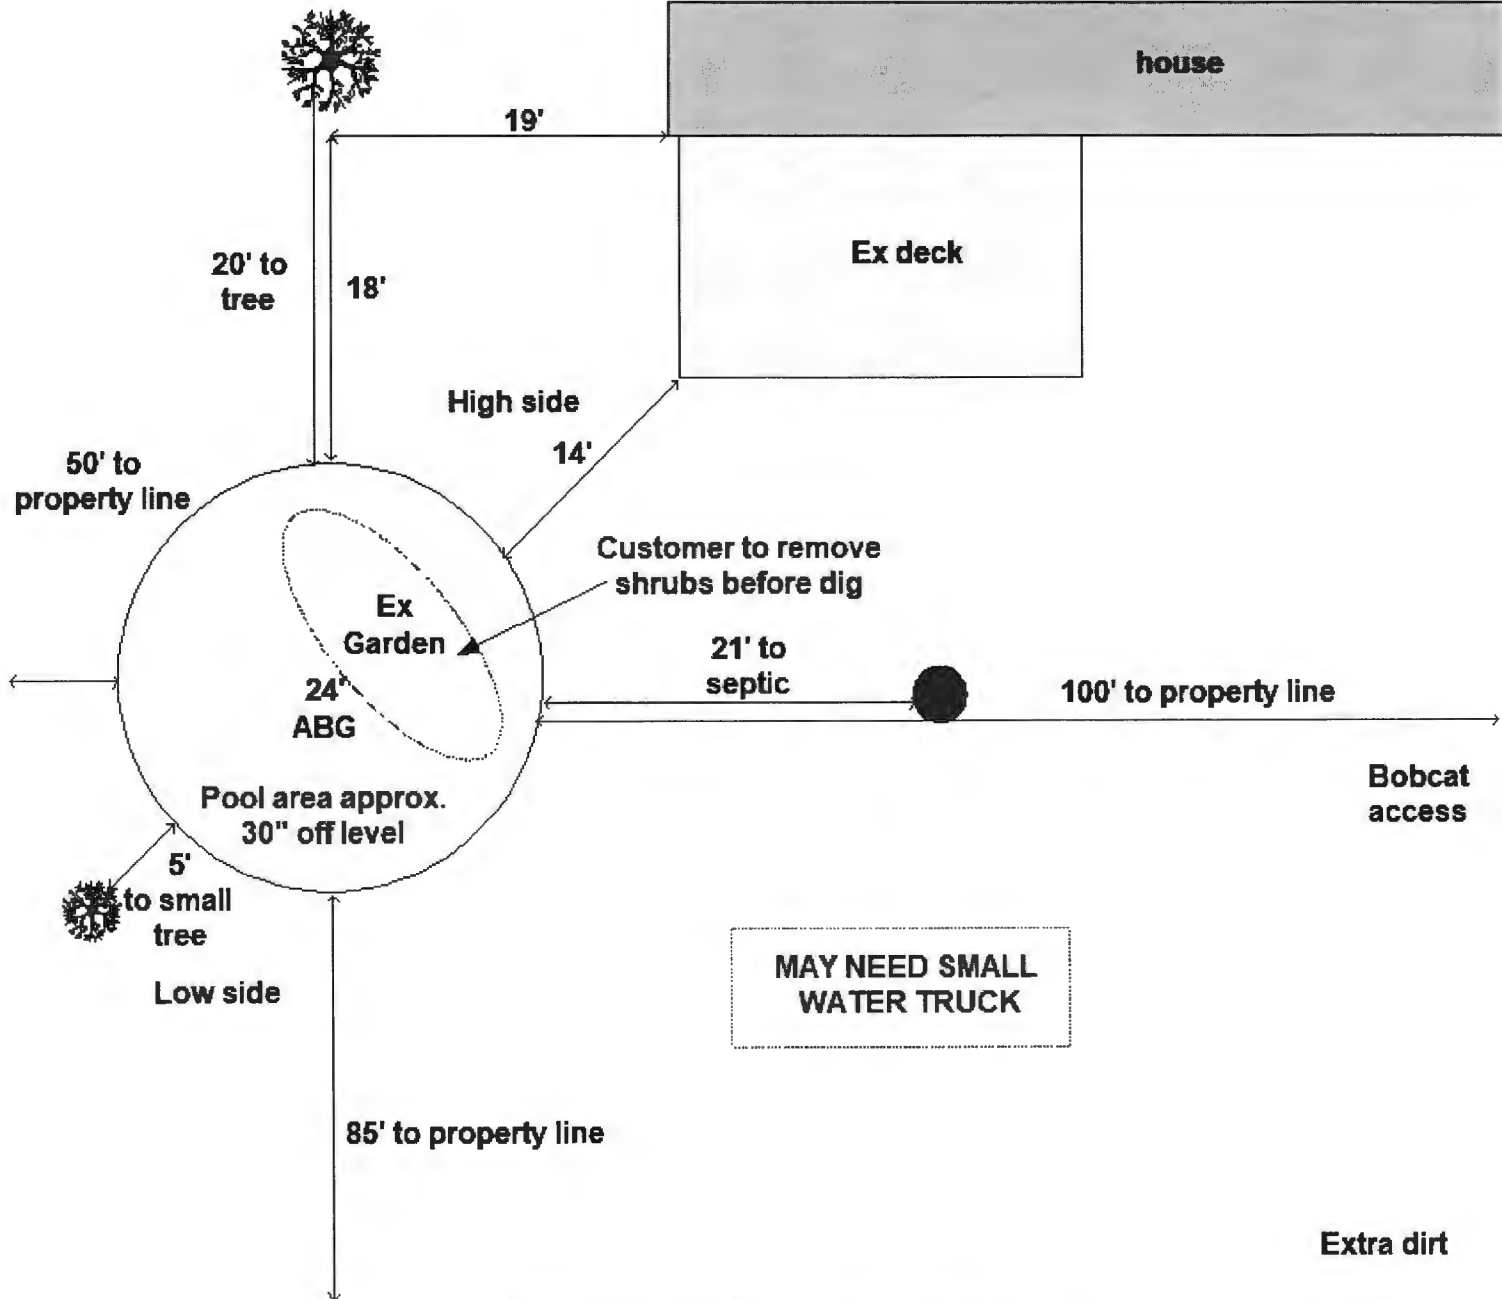


* Please allow up to 2 weeks for install
 * Someone who can make decisions is required to be home during install.
 *Yard will be left in rough grade condition.
Customer Responsible for: Ensuring that all water drains
away from pool area at all times. 2. Any landscaping, raking, seeding,
 damage to yard and removal of any excess dirt and debris. 3. All electric
 and fencing required for pool.
 Customer Signature = _____

Well in front
 Septic 21'
 No Plot Plan
 Howard Cnty.

Drawing #1


Van Dorn Pools and Spas Shrewsbury, PA Reisterstown, MD Kingsville, MD	Phone: (800) VAN-SWIM 2/21/2025	Designed for: Ennis, Caithlin- Jerry 16333 Old Frederick Rd Mount Airy Md. 21771 908-612-7695
--	------------------------------------	--

No. OF BEDROOMS	TOTAL SDA AREA	AVG. PERC RATE	SEPTIC CAPACITY/BEDROOM
4	12285sq'	12	210

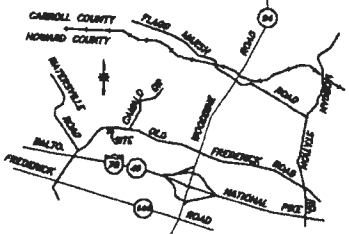

The blue circle is where the pool is going. If you look at the construction plans uploaded they have the exact measurements of where the pool is going in relation to the septic (21 feet away), the property line (50 feet away), and the existing patio in these plans (14 feet away).

- NOTES:**
- 1) ALL EXISTING WELLS AND SEPTIC WITHIN 100' OF THE PROPERTY BOUNDARY HAVE BEEN SHOWN.
 - 2) THE TOPOGRAPHY SHOWN HEREON IS DERIVED FROM A FIELD RUN SURVEY PERFORMED BY M.T.T. ASSOC. INC. IN SEPTEMBER 2006.
 - 3) ALL WELLS TO BE DRILLED PRIOR TO SUBMITTAL AND APPROVAL OF BUILDING PERMIT.
 - 4) THE LOT SHOWN HEREON COMPLIES WITH THE MINIMUM OWNERSHIP WIDTH AND LOT AREA REQUIRED BY THE MARYLAND STATE DEPARTMENT OF THE ENVIRONMENT.
 - 5) THIS AREA DESIGNATES A PRIVATE SEWERAGE EASEMENT OF A MINIMUM OF 10,000 sq' AS REQUIRED BY THE MARYLAND STATE DEPARTMENT OF THE ENVIRONMENT FOR INDIVIDUAL SEWERAGE DISPOSAL. IMPROVEMENTS OF ANY NATURE IN THIS AREA ARE RESTRICTED UNTIL PUBLIC SEWER IS AVAILABLE. THIS EASEMENT SHALL BECOME NULL AND VOID UPON CONNECTION TO A PUBLIC SEWER SYSTEM. THE COUNTY HEALTH OFFICER SHALL HAVE THE AUTHORITY TO GRANT ADJUSTMENTS TO THE PRIVATE SEWERAGE EASEMENT. RECORDATION OF A MODIFIED SEWERAGE EASEMENT PLAT SHALL NOT BE REQUIRED.
 - 6) SEPTIC SYSTEM UPGRADE IS REQUIRED BEFORE BUILDING PERMIT APPROVAL.

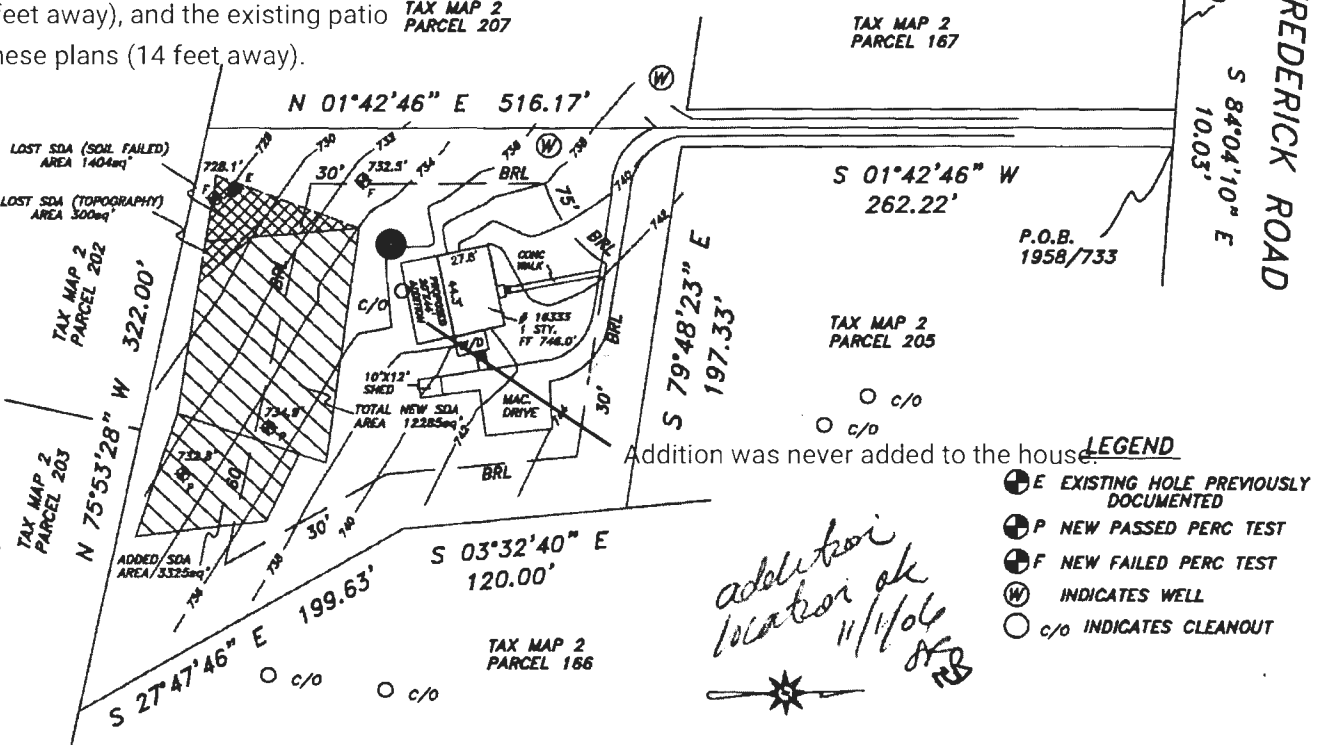

Addition was never added to the house


addition ok location ok 11/1/06 RB

- LEGEND**
- EXISTING HOLE PREVIOUSLY DOCUMENTED
 - NEW PASSED PERC TEST
 - NEW FAILED PERC TEST
 - INDICATES WELL
 - INDICATES CLEANOUT

OWNER / DEVELOPER
ROBERT ELISIO

NOT TO SCALE

Well - No Tag Visible

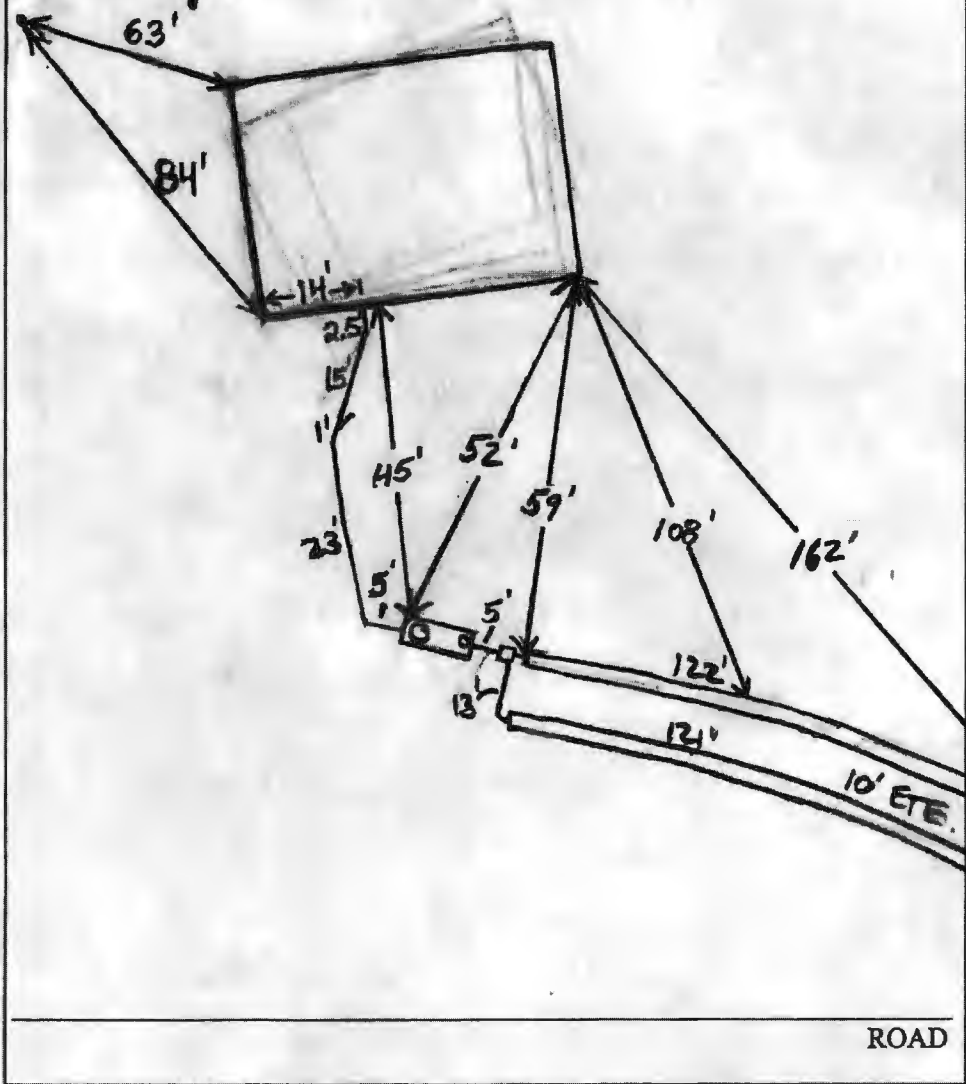

TRENCH/DRAINFIELD DATA

WIDTH	INLET	BOTTOM
_____	_____	_____
NUMBER OF TRENCHES	<u>2</u>	
TOTAL LENGTH	_____	
ABSORPTION AREA	_____	
DISTRIBUTION BOX LEVEL	_____	
DISTRIBUTION BOX BAFFLE	<u>Yes</u>	
DISTRIBUTION BOX PORT	<u>NO</u>	

SEPTIC TANK DATA

SEPTIC TANK 1 LEVEL	<u>Yes</u>
CAPACITY	<u>1500</u> GAL
SEAM LOC	<u>Top</u>
TANK LID DEPTH	<u>2.5'</u>
BAFFLES	<u>Yes</u>
BAFFLE FILTER	<u>-</u>
MANHOLE LOC	<u>Front</u>
6" PORT LOC	<u>Rear</u>
WATERTIGHT TEST	<u>NO</u>
SEPTIC TANK 2 LEVEL	<u>N/A</u>
CAPACITY	_____ GAL
SEAM LOC	_____
TANK LID DEPTH	_____
BAFFLES	_____
BAFFLE FILTER	_____
MANHOLE LOC	_____
6" PORT LOC	_____
WATERTIGHT TEST	_____

2-Comp
Mayer
Bros

PRE-CONSTRUCTION 10/30/06 Old tank pumped out. To set septic tank directly behind house and at least 20' from proposed addition. O.K. to set distribution box right after tank and install 2-116' trenches on contour towards the 199.63' lot line. Connection to existing house made PB 10/31/06 Tank and D box set per installation. Run trenches 1/4" larger. OK to back fill (Pie)

FINAL INSPECTOR [Signature] DATE OF APPROVAL 10/31/06