

PRELIMINARY

APPLICATION

A 25085

P

SEWAGE DISPOSAL TESTING

STATE OF MARYLAND - DEPARTMENT OF HEALTH AND MENTAL HYGIENE

HOWARD COUNTY HEALTH DEPARTMENT
ENVIRONMENTAL HEALTH SERVICES

3 B.R. 1000 gal. Septic tank
4 B.R. 1250 gal. Septic tank

DISTRICT 5th

DATE 1/3/77

P. O. BOX 476, ELLICOTT CITY, MARYLAND 21043
TELEPHONE: 465-5000, EXT. 356

Drywell & trench system to have 175 SQ. FT. effective
sidewall absorption area per bedroom, to begin below the first 4 ft. of
non-porous soil. Maximum depth permitted for drywell or trench is
11 ft. below original grade. Place the drywell 185 ft. from the center
line of Linden Church Road and 10 ft. from the left side line as seen
when facing the property from Linden Church Road. Start the trench
about 30 ft. from the left side line, and proceed to dig it on level ground
towards the left rear corner of the lot.

NOTE: Call for inspection of trench before gravel is installed.
TO: THE COUNTY HEALTH OFFICER
ELLICOTT CITY, MARYLAND

I, HEREBY, APPLY FOR THE NECESSARY TEST IN ORDER TO CONSTRUCT (OR RECONSTRUCT) A SEWAGE
DISPOSAL SYSTEM.

PROPERTY OWNER Edward A. Pielert, III

Louis W. Heddley, Jr.

ADDRESS Contract Purchaser - Louis W. Heddley, Jr.
512 Madingley Road
Linthicum, Md.

PHONE 636-6125 (Home)
Work: 796-8550

PROPERTY LOCATION: 6212 Groveland Ave., Linthicum, Md. 21090

SUBDIVISION 12810 LOT NO. 646-5500

ROAD AND DESCRIPTION Linden Church Road - approximately 1 mile in on left hand side
of road from Route 32

SIZE OF LOT 1.1 acres TYPE BLDG. 4 bedrooms
NUMBER OF BEDROOMS

IF NOT SINGLE RESIDENCE DESCRIBE

THE SYSTEM INSTALLED UNDER THIS APPLICATION IS ACCEPTABLE ONLY UNTIL PUBLIC
FACILITIES BECOME AVAILABLE.

SIGNATURE OF APPLICANT

Louis W. Heddley, Jr.

APPROVED BY

Frank Skinner

FOR

Drywell & trench
(KIND OF SYSTEM)

DATE

2/25/77

REJECTED BY

FOR

(KIND OF SYSTEM)

DATE

HOLD PENDING FURTHER TESTS

DATE

REASONS FOR REJECTION OR HOLDING

BLDG. PERMIT SIGNED
AND RETURNED 9/28/78

serial # 37245

THIS IS NOT A PERMIT

Hole #244

0'

CLAY
10AM

MICA
10AM

13'

① ⑩

0'

clayey

5'

mica
sandy
loam

13'

③ ⑦

0'

clayey


4'

mica
loam

10'

D.W. 10' from left

170 #/B.R.

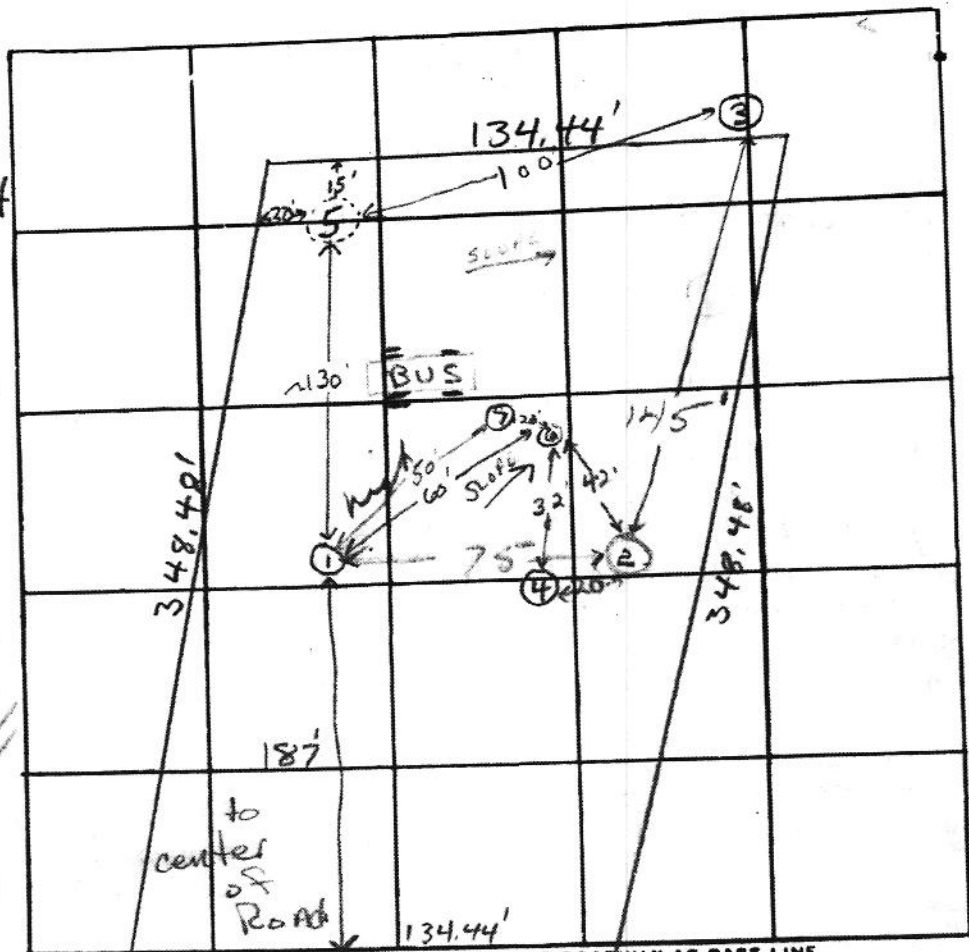

INDICATE NORTH - NAME ADJOINING ROADWAY AS BASE LINE

Linden Chapel


DATE	TEST NO.	DEPTH	PRE-WET		TEST - 1" DROP		TIME
			START	STOP	START	STOP	
1/18/77	15' high	4'	2:40	3:05	pulled peg still clayey to top 320		
	10	13'	2:41	2:46	2:46	3:05	19 min
	25'	5'	3:05		pulled peg still in clay around 3:50		
	20	13'	2:45	3:00	3:00	3:10	10 min
	15a 25d	5'	3:25	3:37	3:37	4:00	23 min
	33	4'	3:49	3:41	at mark at 4:15		
	30	12'	3:49	3:59	3:59	4:15	16 min
	4	7'	Clay to 7'				
2/14/77	6	4 1/2'	2:22		pulled peg 2:30 ~ 1/4" long clayey to 5 1/2' mica loam to 12'		
	7	4'	3:01	3:05	3:05	3:12	7 min

Clay to 4' in section below

REMARKS ⑤ is original per test on 5/6/64 A 08311. ③ is on or near lot line

TYPE OF SOIL sandy mica loam below top 4-9' clayey soil

TESTED BY H.B. & F.S. on 1/18 ALSO PRESENT: Headley, Ken Allen

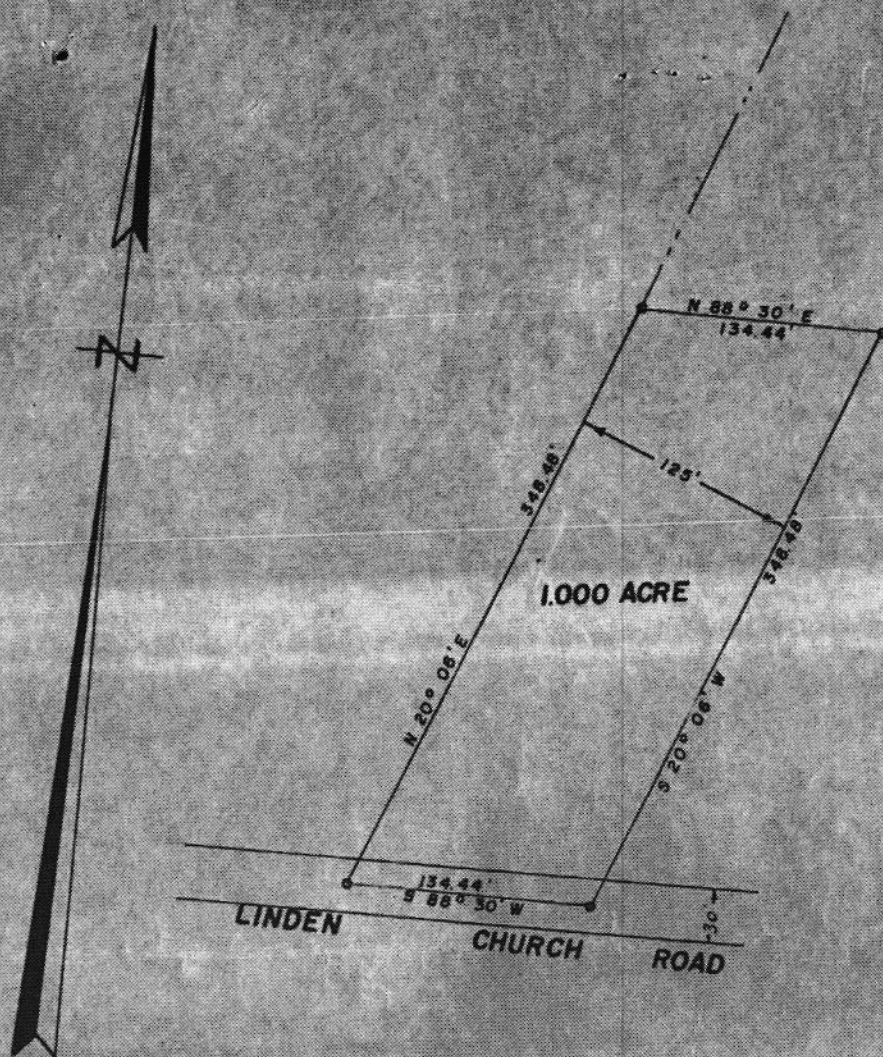

PLAT OF SURVEY
FOR
JOHN WHITE
FIFTH ELECTION DISTRICT OF HOWARD COUNTY
CLARKSVILLE, MARYLAND
SCALE: 1 IN. = 100 FT. OCTOBER 17, 1963

Claude M. Skinner Jr.

Claude M. Skinner Jr. Reg. Engineer & Land Surveyor No. 2237

