


SOILS LEGEND		
SOIL	NAME	CLASS
G9B	Gladstone loam, 3 to 8 percent slopes	A
G9C	Gladstone loam, 8 to 15 percent slopes	A

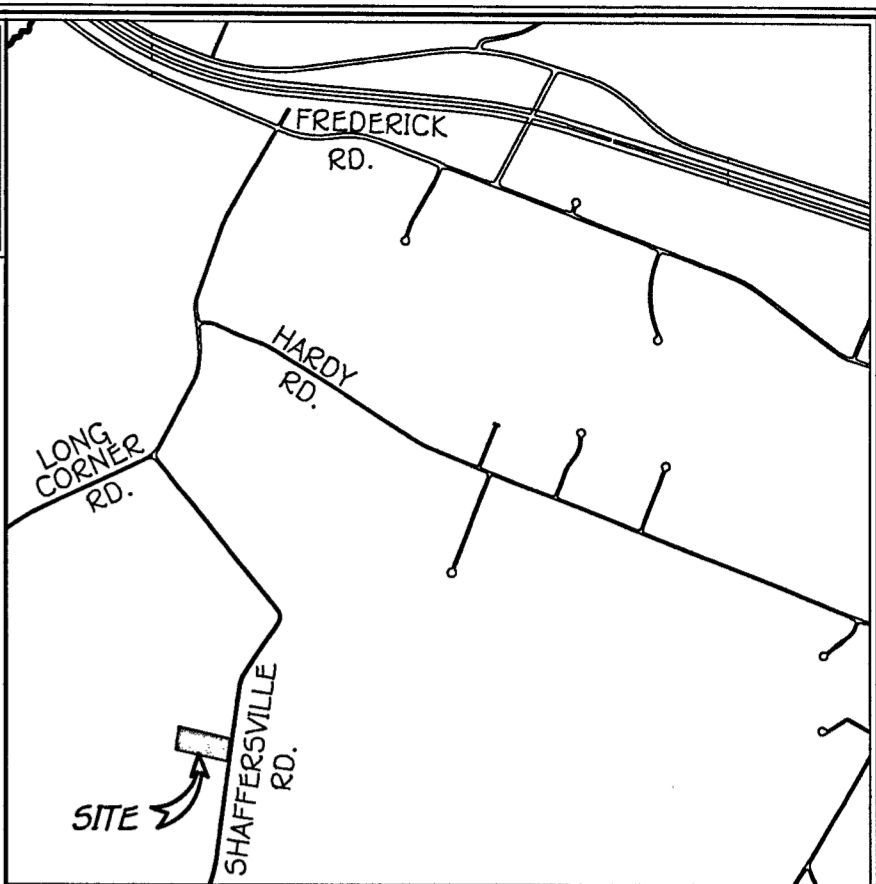

VICINITY MAP
SCALE: 1" = 2000'

LEGEND

- EXISTING 2' CONTOURS
- - - EXISTING 10' CONTOURS
- ~ ~ ~ EXISTING TREE LINE
- G9B / G9C SOIL LINES AND TYPES
- ⊙ DENOTES PROPOSED WELL
- DENOTES PASSED PERC
- ⊙ DENOTES 1500 Sq.Ft. ALTERNATE WELL SITE
- ▨ DENOTES EXISTING SEWAGE DISPOSAL AREA



GENERAL NOTES:

1. THIS AREA DESIGNATES A PRIVATE SEWAGE DISPOSAL AREA OF 10000 SQ.FT AS REQUIRED BY THE MARYLAND STATE DEPARTMENT OF THE ENVIRONMENT FOR INDIVIDUAL SEWAGE DISPOSAL. IMPROVEMENTS OF ANY NATURE IN THIS AREA ARE RESTRICTED. THIS SEWAGE DISPOSAL AREA SHALL BECOME NULL AND VOID UPON CONNECTION TO A PUBLIC SEWERAGE SYSTEM. THE COUNTY HEALTH OFFICER SHALL HAVE THE AUTHORITY TO GRANT ADJUSTMENTS TO THE PRIVATE SEWAGE DISPOSAL AREA. RECORDATION OF A REVISED SEWAGE DISPOSAL AREA SHALL NOT BE NECESSARY.
2. ADJUSTMENTS TO SEWAGE DISPOSAL AREA IS NOT PERMITTED WITHOUT ADDITIONAL TESTING.
3. THE LOT SHOWN HEREON COMPLIES WITH THE MINIMUM OWNERSHIP WIDTH AND LOT AREA AS REQUIRED BY THE MARYLAND STATE DEPARTMENT OF THE ENVIRONMENT.
4. LOCATION OF ALL NEIGHBORING WELLS AND SEPTIC SYSTEMS WITHIN 100 FEET OF THE PROPERTY BOUNDARIES AS WELL AS ALL WELLS OR PROPOSED WELL SITES WITHIN 200 FEET DOWN GRADIENT OF THE SEPTIC DISPOSAL AREA.
5. ALL HOUSE SITES SHOWN COMPLY WITH MINIMUM BUILDING RESTRICTION REGULATIONS.
6. TOPOGRAPHY SHOWN IS COUNTY GIS DATA.
7. BOUNDARY OUTLINE SHOWN IS COUNTY GIS DATA.
8. ANY CHANGES TO A PRIVATE SEWAGE DISPOSAL AREA SHALL REQUIRE A REVISED PERC CERTIFICATION PLAN.
10. DEED REFERENCE LIBER 2512 FOLIO 464.
11. ORIGINAL PERC CERTIFICATION SUBMITTED BY VANMAR ASSOCIATES INC. AND APPROVED ON 2/14/91.

THE PURPOSE OF THIS PERC APPLICATION PLAN IS TO ESTABLISH A WELL BOX AND REESTABLISH A SEWAGE DISPOSAL AREA ON LOT 2.

PERCOLATION CERTIFICATION PLAN
1400 SCHAFFERSVILLE ROAD
LOT 2

TAX MAP #6 PARCEL 257 ZONED RC-DEO
4TH ELECTION DISTRICT HOWARD COUNTY, MARYLAND
SCALE: 1"=50' DATE: JUNE 10, 2024

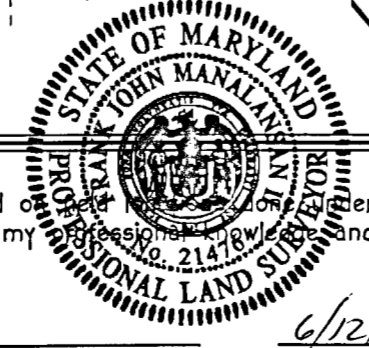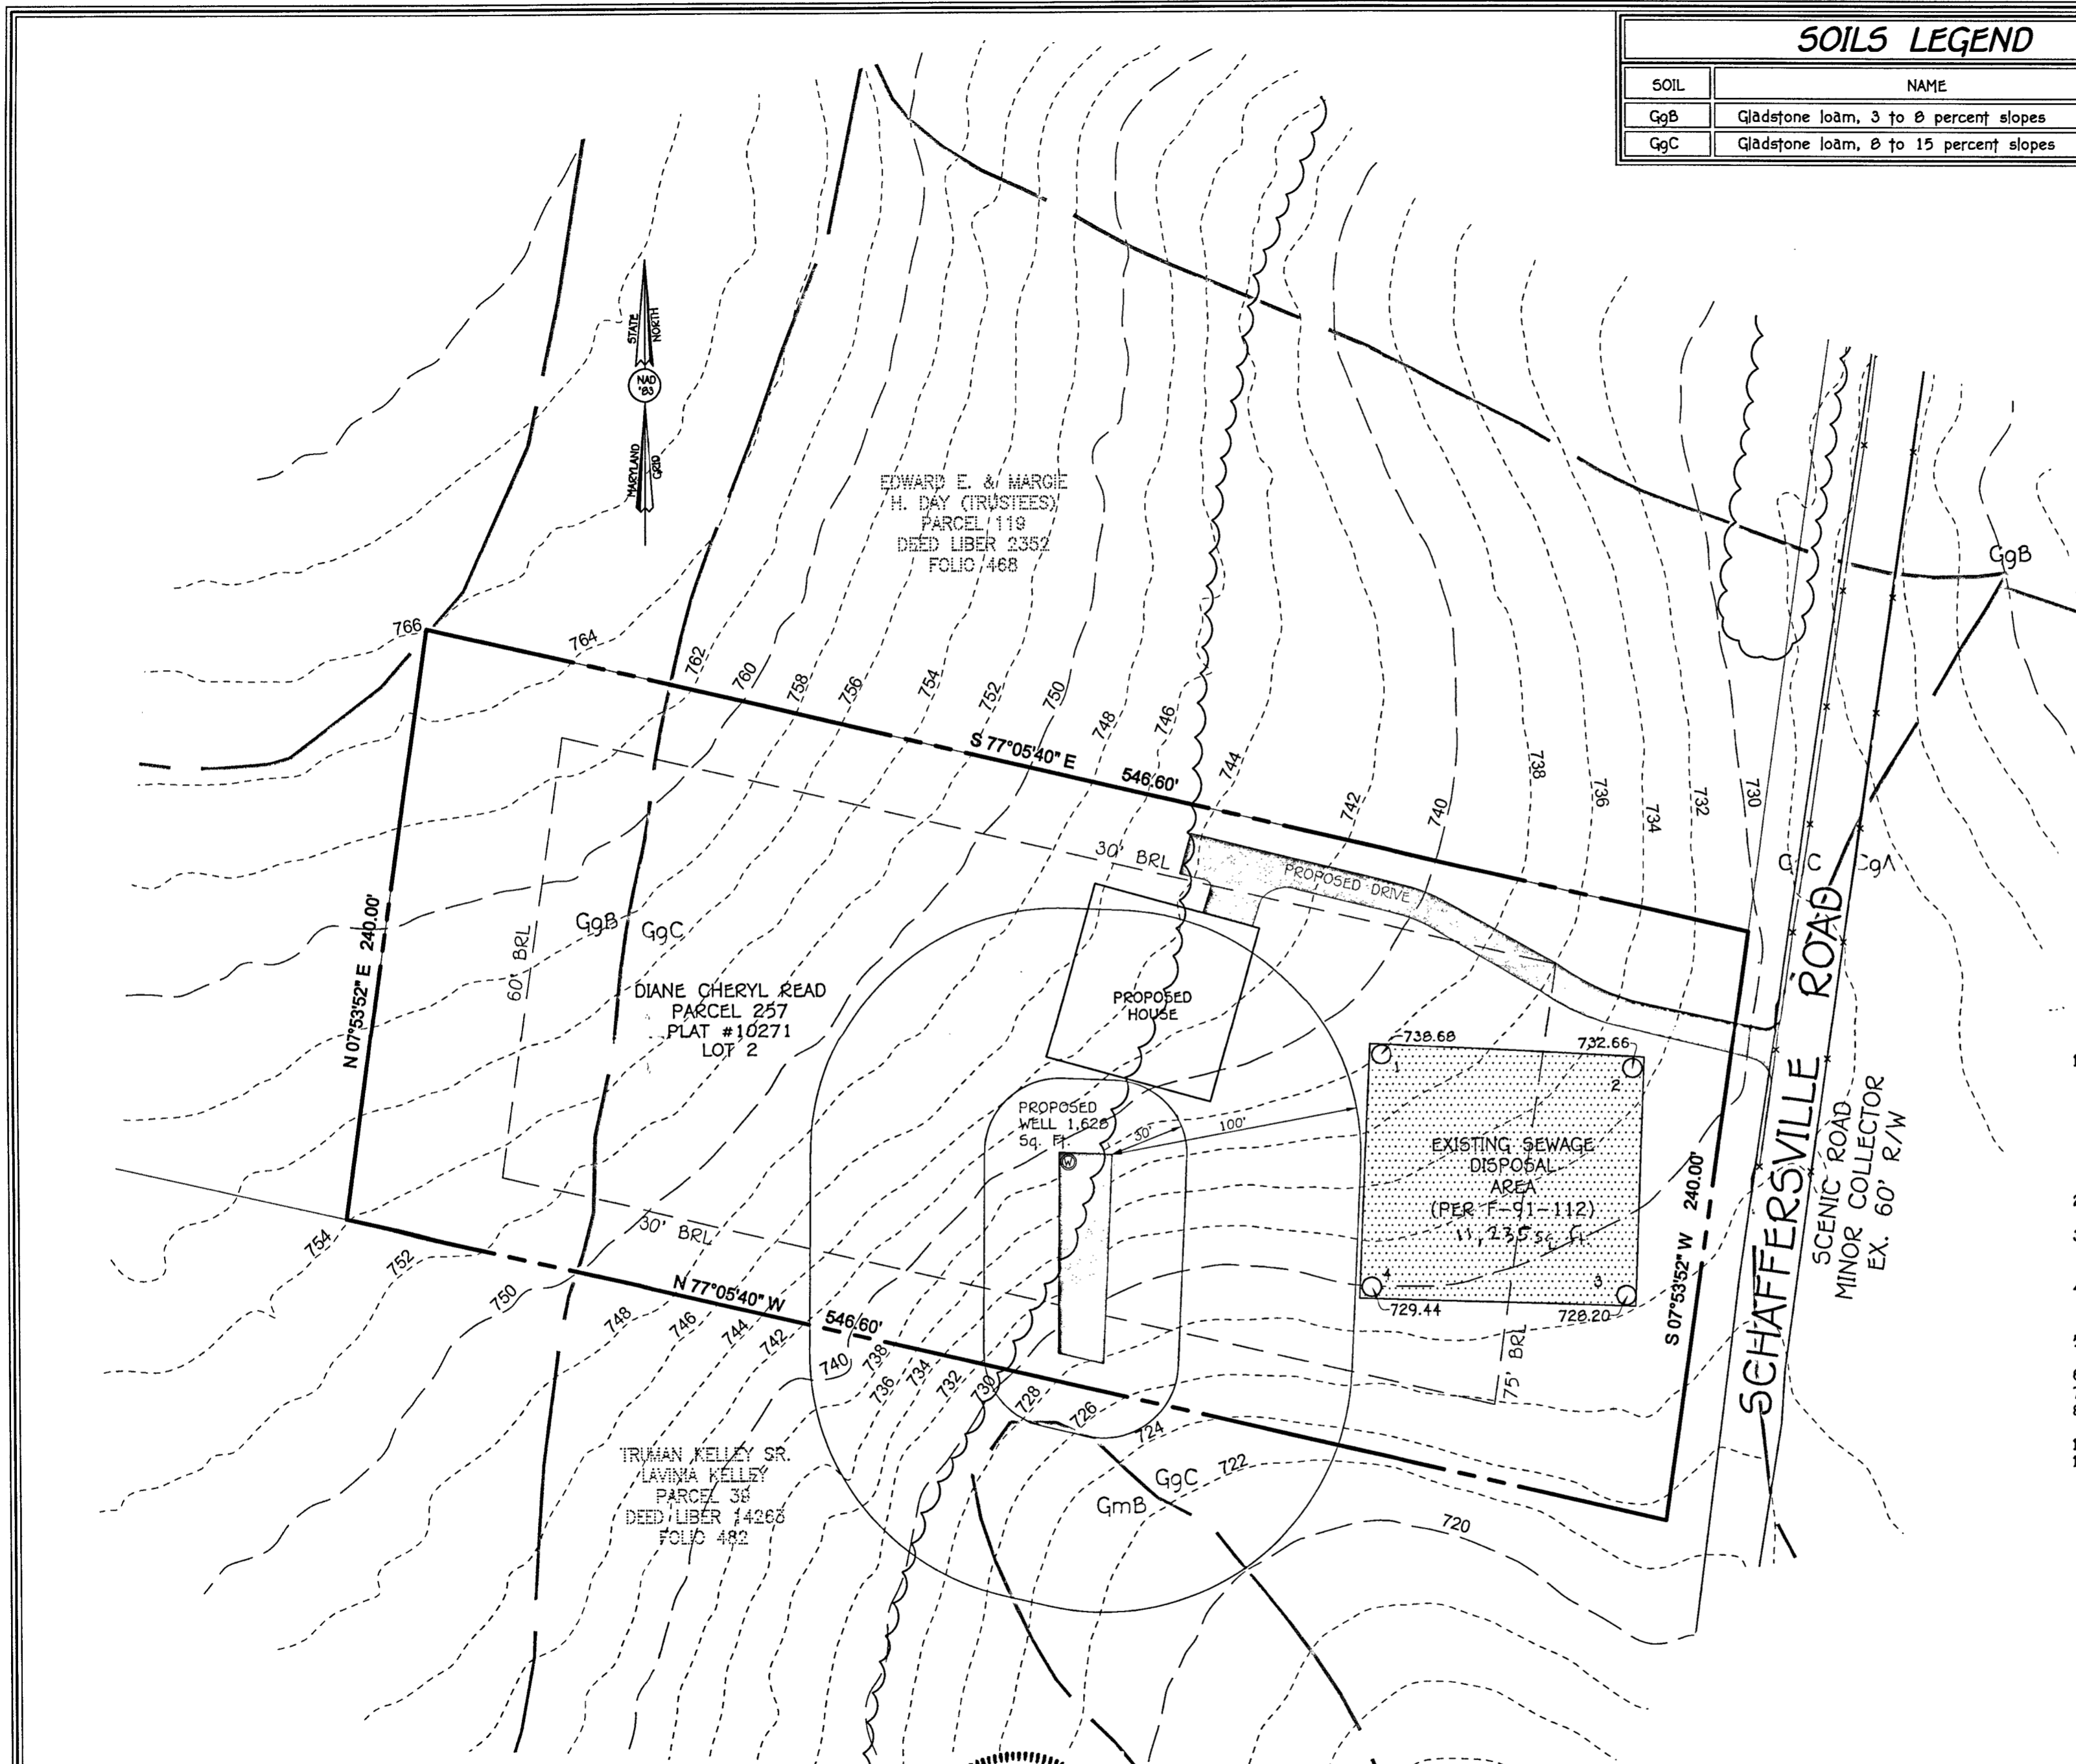

PERC CERTIFICATION
I certify that the locations shown hereon are based on field observations and are correct to the best of my professional knowledge and belief.

Frank John Manalansan II
Signature of Professional Land Surveyor
Frank Manalansan II, Professional Land Surveyor No. 21476 Expires 7/14/25

6/10/24
Date


APPROVED FOR PRIVATE WATER AND PRIVATE SEWERAGE SYSTEMS

Howard County Health Officer
HOWARD COUNTY HEALTH OFFICER

6/10/24
DATE

FISHER, COLLINS & CARTER, INC.
CIVIL ENGINEERING CONSULTANTS & LAND SURVEYORS
CENTENNIAL SQUARE OFFICE PARK - 10272 BALTIMORE NATIONAL PIKE
ELLCOTT CITY, MARYLAND 21042
(410) 461-2895

SOILS LEGEND		
SOIL	NAME	CLASS
GgB	Gladstone loam, 3 to 8 percent slopes	A
GgC	Gladstone loam, 8 to 15 percent slopes	A

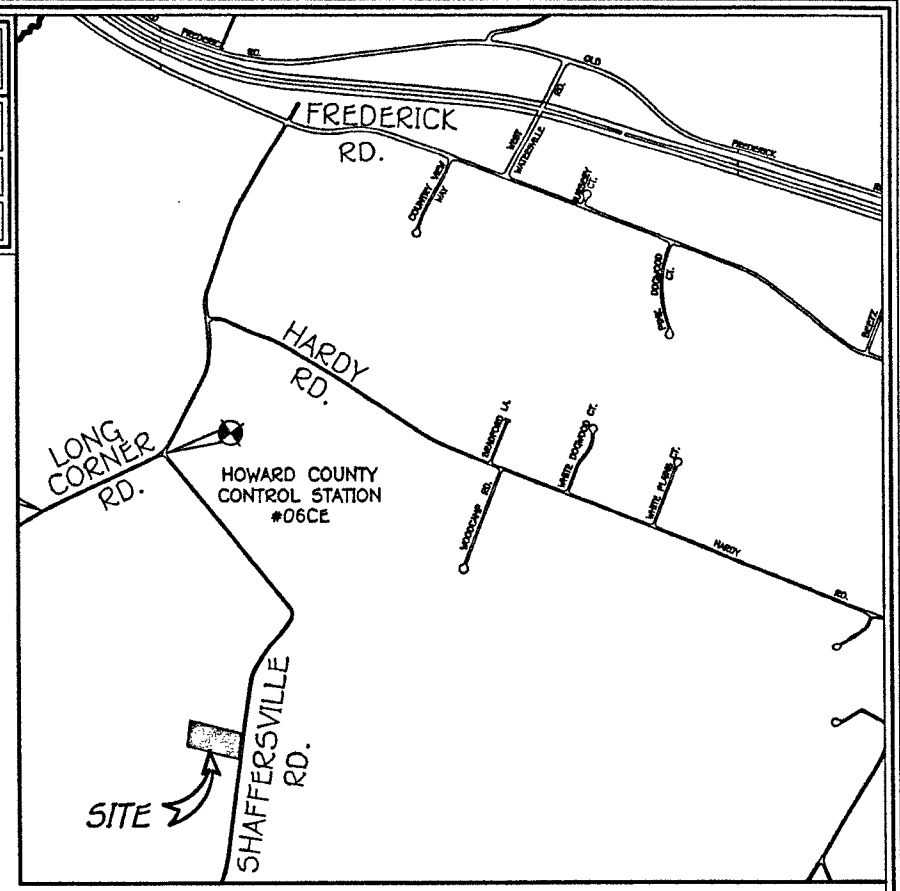

VICINITY MAP
SCALE: 1" = 2000'

LEGEND	
--- (dashed line)	EXISTING 2' CONTOURS
--- (dashed line)	EXISTING 10' CONTOURS
--- (wavy line)	EXISTING TREE LINE
--- (dotted line)	SOIL LINES AND TYPES
⊙ (circle with dot)	DENOTES EXISTING WELL
○ (circle)	DENOTES PASSED PERC
⊙ (circle with dot in square)	DENOTES PROPOSED 1500 Sq.Ft. ALTERNATE WELL SITE
⊙ (circle with dot in square)	DENOTES EXISTING SEWAGE DISPOSAL AREA

GENERAL NOTES:

- THIS AREA DESIGNATES A PRIVATE SEWAGE DISPOSAL AREA OF 10000 SQ.FT. AS REQUIRED BY THE MARYLAND STATE DEPARTMENT OF THE ENVIRONMENT FOR INDIVIDUAL SEWAGE DISPOSAL. IMPROVEMENTS OF ANY NATURE IN THIS AREA ARE RESTRICTED. THIS SEWAGE DISPOSAL AREA SHALL BECOME NULL AND VOID UPON CONNECTION TO A PUBLIC SEWERAGE SYSTEM. THE COUNTY HEALTH OFFICER SHALL HAVE THE AUTHORITY TO GRANT ADJUSTMENTS TO THE PRIVATE SEWAGE DISPOSAL AREA. RECORDATION OF A REVISED SEWAGE DISPOSAL AREA SHALL NOT BE NECESSARY.
- ADJUSTMENTS TO SEWAGE DISPOSAL AREA IS NOT PERMITTED WITHOUT ADDITIONAL TESTING.
- THE LOT SHOWN HEREON COMPLIES WITH THE MINIMUM OWNERSHIP WIDTH AND LOT AREA AS REQUIRED BY THE MARYLAND STATE DEPARTMENT OF THE ENVIRONMENT.
- LOCATION OF ALL NEIGHBORING WELLS AND SEPTIC SYSTEMS WITHIN 100 FEET OF THE PROPERTY BOUNDARIES AS WELL AS ALL WELLS OR PROPOSED WELL SITES WITHIN 200 FEET DOWN GRADIENT OF THE SEPTIC DISPOSAL AREA.
- ALL HOUSE SITES SHOWN COMPLY WITH MINIMUM BUILDING RESTRICTION REGULATIONS.
- TOPOGRAPHY SHOWN IS COUNTY GIS DATA.
- BOUNDARY OUTLINE SHOWN IS COUNTY GIS DATA.
- ANY CHANGES TO A PRIVATE SEWERAGE DISPOSAL AREA SHALL REQUIRE A REVISED PERC CERTIFICATION PLAN.
- DEED REFERENCE LIBER 2512 FOLIO 464.
- ORIGINAL PERC CERTIFICATION SUBMITTED BY VANMAR ASSOCIATES INC. AND APPROVED ON 2/14/91.
- THE WELL HO-22-0139 HAS BEEN FIELD LOCATED AND IS ACCURATELY SHOWN.

PURPOSE NOTE:
THE PURPOSE OF THIS PERC CERTIFICATION PLAN IS TO RELOCATE THE WELL BOX.



PERC CERTIFICATION
I certify that the locations shown hereon are based on field locations done under my direct supervision and are correct to the best of my professional knowledge and belief.

Frank Manalansan II
Signature of Professional Land Surveyor
Fränk Manalansan II, Professional Land Surveyor No. 21476 Expires 7/14/25

3/14/25
Date

APPROVED FOR PRIVATE WATER AND PRIVATE SEWERAGE SYSTEMS

[Signature]
HOWARD COUNTY HEALTH OFFICER

3/13/25
DATE


REVISED PERCOLATION CERTIFICATION PLAN
1400 SHAFFERSVILLE ROAD
LOT 2

TX MAP #6 PARCEL 257
4TH ELECTION DISTRICT
SCALE: 1"=50'

ZONED RC-DEO
HOWARD COUNTY, MARYLAND
DATE: MARCH 13, 2025

FISHER, COLLINS & CARTER, INC.
CIVIL ENGINEERING CONSULTANTS & LAND SURVEYORS
CENTENNIAL SQUARE OFFICE PARK - 10272 BALTIMORE NATIONAL PIKE
ELLICOTT CITY, MARYLAND 21042
(410) 461 - 2855

SOILS LEGEND		
SOIL	NAME	CLASS
GgB	Gladstone loam, 3 to 8 percent slopes	A
GgC	Gladstone loam, 8 to 15 percent slopes	A

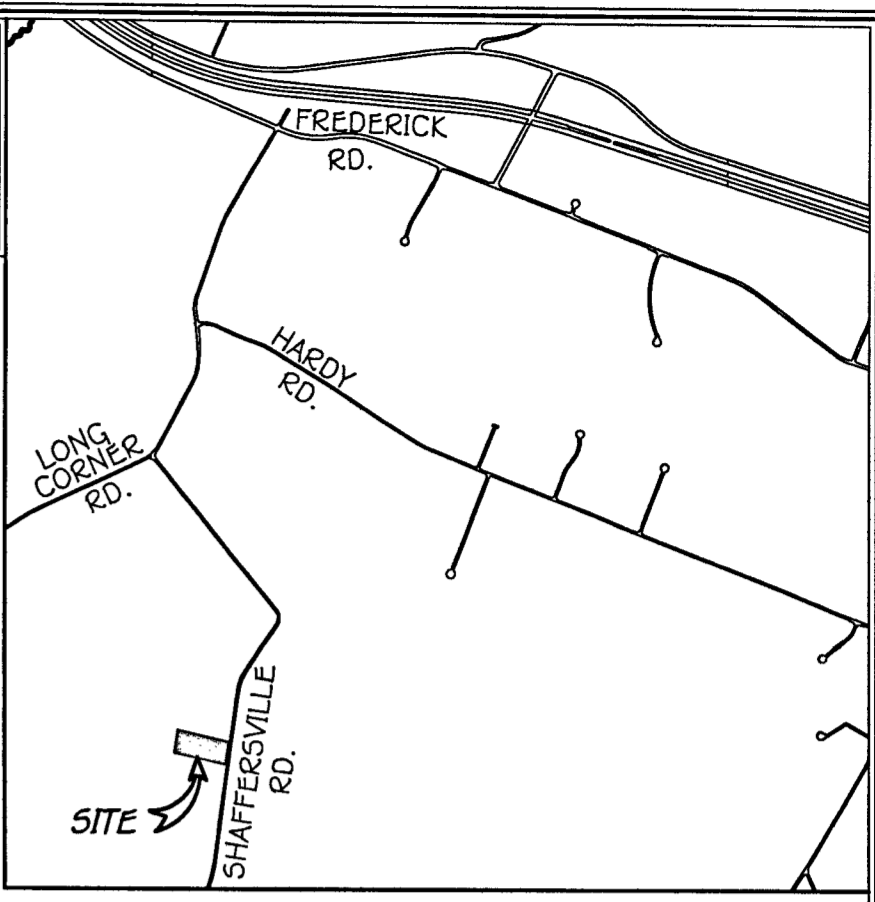

VICINITY MAP
SCALE: 1" = 2000'

- LEGEND**
- - - - - EXISTING 2' CONTOURS
 - - - - - EXISTING 10' CONTOURS
 - ~~~~~ EXISTING TREE LINE
 - SOIL LINES AND TYPES
 - ⊙ DENOTES PROPOSED WELL
 - DENOTES PASSED PERC
 - ⊗ DENOTES 1500 SQ.FT. ALTERNATE WELL SITE
 - ▨ DENOTES EXISTING SEWAGE DISPOSAL AREA


GENERAL NOTES:

1. THIS AREA DESIGNATES A PRIVATE SEWAGE DISPOSAL AREA OF 10000 SQ.FT AS REQUIRED BY THE MARYLAND STATE DEPARTMENT OF THE ENVIRONMENT FOR INDIVIDUAL SEWAGE DISPOSAL IMPROVEMENTS OF ANY NATURE IN THIS AREA ARE RESTRICTED. THIS SEWAGE DISPOSAL AREA SHALL BECOME NULL AND VOID UPON CONNECTION TO A PUBLIC SEWERAGE SYSTEM. THE COUNTY HEALTH OFFICER SHALL HAVE THE AUTHORITY TO GRANT ADJUSTMENTS TO THE PRIVATE SEWAGE DISPOSAL AREA. RECORDATION OF A REVISED SEWAGE DISPOSAL AREA SHALL NOT BE NECESSARY.
2. ADJUSTMENTS TO SEWAGE DISPOSAL AREA IS NOT PERMITTED WITHOUT ADDITIONAL TESTING.
3. THE LOT HEREON COMPLIES WITH THE MINIMUM OWNERSHIP WIDTH AND LOT AREA AS REQUIRED BY THE MARYLAND STATE DEPARTMENT OF THE ENVIRONMENT.
4. LOCATION OF ALL NEIGHBORING WELLS AND SEPTIC SYSTEMS WITHIN 100 FEET OF THE PROPERTY BOUNDARIES AS WELL AS ALL WELLS OR PROPOSED WELL SITES WITHIN 200 FEET DOWN GRADIENT OF THE SEPTIC DISPOSAL AREA.
5. ALL HOUSE SITES SHOWN COMPLY WITH MINIMUM BUILDING RESTRICTION REGULATIONS.
6. TOPOGRAPHY SHOWN IS COUNTY GIS DATA.
7. BOUNDARY OUTLINE SHOWN IS COUNTY GIS DATA.
8. ANY CHANGES TO A PRIVATE SEWAGE DISPOSAL AREA SHALL REQUIRE A REVISED PERC CERTIFICATION PLAN.
10. DEED REFERENCE LIBER 2512 FOLIO 464.
11. ORIGINAL PERC CERTIFICATION SUBMITTED BY VANMAR ASSOCIATES INC. AND APPROVED ON 2/14/91.

THE PURPOSE OF THIS PERC APPLICATION PLAN IS TO ESTABLISH A WELL BOX AND REESTABLISH A SEWAGE DISPOSAL AREA ON LOT 2.

PERCOLATION CERTIFICATION PLAN
1400 SCHAFFERSVILLE ROAD
LOT 2


TAX MAP #6 PARCEL 257 ZONED RC-DEO
4TH ELECTION DISTRICT HOWARD COUNTY, MARYLAND
SCALE: 1"=50' DATE: JUNE 10, 2024

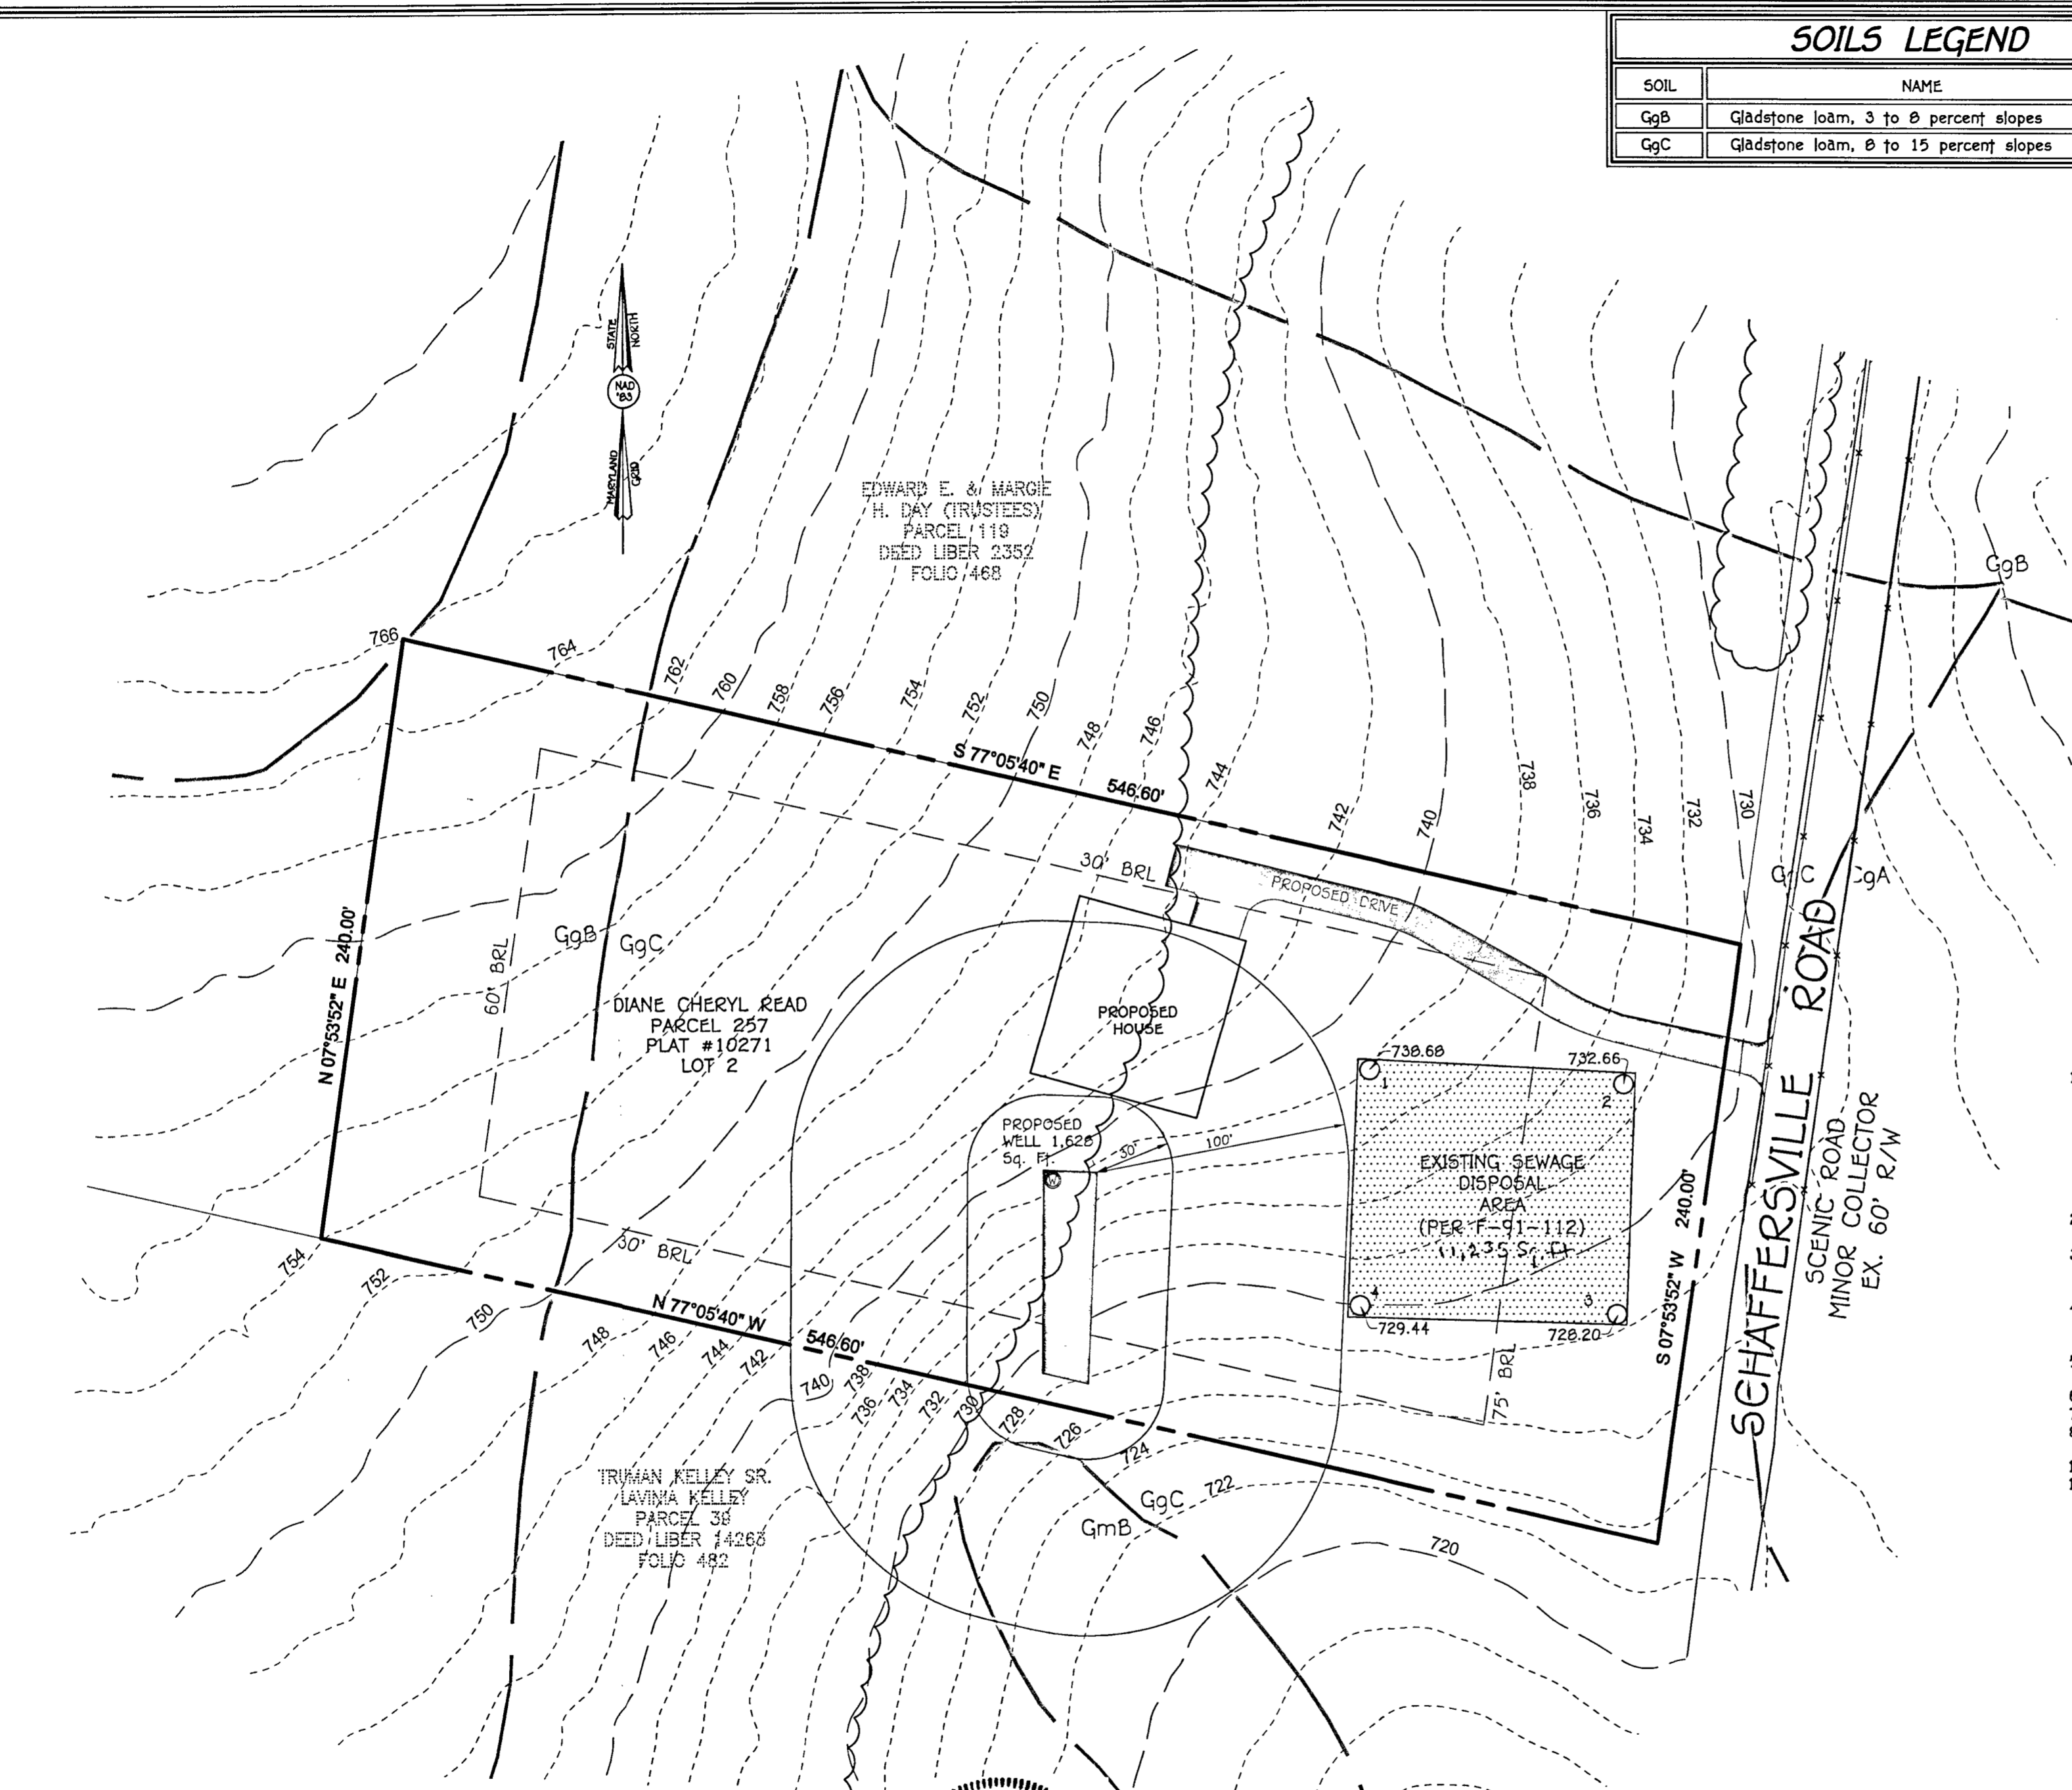

PERC CERTIFICATION
I certify that the locations shown hereon are based on direct supervision and are correct to the best of my knowledge and belief.

Frank M. Manalansan II
Signature of Professional Land Surveyor
Frank Manalansan II, Professional Land Surveyor No. 21476 Expires 7/14/25

6/12/24
Date

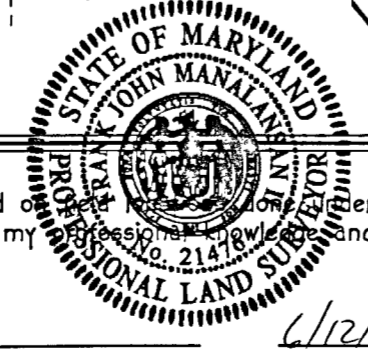


APPROVED FOR PRIVATE WATER AND PRIVATE SEWERAGE SYSTEMS

Howard County Health Officer
HOWARD COUNTY HEALTH OFFICER

6/26/24
DATE

FISHER, COLLINS & CARTER, INC.
CIVIL ENGINEERING CONSULTANTS & LAND SURVEYORS
CENTENNIAL SQUARE OFFICE PARK 10272 BALTIMORE NATIONAL PIKE
ELLCOTT CITY, MARYLAND 21042
(410) 461-2955

SOILS LEGEND		
SOIL	NAME	CLASS
GgB	Gladstone loam, 3 to 8 percent slopes	A
GgC	Gladstone loam, 8 to 15 percent slopes	A

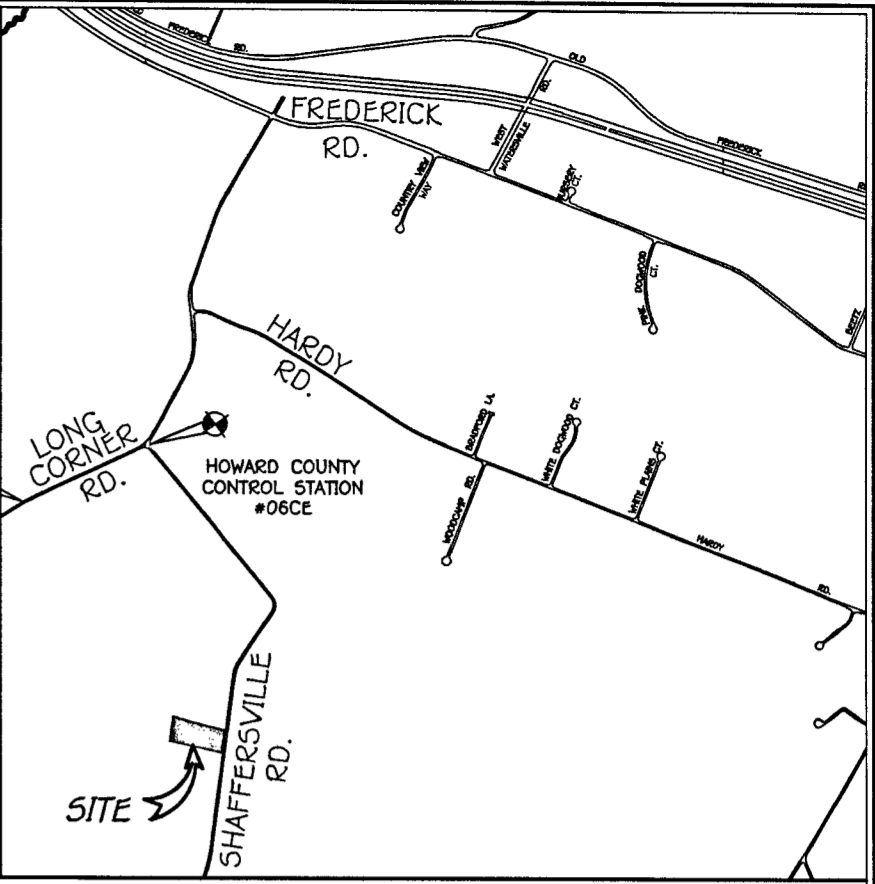

VICINITY MAP
SCALE: 1" = 2000'

LEGEND

- - - - - EXISTING 2' CONTOURS
- - - - - EXISTING 10' CONTOURS
- ~~~~~ EXISTING TREE LINE
- SOIL LINES AND TYPES
- ⊙ DENOTES EXISTING WELL
- DENOTES PASSED PERC
- ⊙ DENOTES PROPOSED 1500 Sq.Ft. ALTERNATE WELL SITE
- ▨ DENOTES EXISTING SEWAGE DISPOSAL AREA

GENERAL NOTES:

1. THIS AREA DESIGNATES A PRIVATE SEWAGE DISPOSAL AREA OF 10000 SQ.FT AS REQUIRED BY THE MARYLAND STATE DEPARTMENT OF THE ENVIRONMENT FOR INDIVIDUAL SEWAGE DISPOSAL IMPROVEMENTS OF ANY NATURE IN THIS AREA ARE RESTRICTED. THIS SEWAGE DISPOSAL AREA SHALL BECOME NULL AND VOID UPON CONNECTION TO A PUBLIC SEWERAGE SYSTEM. THE COUNTY HEALTH OFFICER SHALL HAVE THE AUTHORITY TO GRANT ADJUSTMENTS TO THE PRIVATE SEWAGE DISPOSAL AREA. RECORDATION OF A REVISED SEWAGE DISPOSAL AREA SHALL NOT BE NECESSARY.
2. ADJUSTMENTS TO SEWAGE DISPOSAL AREA IS NOT PERMITTED WITHOUT ADDITIONAL TESTING.
3. THE LOT SHOWN HEREON COMPLIES WITH THE MINIMUM OWNERSHIP WIDTH AND LOT AREA AS REQUIRED BY THE MARYLAND STATE DEPARTMENT OF THE ENVIRONMENT.
4. LOCATION OF ALL NEIGHBORING WELLS AND SEPTIC SYSTEMS WITHIN 100 FEET OF THE PROPERTY BOUNDARIES AS WELL AS ALL WELLS OR PROPOSED WELL SITES WITHIN 200 FEET DOWN GRADIENT OF THE SEPTIC DISPOSAL AREA.
5. ALL HOUSE SITES SHOWN COMPLY WITH MINIMUM BUILDING RESTRICTION REGULATIONS.
6. TOPOGRAPHY SHOWN IS COUNTY GIS DATA.
7. BOUNDARY OUTLINE SHOWN IS COUNTY GIS DATA.
8. ANY CHANGES TO A PRIVATE SEWERAGE DISPOSAL AREA SHALL REQUIRE A REVISED PERC CERTIFICATION PLAN
10. DEED REFERENCE LIBER 2512 FOLIO 464.
11. ORIGINAL PERC CERTIFICATION SUBMITTED BY VANMAR ASSOCIATES INC. AND APPROVED ON 2/14/91.
12. THE WELL HO-22-0139 HAS BEEN FIELD LOCATED AND IS ACCURATELY SHOWN.

PURPOSE NOTE:
THE PURPOSE OF THIS PERC CERTIFICATION PLAN IS TO RELOCATE THE WELL BOX.



REVISED PERCOLATION CERTIFICATION PLAN
1400 SHAFFERSVILLE ROAD
LOT 2

TAX MAP #6 PARCEL 257 ZONED RC-DEO
4TH ELECTION DISTRICT HOWARD COUNTY, MARYLAND
SCALE: 1"=50' DATE: MARCH 13, 2025


PERC CERTIFICATION
I certify that the locations shown hereon are based on field locations done under my direct supervision and are correct to the best of my professional knowledge and belief.

Frank Manalansan II 3/14/25
Signature of Professional Land Surveyor Date
Frank Manalansan II, Professional Land Surveyor No. 21476 Expires 7/14/25


APPROVED FOR PRIVATE WATER AND PRIVATE SEWERAGE SYSTEMS

Lavinia Kelley Sr. 3/18/25
HOWARD COUNTY HEALTH OFFICER DATE

FISHER, COLLINS & CARTER, INC.
CIVIL ENGINEERING CONSULTANTS & LAND SURVEYORS
CENTENNIAL SQUARE OFFICE PARK - 10272 BALTIMORE NATIONAL PIKE
ELLICOTT CITY, MARYLAND 21042
(410) 461 - 2855

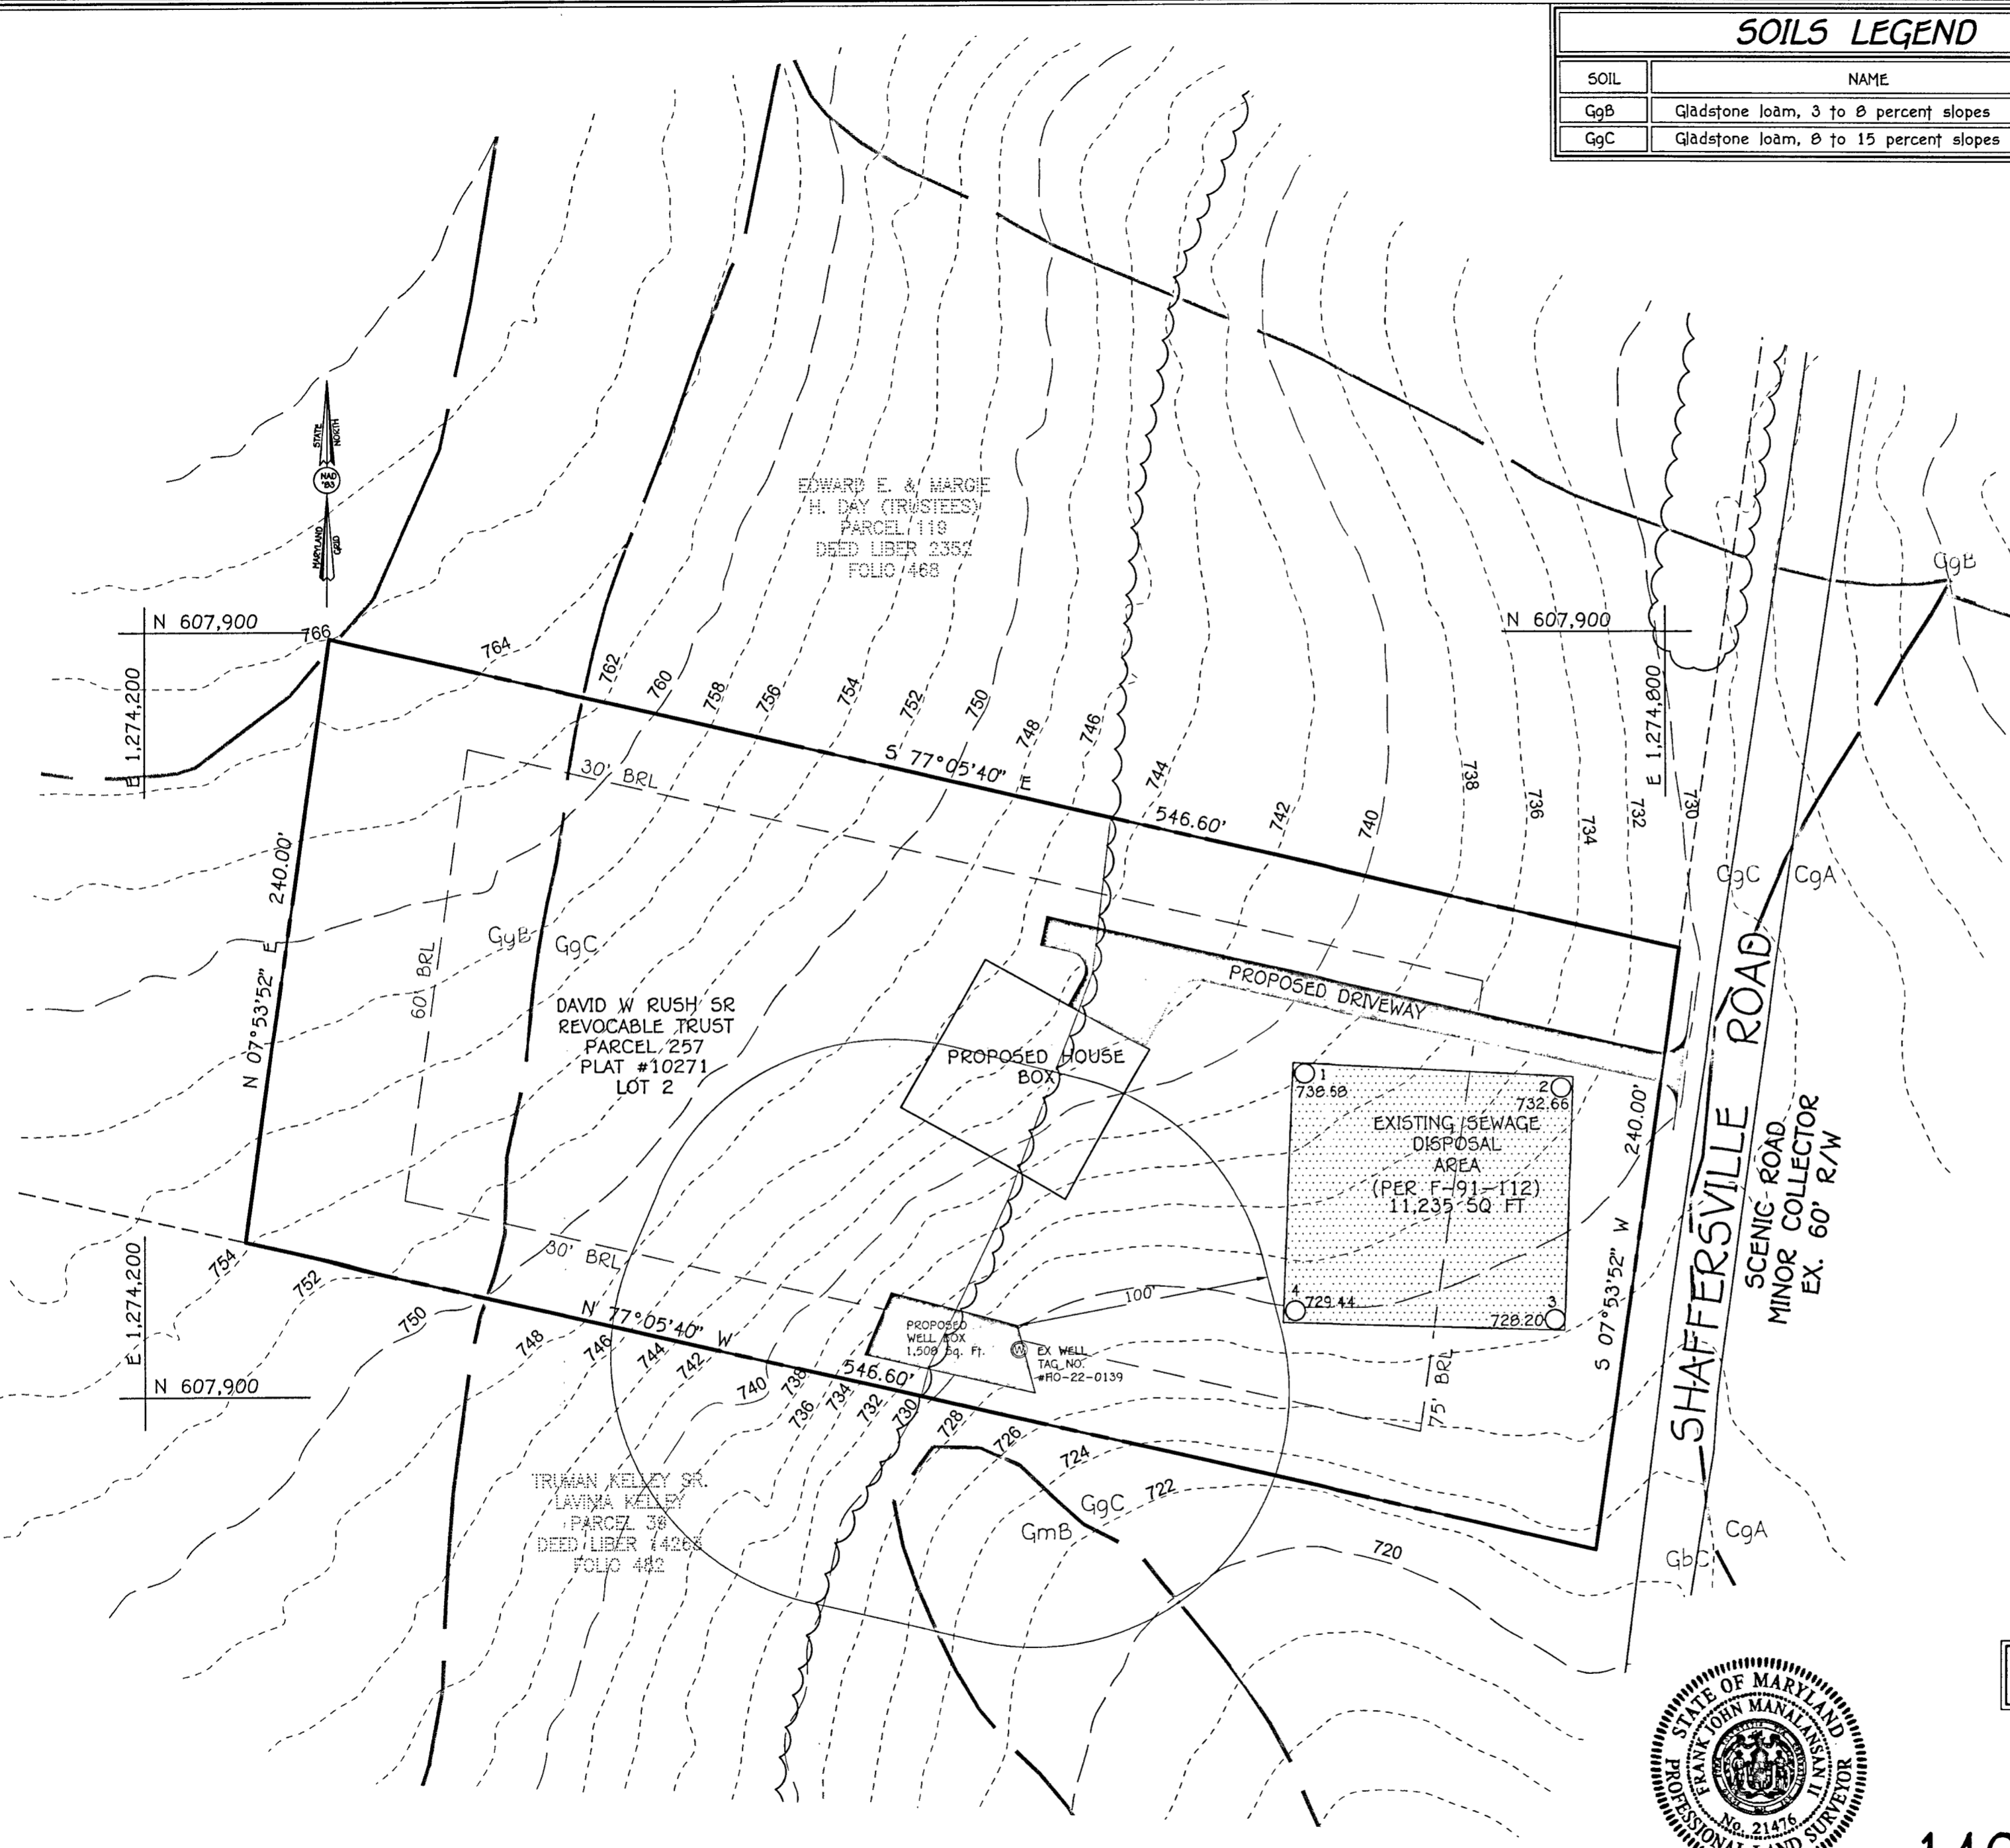

SOILS LEGEND		
SOIL	NAME	CLASS
GgB	Gladstone loam, 3 to 8 percent slopes	A
GgC	Gladstone loam, 8 to 15 percent slopes	A

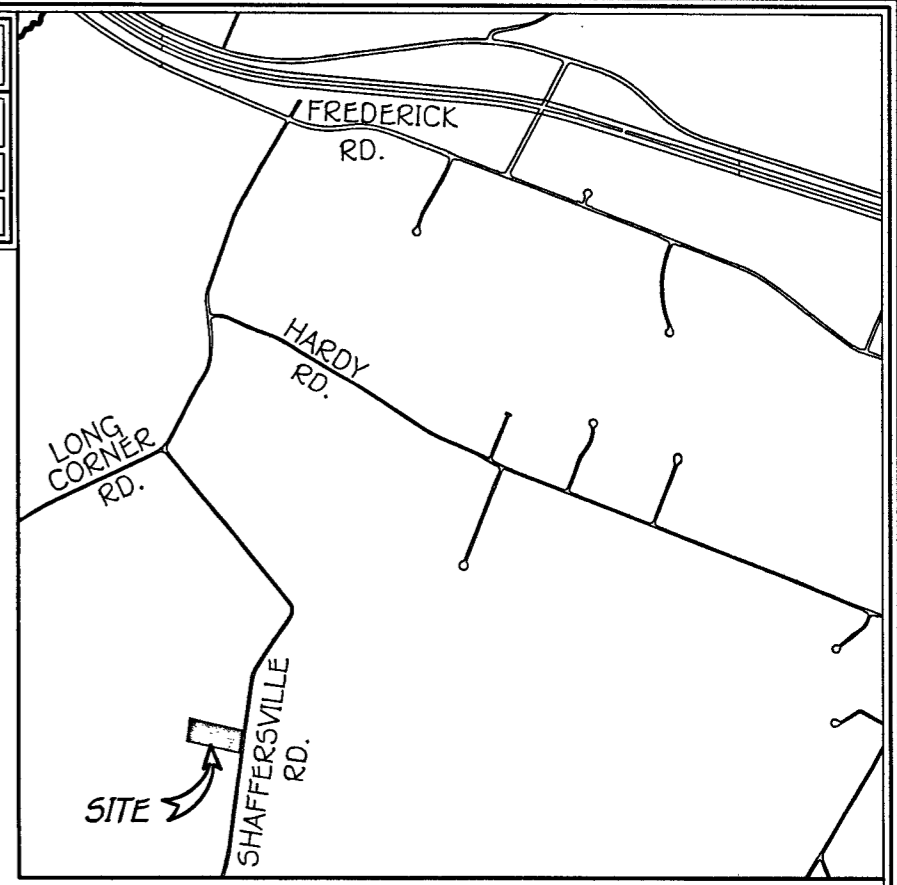

VICINITY MAP
SCALE: 1" = 2000'

LEGEND	
---	EXISTING 2' CONTOURS
---	EXISTING 10' CONTOURS
---	EXISTING TREE LINE
---	SOIL LINES AND TYPES
⊙	DENOTES EXISTING WELL
⊕	DENOTES PROPOSED PERC/TEST PIT
○	DENOTES FAILED PERC
○	DENOTES PASSED PERC
⊙	DENOTES 1500 Sq.Ft. ALTERNATE WELL SITE
▨	DENOTES EXISTING SEWAGE DISPOSAL AREA

GENERAL NOTES:

- THIS AREA DESIGNATES A PRIVATE SEWAGE DISPOSAL AREA OF 10000 SQ.FT OR IF PRIOR TO MARCH 1972, AT LEAST ENOUGH AREA TO ACCOMMODATE AN INITIAL AND TWO REPLACEMENT SYSTEMS AS REQUIRED BY THE MARYLAND STATE DEPARTMENT OF THE ENVIRONMENT FOR INDIVIDUAL SEWAGE DISPOSAL AREAS. IMPROVEMENTS OF ANY NATURE IN THIS AREA ARE RESTRICTED UNTIL PUBLIC SEWERAGE IS AVAILABLE. THESE AREAS SHALL BECOME NULL AND VOID UPON CONNECTION TO A PUBLIC SEWERAGE SYSTEM. THE COUNTY HEALTH OFFICER SHALL HAVE THE AUTHORITY TO GRANT ADJUSTMENTS TO THE PRIVATE SEWAGE DISPOSAL AREA. RECORDATION OF A MODIFIED SEWAGE DISPOSAL AREA SHALL NOT BE NECESSARY.
- ADJUSTMENTS TO SEWAGE DISPOSAL AREA IS NOT PERMITTED WITHOUT ADDITIONAL TESTING.
- THE LOT SHOWN HEREON COMPLIES WITH THE MINIMUM OWNERSHIP WIDTH AND LOT AREA AS REQUIRED BY THE MARYLAND STATE DEPARTMENT OF THE ENVIRONMENT.
- LOCATION OF ALL NEIGHBORING WELLS AND SEPTIC SYSTEMS WITHIN 100 FEET OF THE PROPERTY BOUNDARIES AS WELL AS ALL WELLS OR PROPOSED WELL SITES WITHIN 200 FEET DOWN GRADIENT OF THE SEPTIC DISPOSAL AREA.
- ALL HOUSE SITES SHOWN COMPLY WITH MINIMUM BUILDING RESTRICTION REGULATIONS.
- TOPOGRAPHY SHOWN IS COUNTY GIS DATA.
- BOUNDARY OUTLINE SHOWN IS COUNTY GIS DATA.
- ANY CHANGES TO A PRIVATE SEWERAGE DISPOSAL AREA SHALL REQUIRE A REVISED PERC CERTIFICATION PLAN.
- DEED REFERENCE LIBER 2512 FOLIO 464.
- ORIGINAL PERC CERTIFICATION SUBMITTED BY VANMAR ASSOCIATES INC. AND APPROVED ON 2/14/91.

PERC RE-CERTIFICATION PLAN

1400 SCHAFFERSVILLE ROAD

LOT 2

TAX MAP #6 PARCEL 257
4TH ELECTION DISTRICT
SCALE: 1"=50'

ZONED RC-DEO
HOWARD COUNTY, MARYLAND
DATE: JUNE 4, 2024

PERC CERTIFICATION
I certify that the locations shown hereon are based on direct supervision and are correct to the best of my professional judgment and belief.

Signature of Professional Land Surveyor
Frank Manalansan II, Professional Land Surveyor No. 21476 Expires 7/14/25

Date




THE PURPOSE OF THIS PERC APPLICATION PLAN IS TO REVISE THE WELL BOX ON LOT 2.

FISHER, COLLINS & CARTER, INC.
CIVIL ENGINEERING CONSULTANTS & LAND SURVEYORS
CENTENNIAL SQUARE OFFICE PARK - 10272 BALTIMORE NATIONAL PIKE
ELLCOTT CITY, MARYLAND 21042
(410) 461 - 2855

I:\2006\06089\Engineering\Drawings\Peric App 6-3-24.dwg, 6/5/2024 9:46:08 AM, DWG To PDF.pc3

SOILS LEGEND		
SOIL	NAME	CLASS
GgB	Gladstone loam, 3 to 8 percent slopes	A
GgC	Gladstone loam, 8 to 15 percent slopes	A

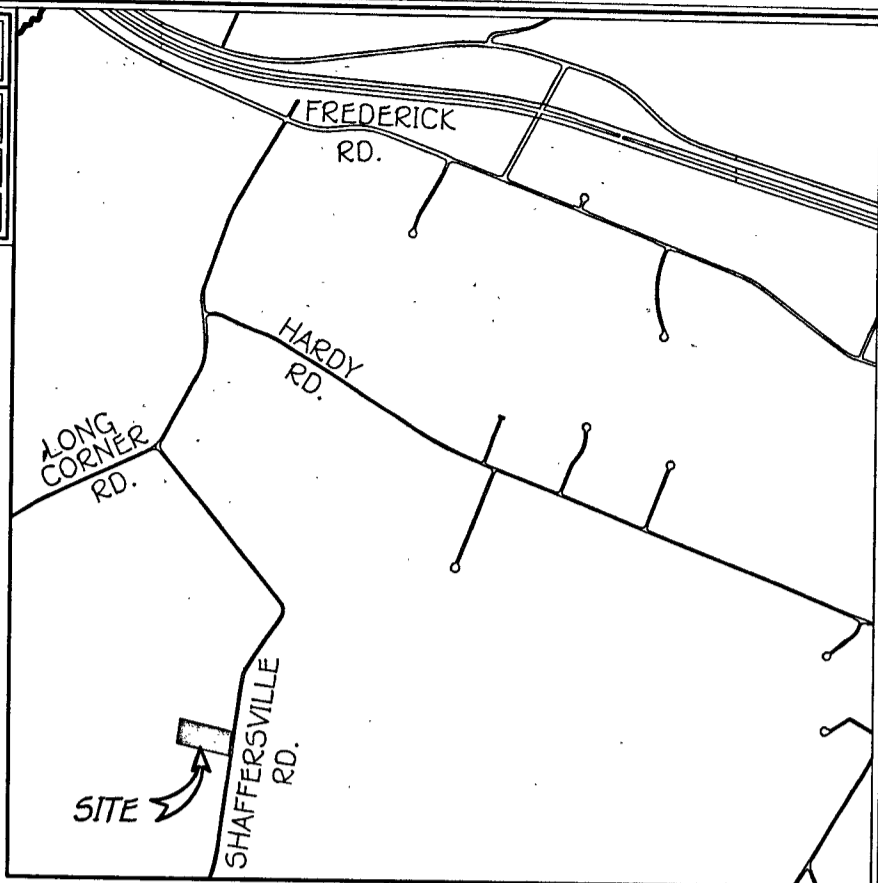

VICINITY MAP
SCALE: 1" = 2000'

LEGEND	
- - - - -	EXISTING 2' CONTOURS
- - - - -	EXISTING 10' CONTOURS
~~~~~	EXISTING TREE LINE
GgB GgC	SOIL LINES AND TYPES
⊙	DENOTES EXISTING WELL
⊕	DENOTES PROPOSED PERC/TEST PIT
○	DENOTES FAILED PERC
○	DENOTES PASSED PERC
⊠	DENOTES 1500 Sq.Ft. ALTERNATE WELL SITE
▨	DENOTES EXISTING SEWAGE DISPOSAL AREA



**GENERAL NOTES:**

- THIS AREA DESIGNATES A PRIVATE SEWAGE DISPOSAL AREA OF 10000 SQ.FT OR IF PRIOR TO MARCH 1972, AT LEAST ENOUGH AREA TO ACCOMMODATE AN INITIAL AND TWO REPLACEMENT SYSTEMS AS REQUIRED BY THE MARYLAND STATE DEPARTMENT OF THE ENVIRONMENT FOR INDIVIDUAL SEWAGE DISPOSAL AREAS. IMPROVEMENTS OF ANY NATURE IN THIS AREA ARE RESTRICTED UNTIL PUBLIC SEWERAGE IS AVAILABLE. THESE AREAS SHALL BECOME NULL AND VOID UPON CONNECTION TO A PUBLIC SEWERAGE SYSTEM. THE COUNTY HEALTH OFFICER SHALL HAVE THE AUTHORITY TO GRANT ADJUSTMENTS TO THE PRIVATE SEWAGE DISPOSAL AREA. RECORDATION OF A MODIFIED SEWAGE DISPOSAL AREA SHALL NOT BE NECESSARY.
- ADJUSTMENTS TO SEWAGE DISPOSAL AREA IS NOT PERMITTED WITHOUT ADDITIONAL TESTING.
- THE LOT SHOWN HEREON COMPLIES WITH THE MINIMUM OWNERSHIP WIDTH AND LOT AREA AS REQUIRED BY THE MARYLAND STATE DEPARTMENT OF THE ENVIRONMENT.
- LOCATION OF ALL NEIGHBORING WELLS AND SEPTIC SYSTEMS WITHIN 100 FEET OF THE PROPERTY BOUNDARIES AS WELL AS ALL WELLS OR PROPOSED WELL SITES WITHIN 200 FEET DOWN GRADIENT OF THE SEPTIC DISPOSAL AREA.
- ALL HOUSE SITES SHOWN COMPLY WITH MINIMUM BUILDING RESTRICTION REGULATIONS.
- TOPOGRAPHY SHOWN IS COUNTY GIS DATA.
- BOUNDARY OUTLINE SHOWN IS COUNTY GIS DATA.
- ANY CHANGES TO A PRIVATE SEWERAGE DISPOSAL AREA SHALL REQUIRE A REVISED PERC CERTIFICATION PLAN.
- DEED REFERENCE LIBER 2512 FOLIO 464.
- ORIGINAL PERC CERTIFICATION SUBMITTED BY VANMAR ASSOCIATES INC. AND APPROVED ON 2/14/91.

**PERC RE-CERTIFICATION PLAN**  
**1400 SCHAFFERSVILLE ROAD**  
**LOT 2**

TAX MAP #6 PARCEL 257  
4TH ELECTION DISTRICT  
SCALE: 1"=50'

ZONED RC-DEO  
HOWARD COUNTY, MARYLAND  
DATE: JUNE 4, 2024

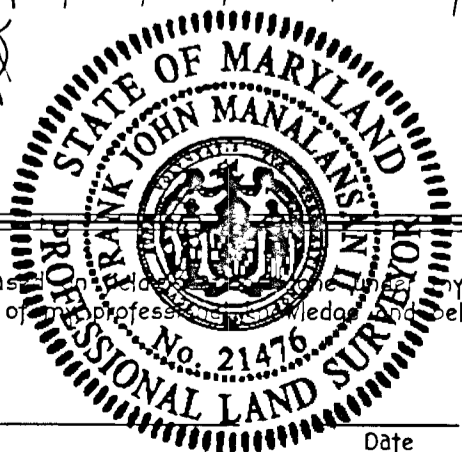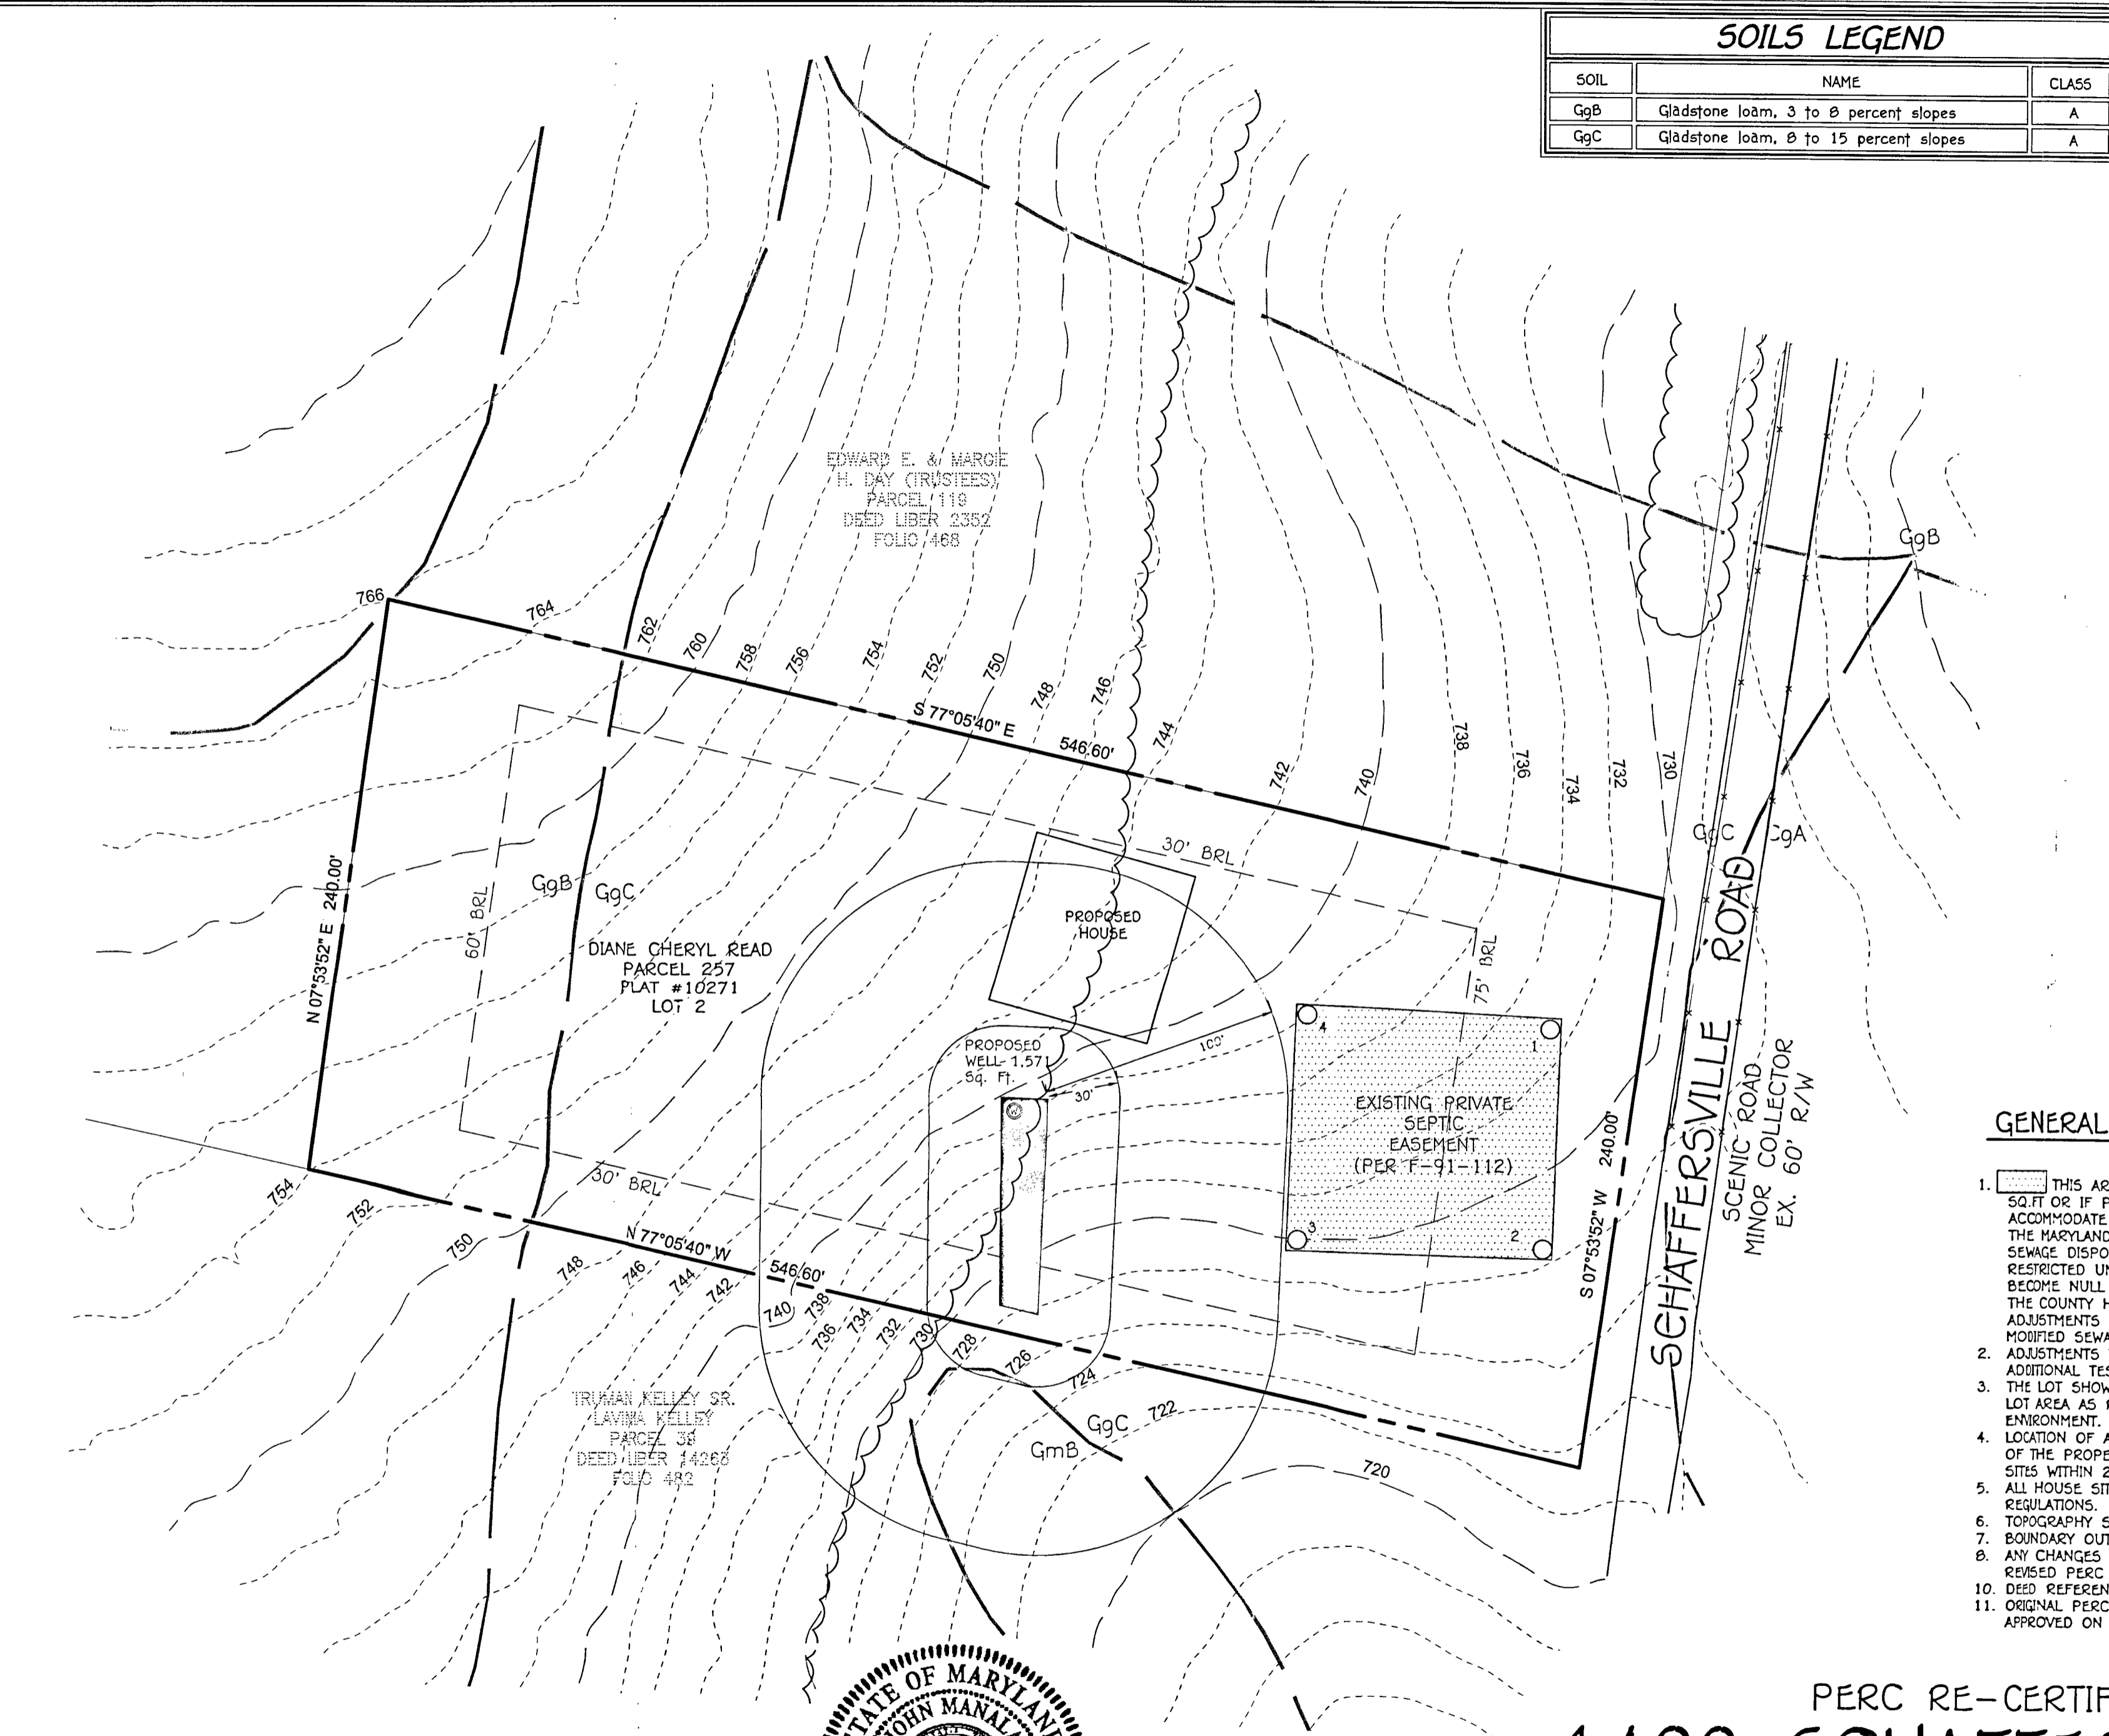


PERC CERTIFICATION  
I certify that the locations shown hereon are based on direct supervision and are correct to the best of my knowledge and belief.

Signature of Professional Land Surveyor _____ Date _____  
Frank Manalansan II, Professional Land Surveyor No. 21476 Expires 7/14/25

THE PURPOSE OF THIS PERC APPLICATION PLAN IS TO REVISE THE WELL BOX ON LOT 2.

**FISHER, COLLINS & CARTER, INC.**  
CIVIL ENGINEERING CONSULTANTS & LAND SURVEYORS  
CENTENNIAL SQUARE OFFICE PARK - 10272 BALTIMORE NATIONAL PIKE  
ELLCOTT CITY, MARYLAND 21042  
(410) 461-2895

SOILS LEGEND		
SOIL	NAME	CLASS
GgB	Gladstone loam, 3 to 8 percent slopes	A
GgC	Gladstone loam, 8 to 15 percent slopes	A

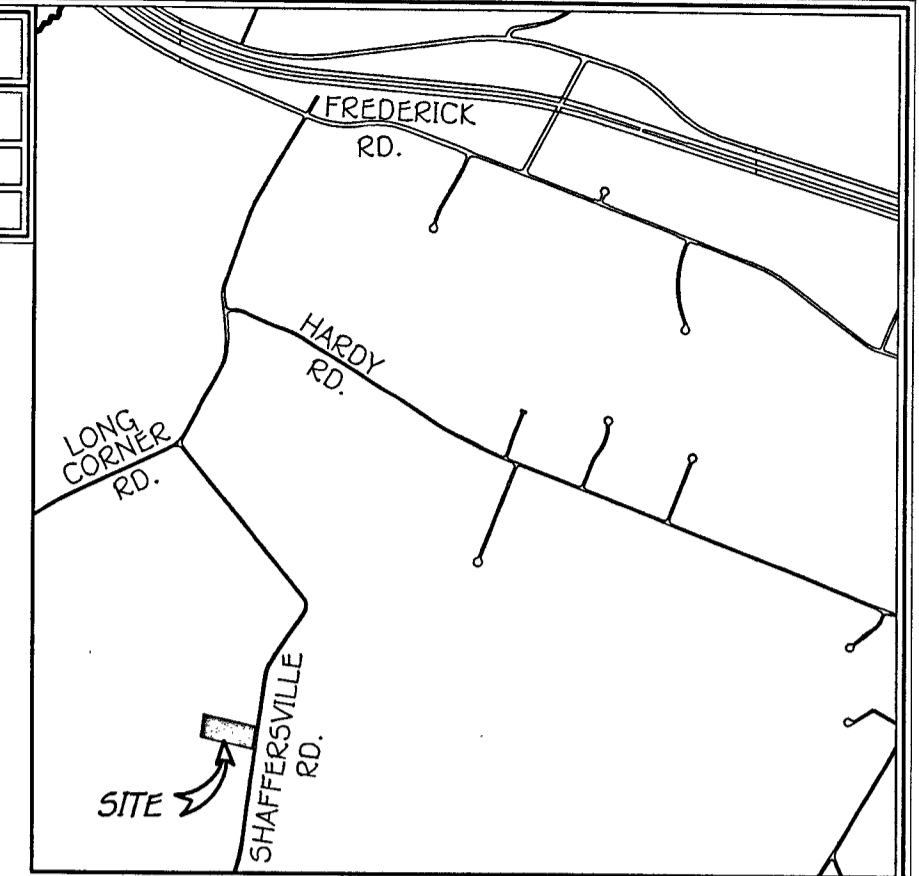

VICINITY MAP  
SCALE: 1" = 2000'

LEGEND

- EXISTING 2' CONTOURS
- - - EXISTING 10' CONTOURS
- ~ ~ ~ EXISTING TREE LINE
- MLC2 SOIL LINES AND TYPES
- ⊙ DENOTES EXISTING WELL
- ⊕ DENOTES PROPOSED PERC/TEST PIT
- DENOTES FAILED PERC
- DENOTES PASSED PERC
- DENOTES 1500 Sq.Ft. ALTERNATE WELL SITE
- ▨ DENOTES EXISTING SEWAGE DISPOSAL AREA

GENERAL NOTES:

- THIS AREA DESIGNATES A PRIVATE SEWAGE DISPOSAL AREA OF 10000 SQ.FT OR IF PRIOR TO MARCH 1972, AT LEAST ENOUGH AREA TO ACCOMMODATE AN INITIAL AND TWO REPLACEMENT SYSTEMS AS REQUIRED BY THE MARYLAND STATE DEPARTMENT OF THE ENVIRONMENT FOR INDIVIDUAL SEWAGE DISPOSAL AREAS. IMPROVEMENTS OF ANY NATURE IN THIS AREA ARE RESTRICTED UNTIL PUBLIC SEWERAGE IS AVAILABLE. THESE AREAS SHALL BECOME NULL AND VOID UPON CONNECTION TO A PUBLIC SEWERAGE SYSTEM. THE COUNTY HEALTH OFFICER SHALL HAVE THE AUTHORITY TO GRANT ADJUSTMENTS TO THE PRIVATE SEWAGE DISPOSAL AREA. RECORDATION OF A MODIFIED SEWAGE DISPOSAL AREA SHALL NOT BE NECESSARY.
- ADJUSTMENTS TO SEWAGE DISPOSAL AREA IS NOT PERMITTED WITHOUT ADDITIONAL TESTING.
- THE LOT SHOWN HEREON COMPLIES WITH THE MINIMUM OWNERSHIP WIDTH AND LOT AREA AS REQUIRED BY THE MARYLAND STATE DEPARTMENT OF THE ENVIRONMENT.
- LOCATION OF ALL NEIGHBORING WELLS AND SEPTIC SYSTEMS WITHIN 100 FEET OF THE PROPERTY BOUNDARIES AS WELL AS ALL WELLS OR PROPOSED WELL SITES WITHIN 200 FEET DOWN GRADIENT OF THE SEPTIC DISPOSAL AREA.
- ALL HOUSE SITES SHOWN COMPLY WITH MINIMUM BUILDING RESTRICTION REGULATIONS.
- TOPOGRAPHY SHOWN IS COUNTY GIS DATA.
- BOUNDARY OUTLINE SHOWN IS COUNTY GIS DATA.
- ANY CHANGES TO A PRIVATE SEWAGE DISPOSAL AREA SHALL REQUIRE A REVISED PERC CERTIFICATION PLAN.
- DEED REFERENCE LIBER 2512 FOLIO 464.
- ORIGINAL PERC CERTIFICATION SUBMITTED BY VANMAR ASSOCIATES INC. AND APPROVED ON 2/14/91.


# PERC RE-CERTIFICATION PLAN

## 1400 SCHAFFERSVILLE ROAD

### LOT 2

TAX MAP #6 PARCEL 257  
4TH ELECTION DISTRICT  
SCALE: 1"=50'

ZONED RC-DEO  
HOWARD COUNTY, MARYLAND  
DATE: JUNE 4, 2024

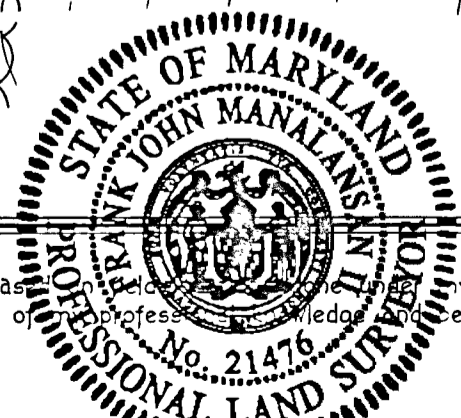

PERC CERTIFICATION  
I certify that the locations shown hereon are based on direct supervision and are correct to the best of my knowledge and belief.

Signature of Professional Land Surveyor  
Frank Manalansan II, Professional Land Surveyor No. 21476 Expires 7/14/25

Date

THE PURPOSE OF THIS PERC APPLICATION PLAN IS TO REVISE THE WELL BOX ON LOT 2.

**FISHER, COLLINS & CARTER, INC.**  
CIVIL ENGINEERING CONSULTANTS & LAND SURVEYORS  
CENTENNIAL SQUARE OFFICE PARK - 10272 BALTIMORE NATIONAL PIKE  
ELLCOTT CITY, MARYLAND 21042  
(410) 461 - 2955