

HOWARD COUNTY
PERMIT APPLICATION

PERMIT NUMBER

B07003616

Building Address 1825 Woodstock Rd
Woodstock MD

Suite/Apt. #: _____ SDP/WP/Petition #: _____

Census Tract _____ Subdivision _____

Section _____ Area _____ Lot _____

Tax Map _____ Parcel _____ Grid _____

Zoning _____ Map Coordinates _____ Lot size _____

Existing Use _____

Proposed Use Deck

Estimated Construction Cost \$ 7000.00

Description of Work Construct two side by side
decks 16'x20' + 12'x12'

Occupant or Tenant Property Owner

Contact Name _____

Address _____

City _____ State _____ Zip Code _____

Phone _____ Fax _____

Property Owner's Name Phillip Blaney

Address 1825 Woodstock Rd

City Woodstock State MD Zip Code 21163

Home Phone 410-750-7815 Work Phone 410-313-6000

Applicant's Name & Mailing Address, (if other than stated hereon): _____

Phone _____ Fax _____

Contractor Company Self

Contact Person _____

Address _____

City _____ State _____ Zip Code _____

License No. _____

Phone _____ Fax _____

Engineer or Architect Company _____

Contact Person _____

Address _____

City _____ State _____ Zip Code _____

Phone _____ Fax _____

BUILDING DESCRIPTION - COMMERCIAL

Building Characteristics

Height: _____

No. of stories: _____

Gross area, sq. ft. per floor: _____

Use group: _____

Construction type:

☐ Reinforced Concrete
☐ Structural Steel
☐ Masonry
☐ Wood Frame

☐ State Certified Modular

Utilities

Water Supply:

☐ Public
☐ Private

Sewage Disposal:

☐ Public
☐ Private

Electric Yes ☐ No ☐

Gas Yes ☐ No ☐

Heating System:

Electric ☐ Oil ☐

Natural Gas ☐

Propane Gas ☐

Sprinkler system: N/A ☐

☐ Full

☐ Partial

☐ Other Suppression

of Heads _____

BUILDING DESCRIPTION - RESIDENTIAL

Building Characteristics

SF Dwelling ☐ SF Townhouse ☐

Depth _____ Width _____

1st floor: _____

2nd floor: _____

Basement: _____

Finished Basement ☐ Unfinished Basement ☐

Crawl space ☐ Slab on Grade ☐

No. of Bedrooms _____

Height: _____

Multi-family dwellings:

No. of efficiency units: _____

No. of 1 BR units: _____

No. of 2 BR units: _____

No. of 3 BR units: _____

Other Structure: Deck

Dimensions: 16' x 20' + 12' x 12'

Footings: 12" x 12" x 8"

Roof Height: N/A

☐ State Certified Modular

☐ Manufactured Home

Utilities

Water Supply:

☐ Public
☒ Private

Sewage Disposal:

☐ Public
☒ Private

Electric Yes ☐ No ☐

Gas Yes ☐ No ☐

Heating System:

Electric ☐ Oil ☐

Natural Gas ☐

Propane Gas ☐

Sprinkler system: N/A ☐

☐ NFPA #13D

☐ NFPA #13R

☐ Other: _____

THE UNDERSIGNED HEREBY CERTIFIES AND AGREES AS FOLLOWS: (1) THAT HE/SHE IS AUTHORIZED TO MAKE THIS APPLICATION; (2) THAT THE INFORMATION IS CORRECT; (3) THAT HE/SHE WILL COMPLY WITH ALL REGULATIONS OF HOWARD COUNTY WHICH ARE APPLICABLE THERETO; (4) THAT HE/SHE WILL PERFORM NO WORK ON THE ABOVE REFERENCED PROPERTY NOT SPECIFICALLY DESCRIBED IN THIS APPLICATION; (5) THAT HE/SHE GRANTS COUNTY OFFICIALS THE RIGHT TO ENTER ONTO THIS PROPERTY FOR THE PURPOSE OF INSPECTING THE WORK PERMITTED AND POSTING NOTICES.

Phillip J. Blaney
Applicant's Signature
Owner
Title/Company

Phillip J. Blaney
Print Name
8/30/09
Date


Checks payable to: **DIRECTOR OF FINANCE OF HOWARD COUNTY**
** PLEASE WRITE NEATLY AND LEGIBLY. **

FOR OFFICE USE ONLY

AGENCY Health Department DATE 8/30/2007 SIGNATURE Shirley A. Galt
Land Development, DPZ
State Highways
Building Official
Dev. Engineering, DPZ
Health
Fire Protection
Is Sediment Control approval required prior to issuance?
YES ☐ NO ☐


DPZ SETBACK INFORMATION
Front: _____ Filing fee \$
Rear: _____ Permit fee \$
Side: _____ Excise tax \$
Side St: _____ Add'l per. fee \$
All minimum setbacks met? TOTAL FEES \$
YES ☐ NO ☐ Sub-total paid \$
Is Entrance Permit required? Balance due \$
YES ☐ NO ☐ Check \$
Historic District? Validation \$
YES ☐ NO ☐
Lot Coverage for NewTown Zone _____
SDP/Red-line approval date _____ Accepted by _____

Distribution of Copies: White: Building Official Green: LDD, DPZ Yellow: DED, DPZ Pink: Health Gold: SHA
T:\home\PERMIT.FRM

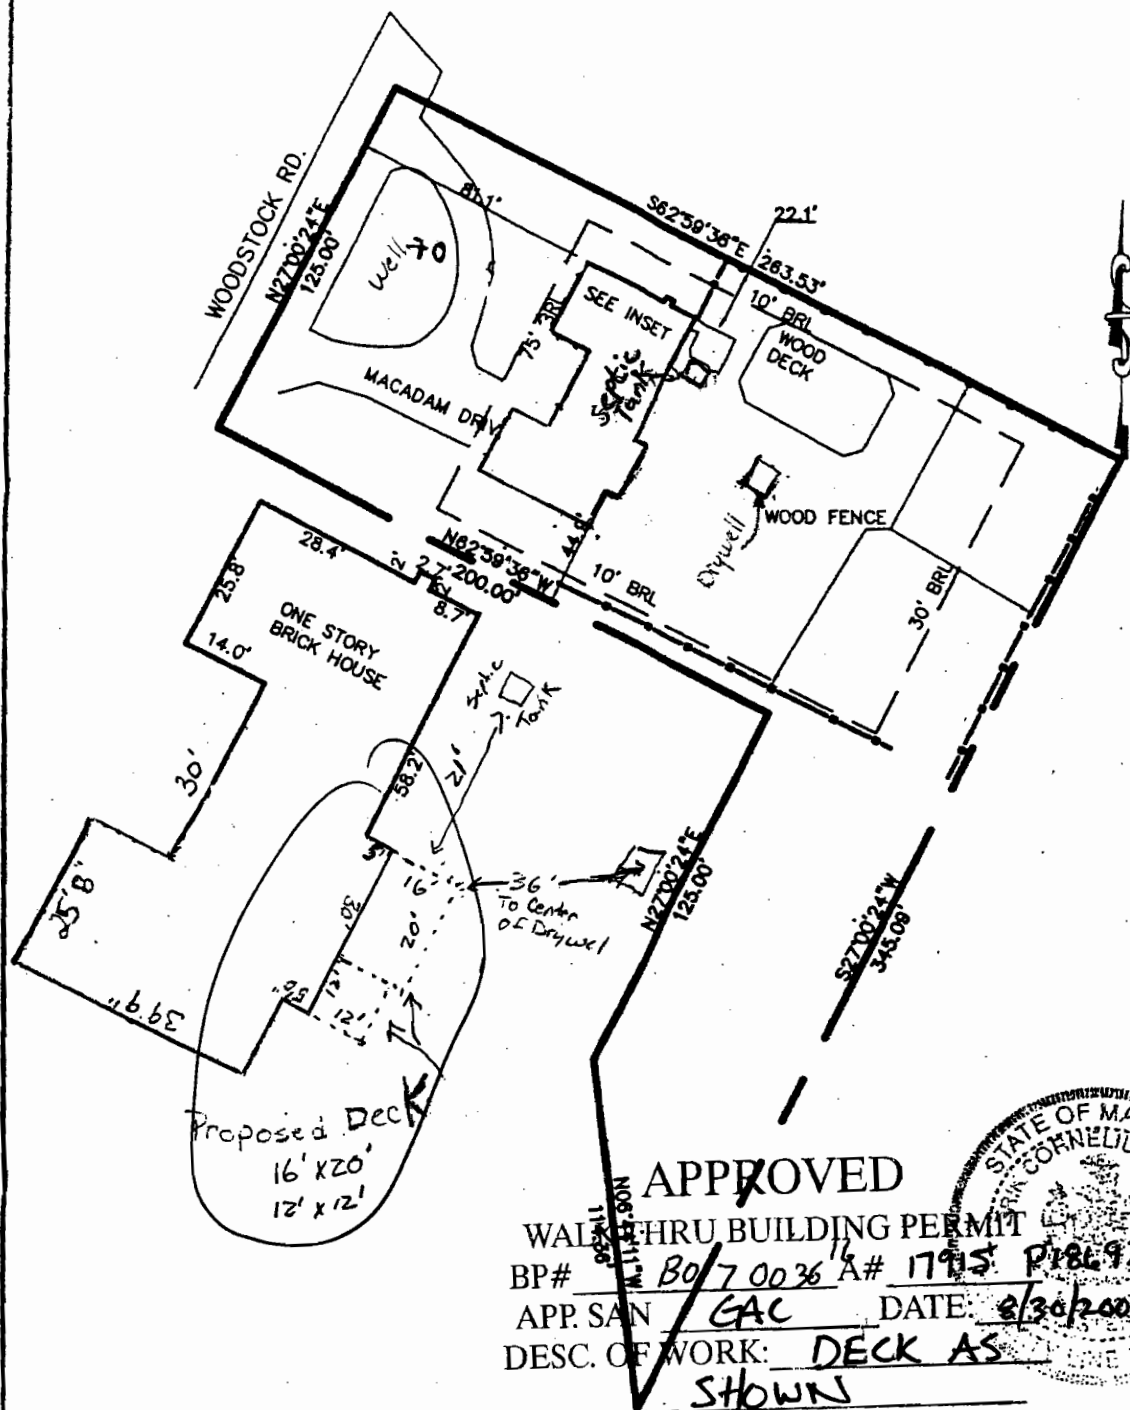

APPROVED

WALK-THRU BUILDING PERMIT
BP# B070036 A# 1795 P18692
APP. SAN CAC DATE: 8/30/2007
DESC. OF WORK: DECK AS SHOWN

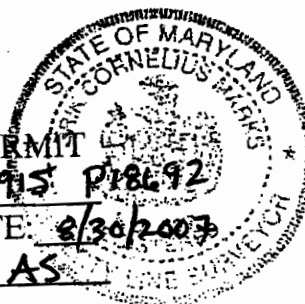

RECORD REFERENCES	LOCATION SURVEY	MARKS & ASSOCIATES L.L.C. SURVEYORS—LAND PLANNING CONSULTANTS 4531 COLLEGE AVENUE ELICOTT CITY, MARYLAND TELEPHONE (410)747-8738 FAX (410)747-8547 I HEREBY CERTIFY THAT THE IMPROVEMENTS ARE LOCATED AS SHOWN HEREON AND TO THE BEST OF MY KNOWLEDGE AND BELIEF, THERE ARE NO ENCROACHMENTS EXCEPT AS SHOWN. <u>Erik C. Marks</u> ERIK C. MARKS R.P.L.S. NO. 607
LIBER/FOLIO 2942/561 PLAT BOOK/FOLIO PLAT NO.	1825 WOODSTOCK ROAD WOODSTOCK, MD 21163	
SCALE: 1"=60' DATE: FEBRUARY 10, 2006	HOWARD COUNTY, MARYLAND	

HOWARD COUNTY
PERMIT APPLICATION

PERMIT NUMBER

B00138689

Building Address 1825 Woodstock Rd
Woodstock, MD 21163
Suite/Apt. #: _____ SDP/WP/Petition #: _____
Census Tract 103000 Subdivision Woodstock 11
Section 111 Area 111 Lot 111
Tax Map 10 Parcel 42 Grid 24
Zoning R-50 Map Coordinates _____ Lot size 111

Property Owner's Name Phillip J. Blaney
Address 1825 Woodstock Rd
City Woodstock State MD Zip Code 21163
Home Phone 410 750 7815 Work Phone 410 313 7310
Applicant's Name & Mailing Address, (if other than stated hereon): _____
Phone _____ Fax _____

Existing Use Single Family Home
Proposed Use Single Family Home
Estimated Construction Cost \$ 100,000.00
Description of Work 2 Story Addition to include Garage, 2 Car
Garage, Relocate Kitchen, Unfinished
TV/Game Room + Office, Rear Porch
Remodeling

Contractor Company Owner
Contact Person Phillip Blaney
Address 1825 Woodstock Rd
City Woodstock State MD Zip Code 21163
License No. 111
Phone 410 750 7815 Fax _____

Occupant or Tenant Phillip J. Blaney
Contact Name Phillip Blaney
Address 1825 Woodstock Rd
City Woodstock State MD Zip Code 21163
Phone 410 750 7815 Fax _____

Engineer or Architect Company Owner
Contact Person Phillip J. Blaney
Address _____
City _____ State _____ Zip Code _____
Phone _____ Fax _____

BUILDING DESCRIPTION - COMMERCIAL

BUILDING DESCRIPTION - RESIDENTIAL

Building Characteristics	Utilities
Height: _____	Water Supply: _____
No. of stories: _____	Public _____
Gross area, sq. ft. per floor: _____	Private _____
Use group: _____	Sewage Disposal: _____
Construction type: _____	Public _____
Reinforced Concrete _____	Private _____
Structural Steel _____	Electric Yes ☐ No ☐
Masonry _____	Gas Yes ☐ No ☐
Wood Frame _____	Heating System: _____
State Certified Modular _____	Electric ☐ Oil ☐
	Natural Gas ☐
	Propane Gas ☐
	Sprinkler system: N/A ☐
	Full _____
	Partial _____
	Other Suppression _____
	# of Heads _____

Building Characteristics	Utilities
SF Dwelling ☒ SF Townhouse ☐	Water Supply: _____
Depth _____ Width _____	Public _____
1st floor: _____	Private ☒
2nd floor: _____	Sewage Disposal: _____
Basement: _____	Public _____
Finished Basement ☐ Unfinished Basement ☒	Private ☒
Crawl space ☐ Slab on Grade ☐	Electric Yes ☒ No ☐
No. of Bedrooms <u>3</u>	Gas Yes ☐ No ☐
Height: _____	Heating System: _____
Multi-family dwellings: _____	Electric ☒ Oil ☐
No. of efficiency units: _____	Natural Gas ☐
No. of 1 BR units: _____	Propane Gas ☒
No. of 2 BR units: _____	Sprinkler system: N/A ☐
No. of 3 BR units: _____	NFPA #13D _____
Other Structure: _____	NFPA #13R _____
Dimensions: _____	Other: _____
Footings: _____	
Roof Height: _____	
State Certified Modular _____	
Manufactured Home _____	

THE UNDERSIGNED HEREBY CERTIFIES AND AGREES AS FOLLOWS: (1) THAT HE/SHE IS AUTHORIZED TO MAKE THIS APPLICATION; (2) THAT THE INFORMATION IS CORRECT; (3) THAT HE/SHE WILL COMPLY WITH ALL REGULATIONS OF HOWARD COUNTY WHICH ARE APPLICABLE THERETO; (4) THAT HE/SHE WILL PERFORM NO WORK ON THE ABOVE REFERENCED PROPERTY NOT SPECIFICALLY DESCRIBED IN THIS APPLICATION; (5) THAT HE/SHE GRANTS COUNTY OFFICIALS THE RIGHT TO ENTER ONTO THIS PROPERTY FOR THE PURPOSE OF INSPECTING THE WORK PERMITTED AND POSTING NOTICES.

Applicant's Signature Phillip J. Blaney
Title/Company Owner

Print Name Phillip J. Blaney
Date March 23, 2006


Checks payable to: **DIRECTOR OF FINANCE OF HOWARD COUNTY**
** PLEASE WRITE NEATLY AND LEGIBLY. **

FOR OFFICE USE ONLY

AGENCY	DATE	SIGNATURE APPROVAL
Development DPZ		
State/County		
Building Official		
Dev. Engineering DPZ		
Health	<u>4/12/06</u>	<u>Stanford</u>
Fire Protection		
Is Department Control approval required prior to issuance?		
YES ☐ NO ☐		

DPZ SETBACK INFORMATION	PROPERTY ID#
Front: _____	Filing fee \$ <u>25</u>
Rear: _____	Permit fee \$ _____
Side: _____	Excise tax \$ _____
Side St: _____	Add'l per. fee \$ _____
All minimum setbacks met? YES ☐ NO ☐	TOTAL FEES \$ _____
Is Entrance Permit required? YES ☐ NO ☐	Sub-total paid \$ _____
	Balance due \$ _____
	Check # <u>71258</u>
	Validation <u>71258</u>

CONTINGENCY CONSTRUCTION START: ☐
ONE STOP SHOP: ☐
Distribution of Copies: _____
White Building Official _____
Green LDC DPZ _____
Yellow FED DPZ _____
Pink Health _____
Gold SHA _____

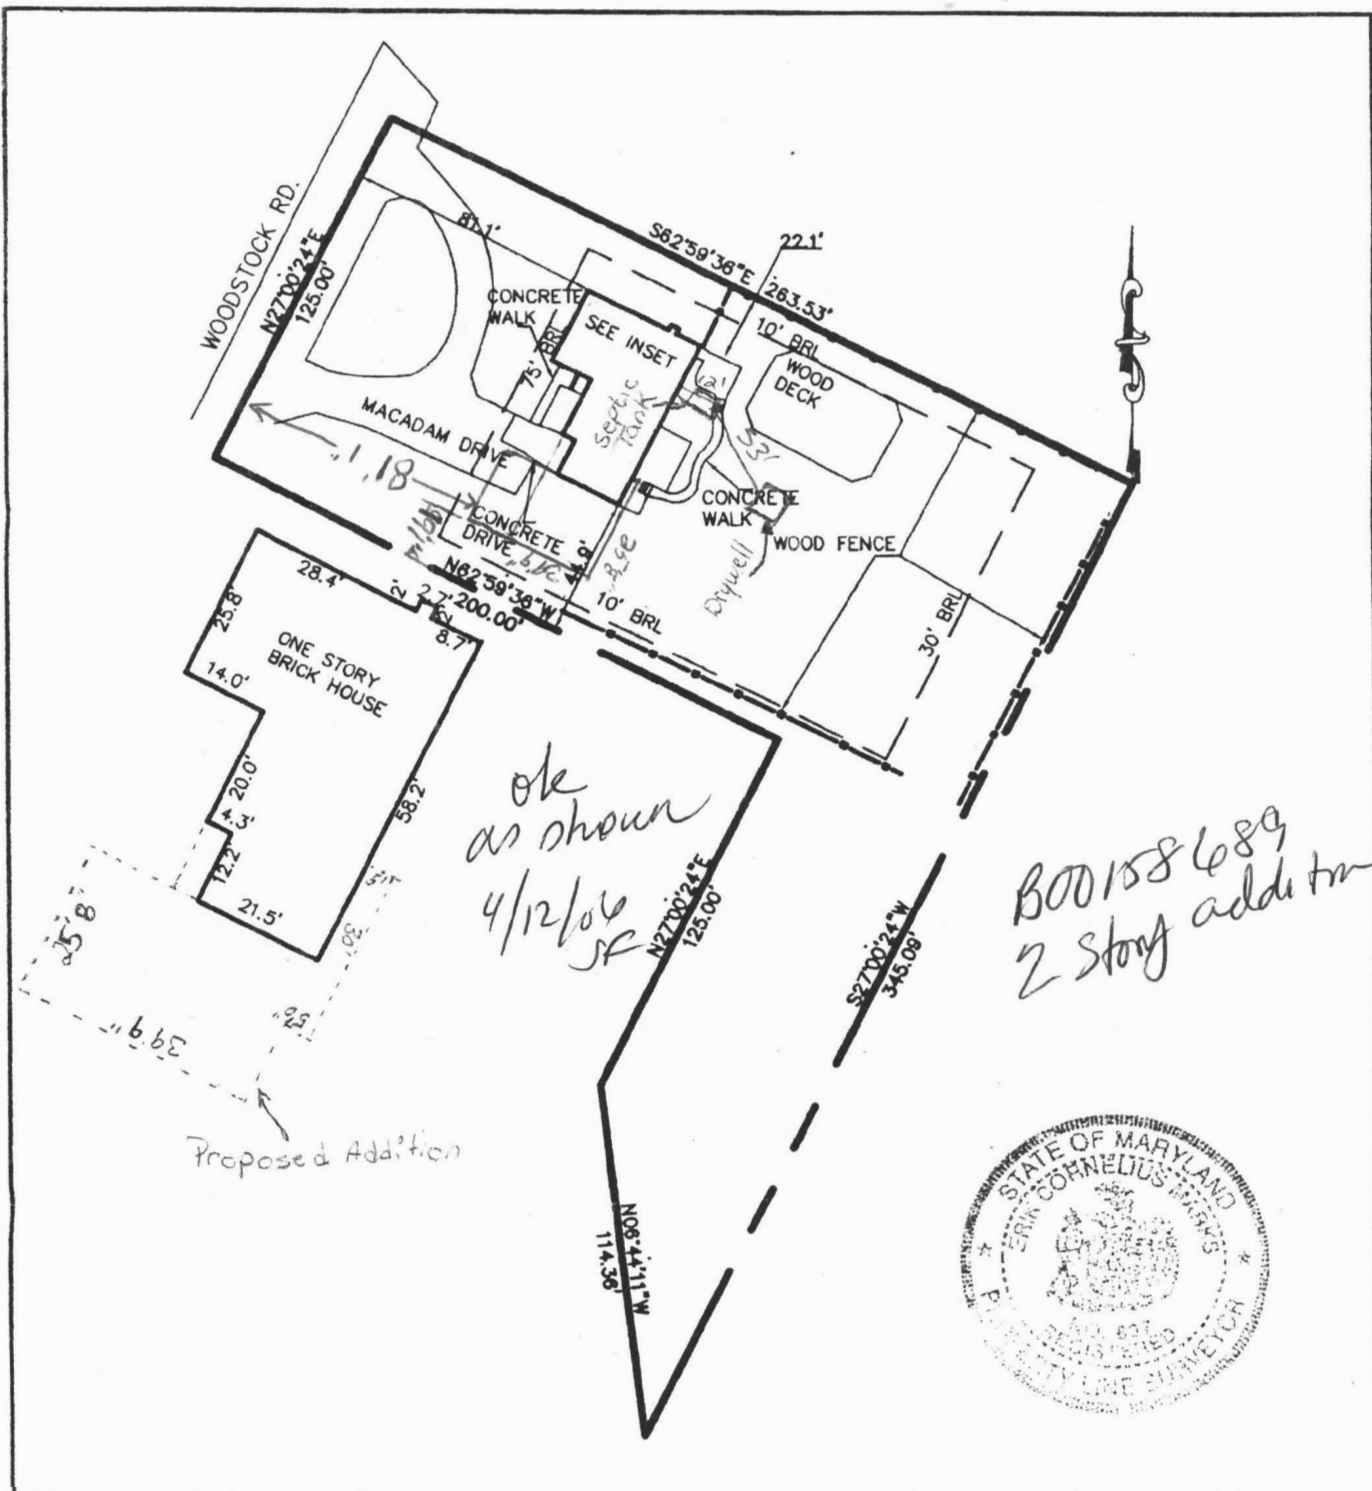


RECORD REFERENCES	LOCATION SURVEY	MARKS & ASSOCIATES L.L.C. SURVEYORS—LAND PLANNING CONSULTANTS 4831 COLLEGE AVENUE ELLICOTT CITY, MARYLAND (410)747-8738 FAX (410)747-8847 I HEREBY CERTIFY THAT THE IMPROVEMENTS ARE LOCATED AS SHOWN HEREON AND TO THE BEST OF MY KNOWLEDGE AND BELIEF, THERE ARE NO ENCROACHMENTS EXCEPT AS SHOWN.  ERIK C. MARKS R.P.L.S. NO. 607
LIBER/FOLIO 2942/561 PLAT BOOK/FOLIO PLAT NO.	1825 WOODSTOCK ROAD WOODSTOCK, MD 21163	
SCALE: 1"=60' DATE: FEBRUARY 10, 2006	HOWARD COUNTY, MARYLAND	

SITE INSPECTION SHEET

OWNER: _____ PHONE #: _____
ADDRESS: 1825 woodstock Rd CONTRACTOR: _____
SUBDIVISION: _____ LOT: _____ WELL TAG #: _____
COUNTY #: _____
PROPOSAL: Verify functioning septic

LOCATION DIAGRAM

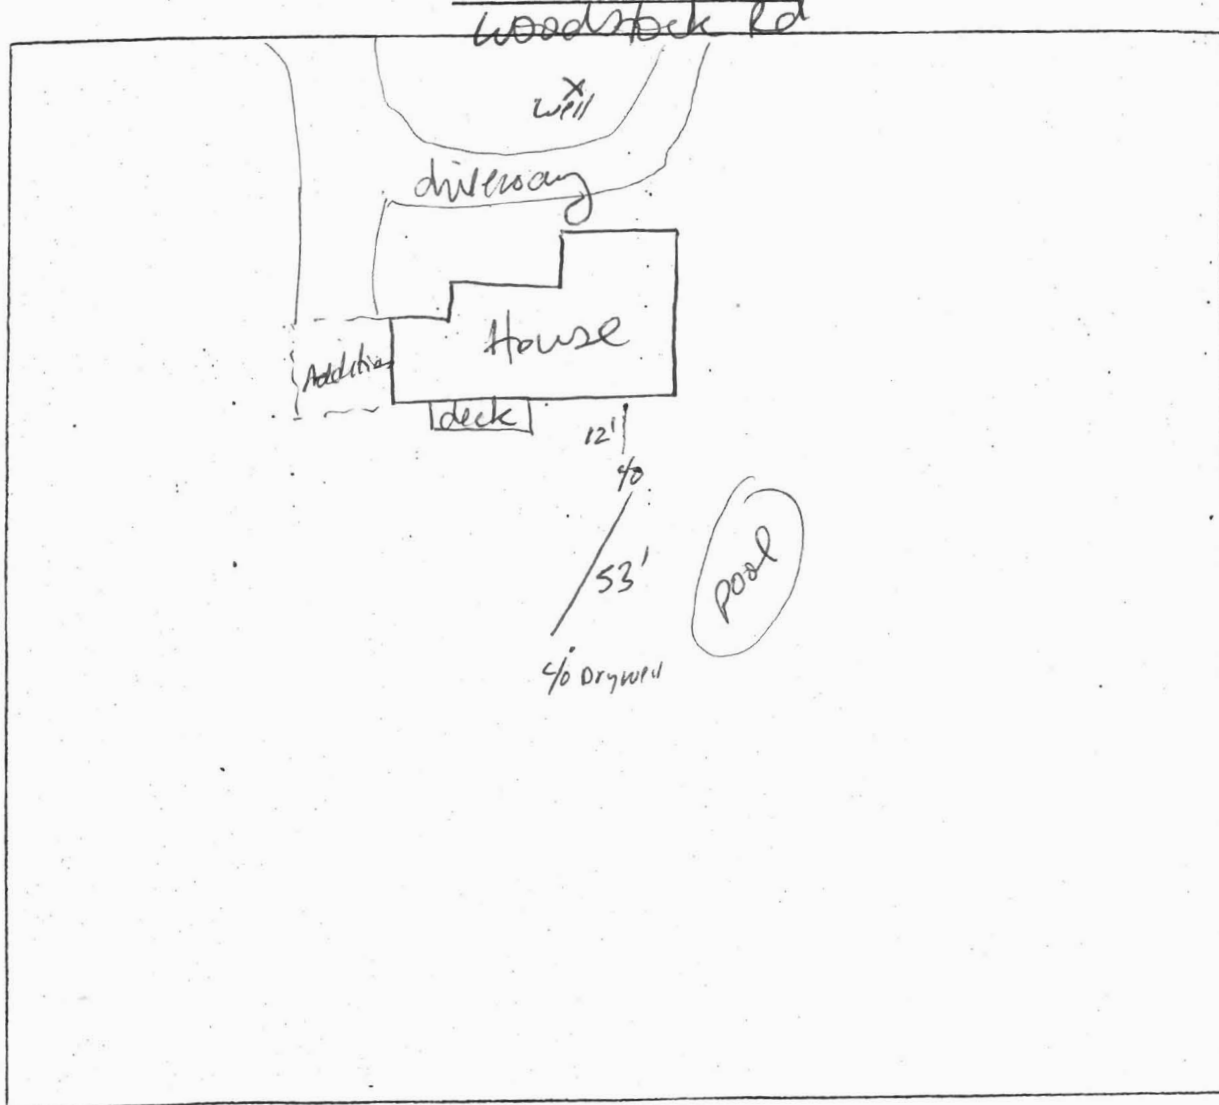

COMMENTS: Drywell and septic tank both are functioning properly.
Effluent levels are okay.

4/10/06

(Signature)