

APPLICATION

A 16612

P _____

SEWAGE DISPOSAL TESTING

MARYLAND STATE DEPARTMENT OF HEALTH

HOWARD COUNTY

ELLICOTT CITY

DISTRICT 3DATE 12/15/71TO: THE COUNTY HEALTH OFFICER
ELLICOTT CITY, MARYLAND

I, HEREBY, APPLY FOR THE NECESSARY TESTS IN ORDER TO CONSTRUCT (OR RECONSTRUCT) A SEWAGE DISPOSAL SYSTEM.

PROPERTY OWNER William Howard Brown, Jr.ADDRESS 1795 Woodstock Road, Box 31, Woodstock, Md.Any questions call:
PHONE Purdum & Jeschke
465-1635

PROPERTY LOCATION:

SUBDIVISION Sherry ValleyLOT NO. 1, Blk. B, Sec. 1ROAD AND DESCRIPTION Woodstock Road

OCCUPANT _____

PHONE _____

PERSON TO CONSTRUCT SYSTEM _____

ADDRESS _____

PHONE _____

SIZE OF LOT 22,700 sq. ft.TYPE BLDG. 3 or 4

NUMBER OF BEDROOMS

IF NOT SINGLE RESIDENCE DESCRIBE _____

SIGNATURE OF APPLICANT /s/ Ron Carter, Purdum & Jeschke

APPROVED BY _____

FOR _____

(KIND OF SYSTEM)

DATE _____

REJECTED BY _____

FOR _____

(KIND OF SYSTEM)

DATE _____

HOLD PENDING FURTHER TESTS _____

DATE _____

REASONS FOR REJECTION OR HOLDING _____


SOIL UNDER FINDING

TESTED BY

THIS IS NOT A PERMIT

1963

APPLICATION

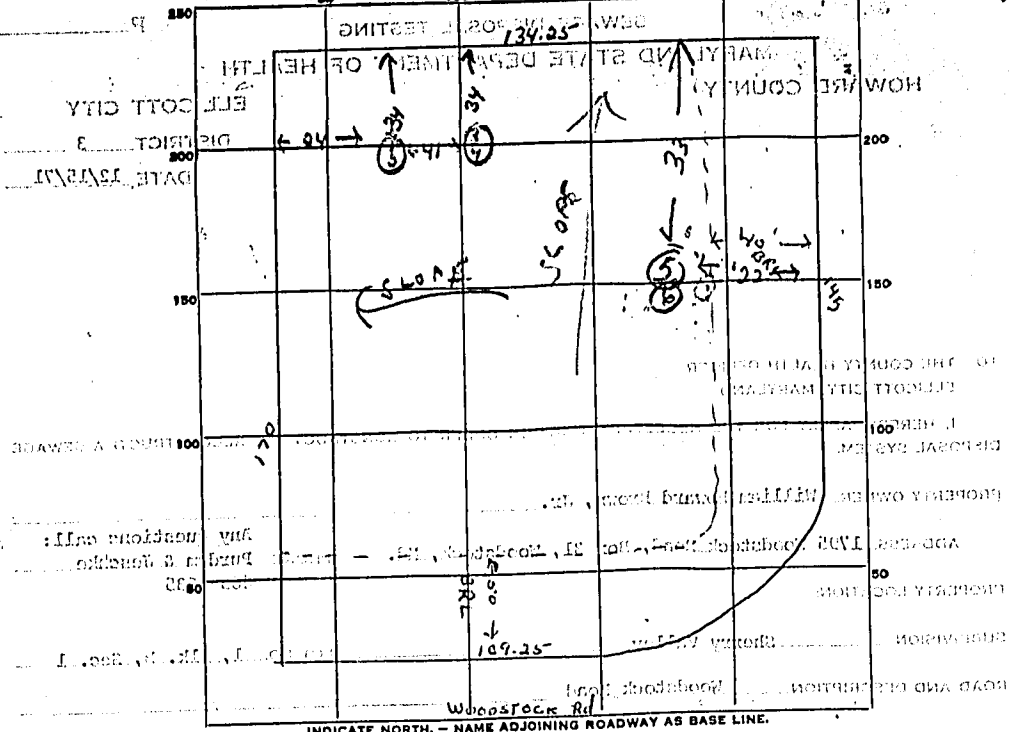

DATE	TEST NO.	DEPTH	PRE-WET		TEST - 1" DROP		TIME
			START	STOP	START	STOP	
12/17/71	1	9 1/2 ft.	10 02		10 02 1/2	10 03 1/2	1 min
	2	2 1/2 ft.	10 02	10 03	10 03	10 04	1 min
	3	2 1/2 ft.	10 06		10 06	10 07	2 min
	4	9 ft.	10 09		10 09	10 10	1 min
	EXTRA FIVE GAL. ADDED.						
	PER START TIME TO 52.0W.						
	5	10 1/2 ft.	10 58	10 59	10 59	11 00	2 min
	6	11 1/2 ft.	10 58	11 00	11 00	11 01	4 min
12/17/71			11 03	11 05	11 05	11 07	2 min

SOIL AUGER FINDING

TESTED BY

R T + O - M

REMARKS

THIS IS NOT A FINAL REPORT