

APPLICATION

A 17915

SEWAGE DISPOSAL TESTING

P _____

STATE OF MARYLAND - DEPARTMENT OF HEALTH AND MENTAL HYGIENE

HOWARD COUNTY HEALTH DEPARTMENT
ENVIRONMENTAL HEALTH SERVICES
P. O. BOX 476, ELLICOTT CITY, MARYLAND 21043
TELEPHONE: 465-5000, EXT. 356

DISTRICT 3

DATE 2/2/73

TO: THE COUNTY HEALTH OFFICER
ELLICOTT CITY, MARYLAND

I, HEREBY, APPLY FOR THE NECESSARY TEST IN ORDER TO CONSTRUCT (OR RECONSTRUCT) A SEWAGE DISPOSAL SYSTEM.

PROPERTY OWNER William Howard Brown, et al

ADDRESS 1795 Woodstock Road, Woodstock, Md. PHONE 328-2120
21163

PROPERTY LOCATION:

SUBDIVISION _____ LOT NO. _____

ROAD AND DESCRIPTION Woodstock Road - 1/4 mile in on Woodstock Road from Route 99

SIZE OF LOT 166 acres TYPE BLDG. 3

NUMBER OF BEDROOMS
(Single Fmly. Dwlg.)

IF NOT SINGLE RESIDENCE DESCRIBE _____

THE SYSTEM INSTALLED UNDER THIS APPLICATION IS ACCEPTABLE ONLY UNTIL PUBLIC FACILITIES BECOME AVAILABLE.

SIGNATURE OF APPLICANT W. Howard Brown

APPROVED BY _____ FOR _____ DATE _____
(KIND OF SYSTEM)

REJECTED BY _____ FOR _____ DATE _____
(KIND OF SYSTEM)

HOLD PENDING FURTHER TESTS _____ DATE _____

REASONS FOR REJECTION OR HOLDING _____

THIS IS NOT A PERMIT

APPLICATION

DATE

SUBMITTER'S NAME ADDRESS CITY STATE ZIP	TEST LOCATION ROAD NO. & MILEAGE COUNTY	TEST NO. & DATE TESTER'S NAME TESTER'S ADDRESS	TESTER'S PHONE TESTER'S SIGNATURE DATE
---	---	--	--

INDICATE NORTH - NAME ADJOINING ROADWAY AS BASE LINE.

63
150
150

DATE	TEST NO.	DEPTH	PRE-WET		TEST - 1" DROP		TIME
			START	STOP	START	STOP	
5/73	Retention argill test hole				150 ft -	No water.	R.T.
	See original Pers sheet						

REMARKS _____


TYPE OF SOIL _____

TESTED BY _____ ALSO PRESENT: _____

A17915

WOODSTOCK

ROAD

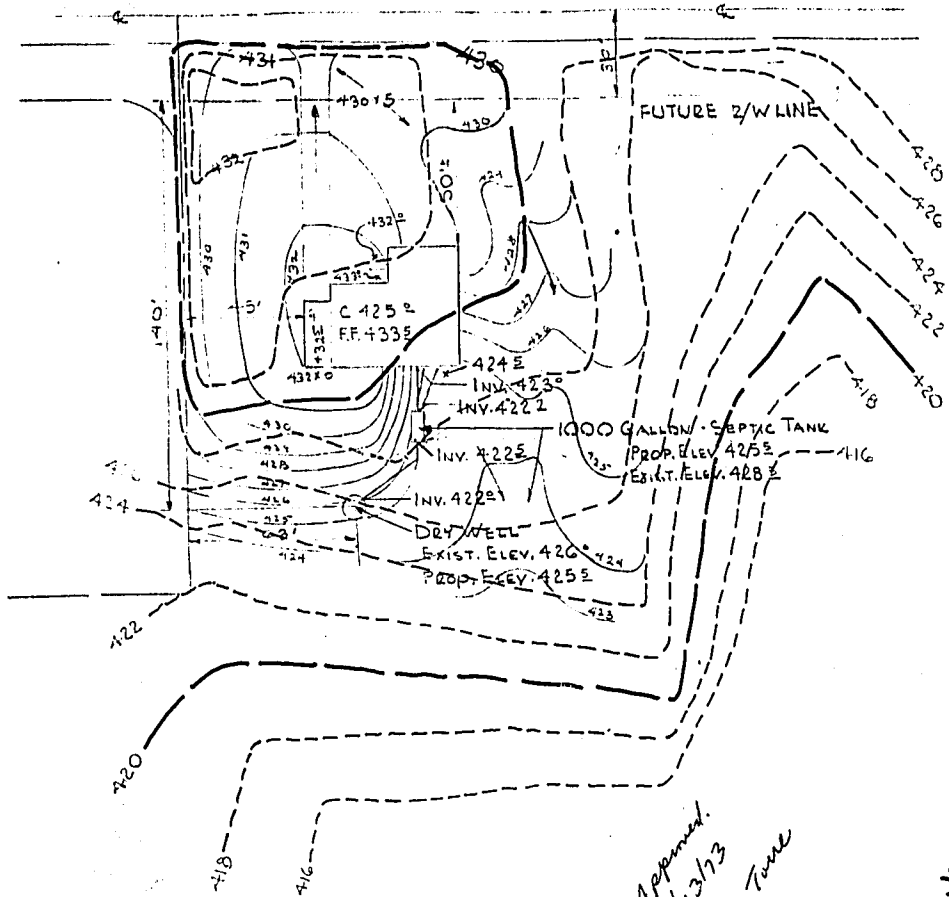

Approved
2/13/13
A. Tume

#17227 W. Woodstock