

PERMIT

SEWAGE DISPOSAL SYSTEM

MARYLAND STATE DEPARTMENT OF HEALTH

HOWARD COUNTY

ELLICOTT CITY

DISTRICT 3

DATE 7/6/73

INDEXED

Roland Barth

IS PERMITTED TO INSTALL ☒ ALTER

ADDRESS Clarksville Pike, Ellicott Maryland PHONE 730-8495

A SEWAGE DISPOSAL SYSTEM LOCATED AT

SUBDIVISION ROAD Woodstock Rd. LOT
(see application for better directions)

PROPERTY OWNER William Howard Brown, et al

ADDRESS

SPECIFICATIONS - 3 bedrooms

DRAIN FIELD DEPTH FEET, BOTTOM AREA SQ. FT.

SEEPAGE PITS ABSORBENT SIDE-WALL AREA SQ. FT.

SEPTIC TANK CAPACITY 1,000 GALLONS

FOR GARBAGE GRINDER, INCREASE DISPOSAL AREA 22% & TANK CAPACITY 50%

OTHER Dry well - 100 sq. ft. absorbent sidewall area per bedroom to begin below the

inlet. Maximum depth permitted for dry well is 11 ft. below grade. (if any water is

encountered stop construction and call Health Dept.) Locate dry well 140 ft. from front lot

line and 63 ft. from right side line as seen from Woodstock Rd.

NOTE: ALL PIPE FROM HOUSE TO DRY WELL MUST BE CAST IRON.

PERMIT VOID AFTER THREE YEARS.

NOTE: INSTALL STAND PIPE ON SEPTIC TANK AND DRY WELL.

PLANS APPROVED BY Robert V. Torre DATE 2/20/73


FILL SEPTIC TANK AND DISTRIBUTION BOX WITH WATER BEFORE CALLING FOR AN INSPECTION. COVER NO WORK
UNTIL INSPECTED AND APPROVED.

NEITHER THE HOWARD COUNTY COMMISSIONERS NOR THE HEALTH DEPARTMENT IS RESPONSIBLE FOR THE
SUCCESSFUL OPERATION OF ANY SYSTEM.

INSPECTOR

DATE SYSTEM APPROVED

17915

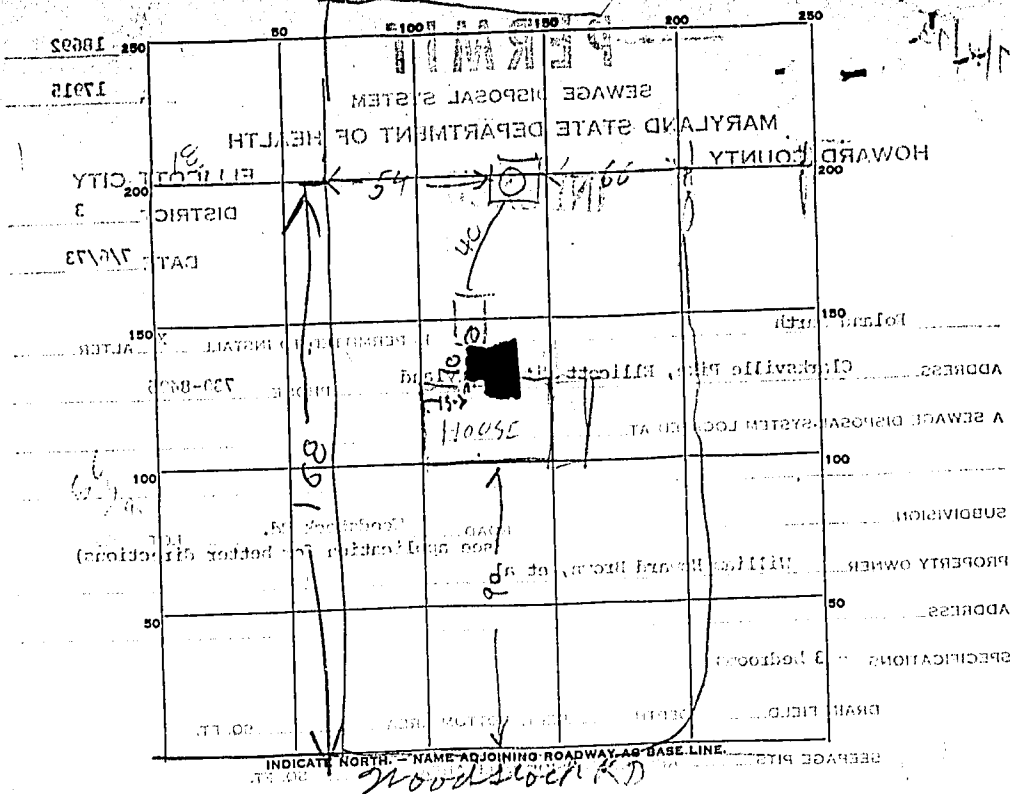

PERMIT CARD

SEPTIC TANK, LEVEL OK concrete 1000 CLEANOUTS OK

DISTRIBUTION BOX, LEVEL Below ground surface

INLET, DRAINAGE, DEPTH 30 FT. TRENCH WIDTH 18 IN. TRENCH DEPTH 30 FT.

GRAVEL DEPTH 12 IN. TOTAL LENGTH 115 FT. TOTAL BOTTOM AREA 10 SQ. FT.

NUMBER OF TRENCHES 1 SEE PAGE PITS, INSIDE DIAMETER 10 FT. DEPTH BELOW INLET 58 FT.

ABSORBENT AREA 348 SQ. FT. REMARKS 7/11/73 Day Well, lot 5 below ground

Remainder of Day Well is 58 FT

3 bedrooms Counted 300 sq ft needed

Well not yet installed

DATE SYSTEM APPROVED 7/11/73 INSPECTOR Raymond Hodge