

APPLICATION

SEWAGE DISPOSAL TESTING

MARYLAND STATE DEPARTMENT OF HEALTH

A 08311

P

HOWARD COUNTY

ELLICOTT CITY

DISTRICT 5

DATE 4/20/64

Septic Tank - 3 bedrooms - 750 gal
4 bedrooms - 1000 gal

Dry Well - 3 bedroom - 324 sqft and all area below inlet pipe
4 bedroom - 432 " " " " " " " "

Place Dry Well about 15 ft from rear lot line and about 30 ft from left side of rear yard facing lot from Linden Church Rd.

TO: THE COUNTY HEALTH OFFICER
ELLICOTT CITY, MARYLAND

I, HEREBY, APPLY FOR THE NECESSARY TESTS IN ORDER TO CONSTRUCT (OR RECONSTRUCT) A SEWAGE DISPOSAL SYSTEM.

PROPERTY OWNER John Baker & Dorothy Ann White

ADDRESS Rt. 32 - Dayton, Maryland

PHONE AT6-2708

PROPERTY LOCATION:

SUBDIVISION

LOT NO.

ROAD AND DESCRIPTION Linden Church Road - go up 29 to 108 - 6 or 8 miles to Rt. 32 - come to Linden Chap/church take right turn and go straight back - dirt road - straight back - look for old farm house

OCCUPANT

PERSON TO CONSTRUCT SYSTEM

ADDRESS

PHONE

SIZE OF LOT 1 acre

TYPE BLDG. 3 or 4 bedroom
NUMBER OF BEDROOMS

IF NOT SINGLE RESIDENCE DESCRIBE

SIGNATURE OF APPLICANT

Mrs. Dorothy Ann White

APPROVED BY

DW Monaghan

FOR

Dry Well

(KIND OF SYSTEM)

DATE

5/6/64

REJECTED BY

FOR

(KIND OF SYSTEM)


DATE

HOLD PENDING FURTHER TESTS

DATE

REASONS FOR REJECTION OR HOLDING

THIS IS NOT A PERMIT

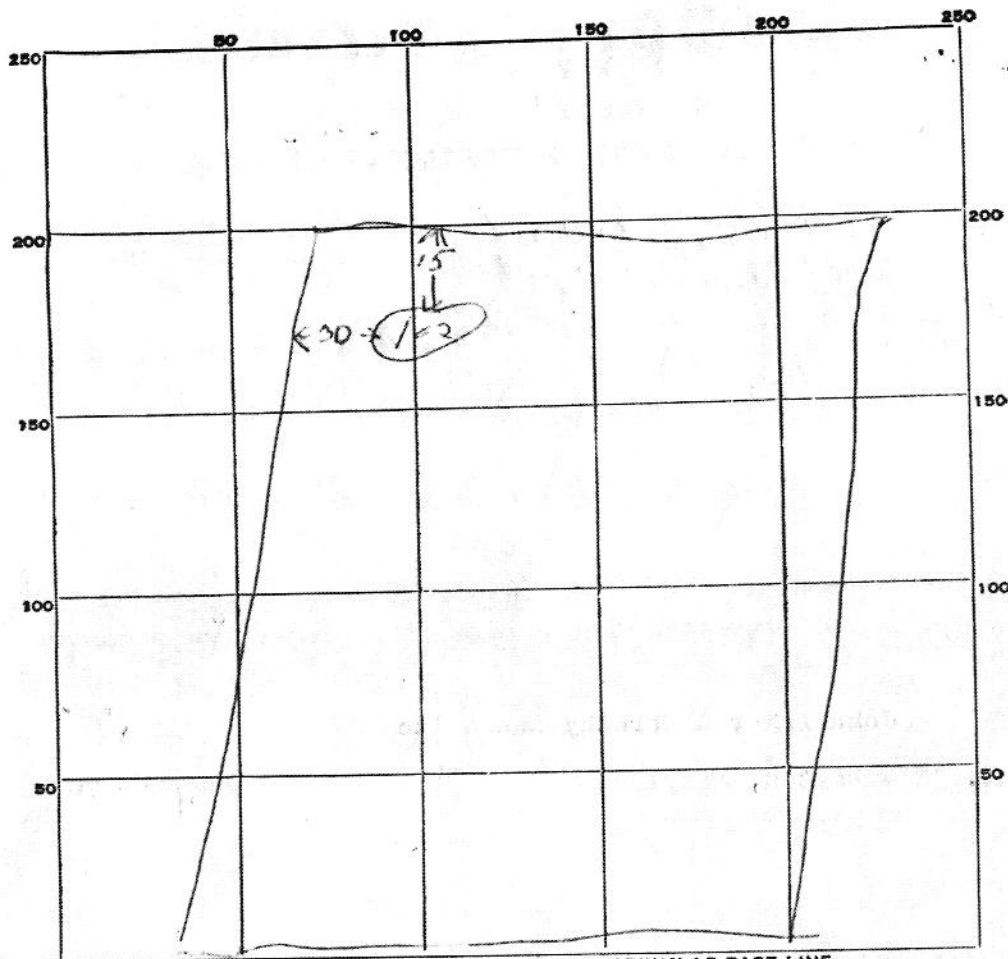

INDICATE NORTH. - NAME ADJOINING ROADWAY AS BASE LINE.

London Church Rd

DATE	TEST NO.	DEPTH	PRE-WET		TEST - 1" DROP		TIME
			START	STOP	START	STOP	
5/6/64	1	9	948	952	952	1001	9 min
	2	5	949	953	953	1002	9 min

SOIL AUGER FINDING

TESTED BY

Deum 5/6/64

REMARKS

ALSO PRESENT

John Baker white


LOT NO.

9/27/78
Sketch O.K.
T. Skinner

ELEV. AT TIME OF PEG TEST 510
EXIST. ELEV. 510
INV. ELEV. 506
W.M. Campbell
3/23/109

EXIST. ELEV. 511
INV. ELEV. 506.5
INV. ELEV. 506.75
INV. ELEV. 507

T.J. White
10/7/111

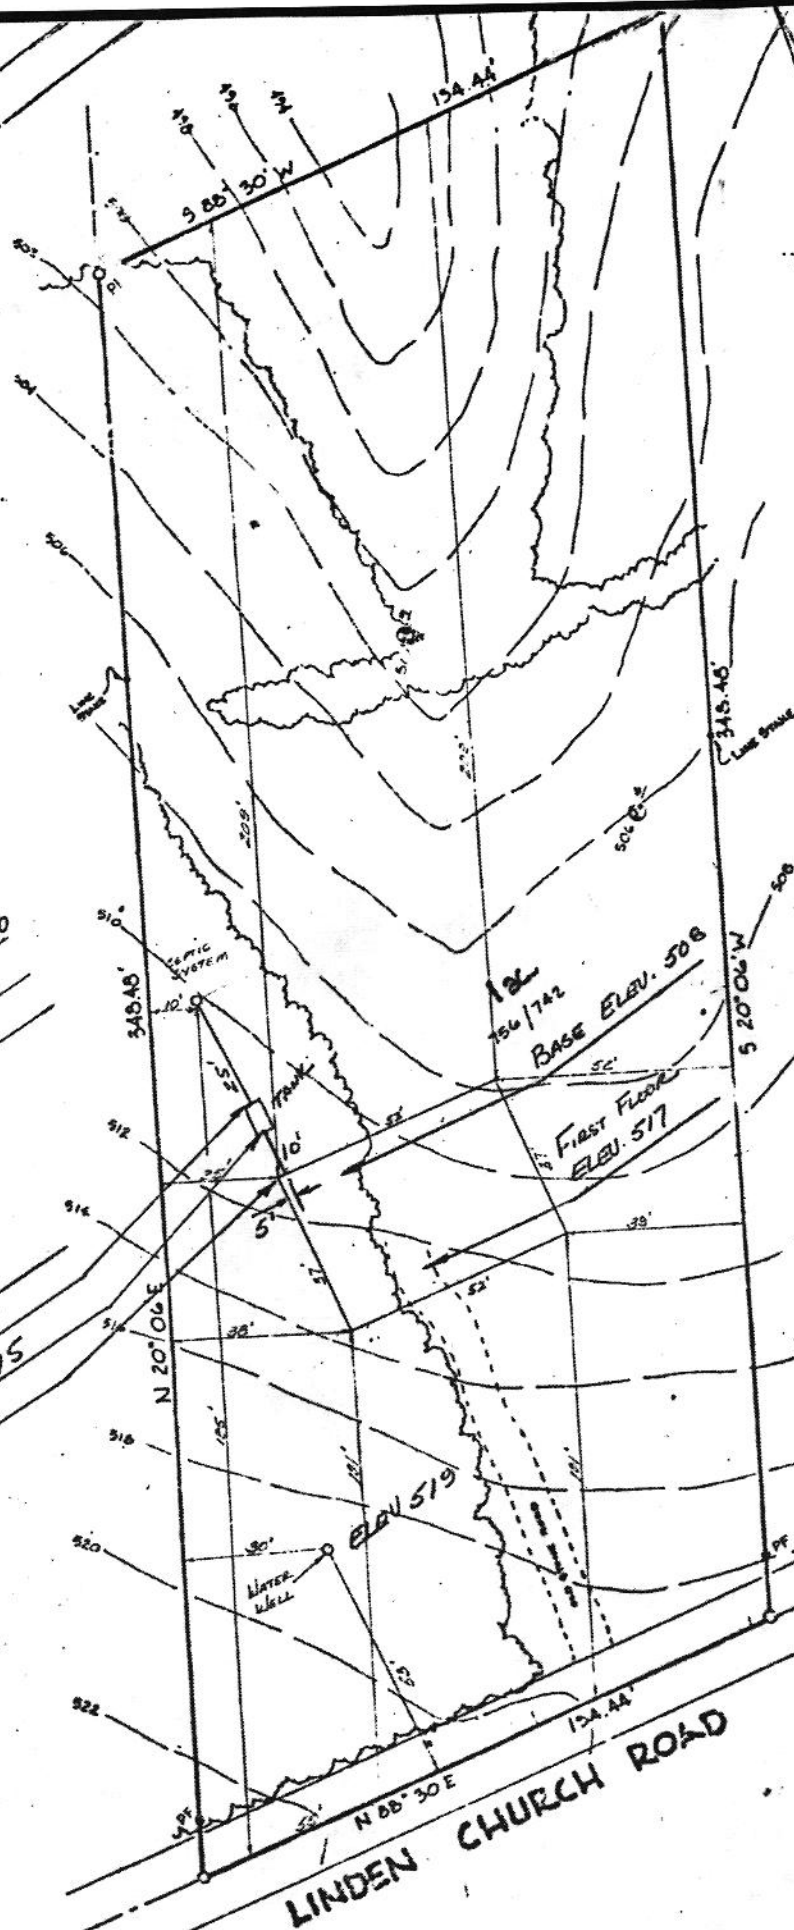

LINDEN CHURCH ROAD

T.
A.