

FOUNTAIN VALLEY ANALYTICAL LABORATORY, INC.

1413 Old Taneytown Rd. Westminster, MD (410) 848-1014 (410) 876-4554

REPORT OF ANALYSIS

Laboratory ID #: 177144 Account #: 3327
Reference: Peter Pan Learning Center Client: Peter Pan Learning Center
Location: 1260 Driver Road Requested By: Sue Kruhm
Marriottsville, MD 21104 Source: Well Water
Date/ Time Collected: 10/22/2025 0950 Site: Downstairs Kitchen Sink Tap
Date/Time Rec'd: 10/22/2025 1500 Treatment: **
Chlorine ppm: Free: ND Total: ND pH: 5.5
Collected By: R. Ott 0266RO Well #: HO-94-3345

PARAMETERS	RESULTS	UNITS	REFERENCE	METHOD	DATE/TIME/ANALYST
Bacteria, Coliform, Total, MPN	<1.0	MPN/ 100 ml	<1.0	SM20 9223B	10/23/2025 / 1000 / KDR
Bacteria, E. coli, MPN	<1.0	MPN/ 100 ml	<1.0	SM20 9223B	10/23/2025 / 1000 / KDR
Nitrate.	5.74	mg/L (as N)	10	EPA 300.0	10/22/2025 / 1627 / KDR

NOTES:

- 1 mg/L = milligrams per liter (also, parts per million)
- 2 MPN/ 100 ml = Most Probable Number [of viable bacteria] per 100 ml of sample.
- 3 pH & Chlorine level tested on site
- 4 Results less than or within the reference range are considered satisfactory and within potable water limits at the time of sampling.
- 5 ND = None Detected
- 6 Visual well check: Sealed, vented cap
- 7 **Neutralizer/Softener/Conditioner/Spin Down Filter

Reason for Test : SDWA (MD1130014-TP01)

Date Reported: 10/23/2025

Reviewed By: 

PUBLIC SEWER STATUS VERIFIED BY

ISSUE DATE: 6/2/2011

APPROVAL DATE: 6/6/11

PERMIT

P 535217

A REPAIR

Septic Repair

ON-SITE SEWAGE DISPOSAL SYSTEM
HOWARD COUNTY HEALTH DEPARTMENT
BUREAU OF ENVIRONMENTAL HEALTH

William Hopkins IS PERMITTED TO INSTALL ALTER

ADDRESS: 17550 Old Frederick Road PHONE NUMBER: 410-404-2361

SUBDIVISION: Peter Pan Learning Center LOT NUMBER: _____

ADDRESS: 1260 Driver Road PROPERTY OWNER: Wayne Kruhm

SEPTIC TANK CAPACITY (GALLONS): 1500ex.

PUMP CHAMBER CAPACITY (GALLONS): N/A

NUMBER OF BEDROOMS: 3

SQUARE FEET OF HOUSE: N/A

LINEAR FEET OF TRENCH REQUIRED: 160

TRENCHES:	Trenches to be 2 feet wide. Inlet 4 feet below original grade. Bottom maximum depth 9 feet below grade. Effective area begins at 7 feet below original grade with 5 feet of stone below distribution pipe.
LOCATION:	Install d box just below falling trench aprox. 65° off from drive way. Install 2 x 54' trenches on contour running towards drive and 1x 54' trench running away from drive.
NOTES:	Mark utilities. Gravel tickets must be available for Environmental Sanitarians. Stone must be approved by the Howard County Health Department. Observations need to be installed at the ends of all trenches. Replace broken pipe from ex. septic tank to new d box.

PLANS APPROVED: Kevin Wolf DATE: 6/2/2011

NOTE: PERMIT VOID AFTER 2 YEARS

NOTE: CONTRACTOR RESPONSIBLE FOR SCHEDULING A PRE-CONSTRUCTION INSPECTION FOR ALL INSTALLATIONS

NOTE: WATERTIGHT SEPTIC TANKS REQUIRED

NOTE: ALL PARTS OF SEPTIC SYSTEM SHALL BE 100 FEET FROM ANY WATER WELL

NOTE: MANHOLE RISERS REQUIRED ON ALL SEPTIC TANKS AND PUMP CHAMBERS

NOTE: AN ELECTRICAL PERMIT IS REQUIRED FOR INSTALLATION OF ANY ELECTRICAL COMPONENTS OF THE SYSTEM

NEITHER THE HOWARD COUNTY COUNCIL OR THE HEALTH DEPARTMENT IS
RESPONSIBLE FOR THE SUCCESSFUL OPERATION OF ANY SYSTEM
PERMITTEE RESPONSIBLE FOR OBTAINING FINAL APPROVAL ON THIS PERMIT
CALL 410-313-1771 FOR INSPECTION OF SEPTIC SYSTEM

3/1/02
1:00

SITE INSPECTION SHEET

OWNER: Wayne Krahm

DATE REQUESTED: 3/1/02

ADDRESS: 1260 Driver Rd


DRILLER: Joe Mayne

WELL TAG # H0-94-3345 OK

COUNTY # (13) AB14976A

PROPOSAL: Ex well is going dry after 1/2 hour. Is a driven well.

LOCATION DIAGRAM

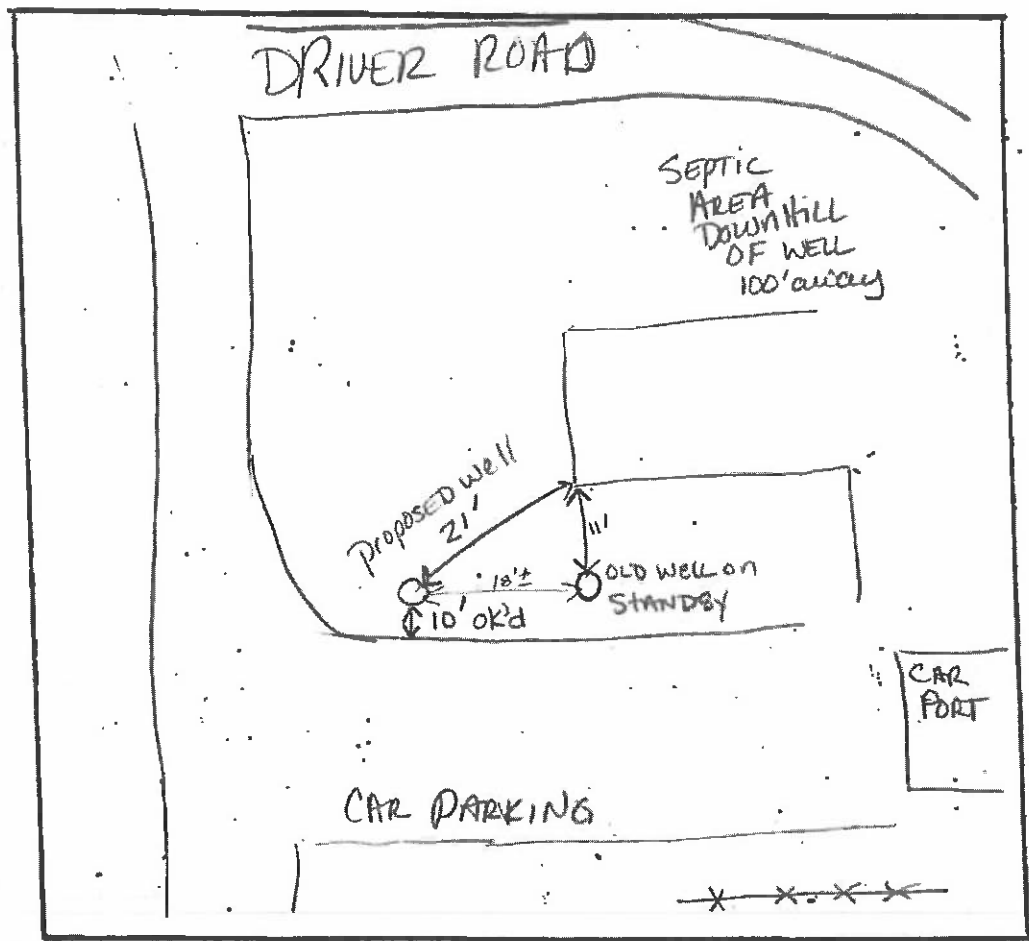

COMMENTS: 2/29/02 Keeping existing well as a stand-by.
No tag on the old well due to age of well. New
site an improvement of well location

well needs tag. Received \$0 payment (Gave to Barbara)

DATE: 2/29/02

INSPECTOR: Kacie

3/1/02
1:00

SITE INSPECTION SHEET

OWNER: Wayne Krahn

DATE REQUESTED: 3/1/02

ADDRESS: 1260 Driver Rd


DRILLER: Joe Mayne

WELL TAG # HO-94-3345

COUNTY # (13) A514976-A

PROPOSAL: Ex well is going dry after 1/2 hour. Is a driven well.

LOCATION DIAGRAM

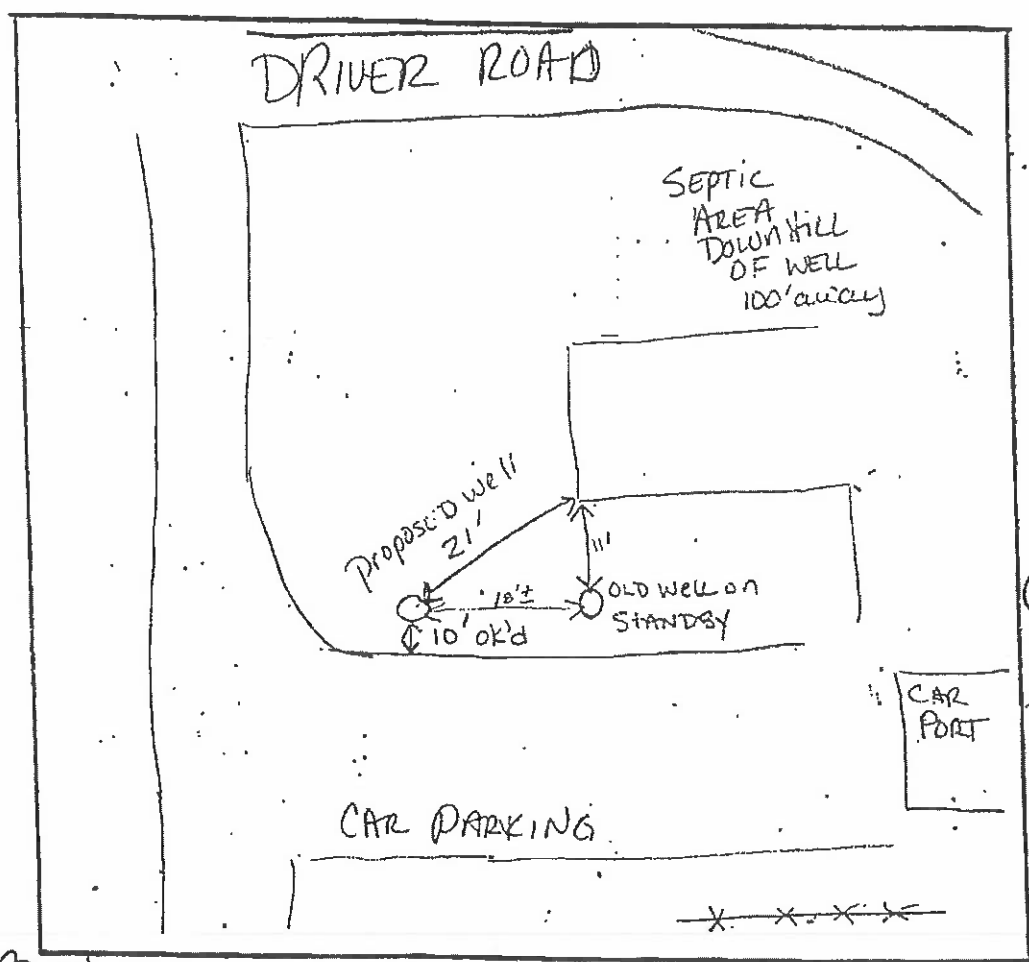

Water
Sampler
@ location
same time
I inspected
said all
done &
ready
for H₂O
testing

COMMENTS: 3/1/02 Keeping existing well as a stand-by.
No tag on the old well due to age of well. New
site an improvement of well location

well needs tag. Received \$ payment (Gave to Barbara)

DATE: 3/1/02

INSPECTOR: Krahn

Site visit – 12/18/25
1260 Driver Road
Marriottsville, MD 21104



Well tag # HO-94-3345

Site visit – 12/18/25
1260 Driver Road
Marriottsville, MD 21104



Site visit – 12/18/25
1260 Driver Road
Marriottsville, MD 21104



Septic tank man hole cover in front.