


SITE INSPECTION SHEET

OWNER: Jeen Pierre PHONE #: chariter2970@gmail.com
ADDRESS: 2970 Brookwood Rd CONTRACTOR: _____
WELL TAG #: _____
SUBDIVISION: _____ LOT: _____ COUNTY #: 13
PROPOSAL: Site inspection in response to complaint about large hole @ back of house, since HHO moved in 10 years ago.

LOCATION DIAGRAM

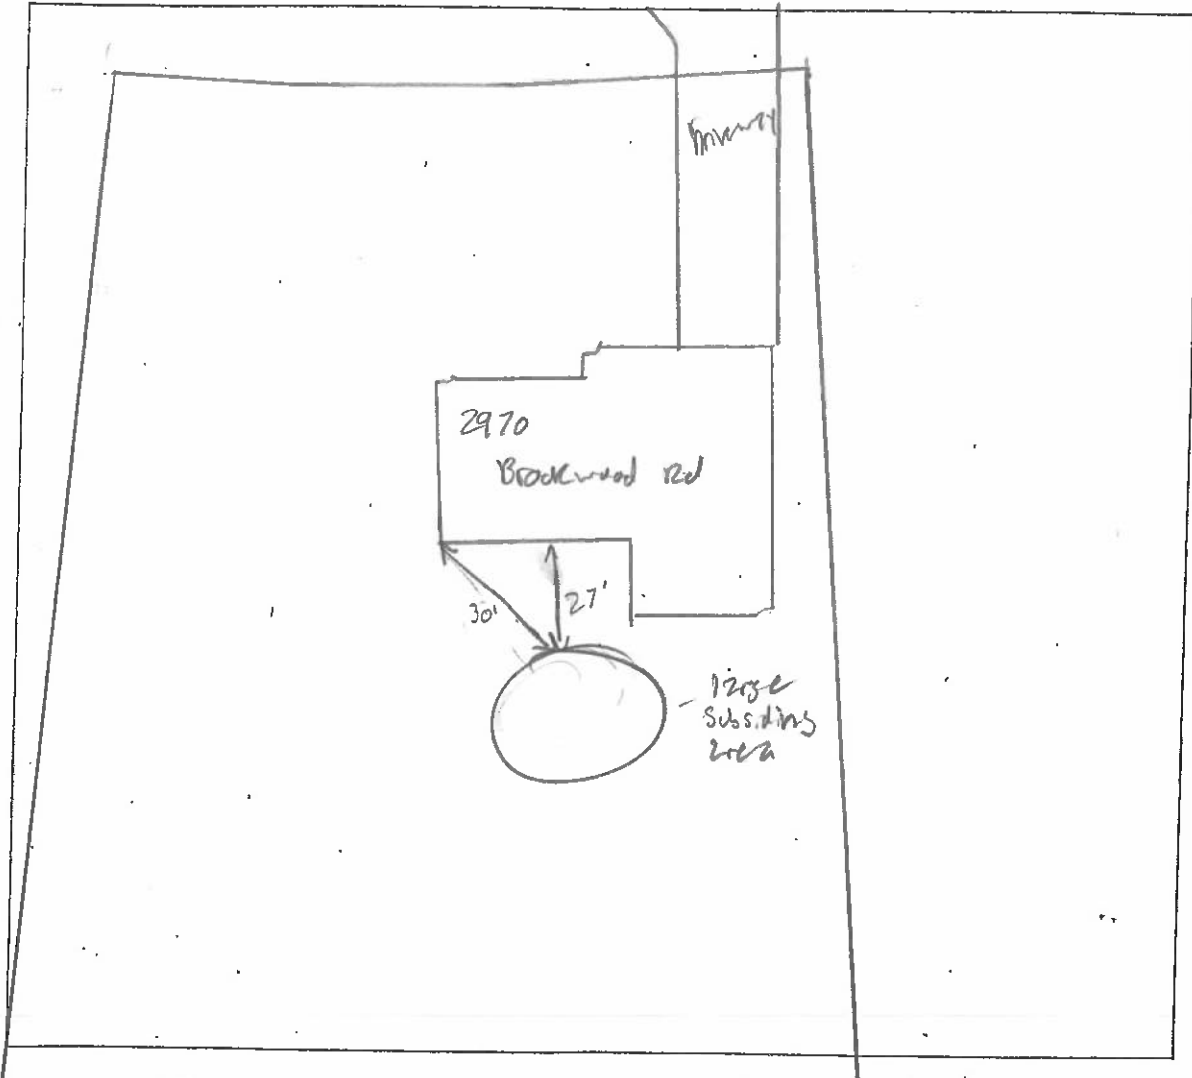

COMMENTS: 8/27/2025 - Met Homeowner Jeen Pierre onsite for inspection. Noted Large subsiding area @ back of yard 27' from building foundation. No signs of well or septic components unknown. HCHO has no record of past well or septic system. (SP)

DATE: 8/27/2025 INSPECTOR: S. Page