

APPLICATION

PERCOLATION TESTING

A _____

P _____

HOWARD COUNTY HEALTH DEPARTMENT

BUREAU OF ENVIRONMENTAL HEALTH

3525-H ELLICOTT MILLS DRIVE/ELLICOTT CITY, MARYLAND 21043

TELEPHONE: 313-2640

DISTRICT _____

DATE _____

TO: THE COUNTY HEALTH OFFICER
ELLICOTT CITY, MARYLAND

I HEREBY APPLY FOR THE NECESSARY TEST PRIOR TO APPLICATION FOR PERMIT TO CONSTRUCT (OR RECONSTRUCT) A SEWAGE DISPOSAL SYSTEM.

PROPERTY OWNER Mario Mannarelli

ADDRESS C/O Land Design Development
12205 Hickory Ridge Rd PHONE 741-2107

AGENT OR PROSPECTIVE BUYER Dana Reish

ADDRESS _____ PHONE _____

PROPERTY LOCATION:

SUBDIVISION Vineyards at Cattail Creek LOT NO. 13

ROAD AND DESCRIPTION Route 97

TAX MAP 21 PARCEL # 2,132,220 + 211

SIZE OF LOT 1 + acres TYPE BLDG. SFD
(SINGLE FAMILY DWELLING OR COMMERCIAL)

THE SYSTEM INSTALLED UNDER THIS APPLICATION IS ACCEPTABLE ONLY UNTIL PUBLIC FACILITIES BECOME AVAILABLE. I FULLY UNDERSTAND THE FEE CONNECTED WITH THE FILING OF THIS PERC TEST APPLICATION IS NON-REFUNDABLE UNDER ANY CIRCUMSTANCES. I ALSO AGREE TO COMPLY WITH ALL M.O.S.H.A. REQUIREMENTS IN TESTING THIS LOT.

Mario Mannarelli
(SIGNATURE OF APPLICANT)

APPROVED BY _____ FOR _____ DATE _____

DISAPPROVED BY _____ FOR _____ DATE _____

HOLD PENDING FURTHER TESTS _____

REASONS FOR REJECTION OR HOLDING _____

PERCOLATION TEST PLAT/PRELIMINARY PLAT - TITLE OR I.D. # _____ DATE _____

SITE DEVELOPMENT PLAN/FINAL PLAT - TITLE OR I.D. # _____ DATE _____

THIS IS NOT A PERMIT

APPLICATION

PERCOLATION TESTING

A 502250

P _____

HOWARD COUNTY HEALTH DEPARTMENT
BUREAU OF ENVIRONMENTAL HEALTH
3525-H ELLICOTT MILLS DRIVE/ELLICOTT CITY, MARYLAND 21043
TELEPHONE: 313-2640

DISTRICT _____

DATE _____

TO: THE COUNTY HEALTH OFFICER
ELLICOTT CITY, MARYLAND

I HEREBY APPLY FOR THE NECESSARY TEST PRIOR TO APPLICATION FOR PERMIT TO CONSTRUCT (OR RECONSTRUCT) A SEWAGE DISPOSAL SYSTEM.

PROPERTY OWNER Norio Mannarelli

ADDRESS C/O Land Design Development
12205 Highway Ridge Rd PHONE 741-2100

AGENT OR PROSPECTIVE BUYER Nora Reich

ADDRESS _____ PHONE _____

PROPERTY LOCATION:

SUBDIVISION Vineyards at Cattail Creek LOT NO. ~~13, 14, 15, 16~~ 20

ROAD AND DESCRIPTION Route 97

TAX MAP 21 PARCEL # 2, 132, 220 & 211

SIZE OF LOT 1 + acres TYPE BLDG. SFD
(SINGLE FAMILY DWELLING OR COMMERCIAL)

THE SYSTEM INSTALLED UNDER THIS APPLICATION IS ACCEPTABLE ONLY UNTIL PUBLIC FACILITIES BECOME AVAILABLE. I FULLY UNDERSTAND THE FEE CONNECTED WITH THE FILING OF THIS PERC TEST APPLICATION IS NON-REFUNDABLE UNDER ANY CIRCUMSTANCES. I ALSO AGREE TO COMPLY WITH ALL M.O.S.H.A. REQUIREMENTS IN TESTING THIS LOT. Mal A. Reed
(SIGNATURE OF APPLICANT)

APPROVED BY _____ FOR _____ DATE _____

DISAPPROVED BY _____ FOR _____ DATE _____

HOLD PENDING FURTHER TESTS _____

REASONS FOR REJECTION OR HOLDING _____

PERCOLATION TEST PLAT/PRELIMINARY PLAT - TITLE OR I.D. # Vineyards at CC SP-96-11 DATE 2-28-96

SITE DEVELOPMENT PLAN/FINAL PLAT - TITLE OR I.D. # _____ DATE _____

THIS IS NOT A PERMIT



REMARKS Lined Paper 9/7 Rock see #15 (also t.t. 9/8 9 10 11)
(2 holes) (13 14 15)

Mark Reick
3 others

Hold (?) for reexamination

150225 ~~05~~ LOT 16

Tests
back
of
LOT #16

LOT 16

9/8/94 Note
Good soil 4' 1/2" 4'-10"

11	10:10	10:11	10:13	2 min
10'-10"	LOAM			
12 4'-3"	10:14	10:16	10:26	10 min
10 1/2'	"LOAM"		(5% sandstone)	

More
hole
due
to
Rock
along
main
lot

HOWARD COUNTY HEALTH DEPARTMENT
BUREAU OF ENVIRONMENTAL HEALTH
1000 BELMONT MILLS DRIVE
BETHESDA, MARYLAND 20814
TELEPHONE: 313-2840

THE COUNTY HEALTH OFFICE
BETHESDA CITY, MARYLAND

Tests
at
back
of
lots
13, 14, 15
at 13:00 on
9/8/94

Thursday
9/8/94 Hole
13

5'	10:31	10:33	10:35	2+ min
11'	(LOAM)			
on LOT 15 5'	10:38	10:39	10:41	2+ min
14 10' 4"	(LOAM)			
15 4' 9"	10:48	10:50	10:52	2 min
10 1/2'	LOAM			
on LOT 13 16 4' 8"	12:21	12:23	12:25	2 min
10'	LOAM			


(Wanted for
test hole
to see how
1/8/93)

APPROVED BY
DISAPPROVED BY
HOLD PENDING FURTHER TESTS
REASONS FOR REJECTION OR HOLDING


PERCOLATION TEST PLAT/PRELIMINARY PLAT
SITE DEVELOPMENT PLAT/FINAL PLAT

THIS IS NOT A PERMIT

PERC STAKEOUT PLAN

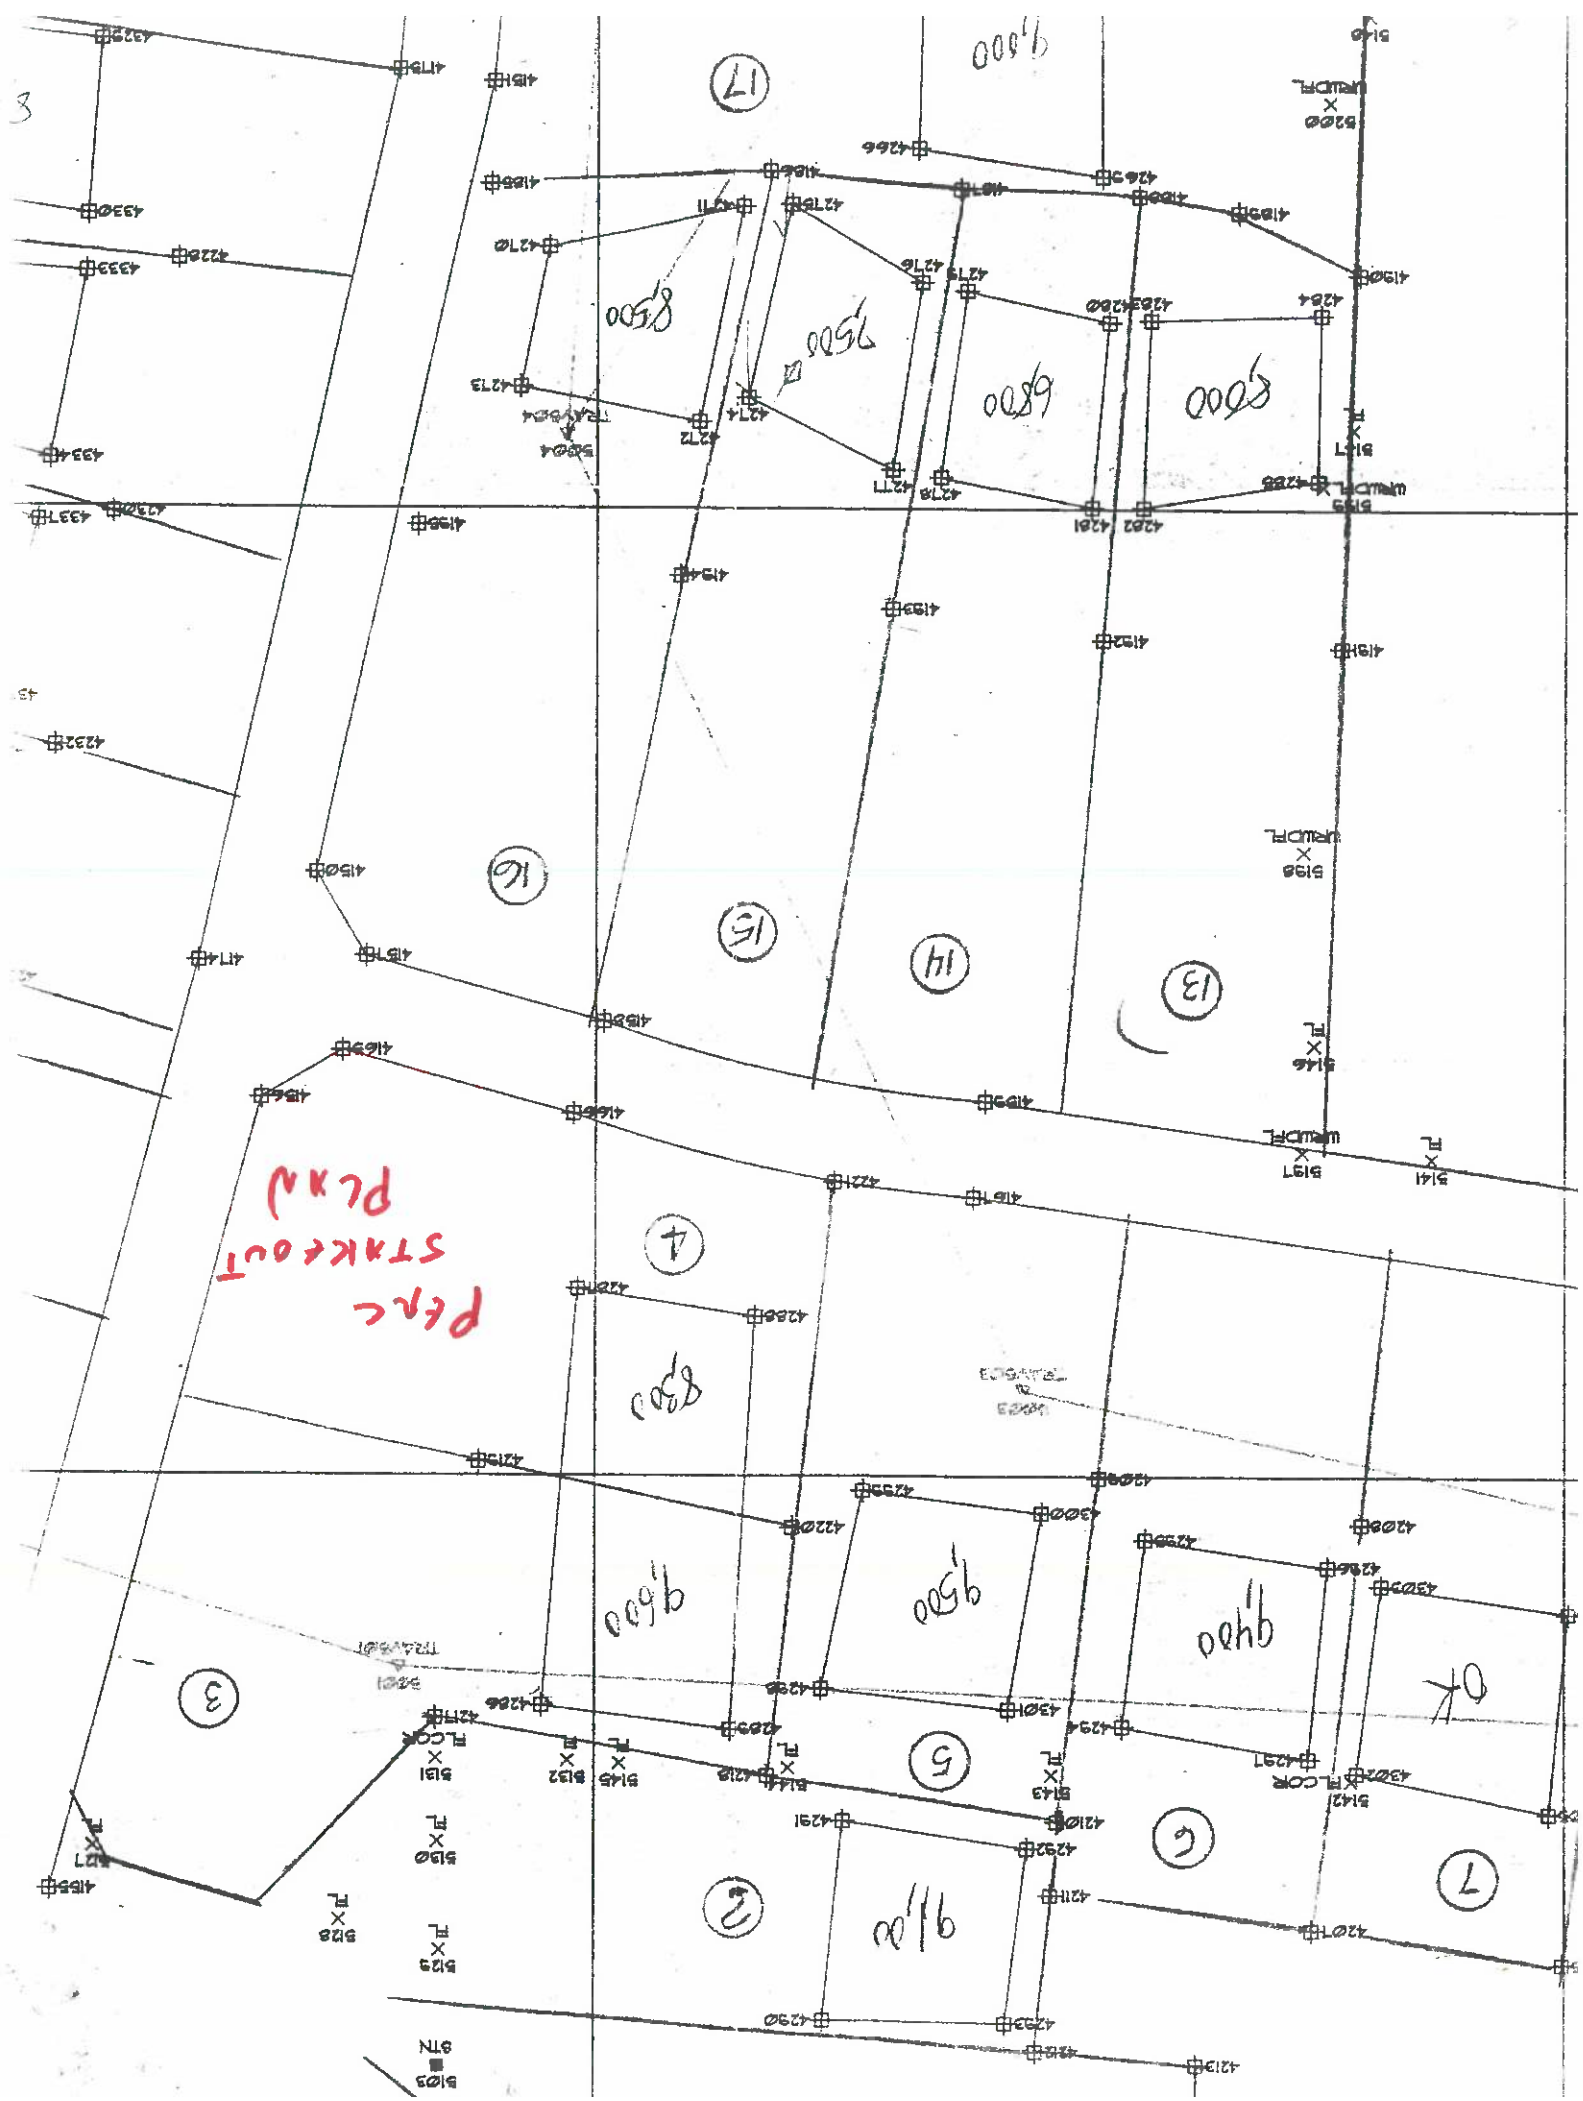


SP. 96.11

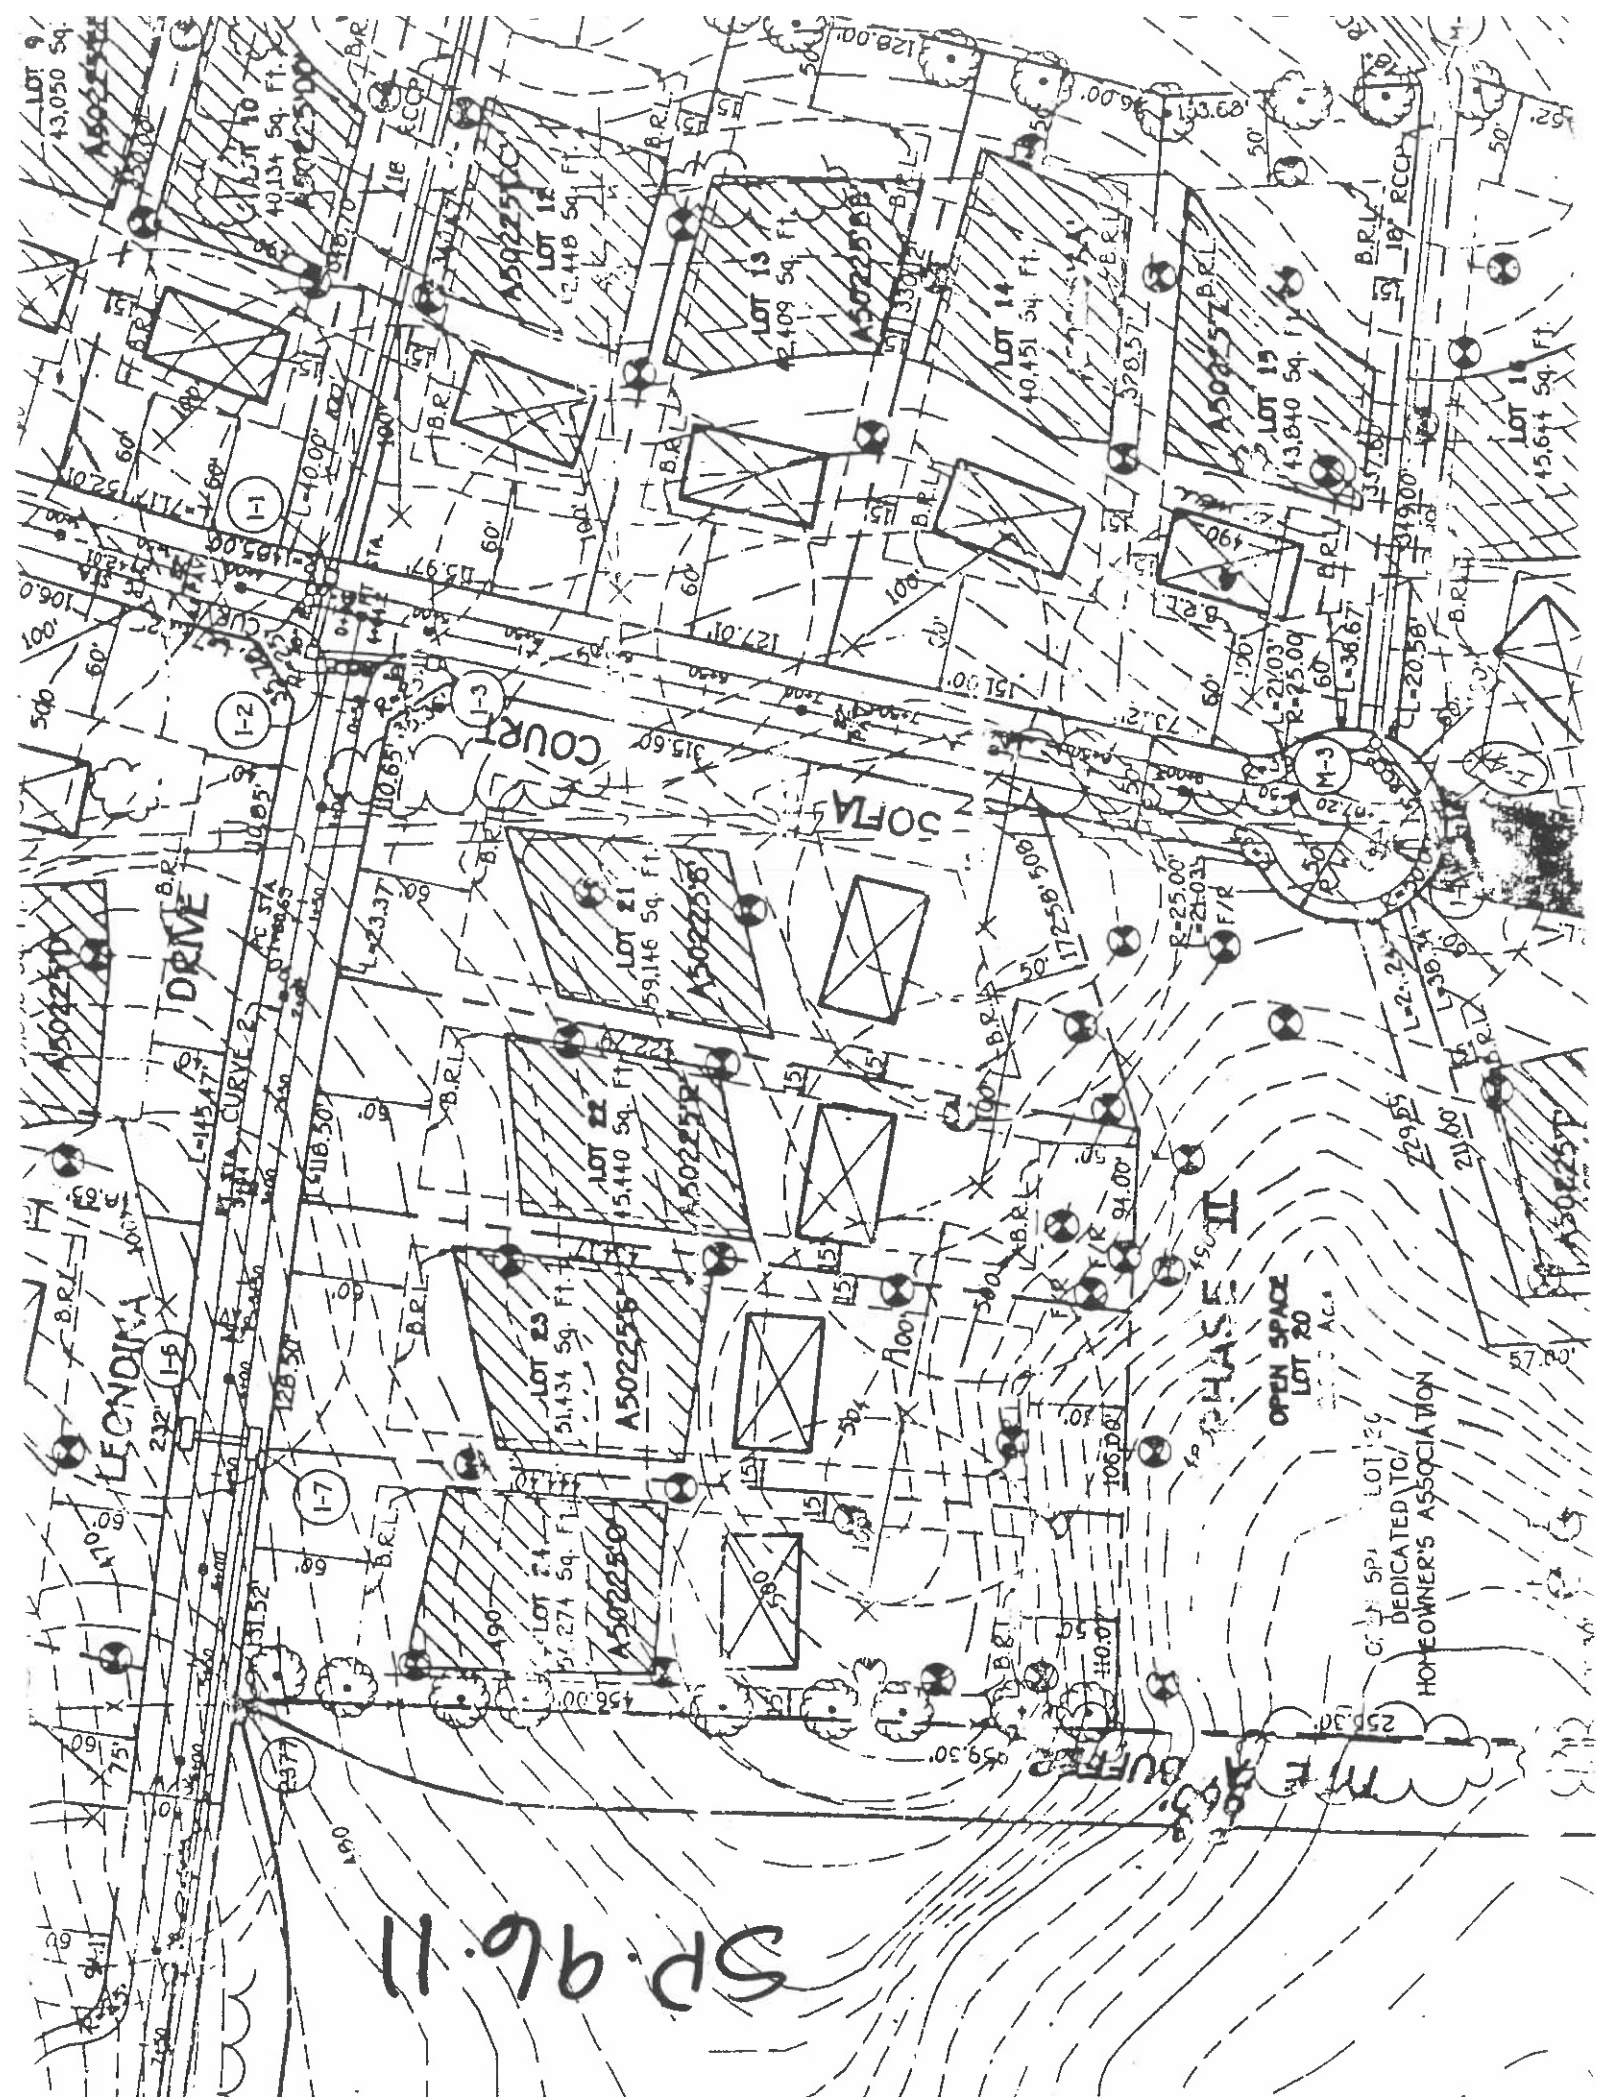



The Requirements S-3-108, The Real Property
 Of Maryland, 1988 Replacement Volume, (As
 They Relate To The Making Of This Plat And
 Have Been Complied With
 Terrell A. Fisher, L.S. 40032
 (Registered Land Surveyor)
 Maryland

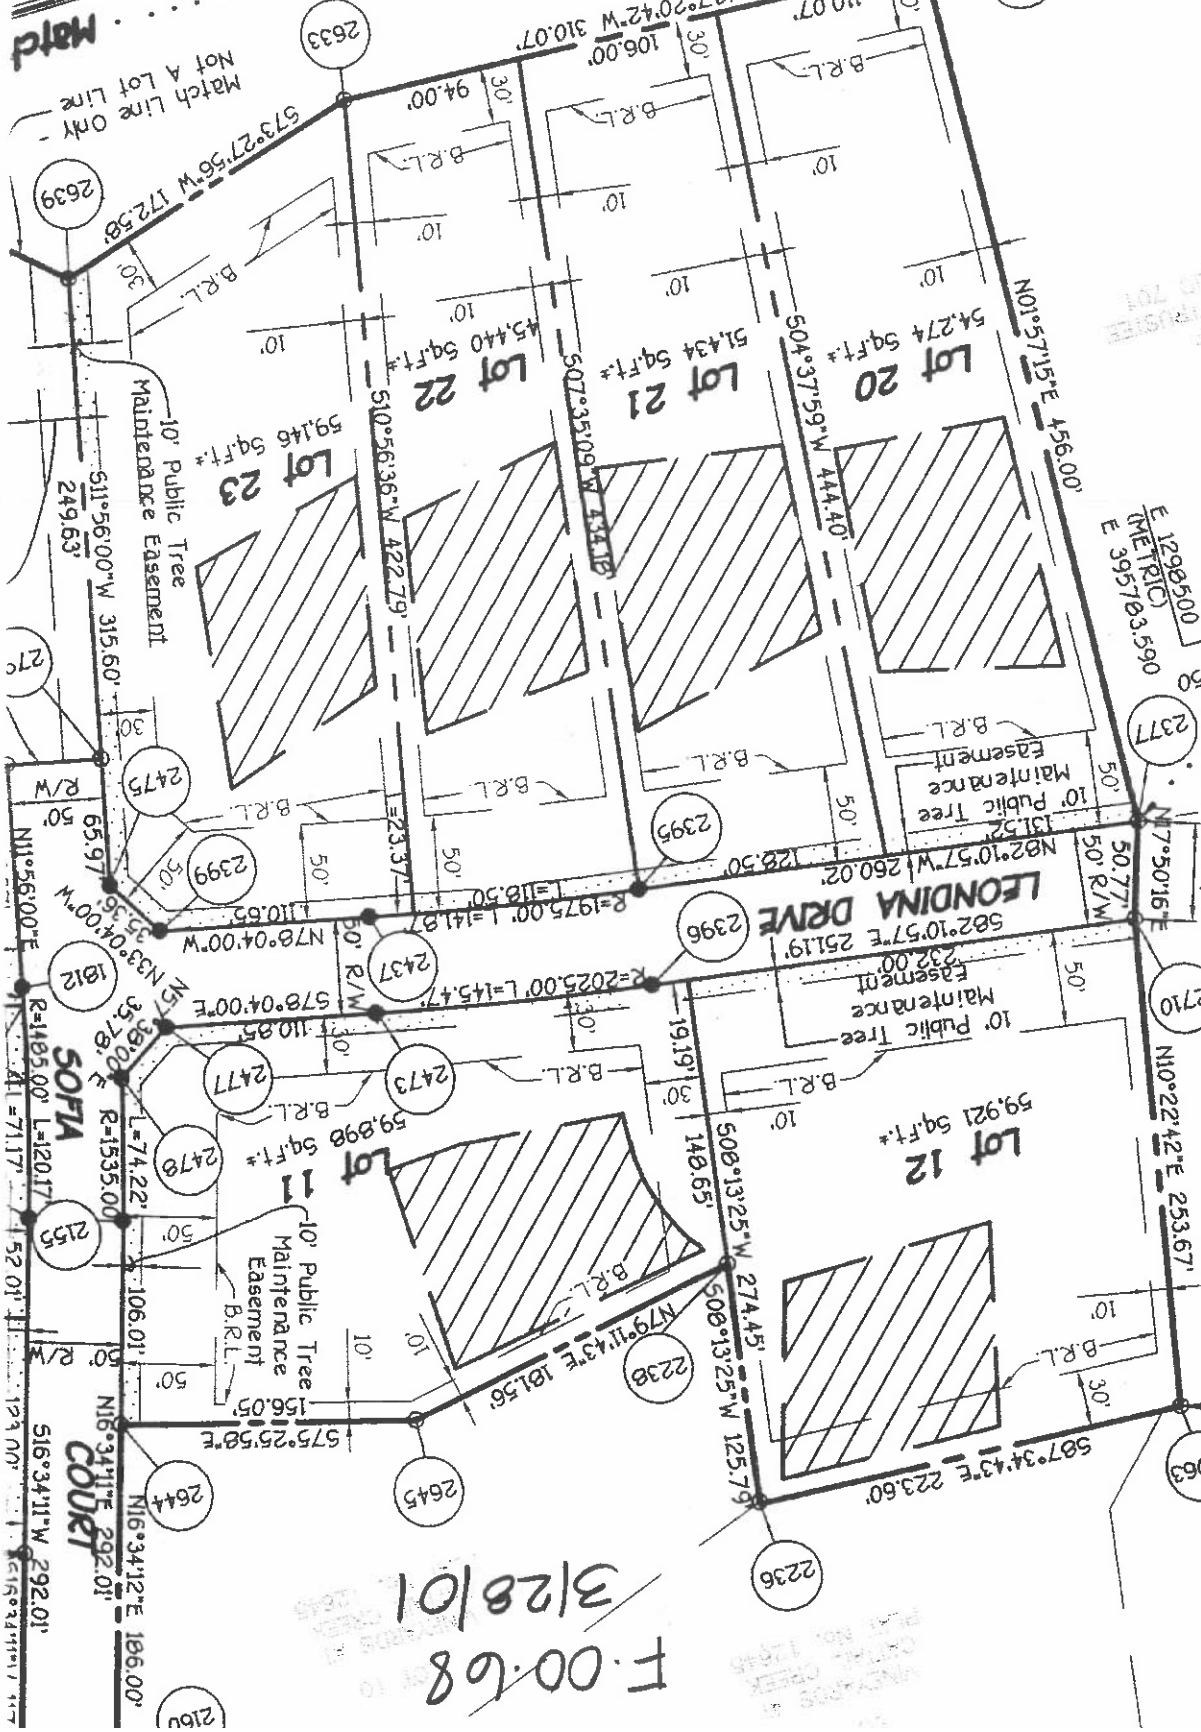

PROPERTY OF
 CARRIAGE RAILROAD, INCORPORATED
 UNDER THE LAWS OF THE STATE OF MARYLAND

N 178°00'3.550
 (METRIC)
 N 58°40'00
 E 129°05'00
 E 395'703.590

MATCH LINE SEE SHEET 3

178°18'3.120
 (METRIC)
 N 58°45'00
 E 129°05'00
 E 395'703.590

F.00.68
 3/28/01