

APPLICATION

HOWARD COUNTY HEALTH DEPARTMENT
BUREAU OF ENVIRONMENTAL HEALTH
3525-H ELLICOTT MILLS DRIVE/ELLICOTT CITY, MARYLAND 21043
TELEPHONE: 313-2640

PERCOLATION TESTING

7/18/96 TO SUPPORT/VERIFY
RE TEST TO SUPPORT/VERIFY
PLAT ERROR CHECK
NO FEE

A 30412

P _____

DISTRICT _____

DATE 7/18/96

TO: THE COUNTY HEALTH OFFICER
ELLICOTT CITY, MARYLAND

I HEREBY APPLY FOR THE NECESSARY TEST PRIOR TO APPLICATION FOR PERMIT TO CONSTRUCT (OR RECONSTRUCT) A SEWAGE DISPOSAL SYSTEM.

PROPERTY OWNER JEFF VAN STONE

ADDRESS 9138 WINDING WAY PHONE _____

AGENT OR PROSPECTIVE BUYER _____

ADDRESS _____ PHONE _____

PROPERTY LOCATION:

SUBDIVISION WYNFIELD LOT NO. 22

ROAD AND DESCRIPTION _____

TAX MAP _____ PARCEL # _____

SIZE OF LOT 3 ACRES TYPE BLDG. SFO
(SINGLE FAMILY DWELLING OR COMMERCIAL)

THE SYSTEM INSTALLED UNDER THIS APPLICATION IS ACCEPTABLE ONLY UNTIL PUBLIC FACILITIES BECOME AVAILABLE. I FULLY UNDERSTAND THE FEE CONNECTED WITH THE FILING OF THIS PERC TEST APPLICATION IS NON-REFUNDABLE UNDER ANY CIRCUMSTANCES. I ALSO AGREE TO COMPLY WITH ALL M.O.S.H.A. REQUIREMENTS IN TESTING THIS LOT.

(SIGNATURE OF APPLICANT)

APPROVED BY _____ FOR _____ DATE _____

DISAPPROVED BY _____ FOR _____ DATE _____

HOLD PENDING FURTHER TESTS _____

REASONS FOR REJECTION OR HOLDING _____

PERCOLATION TEST PLAT/PRELIMINARY PLAT - TITLE OR I.D. # _____ DATE _____

SITE DEVELOPMENT PLAN/FINAL PLAT - TITLE OR I.D. # _____ DATE _____

THIS IS NOT A PERMIT

30412

COUNTY #


SOIL PROFILE

TOP SOIL
Brown CL.
3-4
BROWN ORANGE
MOTTLED
GREY
MIST LAM.
WOOD LIKE
BROWN
SI LOAM
5'
GREY BLU
MIST LOAM
6'

TOP SOIL
Brown
CLAY
LOAM
3
Brown
MICACOUS
SI LOAM
12
G

TOP SOIL
MICA
SANDY
S.L.
10
WATER
11'

NOT TO SCALE

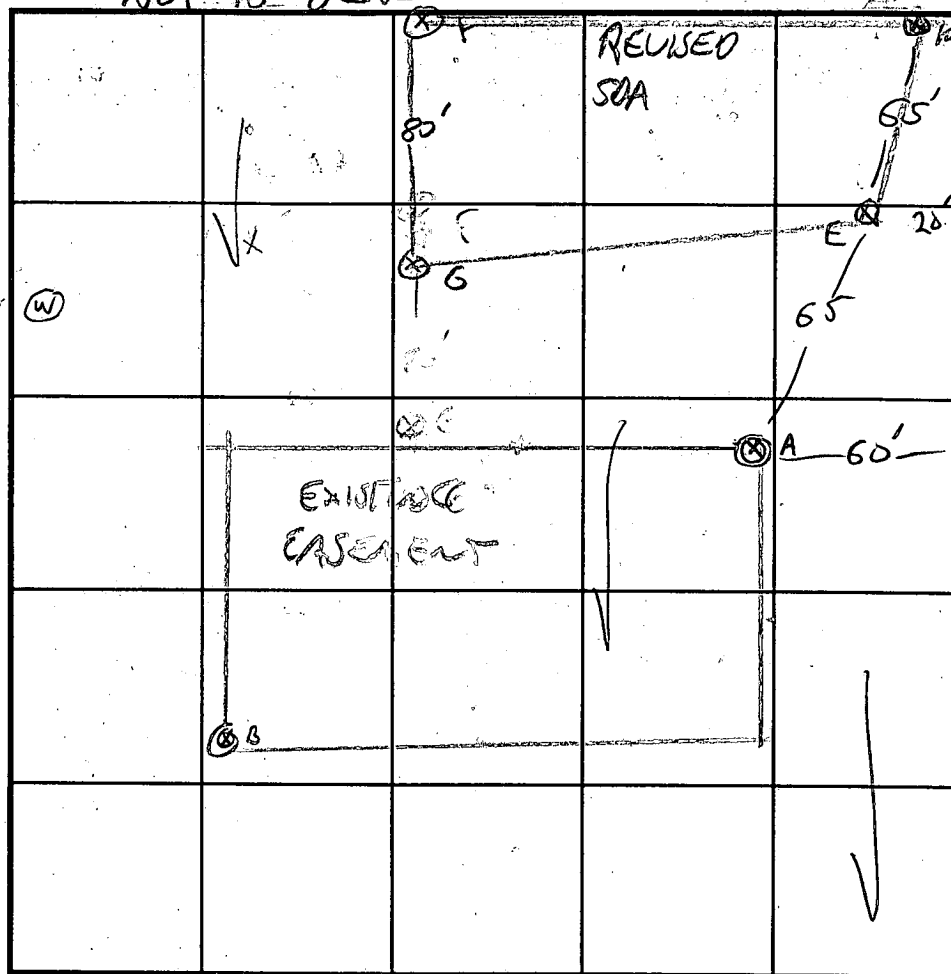

← PROP CR

SOIL PROFILE

TOP SOIL
Brown CL.
2.5'
20% MICA-
RANGE
6
CAVING IN
WET
11'6"

INDICATE NORTH - NAME ADJOINING ROADWAY AS BASE LINE.

ACCESS ROAD

TO WYFIELD →

DATE	TEST NO.	DEPTH	PRE-WET		TEST - 1" DROP		TIME
			START	STOP	START	STOP	
7/18/96	XA. EAL	-WATER AT					
	XB FAL	-WATER					
	E	4.5/12	11:37	11:42	11:42	11:55	13 MW
	C	4.5/11.6	11:49	11:52	11:52	11:56	4 MW
	F	3.5/11	12:17	12:21	12:21	12:25	4 MW
	G	3.5/12	12:38	12:39	12:39	12:41	2 MW

REMARKS

TYPE OF SOIL

TESTED BY G. SAVAGE

OWNER, ENGINEER
DON RICK-FROCK'S

TRENCH DESIGN DATA: AVERAGE PERCOLATION TIME 7 MW

TRENCH WIDTH 3

INLET DEPTH 33.5

MAXIMUM BOTTOM DEPTH 5.5

SQ. FT./BEDROOM 180