

PERMIT

SEWAGE DISPOSAL SYSTEM

DEPARTMENT OF HEALTH AND MENTAL HYGIENE

HOWARD COUNTY HEALTH DEPARTMENT

BUREAU OF ENVIRONMENTAL HEALTH

~~XX61-9933~~ 313-2640

INDEXED

03-309924

P 57302

A 30412

DISTRICT 3rd

DATE 10-4-96

DATE SYSTEM APPROVED 10-7-96

INSPECTOR DRS

Jack Fyock Septic Service

IS PERMITTED TO INSTALL ☒ ALTER ☐

ADDRESS 4105 Ten Oaks Road, Dayton, Maryland 21036 PHONE 988-9270

SUBDIVISION Wynfield LOT 22 ROAD 2761 Wynfield Road

PROPERTY OWNER Jeff VanStone

ADDRESS

SEPTIC TANK CAPACITY 1250 GALLONS

NUMBER OF BEDROOMS 4

180 SQUARE FEET PER BEDROOM

LINEAR FEET OF TRENCH REQUIRED 240

TRENCHES - Trench to be 3 feet wide. Inlet 3.5 feet below original grade. Bottom maximum depth 5.5 feet below original grade. Effective area begins at 5.5 feet below original grade. 2 feet of stone below distribution pipe.

LOCATION - Place the distribution box 70 feet off and 10 feet higher than the junction of the 294.47 and 280.85' lot lines. Run trenches along contour in both directions.

NOTES - No trench to exceed 100 feet in length. Provide 6" - 8" diameter cleanout and cap to grade or above on septic tank. 8/30/96 OK ALM

PLANS APPROVED BY Glen Savage DATE 08/21/96

COVER NO WORK UNTIL INSPECTED AND APPROVED

NEITHER THE HOWARD COUNTY COUNCIL NOR THE HEALTH DEPARTMENT IS RESPONSIBLE FOR THE SUCCESSFUL OPERATION OF ANY SYSTEM

NOTE: CLEANOUT REQUIRED EVERY 70 FEET OF SEWER LINE AND/OR AT 90° SWEEPS IN LINES FROM HOUSE TO DRAIN FIELDS, 90° ELBOWS NOT ACCEPTABLE.

NOTE: ALL PARTS OF SEPTIC SYSTEMS (I.E. TANK, DISTRIBUTION BOX TRENCHES) TO BE 100 FEET FROM WELL (UNLESS OTHERWISE SPECIFICALLY AUTHORIZED)

NOTE: IF DEEP TRENCH(ES) ARE USED CALL FOR INSPECTION BEFORE AND AFTER PLACING GRAVEL IN TRENCH(ES)

NOTE: NO DRY WELL SHALL EXCEED 15 FOOT IN DIAMETER NO ABSORPTION TRENCH TO EXCEED 100 FEET IN LENGTH

NOTE: ALL PIPE FROM HOUSE TO SEPTIC TANK MUST BE CAST IRON OR SCHEDULE 35/40 PVC OR ABS


PERMIT VOID AFTER TWO YEARS

NOTE: INSTALL STAND PIPE ON SEPTIC TANK AND DRY WELL STAND PIPES MUST BE 6 INCHES IN DIAMETER CAST IRON. CONCRETE OR TERRA COTTA OR PVA OR ABS ACCEPTED. IF TOP OF SEPTIC TANK IS DEEPER THAN 3 FEET. MANHOLE TO GRADE REQUIRED.

NOTE: DISTRIBUTION BOXES MUST HAVE BAFFLES

*INSTALLER IS RESPONSIBLE FOR OBTAINING FINAL APPROVAL ON THIS PERMIT

A 30412

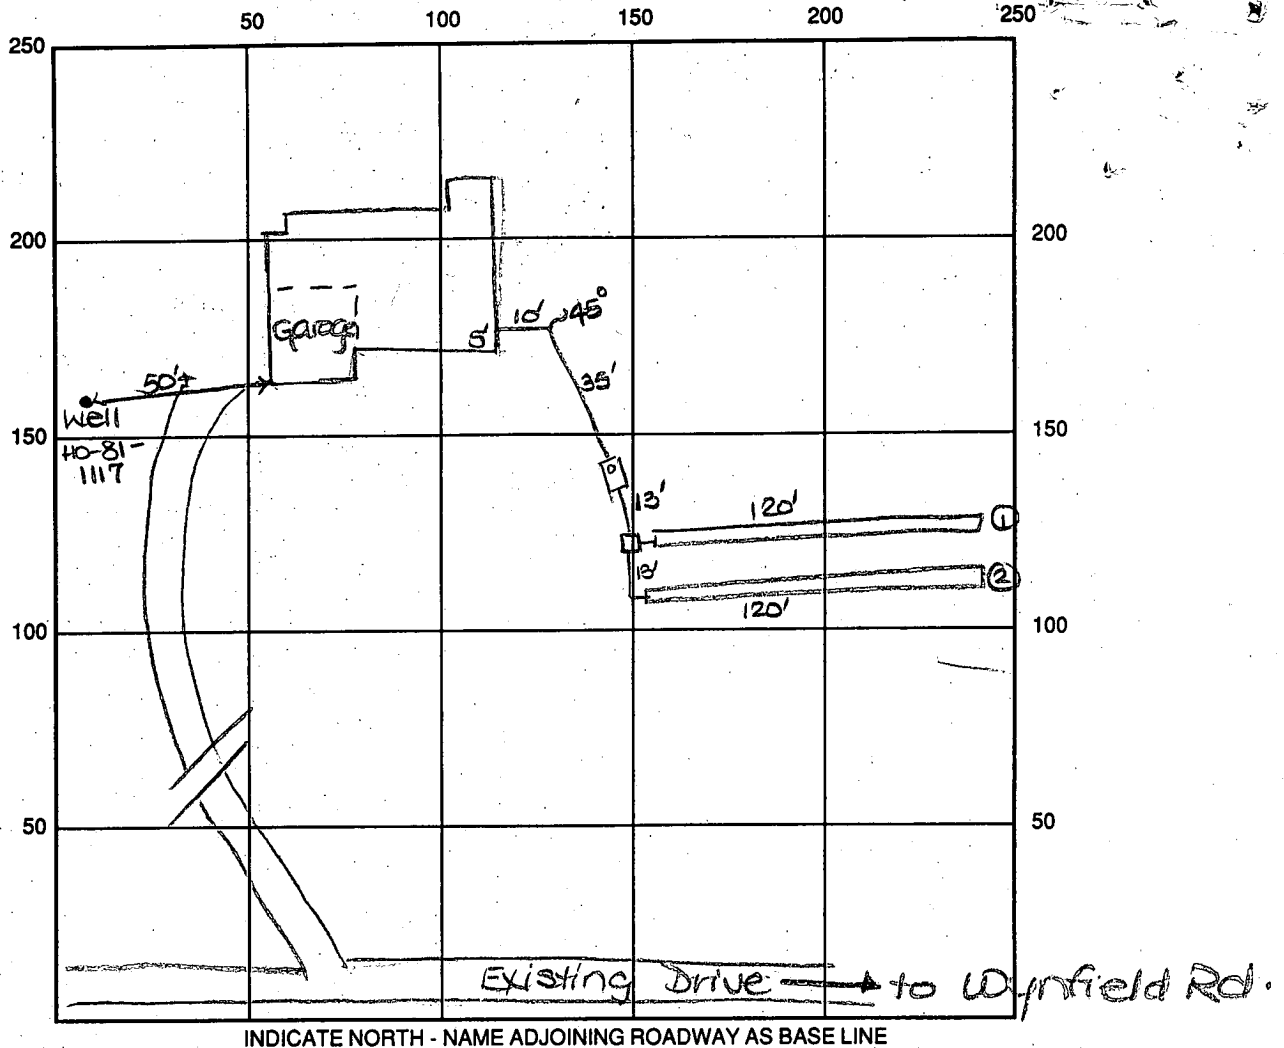

SEPTIC TANK LEVEL OK-1250 gal CLEANOUTS one on s.t.

DISTRIBUTION BOX LEVEL OK

DRAIN FIELD/TITLE DEPTH 5.5 FT. TRENCH WIDTH 3 FT. INLET DEPTH 3.5 FT.

EFFECTIVE GRAVEL DEPTH 2 FT. TOTAL LENGTH ① 120 FT. ② 120 FT. → 240'

NUMBER OF TRENCHES 2 ~~ONE SIDEWALK~~ / BOTTOM AREA 720 SQ. FT.

DRYWALL INSIDE DIAMETER — FT. EFFECTIVE DEPTH BELOW INLET — FT.

ABSORBENT AREA 720 SQ. FT.

REMARKS: 10/7/90 FINAL - OK to cover all work. DKS

DATE SYSTEM APPROVED 10/7/90

INSPECTOR DORNA K JOEL

APPLICATION

HOWARD COUNTY HEALTH DEPARTMENT
BUREAU OF ENVIRONMENTAL HEALTH
3525-H ELLICOTT MILLS DRIVE/ELLICOTT CITY, MARYLAND 21043
TELEPHONE: 313-2640

PERCOLATION TESTING

7/18/96 TO SUPPORT/VERIFY
RE TEST TO SUPPORT/VERIFY
PLAT ERROR CHECK
NO FEE

A 30412

P _____

DISTRICT _____

DATE 7/18/96

TO: THE COUNTY HEALTH OFFICER
ELLICOTT CITY, MARYLAND

I HEREBY APPLY FOR THE NECESSARY TEST PRIOR TO APPLICATION FOR PERMIT TO CONSTRUCT (OR RECONSTRUCT) A SEWAGE DISPOSAL SYSTEM.

PROPERTY OWNER JEFF VAN STONE

ADDRESS 9138 WINDING WAY PHONE _____

AGENT OR PROSPECTIVE BUYER _____

ADDRESS _____ PHONE _____

PROPERTY LOCATION:

SUBDIVISION WYNFIELD LOT NO. 22

ROAD AND DESCRIPTION _____

TAX MAP _____ PARCEL # _____

SIZE OF LOT 3 ACRES TYPE BLDG. SFO
(SINGLE FAMILY DWELLING OR COMMERCIAL)

THE SYSTEM INSTALLED UNDER THIS APPLICATION IS ACCEPTABLE ONLY UNTIL PUBLIC FACILITIES BECOME AVAILABLE. I FULLY UNDERSTAND THE
FEE CONNECTED WITH THE FILING OF THIS PERC TEST APPLICATION IS NON-REFUNDABLE UNDER ANY CIRCUMSTANCES. I ALSO AGREE TO
COMPLY WITH ALL M.O.S.H.A. REQUIREMENTS IN TESTING THIS LOT. _____
(SIGNATURE OF APPLICANT)

APPROVED BY _____ FOR _____ DATE _____

DISAPPROVED BY _____ FOR _____ DATE _____

HOLD PENDING FURTHER TESTS _____

REASONS FOR REJECTION OR HOLDING _____

PERCOLATION TEST PLAT/PRELIMINARY PLAT - TITLE OR I.D. # _____ DATE _____

SITE DEVELOPMENT PLAN/FINAL PLAT - TITLE OR I.D. # _____ DATE _____

THIS IS NOT A PERMIT

SOIL PROFILE

NOT TO SCALE

$$A \leq \text{PROP CR}$$

REUSED
SQA

SOIL PROFILE

750501L

Brown
CL.

ALL ORANGE

NOTED
GREY
MIST LAM
WAS LIKE
BROWN
SI LAM

GREY FLW
M: S: LOAN

Top 500

Brown
Clay
Coon

Brown
nicot
51 com

10/15/11

MICA
5 Aug 4
S.L.

CAUVW6

WATER

INDICATE NORTH - NAME ADJOINING ROADWAY AS BASE LINE.

ACCESS ROAD

TO WYNFIELD

DATE	TEST NO.	DEPTH	PRE-WET		TEST - 1" DROP		TIME
			START	STOP	START	STOP	
7/18/96	XA. FAUL	-WATER AT					
	XB FAUL	-WATER					
	E	4.5/12	11:37	11:42	11:42	11:55	13 MW
	C	4.5/11.6	11:49	11:52	11:52	11:56	4 MW
	F	3.5/11	12:17	12:21	12:21	12:25	4 MW
	G	3.4/12	12:38	12:39	12:39	12:41	2 MW

REMARKS

TYPE OF SOIL

TESTED BY G. SAVAGE

OWNER, ENGINE
ALSO PRESENT DON-RICK-FYOC/LS

TRENCH DESIGN DATA: AVERAGE PERCOLATION TIME 7 min

TRENCH WIDTH 3

INLET DEPTH 33.5 MAXIMUM BOTTOM DEPTH 5.5 SQ. FT./BEDROOM 180

PRELIMINARY

APPLICATION

SEWAGE DISPOSAL TESTING

STATE OF MARYLAND - DEPARTMENT OF HEALTH AND MENTAL HYGIENE

A 30412

P _____

HOWARD COUNTY HEALTH DEPARTMENT
ENVIRONMENTAL HEALTH SERVICES

P.O. BOX 476 ELLICOTT, MARYLAND 21043
TELEPHONE: 992-2330

DISTRICT 3rd.

DATE 12/10/79

TO: THE COUNTY HEALTH OFFICER
ELLICOTT CITY, MARYLAND

I, HEREBY, APPLY FOR THE NECESSARY TEST IN ORDER TO CONSTRUCT (OR RECONSTRUCT) A SEWAGE DISPOSAL SYSTEM.

PROPERTY OWNER Land Associates Jeff Van Stone
ADDRESS 3450 Ft. Meade Rd., No. 205, Laurel, Md. 20810
PHONE Tom Munz - 792-2242
or Ted Snovell - 265-6543

PROPERTY LOCATION: Lot 22 SECT 3
SUBDIVISION Hoffman property WYNFIELD LOT NO. 15
ROAD AND DESCRIPTION Route 144 (2761 Wynfield Road)

SIZE OF LOT 3 acres plus TYPE BLDG. 3 or 4 Bedrooms

THE SYSTEM INSTALLED UNDER THIS APPLICATION IS ACCEPTABLE ONLY UNTIL PUBLIC FACILITIES BECOME AVAILABLE.

I FULLY UNDERSTAND THE FEE CONNECTED WITH THE FILING OF THIS PERC TEST APPLICATION IS NON-REFUNDABLE UNDER

ANY CIRCUMSTANCES.

SIGNATURE OF APPLICANT /s/ Ted Snovell for Land Associates

APPROVED BY R.D. & D.W.M. FOR DRAINFIELDS DATE 12/27/79

REJECTED BY _____ FOR _____ DATE _____


HOLD PENDING FURTHER TESTS _____ DATE _____

REASONS FOR REJECTION OR HOLDING HOLD FOR APPROVAL - 12/17/79



2/1/85 Spec written RH

THIS IS NOT A PERMIT

HOLE #5 SOIL PROFILE

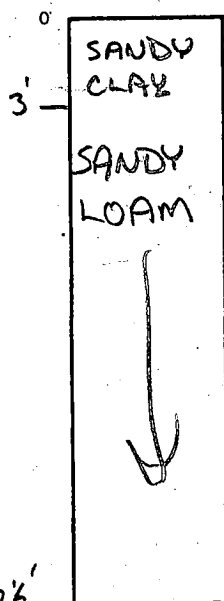

HOLE #344

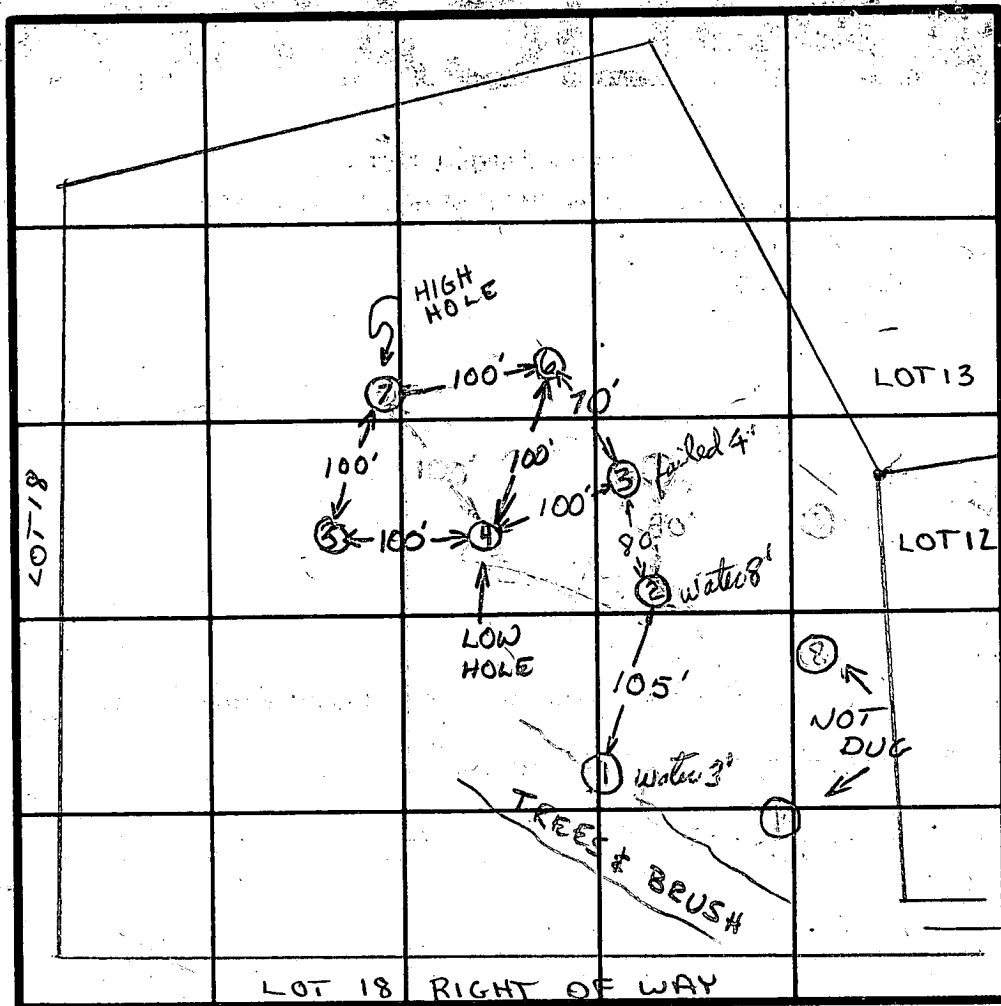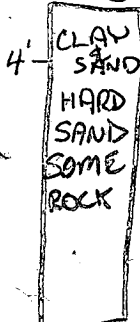

INDICATE NORTH - NAME ADJOINING ROADWAY AS BASE LINE.

DATE	TEST NO.	DEPTH	PRE-WET		TEST - 1" DROP		TIME
			START	STOP	START	STOP	
12/17/79	①	3'	WATER AT 3'				X
	②	10'	WATER AT 8'				X
	3S	4'	3:07	3:30	3:36	FAILED 2 1/2 INCH X	
	3D	12'	3:07	3:14	3:14	3:22	8
	4S	3 1/2'	3:28	3:29	3:29	3:31	2
	4D	12 1/2'	3:28	3:46	3:46	4:06	20
	5S	4'	3:38	3:50	3:50	4:02	12
	5D	12 1/2'	3:38	3:40	3:40	3:42	2
	6S	3 1/2'	3:53	3:54	3:54	3:56	2
	6D	12'	3:53	3:58	3:58	4:04	6
	7S		COULDN'T DIG POT HOLE -				✓
	7D		CAVED IN ON DIGGER				

REMARKS AREA DIFF. FROM PLAT. NO P.O.L.'S OR CORNERS LOCATED, AREA MAY BE DIFF. THAN SHOWN. HOLD FOR WET SEASON

TYPE OF SOIL

TESTED BY

IS + RD.

ALSO PRESENT

DUSZYNSKI

C12367SEQUENCE NO. (OEP USE ONLY)STATE OF MARYLANDWELL COMPLETION REPORTFILL IN THIS FORM COMPLETELYPLEASE PRINT OR TYPE

(THIS NUMBER IS TO BE PUNCHED IN COLS. 3-6 ON ALL CARDS)

COUNTY NUMBERA 30412

PERMIT NO. FROM "PERMIT TO DRILL WELL"40-81-1117

DATE RECEIVED

DATE WELL COMPLETED100985

DEPTH OF WELL30026 (TO NEAREST FOOT)

OWNERMELSON FRANCIS

STREET OR RFDlast name WYNFIELD RDfirst name

TOWNWEST FRIENDSHIP

SUBDIVISIONWYNFIELDSECTIONIIILOT 22

WELL LOGNot required for driven wells

STATE THE KIND OF FORMATIONS PENETRATED, THEIR COLOR, DEPTH, THICKNESS AND IF WATER BEARING

DESCRIPTION (Use additional sheets if needed)FEETFROM TOCheck if water bearing

Brown shale025

Gray mica rock25300

9 Dry wells drilled in with cement & drilling materials

1- 325

2- 280

3- 220

4- 230

5- 240

6- 225

7- 225

8- 125

9- 265

GROUTING RECORD

WELL HAS BEEN GROUTED (Circle appropriate box)yesYnoN

TYPE OF GROUTING MATERIALCEMENTCMBENTONITE CLAYBC

NO. OF BAGS48NO. OF POUNDS752

GALLONS OF WATER48

DEPTH OF GROUT SEAL (to nearest foot)from0ft. to28ft.

CASING RECORD

casing typesinsert appropriate code below

STEELSTCONCRETECO

PLASTICPLOtherOT

MAIN CASING TYPENominal diameter (nearest inch)Total depth (nearest foot)

ST629

OTHER CASING (if used) diameter inchdepth (feet) from to

SCREEN RECORD

screen type or open holeinsert appropriate code below

STEELSTBRASSBRONZEPLASTICPLOtherOT

DEPTH (nearest ft.)

1- 28

2- 300

3- 300

4- 300

5- 300

6- 300

7- 300

8- 300

9- 300

SLOT SIZE 1- 2- 3

DIAMETER OF SCREEN (NEAREST INCH)

5660

GRAVEL PACK

IF WELL DRILLED WAS FLOWING WELL INSERT F IN BOX 68

OEP USE ONLY (NOT TO BE FILLED IN BY DRILLER)

T (E.R.O.S.)7072

WQ747576

TELESCOPE CASINGLOG INDICATOROTHER DATA

C3

PUMPING TEST

HOURS PUMPED (nearest hour)3

PUMPING RATE (gal. per min. to nearest gal.)4

METHOD USED TO MEASURE PUMPING RATEbucket

WATER LEVEL (distance from land surface) BEFORE PUMPING27

WHEN PUMPING143

TYPE OF PUMP USED (for test)A airP pistonT turbineC centrifugalR rotaryO other (describe below)J jetS submersible

PUMP INSTALLED

DRILLER WILL INSTALL PUMP (CIRCLE) YES (NO)

IF DRILLER INSTALLS PUMP, THIS SECTION MUST BE COMPLETED FOR ALL WELLS EXCEPT HOME USE

TYPE OF PUMP INSTALLED PLACE (A,C,J,P,R,S,T,O) IN BOX - SEE ABOVE:29

CAPACITY: GALLONS PER MINUTE (to nearest gallon)3135

PUMP HORSE POWER3741

PUMP COLUMN LENGTH (nearest ft.)4347

CASING HEIGHT (circle appropriate box and enter casing height)abovebelowLAND SURFACE (nearest foot)5051

LOCATION OF WELL ON LOT

SHOW PERMANENT STRUCTURE SUCH AS BUILDING, SEPTIC TANKS, AND/OR LANDMARKS AND INDICATE NOT LESS THAN TWO DISTANCES (MEASUREMENTS TO WELL)

294.47

280.65


[illegible]


ADDITIONAL PERC TESTS DE
 LOTS 12, 13, 14, 99, 100
 RETEST LOT NO. 29 & 30 DEC. 1

1" = 100'

UNIMATED
 75' 17'
 ZONED

North

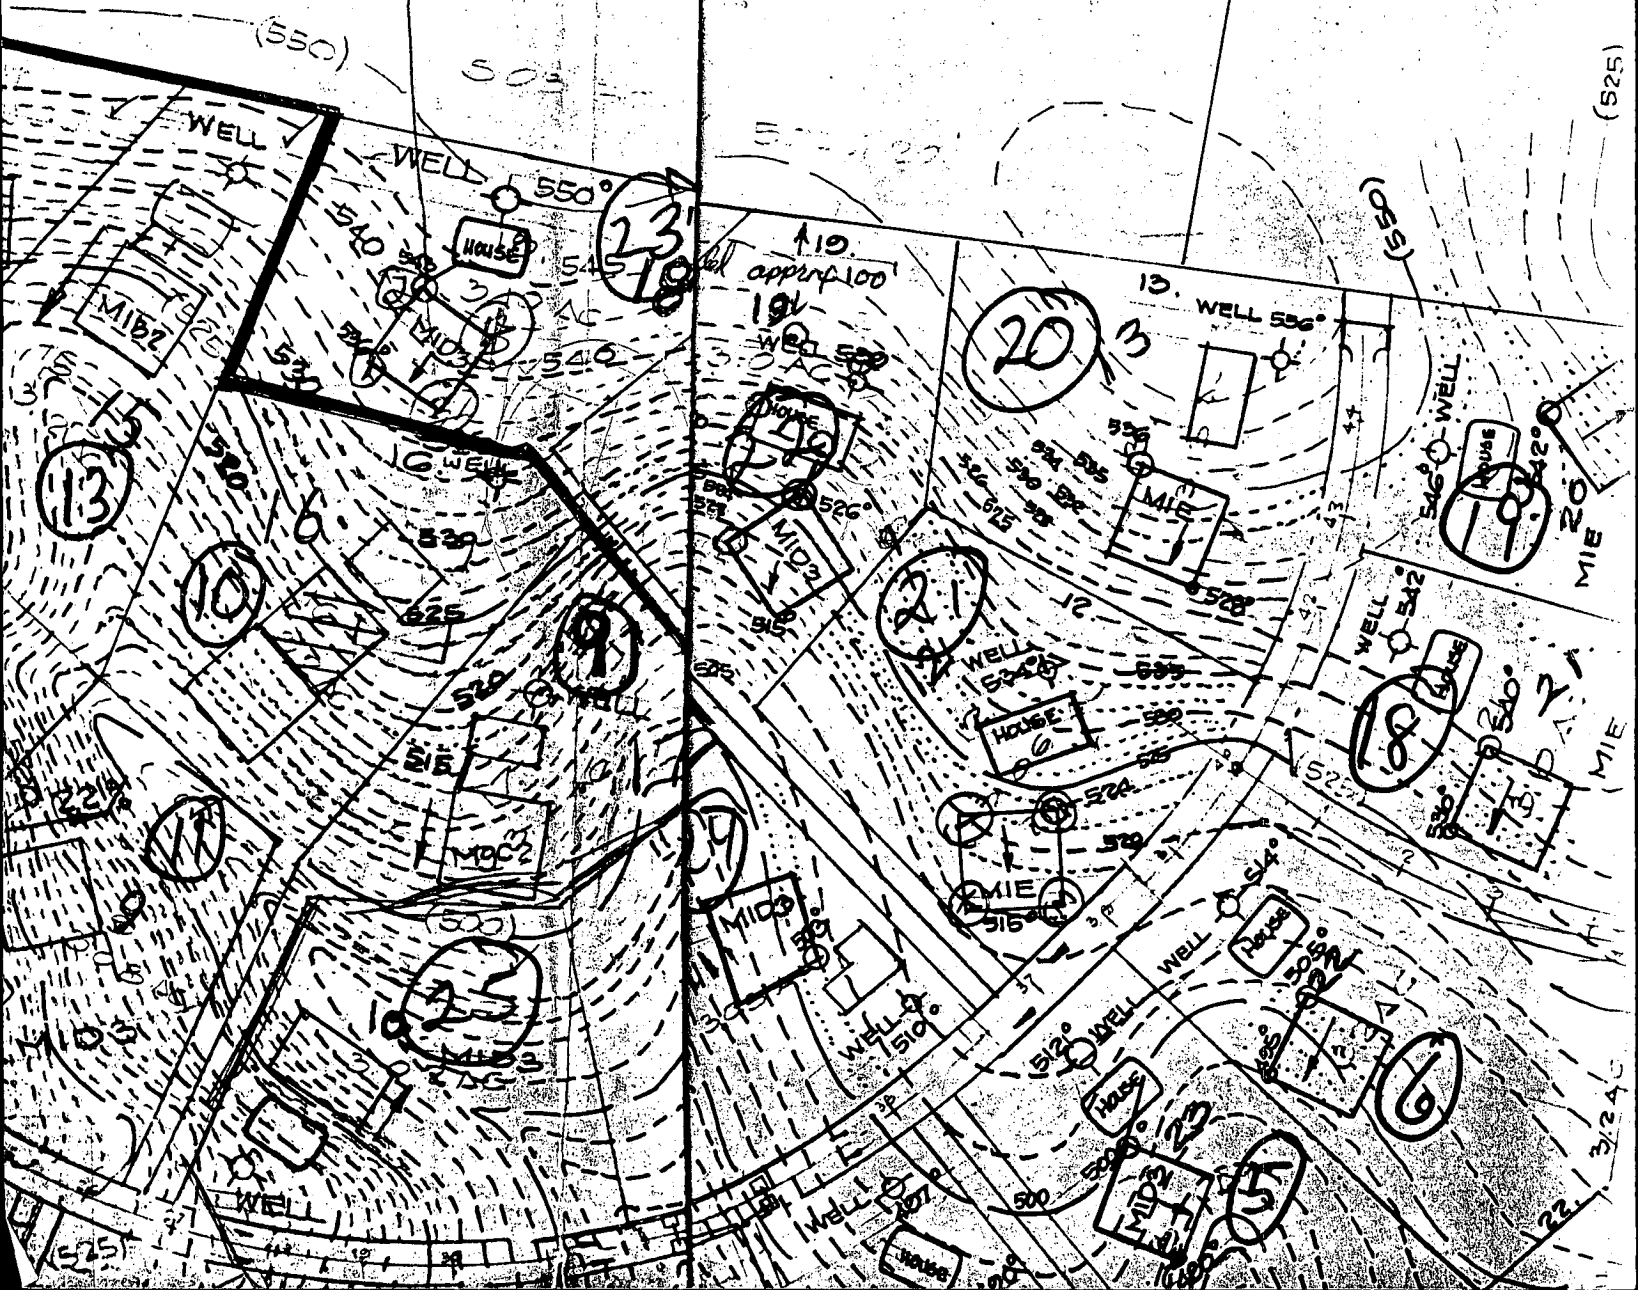

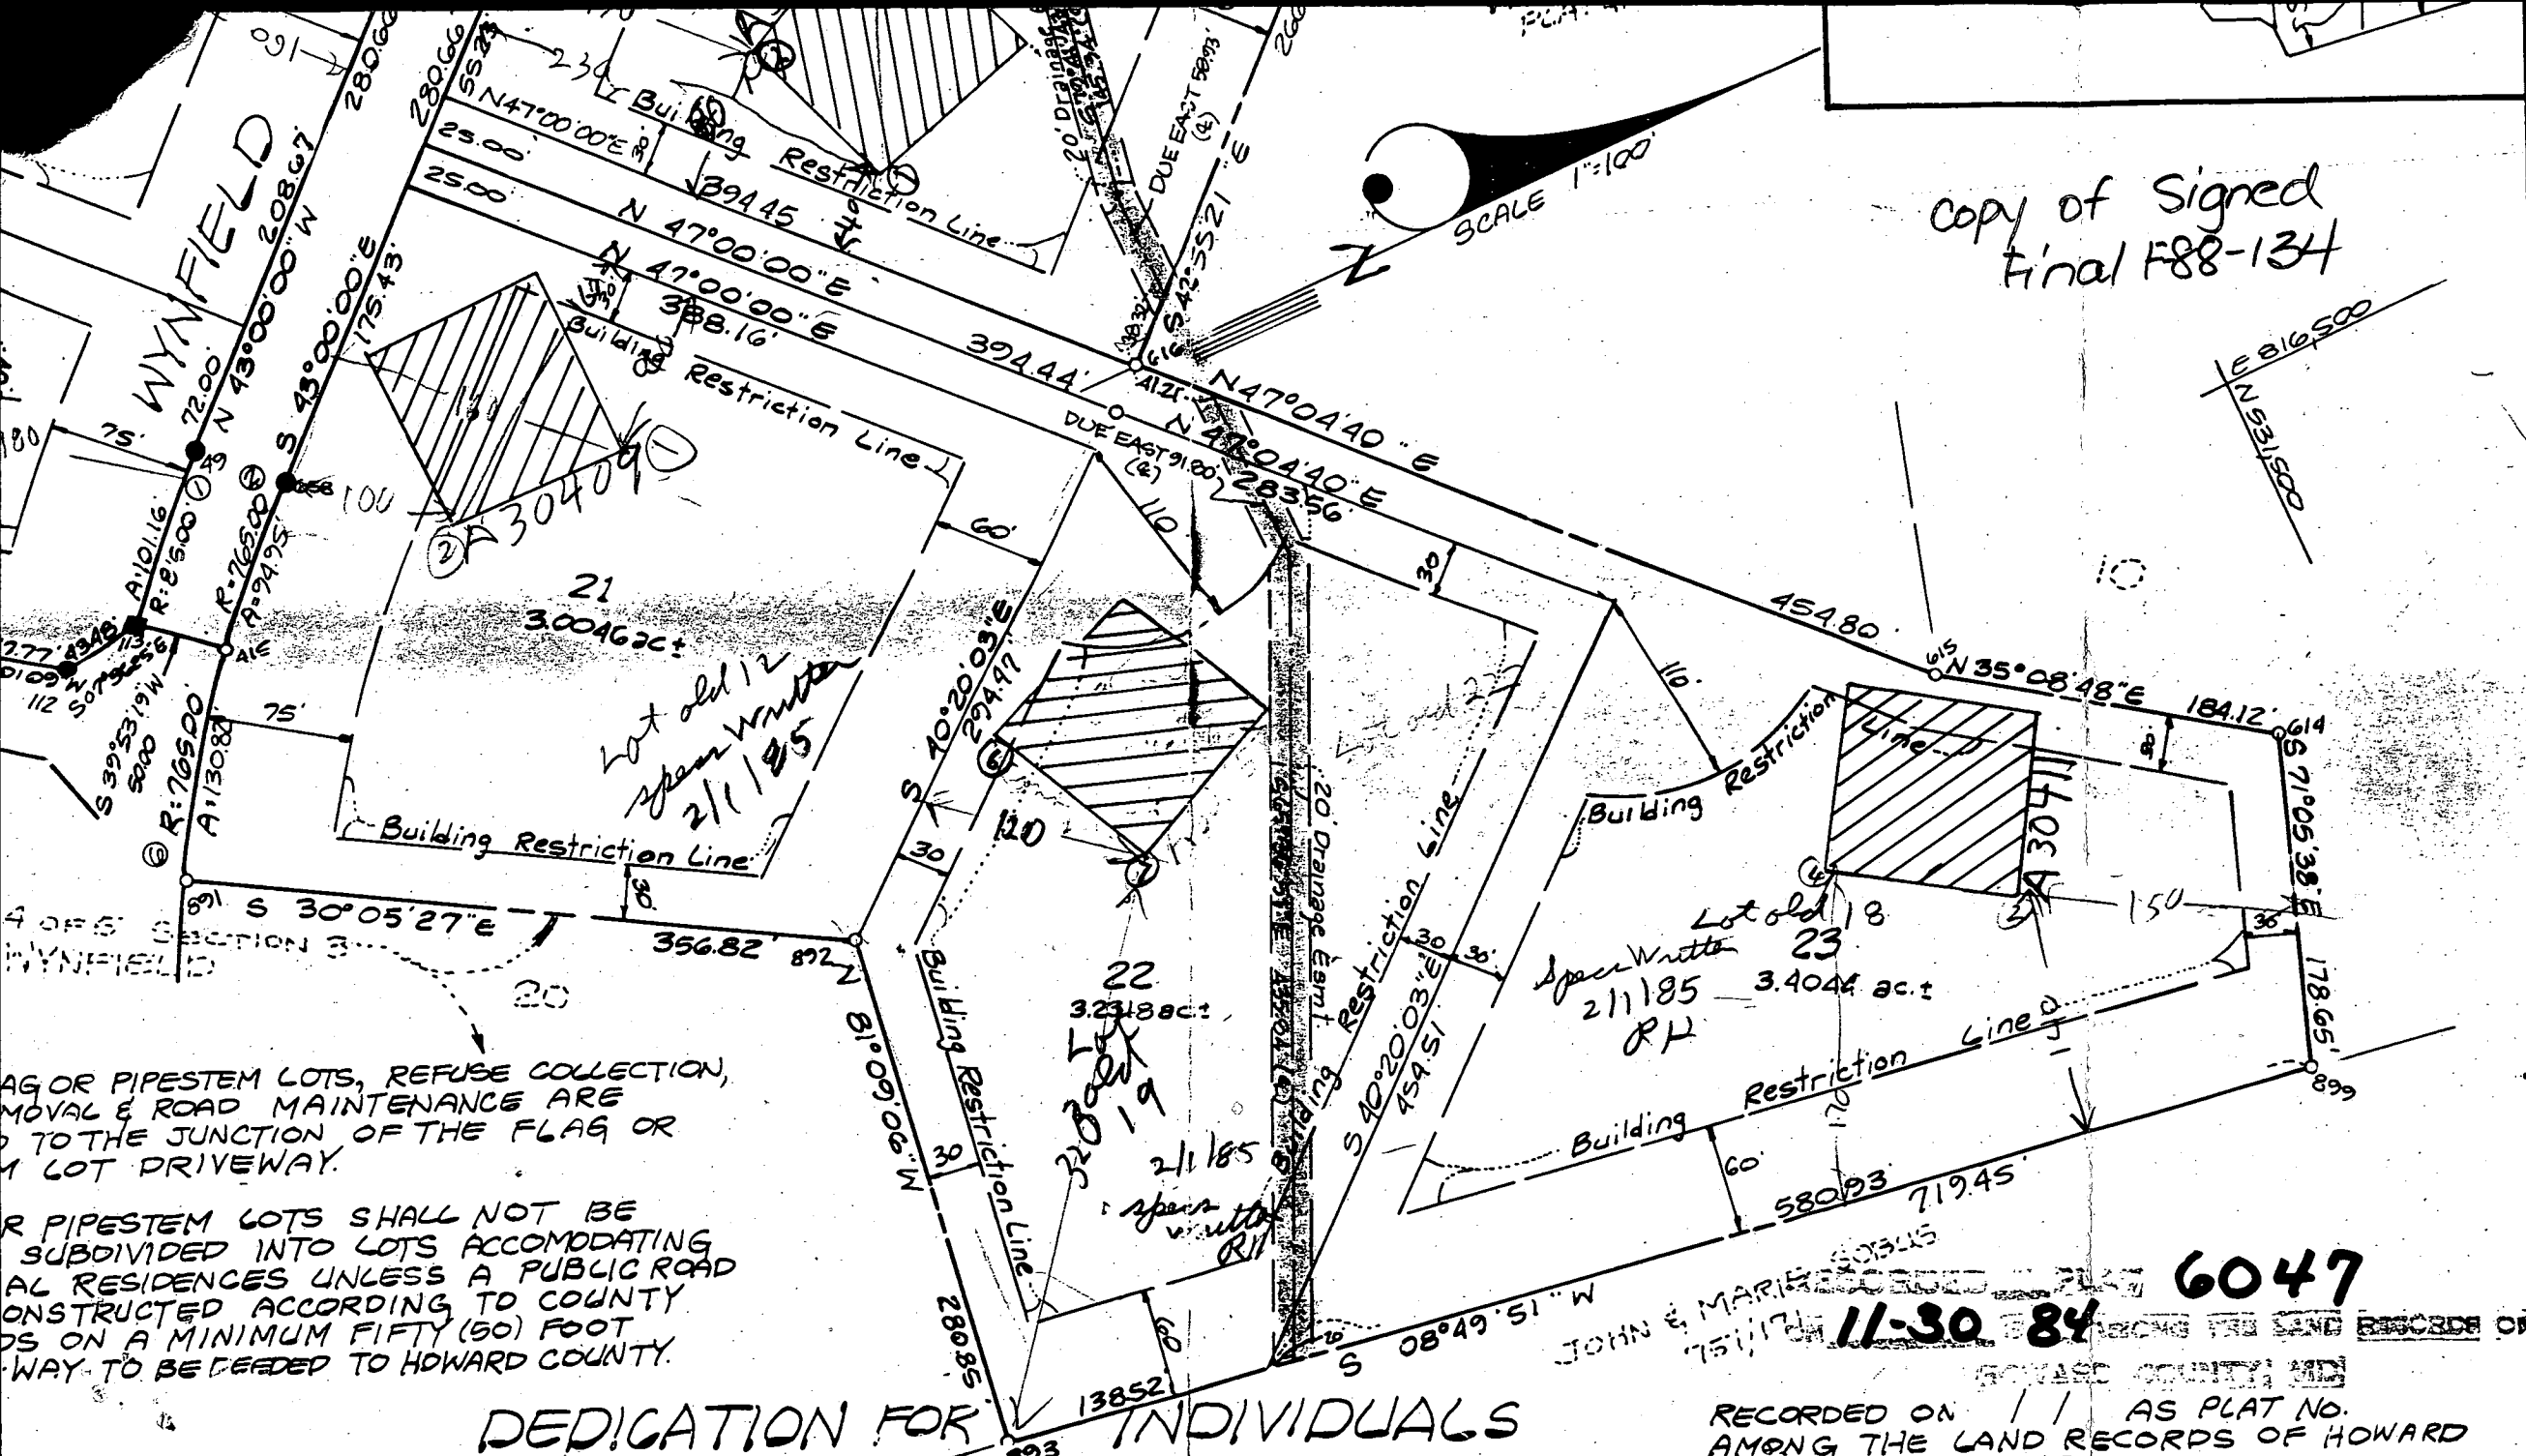

copy of Signed
Final F88-134

FLAG OR PIPESTEM LOTS, REFUSE COLLECTION,
REMOVAL & ROAD MAINTENANCE ARE
TO THE JUNCTION OF THE FLAG OR
LOT DRIVEWAY.

PIPESTEM LOTS SHALL NOT BE
SUBDIVIDED INTO LOTS ACCOMMODATING
RESIDENCES UNLESS A PUBLIC ROAD
CONSTRUCTED ACCORDING TO COUNTY
ORDINANCES ON A MINIMUM FIFTY (50) FOOT
DRIVEWAY TO BE DEDED TO HOWARD COUNTY.

DEDICATION FOR INDIVIDUALS

WE, BALLANGER CREEK ASSOCIATES, A MARYLAND LIMITED PARTNERSHIP,
BY KENNETH H. ROBERTS & THOMAS C. MUNZ, GENERAL PARTNERS, OWNERS OF THE
PROPERTY SHOWN AND DESCRIBED HEREON, HEREBY ADOPT THIS PLAN OF
SUBDIVISION, & IN CONSIDERATION OF THE APPROVAL OF THIS FINAL PLAT
BY THE OFFICE OF PLANNING AND ZONING, ESTABLISH THE MINIMUM BUILDING

JOHN E. MARSHALL
11-30-84
6047
RECORDED ON 11-30-84 AS PLAT NO. 6047
AMONG THE LAND RECORDS OF HOWARD COUNTY, MARYLAND

RECORDED ON 11-30-84 AS PLAT NO. 6047
AMONG THE LAND RECORDS OF HOWARD COUNTY, MARYLAND

FINAL PLAT

