

Approved 2/25/26
H.O.

Menu Save Reset Cancel Help

Record Detail * (This section is required.)

Permit Type Permit Number Opened Date
Building/Residential/Alteration/SFD B26000507 02/20/2026

Description of Work

SFD/ interior alteration to remove interior non load bearing walls in the kitchen space. **SUBJECT TO FIELD INSPECTION**

Online BP.
g8 2/24/26

[check spelling](#)

Address * (This section is required.)

Search Reset Clear Get Parcel & Owner

Street # Street Name Street Type
1508 GROOMS LN
Unit Type Unit # X Coordinate Y Coordinate
-Select- -76.87287 39.33002
City State Zip Code Primary
WOODSTOCK MD 21163 Yes

Parcel * (This section is required.)

Search Reset Clear Get Address & Owner

GIS ID * Parcel Parcel Area Land Value Improved Value Exemption Value Plan Area
908090 83 1 271200 698900 427700 RURAL

Legal Description

IMPSLOT 7 1.000 A[] 1508 GROOMS LN[] L GERTRUDE B PLAT

[check spelling](#)

Block Lot Census Tract Council Dist Inspection Dist Supervisor Dist Map # DAP Zone
7 603000 5 6
Plan Area State Tax Id Subdivision Name
1403286991
Section Area Tax Map
10
Grid Zoning District ADC Map
10-18 RC-DEO 4695-A8
SDP No. Final Plan No. WP File No.
Record Plat No. WS Contract No. FDP No. Primary
63 208 Yes
Owner Occupied Year Built Historic District
Yes No 1994 Yes No
Historic District Registry No. Stat Area Flood Plain
3-02A Yes No
Building No

Owner (This section is not required.)

Search Reset Clear

Name *
SYED I
Address Line 1
1508 GROOMS LN
Address Line 2
Address Line 3
Mail City
WOODSTOCK
Mail State
MD
Mail Zip Code
21163
Phone
410-782-9124
Primary
Yes
E-mail

goharns@hotmail.com

Cell Number

4108050594

Fax Number

Professionals (This section is not required.)

License # *	Business Name			
License Type *	First Name	Middle Name	Last Name	
--Select--	▼			
Primary	Address Line 1			
Yes	▼			
	Address Line 2			
	City		State	ZIP Code
	Phone 1	Phone 2	Fax	
	E-mail			

Applicant (This section is not required.)

Search As Owner As Lic. Prof As Contact

Type *	First Name	MI	Last Name	
Applicant	▼ MEHREEN		PASHA	
Relationship	Full Name			
Applicant	▼ MEHREEN PASHA			
Primary	Organization Name			
No	▼			
	Street Address			
	1508 Grooms Ln			
	Address Line 2			
	1508 grooms ln			
	City		State	Zip Code
	Granite		MD	21163
	Phone	Cell	Fax	
	4108050594			
	E-mail *			
	MEHREEN.PASHA1988@GMAIL.COM			

Contact (This section is not required.)

Search As Owner As Lic. Prof As Contact

Type	First Name	MI	Last Name	
Contact	▼ Gohar	E-Naye	Syed	
Relationship	Full Name			
Applicant	▼ SYED GOHAR E NAYAB			
Primary	Organization Name			
Yes	SYED GOHAR E NAYAB			
	Street Address			
	1508 GROOMS LN			
	Address Line 2			
	City		State	Zip Code
	WOODSTOCK		MD	▼ 21163
	Phone	Cell	Fax	
	410-782-9124			
	E-mail			
	GOHARNS@HOTMAIL.COM			

Addtl Info

Est Construction Cost *	Housing Units *	Number of Buildings *	Public Owned
30000	0	0	No ▼
Construction Type	▼		
434 - Additions, Alterations and Conversions - Residential			

RESIDENTIAL ALTERATION INFO

RESIDENTIAL ALTERATION INFORMATION

Total Square Footage *	No of Stories *	Basement	Bedrooms	Full Baths	Half Baths	Water *	Sewage *
300	SQFT (Number) 2	(Number) Full Finished	▼ 3	(Number) 2	(Number) 0	(Number) Private	▼ Private

Existing Utilities *
Electric ▼

Existing Heating System *
Electric ▼


Existing Sprinkler System *
None ▼

Type of New Fireplace
--Select-- ▼

Expiration Date
8/19/2026 

Submit Cancel


DATE _____

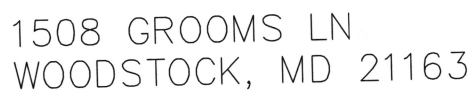

REV. 2

FLOOR PLAN 1ST FLOOR—NON STRUCTURAL CHANGES TO FLOOR PLAN

DATE _____

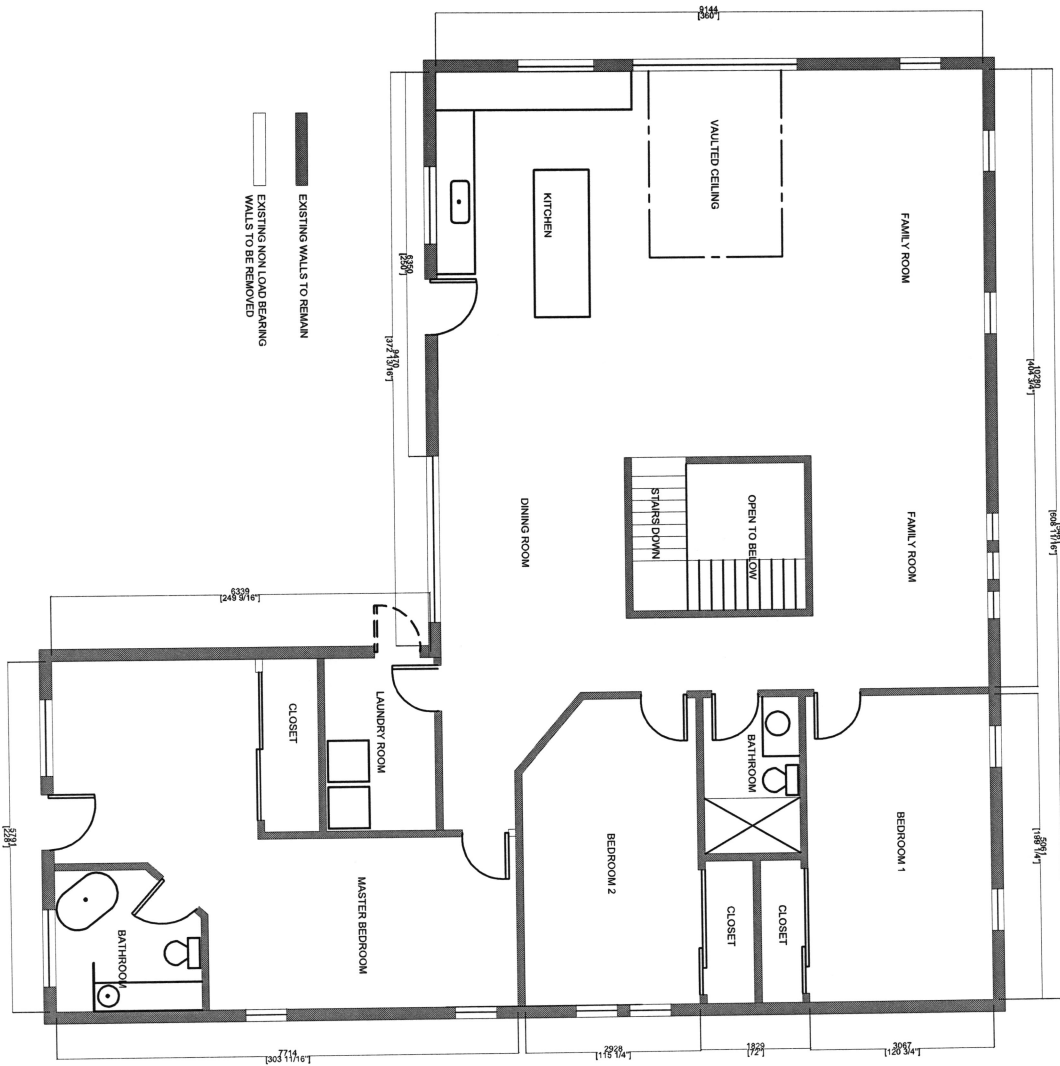

1508 GROOMS LN
WOODSTOCK, MD 21163

REVISION HISTORY

REV. 2