

Menu Save Reset Cancel Help

Record Detail * (This section is required.)

Permit Type Building/Residential/Misc/Deck Permit Number B24003796 Opened Date 10/03/2024
Description of Work SFD/ REMOVE EXISTING AND CONSTRUCT A 12' X 7' OPEN DECK WITH STEPS TO GRADE**SUBJECT TO FIELD INSPECTION**

check spelling

Approved
g8 10/18/24

Address * (This section is required.)

Search Reset Clear Get Parcel & Owner
Street # 13376 Street Name HUNT RIDGE Street Type --Select--
Unit Type --Select-- Unit # X Coordinate -76.97925 Y Coordinate 39.26799
City ELLICOTT CITY State MD Zip Code 21042 Primary Yes

Parcel (This section is required.)

Search Reset Clear Get Address & Owner
GIS ID Parcel Parcel Area Land Value Improved Value Exemption Value Plan Area
895142 261 1.13 0 647200 0 RURAL
Legal Description P/O LOT 10D 1.13883A[]13376 HUNT RIDGE RD SW []TRIADELPHIA FARMS II

check spelling

Block Lot Census Tract Council Dist Inspection Dist Supervisor Dist Map # DAP Zone
10 D 603000 5
Plan Area State Tax Id Subdivision Name
1403292118
Section Area Tax Map
22
Grid Zoning District ADC Map
22-8 RR-DEO 4813-D8
SDP No. Final Plan No. WP File No.
Record Plat No. WS Contract No. FDP No. Primary Yes
Owner Occupied Year Built Historic District
Yes No 1985 Yes No
Historic District Registry No. Stat Area Flood Plain
3-08A Yes No
Building No

Owner (This section is required.)

Search Reset Clear
Name MORG
Address Line 1 13376 HUNT RDG
Address Line 2
Address Line 3

Mail City
ELLICOTT CITY
Mail State
MD
Mail Zip Code
21042
Phone
410-969-4444
Primary
Yes
E-mail
PERMITS@FENCEDECKCONNECT.COM
Cell Number
Fax Number

Professionals (This section is not required.)

License # *
08050045780
License Type *
MHIC Co
Primary
Yes
Business Name
FENCE & DECK CONNECTION
First Name
JAMES
Middle Name
W
Last Name
RUBUSH
Address Line 1
8057 VETERANS HIGHWAY
Address Line 2
City
MILLERSVILLE
State
MD
ZIP Code
21108
Phone 1
4109694444
Phone 2
Fax
4109694448
E-mail
permits@fencedeckconnect.com

Applicant (This section is not required.)

Search As Owner As Lic. Prof As Contact

Type *
Applicant
Relationship
Applicant
Primary
Yes
First Name
JOSH
MI
Last Name
SIMPSON
Full Name
JOSH SIMPSON
Organization Name
FENCE & DECK CONNECTION
Street Address
8057 VETERANS HIGHWAY
Address Line 2
City
MILLERSVILLE
State
MD
Zip Code
21108
Phone
410-969-4444
Cell
Fax
E-mail
permits@fencedeckconnect.com

Addtl Info

Est Construction Cost
12800
Housing Units
0
Number of Buildings *
0
Public Owned
No
Construction Type
--Select--

MISC PERMIT INFO

MISCELLANEOUS PERMIT INFORMATION

Capital Project-No Fee
☐ Yes ☒ No
Capital Project Number
SFD
Fee Exempt *
(Text) ☐ Yes ☒ No
Roadside Tree Project Permit *
☐ Yes ☒ No
Roadside Tree Project Permit #
(Text)
Existing Use
SFD
Water
Private
Sewage
Private
Expiration Date
4/2/2025


Property known as:

L. 1766 F. 619

3RD ELECTION DISTRICT

HOWARD COUNTY MD

MORGES

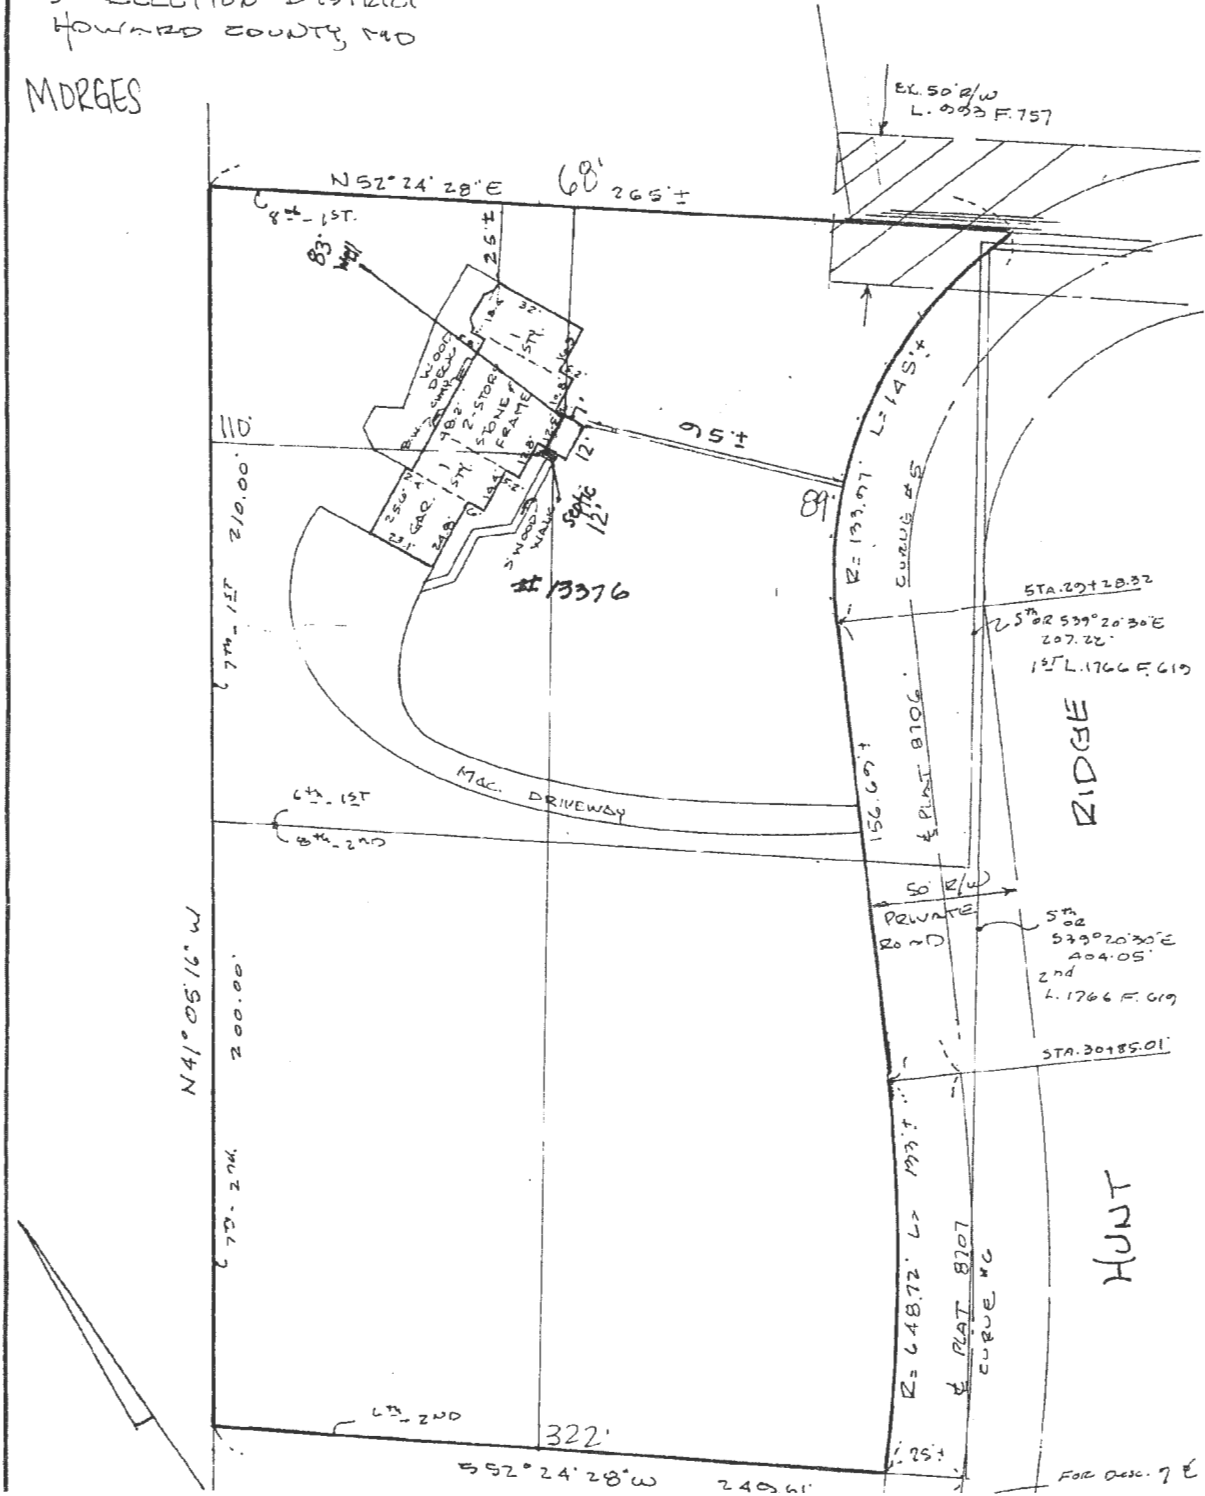

1" = 40'