

Menu Save Reset Cancel Help

Record Detail * (This section is required.)

Permit Type	Permit Number	Opened Date
Building/Residential/Misc/Porch	B19004287	12/18/2019
Description of Work		
SFD/ CONSTRUCT 12' X 12' OPEN PORCH WITH A 20' X 12' L-SHAPED OPEN DECK WITH (2) LANDINGS & (2) SETS OF STEPS		
check spelling		

Address * (This section is required.)

Search Reset Clear Get Parcel & Owner

Street #	Street Name	Street Type
11066	DORSCH FARM	RD
Unit Type	Unit #	X Coordinate
--Select--		-76.89486
		Y Coordinate
		39.24675
City	State	Zip Code
ELLCOTT CITY	MD	21042
		Primary
		Yes

Parcel * (This section is required.)

Search Reset Clear Get Address & Owner

GIS ID *	Parcel	Parcel Area	Land Value	Improved Value	Exemption Value	Plan Area
888088	21	1.14	269100	618700	349600	RURAL
Legal Description						
IMPSLOT 64 1.148 A[]11066 DORSCH FARM RD[]GAITHER HUNT S1A1 RSB 4&						
check spelling						

Block	Lot	Census Tract	Council Dist	Inspection Dist	Supervisor Dist	Map #	DAP Zone
9999	64	603000	5				
Plan Area	State Tax Id	Subdivision Name					
	1403326284						
Section	Area	Tax Map					
		29					
Grid	Zoning District	ADC Map					
29-4	RC-DEO	4934-G1					
SDP No.	Final Plan No.	WP File No.					
Record Plat No.	WS Contract No.	FDP No.					
13211							
Owner Occupied	Year Built	Historic District					
☐ Yes ☐ No	1999	☐ Yes ☒ No					
Historic District Registry No.	Stat Area	Flood Plain					
	3-09A	☐ Yes ☒ No					
Building No							

Owner * (This section is required.)

Search Reset Clear

Name *		
RADCLIFFE SCOTT T		
Address Line 1		
11066 DORSCH FARM RD		
Address Line 2		
Address Line 3		
Mail City	Mail State	Mail Zip Code
ELLCOTT CITY	MD	21042
Phone	Primary	
410-964-6559	Yes	
E-mail		
Cell Number	Fax Number	

Approved 3/26/2020
RAE

Professionals (This section is not required.)

Search Reset Clear

License # *	Business Name		
08010091395	CUSTOM WORKS INC		
License Type *	First Name	Middle Name	Last Name
MHIC Ind ☒	GLEN		WILSON
Primary	Address Line 1		
Yes ☒	3355 AISQUITH FARM ROAD		
	Address Line 2		
	City	State	ZIP Code
	DAVIDSONVILLE	MD	21035-0000
	Phone 1	Phone 2	Fax
	4109631119		4109562817
	E-mail		
	GWILSON@CWINCMD.COM		

Applicant (This section is not required.)

Search As Owner As Lic. Prof As Contact

Type *	First Name	MI	Last Name
Applicant ☒	NICHOLAS		WILSON
Relationship	Full Name		
Applicant ☒	NICHOLAS WILSON		
Primary	Organization Name		
Yes ☒	CUSTOM WORKS INC		
	Street Address		
	PO BOX 175		
	Address Line 2		
	City	State	Zip Code
	RIVA	MD	21140
	Phone	Cell	Fax
	443-926-2619		
	E-mail *		
	nwilson@cwincmd.com		

Addtl Info

Est Construction Cost *	Housing Units *	Number of Buildings *	Public Owned
21000	0	0	No ☒
Construction Type			
434 - Additions, Alterations and Conversions - Residential ☒			

PORCH INFORMATION


PORCH INFORMATION				
Capital Project-No Fee *	Capital Project Number	Fee Exempt *	Roadside Tree Project Permit *	Roadside Tree Project Permit #
☐ Yes ☒ No		☐ Yes ☒ No	☐ Yes ☒ No	
Existing Use *	Type of Porch *	Type of Porch Foundation *	Total Square Footage *	
SFD ☒	Open Porch ☒	New Deck ☒	144 SQFT	
Water Supply	Sewage Disposal	Expiration Date		
Private ☒	Private ☒	6/16/2020		

PAYMENT INFORMATION

Check 1	Payee 1	Check 2	Payee 2	SAP Doc No	SAP Entered

Submit Cancel

Dorsch Farm Road

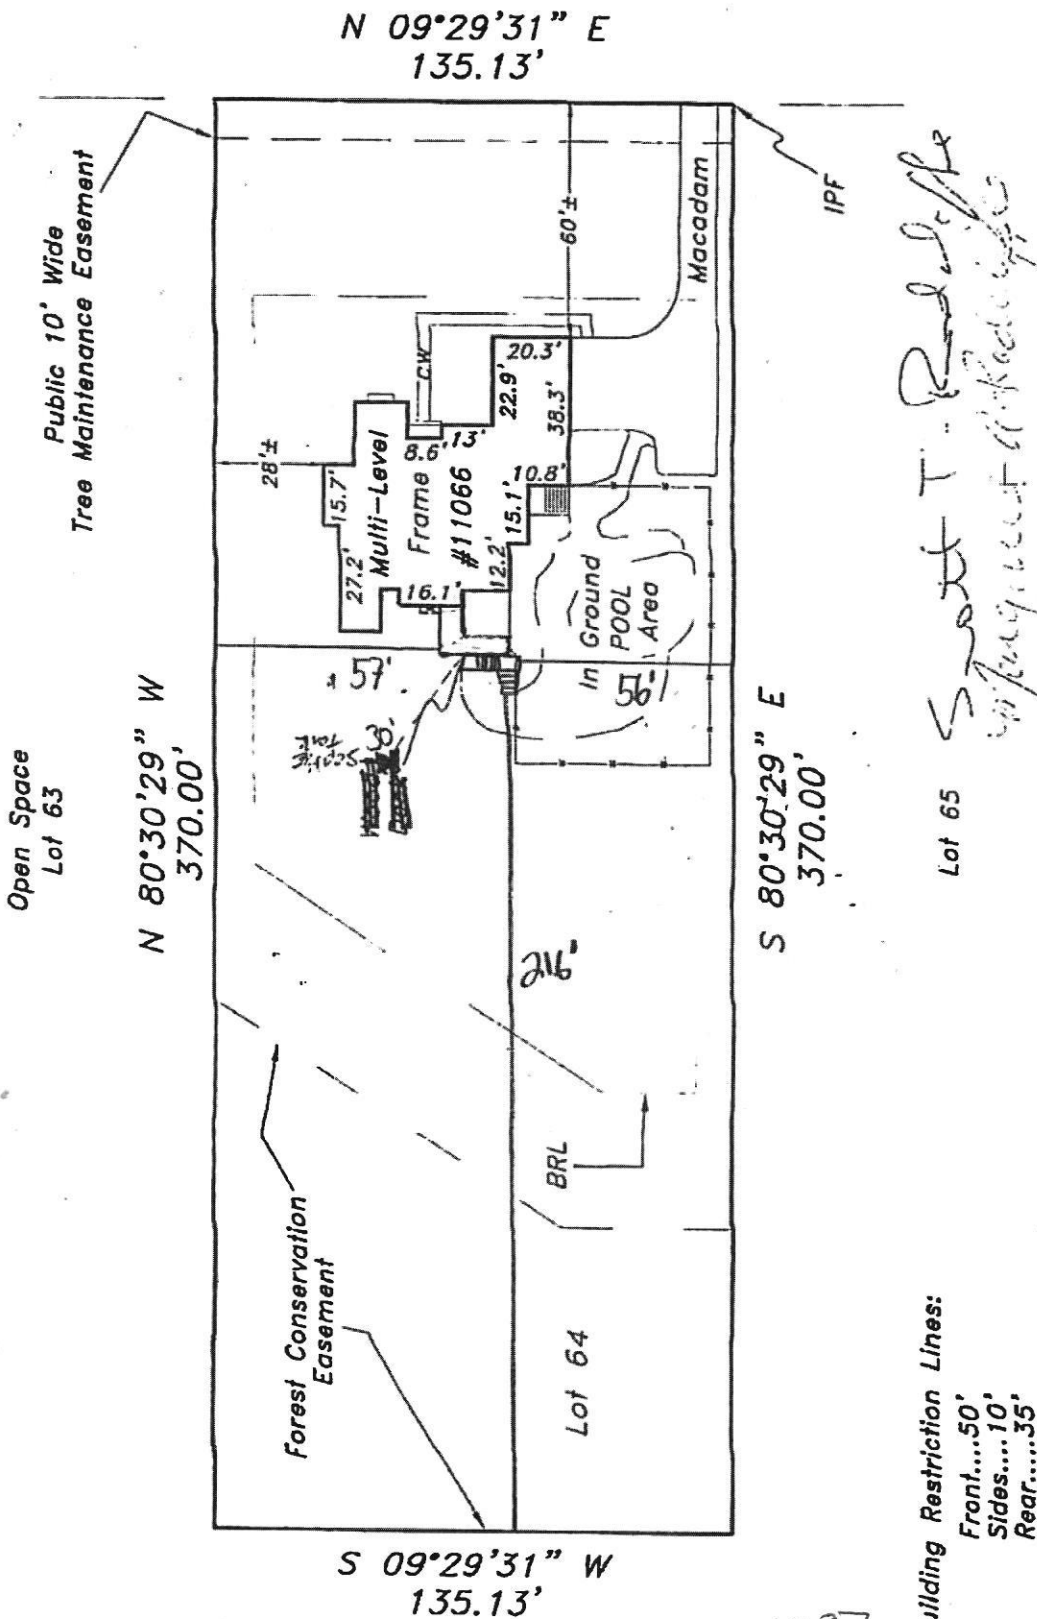

Approved 1319004287
 3/26/2020

Building Restriction Lines:
 Front....50'
 Sides....10'
 Rear.....35'

The purpose of this drawing is to locate, describe, and represent the positions of buildings and substantial improvements affecting the property shown hereon, being known as:

Lot 64, Section 1, Area 1,
 GAITHER HUNT
 recorded among the land records of Howard County, Maryland in
 Plat 13211

PREPARED FOR:

Lakeside
 LAKESIDE SURVEYING

This is page one of a two page document. The advice found on the affixed page is an integral part of this drawing, and is not valid without all pages.




LOCATION DRAWING
 11066 Dorsch Farm Road
 3rd ELECTION DISTRICT
 HOWARD COUNTY, MARYLAND

NTT Associates, Inc.
 16205 Old Frederick Rd.
 Mt. Airy, Maryland 21771
 Phone: (410) 442-2031
 Fax: (410) 442-1315
 www.nttsurveyors.com

Scale: 1"= 50'
 Date: 9-15-16
 Field By: DR
 Drawn By: DR
 File No.: LMD27896
 Page No.: 1 of 2



Compton

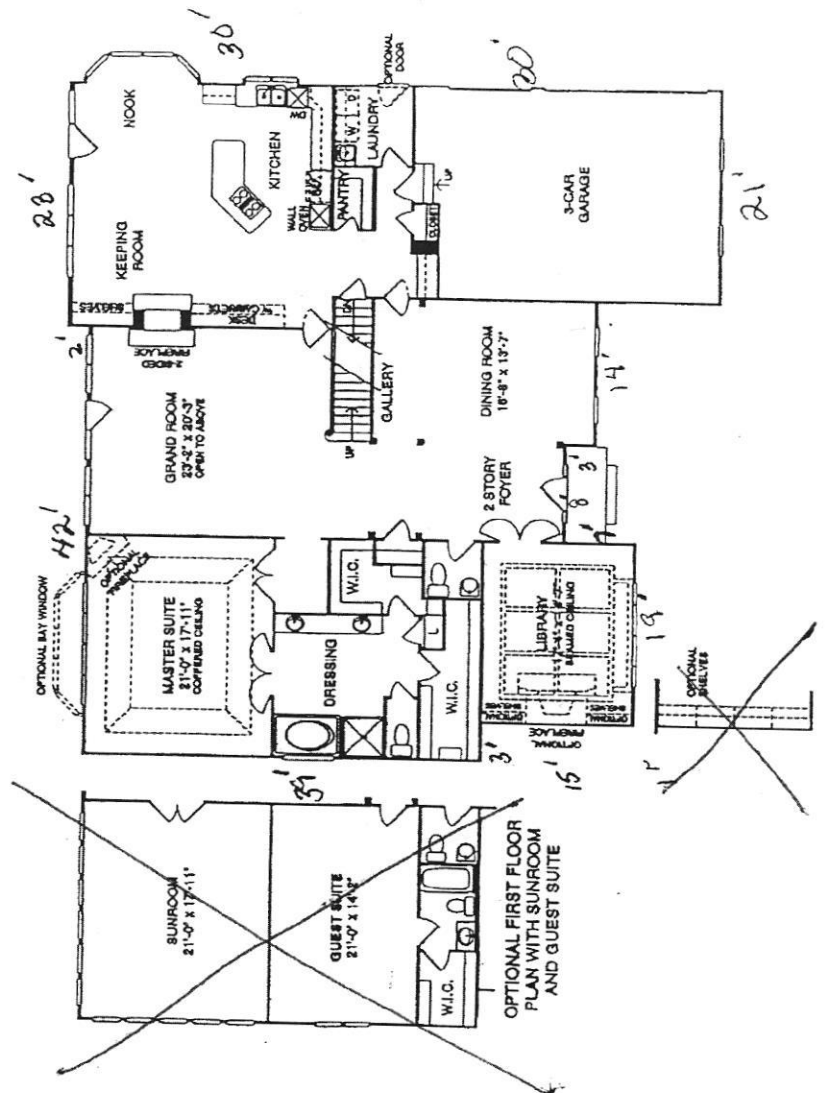

443 926 2619

Nick Wilson

Edward Dent

B19004287

11066 Dorsch From Rd