

**COMPLETE THIS FORM WHEN DROPPING OFF ANY
CORRESPONDENCE AND/OR PLANS TO THE HOWARD COUNTY
DEPARTMENT OF INSPECTIONS, LICENSES AND PERMITS COUNTER:**

Date: 12/12/18

To: SPENCER (ROBERT) FREEMAN / HEALTH
(Person's Name and Division)

From: STEPHANIE TUITE, FCC (410) 461-2855
(Your Name, Company Name and Telephone Number)

Subject: Project name HILL PROPERTY, LOT 1
Project site address 12415 HILL CREST
Permit # B18003380 SDP # N/A
Other information pertinent to this project _____

✓ Please check the attachments below that you are submitting with this transmittal:

- ____ Letter of response to address plan review comment letter
- ____ Revised plans and/or revised details: When submitting for a complete re-review, **duplicate sets shall be submitted.**
- ____ Letter Summarizing Changes
- ____ Energy conservation calculations
- ☒ Copies of PERMIT PLAN (be specific). SEE ATTACHED
EMAIL FOR
EXPLANATION
- ____ ☒ Health Department Request _____ DPZ/ DED Request _____ Applicant's Request _____
- ____ Two sets of single family dwelling model plans to be placed on permanent file: Model name and/or # _____
- ____ Other _____

Contact Person Information: (Required)

Please Print Name

Telephone No:

E-Mail Address:

PLEASE ASSURE ALL DOCUMENTS AND/OR REVISIONS ARE APPROPRIATELY SIGNED AND SEALED, IF NECESSARY, BY A LICENSED ARCHITECT OR ENGINEER. PLEASE BE ADVISED THAT INSUFFICIENT INFORMATION MAY RESULT IN THE DELAY OF REVIEW BY THE PLANS EXAMINER. THE DEPARTMENT OF INSPECTIONS, LICENSES AND PERMITS WILL CONTACT YOU IF THERE IS A PROBLEM. IN ADDITION, ONCE THE BUILDING PERMIT IS APPROVED BY THE PLAN REVIEW DIVISION AND ALL OTHER REQUIRED SIGNATORY AGENCIES, AND THE BUILDING PERMIT IS READY FOR ISSUANCE, THE PERMIT DIVISION WILL NOTIFY THE APPROPRIATE CONTACT PERSON FOR PERMIT PICK UP. ALL PERMIT STATUS INQUIRIES SHALL BE DIRECTED TO THE PERMIT DIVISION AT 410-313-2455. CODE RELATED QUESTIONS AND PLAN REVIEW INQUIRIES SHALL BE DIRECTED TO THE PLAN REVIEW DIVISION AT 410-313-2436. PLEASE ALLOW A MINIMUM OF FIVE (5) WORKING DAYS FOR ANY PLAN SUBMITTALS TO BE REVIEWED. THANK YOU.

Received by [Signature]

Hill, Amanda

From: Stephanie Tuite <Stephanie@fcc-eng.com>
Sent: Thursday, December 13, 2018 10:23 AM
To: Hill, Amanda
Subject: RE: B18003380

[Note: This email originated from outside of the organization. Please only click on links or attachments if you know the sender.]

Sorry, forgot to add that. We modified grading in the area of the well box in order to remove the culvert pipe under the circular driveway.

Steph

Stephanie Tuite, RLA, PE, LEED AP BD&C
FISHER, COLLINS & CARTER, INC.

From: Hill, Amanda <ahill@howardcountymd.gov>
Sent: Thursday, December 13, 2018 9:56 AM
To: Stephanie Tuite <Stephanie@fcc-eng.com>
Cc: Anest, Cathy <canest@howardcountymd.gov>
Subject: RE: B18003380

Good Morning Stephanie,

I apologize, we have quite a stack of revisions and amendments to process and this is the first chance I have had to process them.

I have the transmittal and revised plot plan in hand, but unfortunately it is not noted on the transmittal or plot plan as to what is being revised. The Health Department does not have any comments in Accela either, so I do need to confirm what the revision is for before processing it.

Please let us know what is being revised on the plot plan and I will go ahead and process the revision.

Thank you,

Amanda Hill

Regulation Support Technician II
Department of Inspections, Licenses and Permits
3430 Court House Drive
Ellicott City, MD 21043
ahill@howardcountymd.gov
410.313.2455
410.313.3322 (fax)

To check the status of a permit, please visit myhoward.info and search by address or permit number

From: Stephanie Tuite <Stephanie@fcc-eng.com>
Sent: Thursday, December 13, 2018 9:04:46 AM
To: Anest, Cathy
Subject: B18003380

[Note: This email originated from outside of the organization. Please only click on links or attachments if you know the sender.]

Cathy,


We dropped off a revised Permit Plan for B18003380 (12415 Hill Crest) yesterday. Health is waiting to see this uploaded so they can sign off on the permit. Can you or someone else please upload to accella as soon as you can? I would appreciate it. thanks.

Steph



REVISED
Date: 12/12/18
Comments: B18003380

MODIFIED GRADING
AREA OF WELL BOX

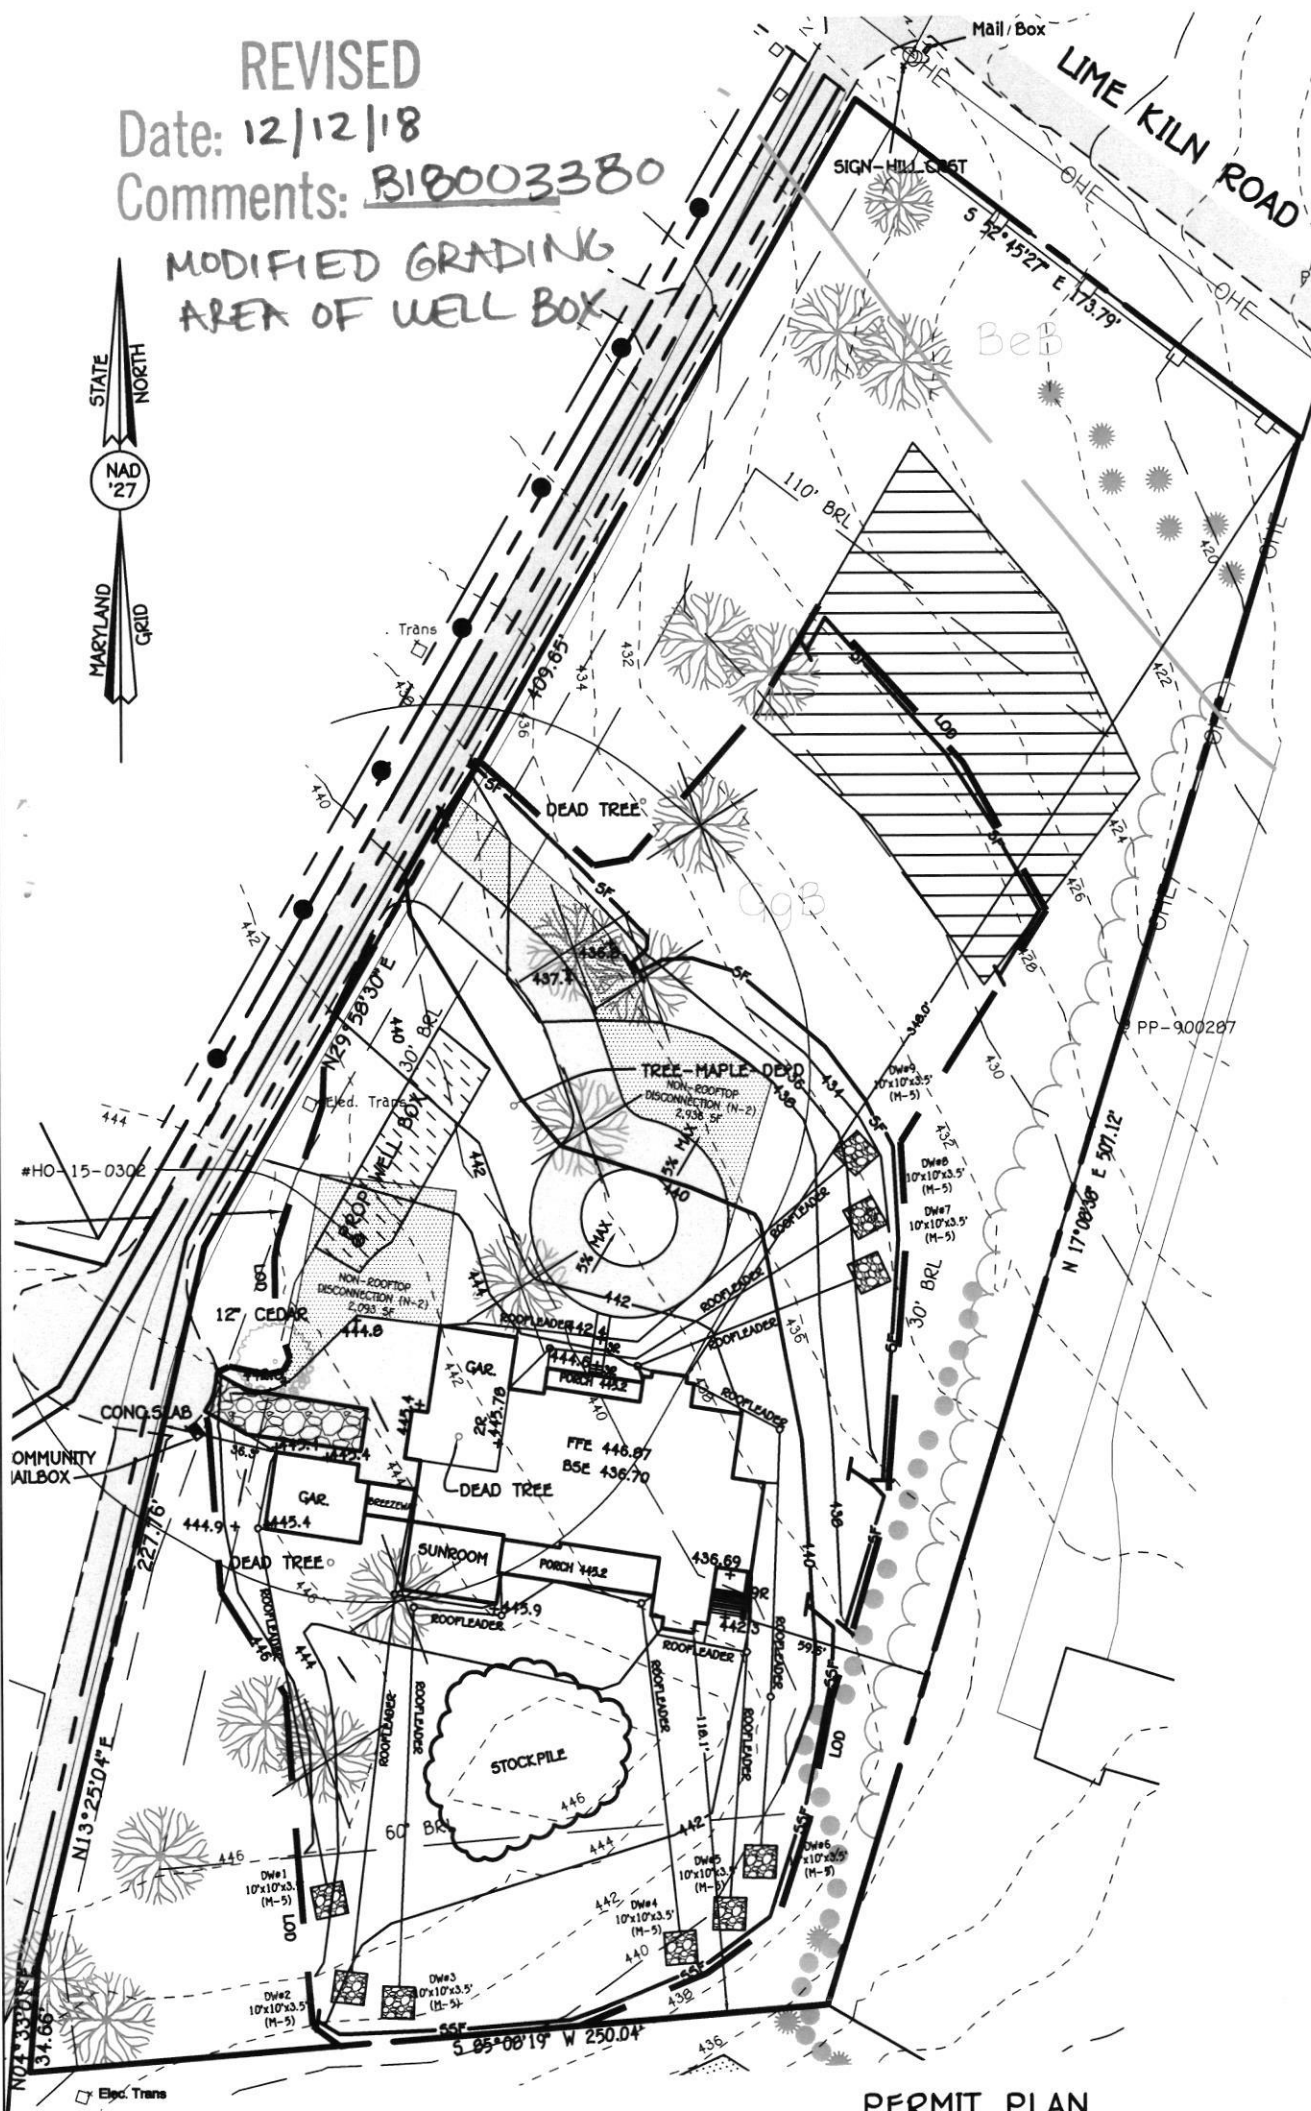

PERMIT PLAN
HILL PROPERTY, LOT 1
12415 HILL CREST

FISHER, COLLINS & CARTER, INC.
CIVIL ENGINEERING CONSULTANTS & LAND SURVEYORS
CENTENNIAL SQUARE OFFICE PARK - 10272 BALTIMORE NATIONAL PIKE
ELLICOTT CITY, MARYLAND 21042
(410) 461 - 2055

ZONING: RR-DEO
TAX MAP No. 45 BLOCK No. 5 PARCEL No. 59
FIFTH ELECTION DISTRICT HOWARD COUNTY, MARYLAND
SCALE: 1"=50' DATE: DECEMBER 2018


REVISED

Date: 12/12/18

Comments: B18003380

MODIFIED GRADING
AREA OF WELL
BOX

BOX

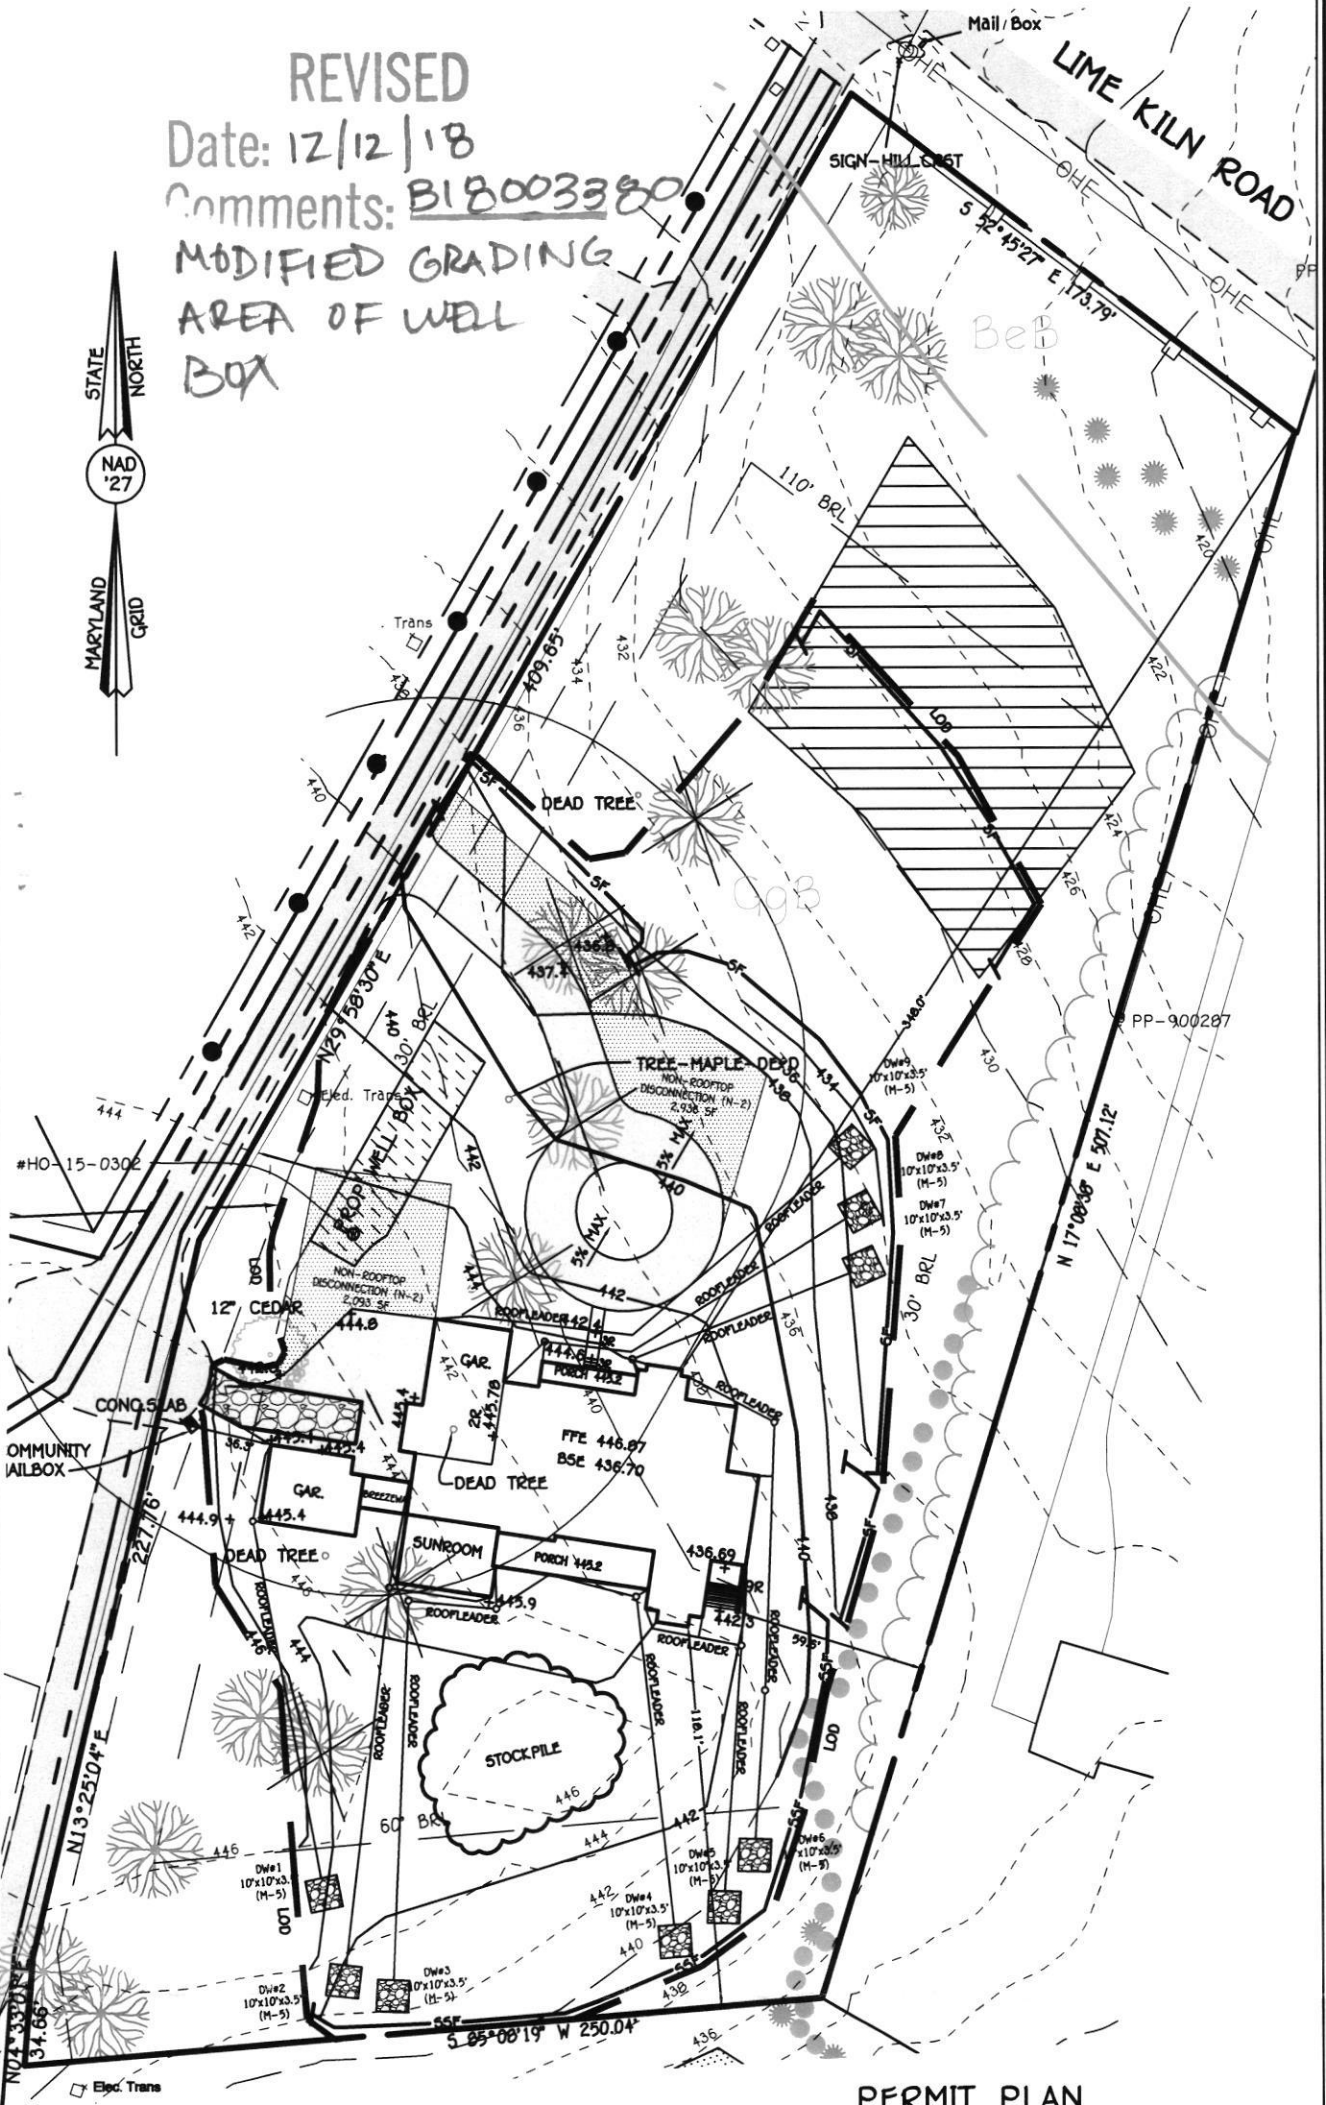

PERMIT PLAN
HILL PROPERTY, LOT 1
12415 HILL CREST

FISHER, COLLINS & CARTER, INC.
CIVIL ENGINEERING CONSULTANTS & LAND SURVEYORS
CENTENNIAL SQUARE OFFICE PARK - 10272 BALTIMORE NATIONAL PIKE
ELLICOTT CITY, MARYLAND 21042
(410) 461 - 2055


ZONING: RR-DEO
TAX MAP No. 45 BLOCK No. 5 PARCEL No. 59
FIFTH ELECTION DISTRICT HOWARD COUNTY, MARYLAND
SCALE: 1"=50' DATE: DECEMBER 2018

REVISED

Date: 12/12/18

Comments: B18003380

MODIFIED GRADING
AREA OF WELL
BOX

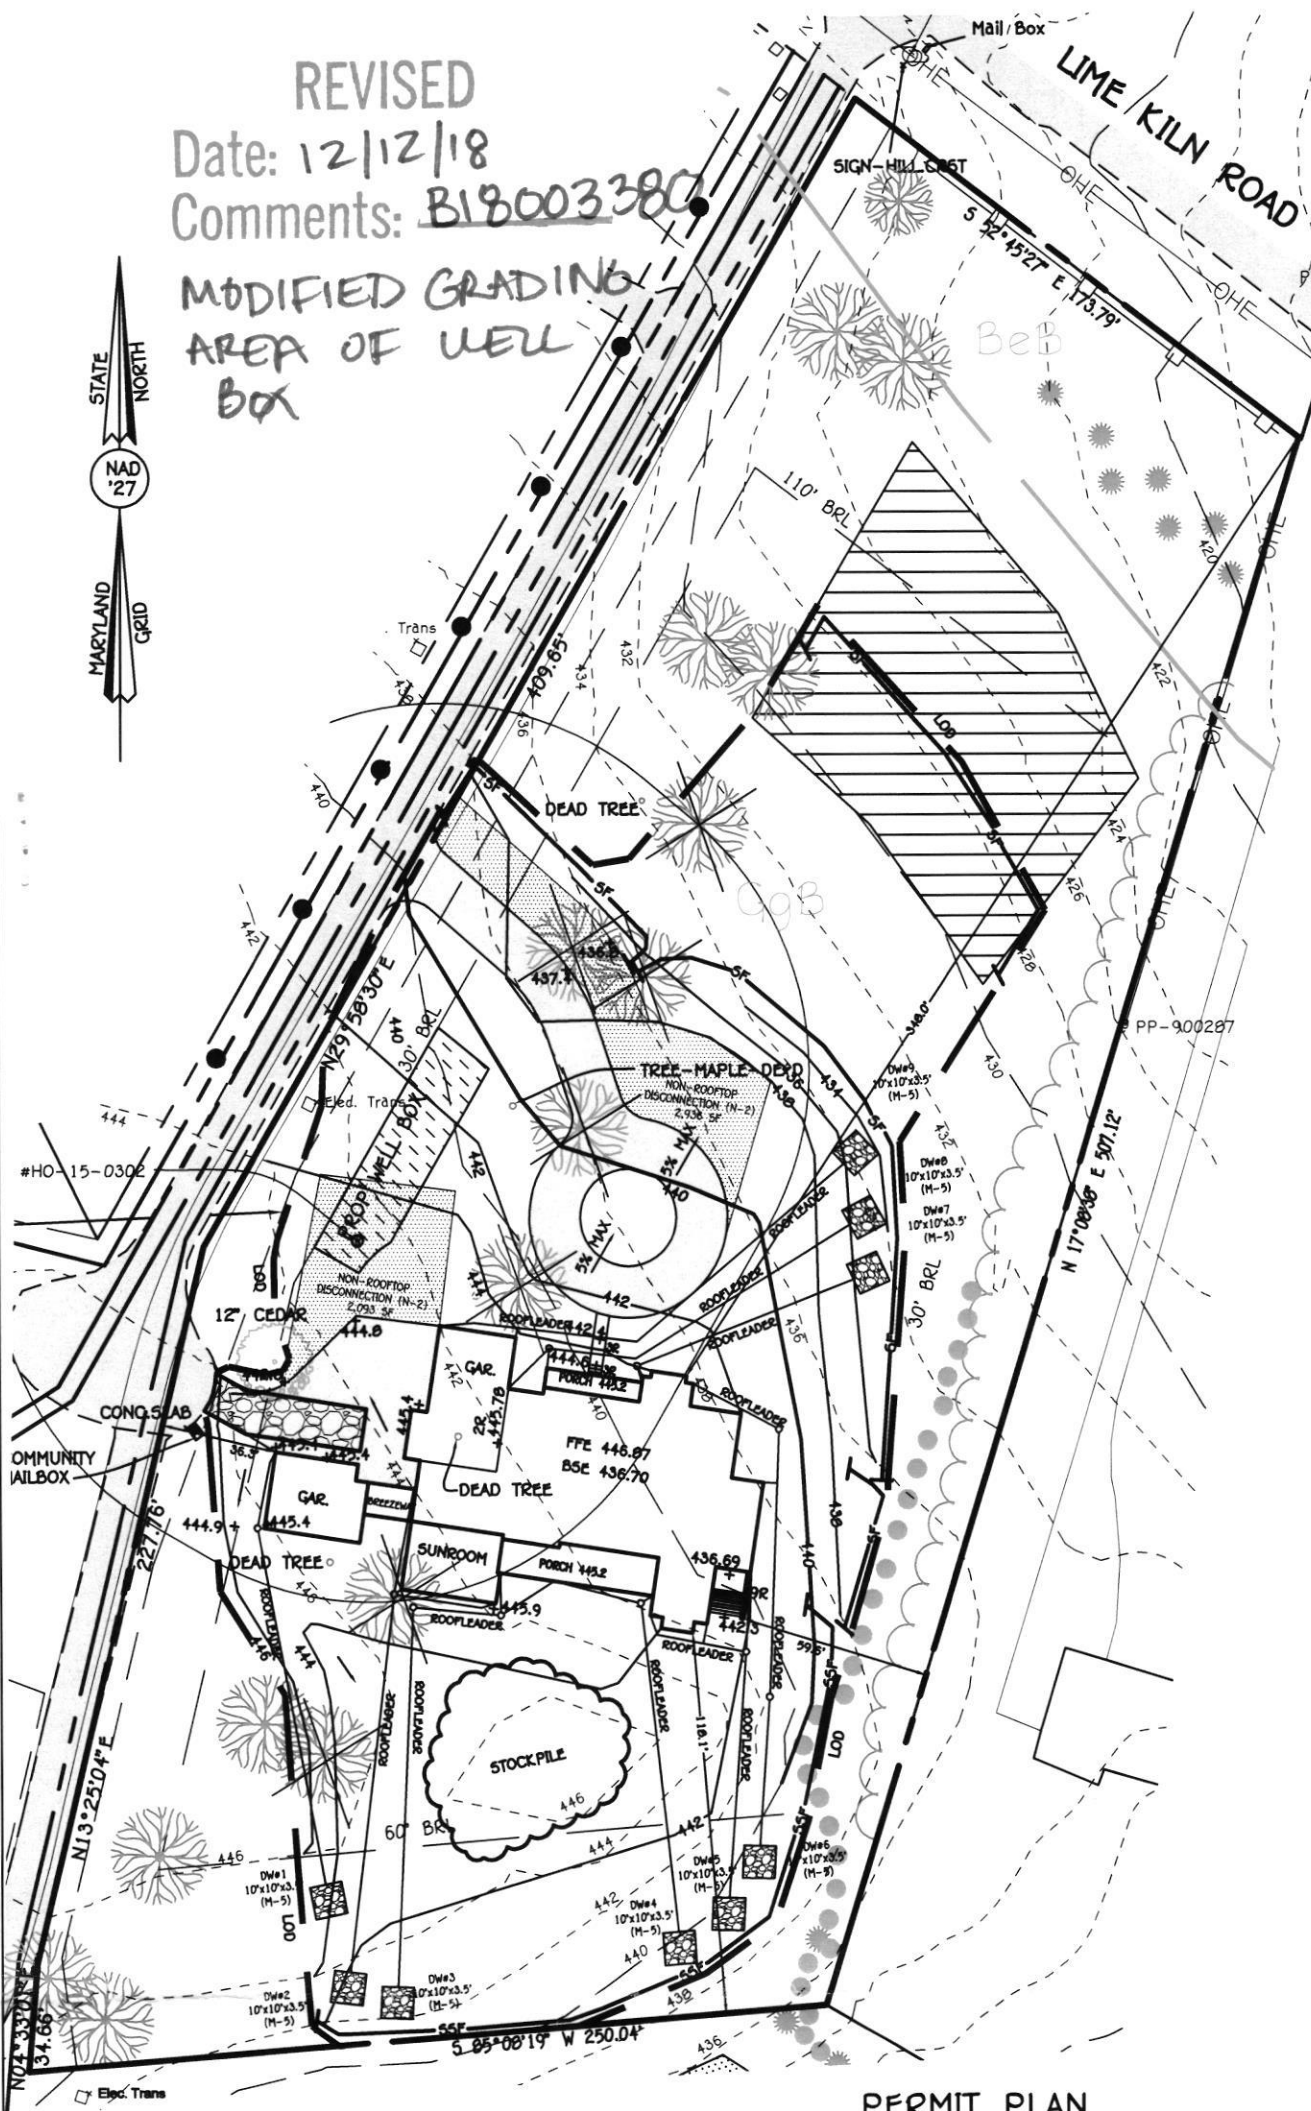

PERMIT PLAN
HILL PROPERTY, LOT 1
12415 HILL CREST

FISHER, COLLINS & CARTER, INC.
CIVIL ENGINEERING CONSULTANTS & LAND SURVEYORS
CENTENNIAL SQUARE OFFICE PARK - 10272 BALTIMORE NATIONAL PIKE
ELLICOTT CITY, MARYLAND 21042
(410) 461 - 2055

ZONING: RR-DEO
TAX MAP No. 45 BLOCK No. 5 PARCEL No. 59
FIFTH ELECTION DISTRICT HOWARD COUNTY, MARYLAND
SCALE: 1"=50' DATE: DECEMBER 2018