

Menu Save Reset Cancel Help

Record Detail * (This section is required.)

Permit Type	Permit Number	Opened Date
Building/Residential/Misc/Shed	B25004627	10/16/2025
Description of Work		
SFD/ INSTALL 12' X 24' PREFAB SHED		

Online BP.
gl 10/22/25

Approved
RMC
10/30/25

[check spelling](#)

Address * (This section is required.)

Search Reset Clear Get Parcel & Owner

Street #	Street Name	Street Type	
7109	DEER VALLEY	RD	
Unit Type	Unit #	X Coordinate	Y Coordinate
--Select--		-76.9747	39.17619
City	State	Zip Code	Primary
HIGHLAND	MD	20777	Yes

Parcel * (This section is required.)

Search Reset Clear Get Address & Owner

GIS ID *	Parcel	Parcel Area	Land Value	Improved Value	Exemption Value	Plan Area
914404	235	3.43	299400	759900	460500	RURAL
Legal Description						
IMPSLOT 40 3.437 A[]7109 DEER VALLEY RD[]CISSEL FARM S3 RSB L 32						

[check spelling](#)

Block	Lot	Census Tract	Council Dist	Inspection Dist	Supervisor Dist	Map #	DAP Zone
	40	605101	5				
Plan Area	State Tax Id		Subdivision Name				
	1405407672		CISSELL FARM S3 RSB L 32				
Section	Area		Tax Map				
			40				
Grid	Zoning District		ADC Map				
40-3	RR-DEO		5051-E2				
SDP No.	Final Plan No.		WP File No.				
Record Plat No.	WS Contract No.		FDP No.		Primary		
7687					Yes		
Owner Occupied	Year Built		Historic District				
☒ Yes ☐ No	1989		☐ Yes ☒ No				
Historic District Registry No.	Stat Area		Flood Plain				
	5-04A		☐ Yes ☒ No				
Building No							

Owner * (This section is required.)

Search Reset Clear

Name *

SEAST

Address Line 1

7109 DEER VALLEY RD

Address Line 2

Address Line 3

Mail City
HIGHLAND
Mail State
MD
Mail Zip Code
20777
Phone
301-537-2725
Primary
Yes
E-mail
derrick.seastrom@gmail.com
Cell Number
Fax Number

Professionals (This section is not required.)

License # *
0
License Type *
Property Owner
Primary
Yes
Business Name
PROPERTY OWNER TO ACT AS CONTRACTOR
First Name
DERRICK
Middle Name
Last Name
SEASTROM
Address Line 1
7109 DEER VALLEY RD
Address Line 2
City
HIGHLAND
State
MD
ZIP Code
20777
Phone 1
301-537-2725
Phone 2
Fax
E-mail
derrick.seastrom@gmail.com

Applicant (This section is not required.)

Search As Owner As Lic. Prof As Contact

Type *
Applicant
Relationship
Applicant
Primary
Yes
First Name
Derrick
MI
Last Name
Seastrom
Full Name
Derrick Seastrom
Organization Name
Street Address
7109 Deer Valley Rd
Address Line 2
City
Highland
State
MD
Zip Code
20777
Phone
301-537-2725
Cell
Fax
E-mail *
derrick.seastrom@gmail.com

Addtl Info

Est Construction Cost *
6000
Housing Units *
0
Number of Buildings *
0
Public Owned
No
Construction Type
434 - Additions, Alterations and Conversions - Residential

MISC PERMIT INFO

MISCELLANEOUS PERMIT INFORMATION


Capital Project-No Fee * Capital Project Number Fee Exempt * Roadside Tree Project Permit * Roadside Tree Project Permit #
☐ Yes ☒ No (Text) ☐ Yes ☒ No ☐ Yes ☒ No (Text)
Existing Use * Water Sewage Expiration Date
Other - See Description of Work Private Private 4/19/2026



Submit

Cancel

25.50 ACRES, 100
 271 1/2" RADIUS CIRCLE VILLAGE CENTER
 KERRIS PARK ROAD
 100' 0" 210' 0"

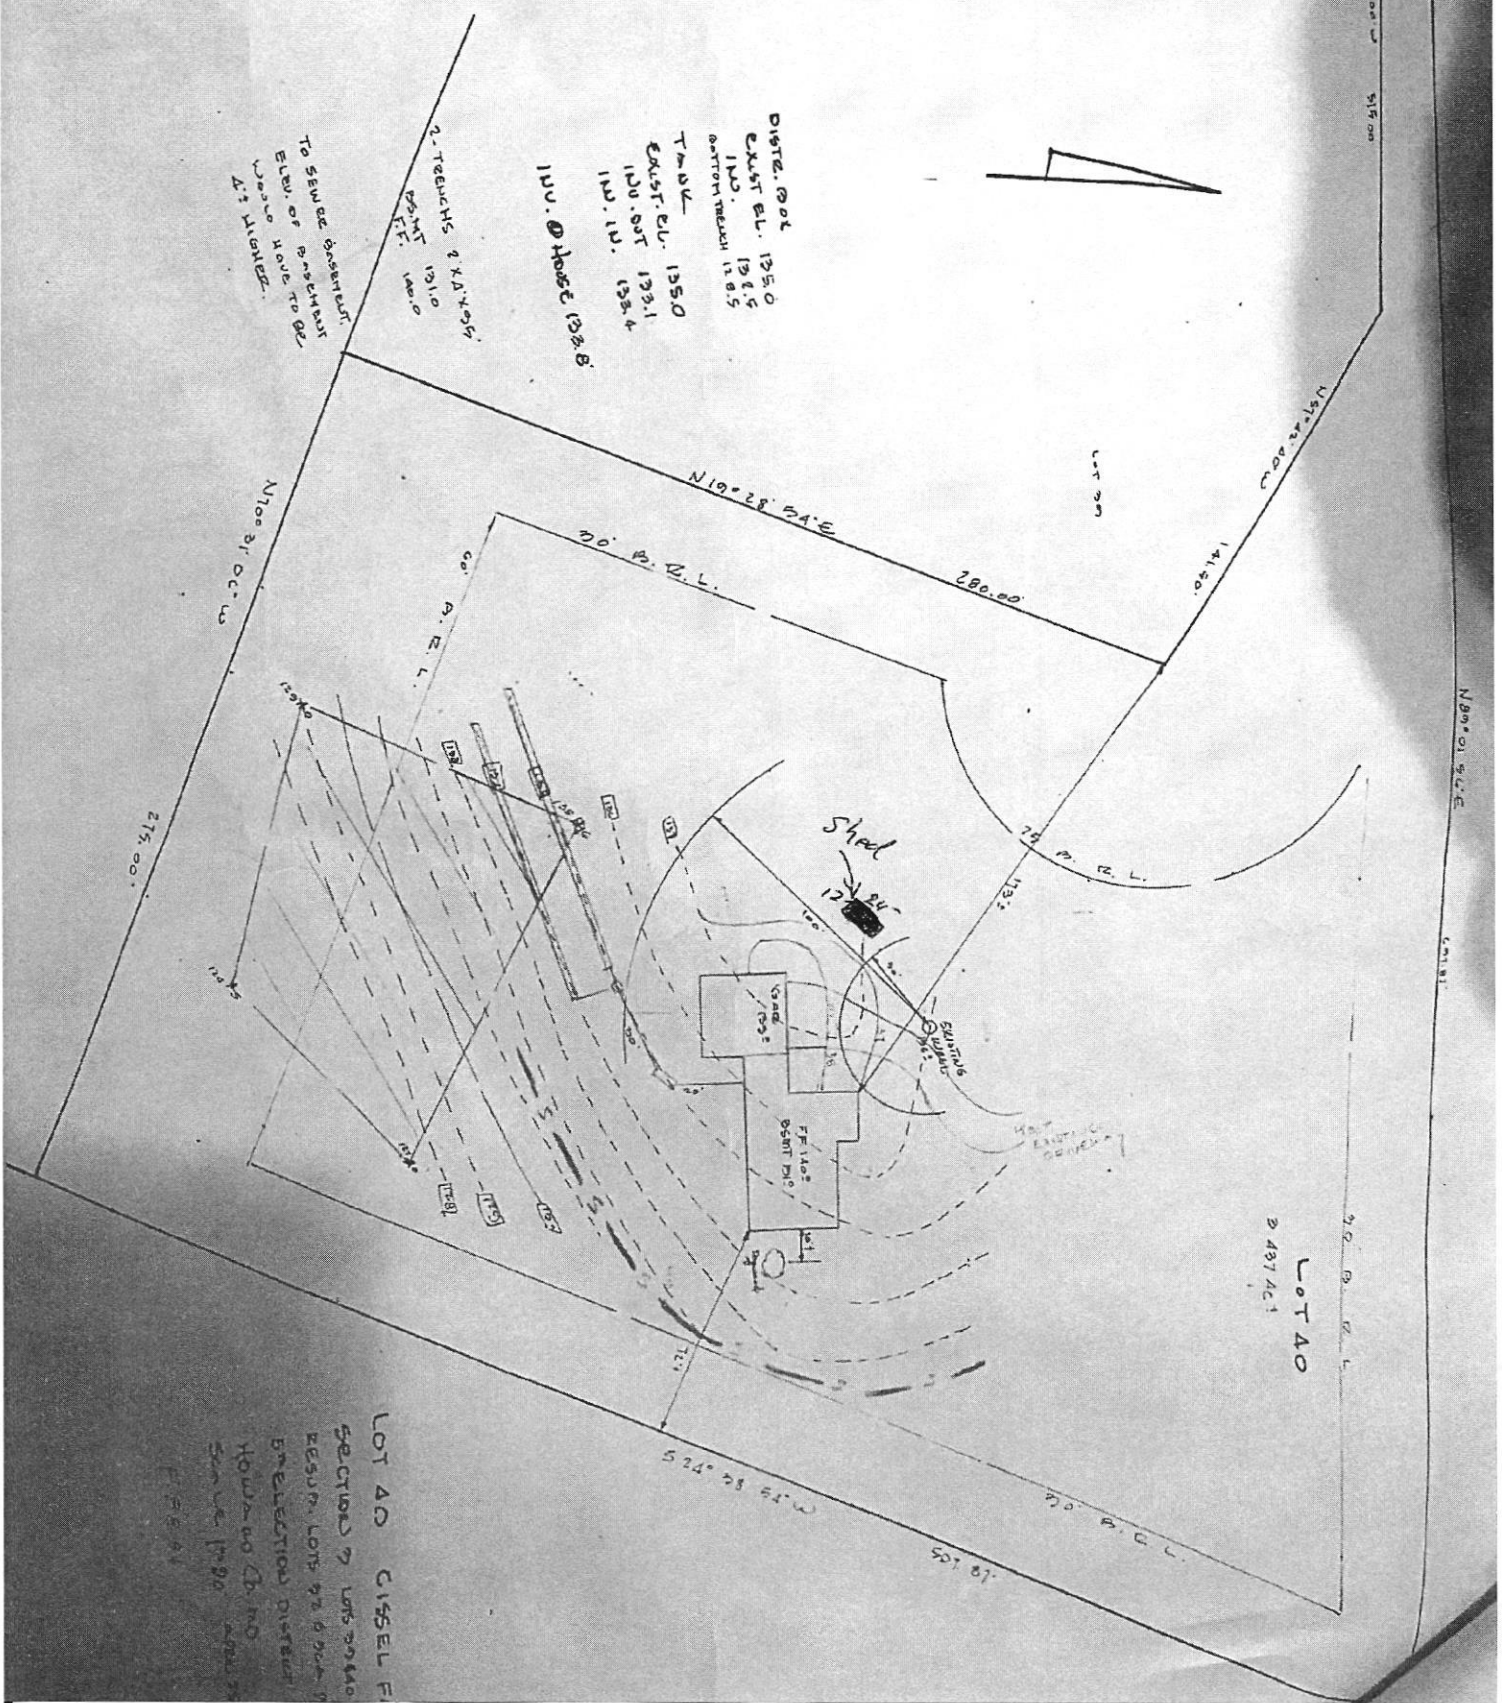

TO SEWER CONNECTION
 ELEV. OF PAVEMENT
 WOULD HAVE TO BE
 12' HIGHER.

2 TRENCHES 2' X 4' X 5' 4"
 POINT 131.0
 FT. 100.0

110.0 110.0 133.8

LOT 40
 40.00 AC.

LOT 40 CISEL F
 SECTION 7 TOWNSHIP 140
 RESUR. LOTS 72.5 73.4 74.0
 ELECTION DISTRICT
 HOWARD CH. NO
 S.W. 1/4 1780 1780 1780