

3/3/93 BPH

3/8/93 non 30 CAT6

3/9/93 non 4 CAT6

PERMIT

SEWAGE DISPOSAL SYSTEM

DEPARTMENT OF HEALTH AND MENTAL HYGIENE

03-315347

P 48760

A 38154

DISTRICT 3rd

DATE 12/5/92

DATE SYSTEM APPROVED 3/9/93

INSPECTOR M. R. F. K. N.

HOWARD COUNTY HEALTH DEPARTMENT

BUREAU OF ENVIRONMENTAL HEALTH

~~XXXX-9933~~

313-2640

INDEXED

Paul Schissler/South Carroll Backhoe, Inc. IS PERMITTED TO INSTALL X ALTER

ADDRESS 4410 Salem Bottom Road, Westminster, Maryland 21157 PHONE 875-4197

SUBDIVISION Meadowood, Sec. 2 LOT 4444 ROAD 1219 Wild Rose Court

PROPERTY OWNER Brian and Theresa Hamill

ADDRESS

SEPTIC TANK CAPACITY 1500 GALLONS

NUMBER OF BEDROOMS 5

180 SQUARE FEET PER BEDROOM

LINEAR FEET OF TRENCH REQUIRED 300'

TRENCHES - Trench to be 3 feet wide. Inlet 2.5 feet below original grade. Bottom maximum depth 4.5 feet below original grade. Effective area begins at 2.5 feet below original grade. 2 feet of stone below distribution pipe.

LOCATION - Start the first trench 185 feet from the right (362+/-) lot line and 40 feet off the front (287+/-) lot line as seen when facing the lot from flag stems off Wild Rose Court. Run trenches on contour toward the right line.

NOTES - No trench to exceed 100 feet in length. Provide 6" - 8" diameter cleanout and cap to grade or above on septic tank. 01/12/2192 R11

PLANS APPROVED BY Sid Abel DATE 7/17/89

COVER NO WORK UNTIL INSPECTED AND APPROVED

NEITHER THE HOWARD COUNTY COUNCIL NOR THE HEALTH DEPARTMENT IS RESPONSIBLE FOR THE SUCCESSFUL OPERATION OF ANY SYSTEM

NOTE: CLEANOUT REQUIRED EVERY 70 FEET OF SEWER LINE AND/OR AT 90° SWEEPS IN LINES FROM HOUSE TO DRAIN FIELDS, 90° ELBOWS NOT ACCEPTABLE.

NOTE: ALL PARTS OF SEPTIC SYSTEMS (I.E. TANK, DISTRIBUTION BOX TRENCHES) TO BE 100 FEET FROM WELL (UNLESS OTHERWISE SPECIFICALLY AUTHORIZED)

NOTE: IF DEEP TRENCH(ES) ARE USED CALL FOR INSPECTION BEFORE AND AFTER PLACING GRAVEL IN TRENCH(ES)

NOTE: NO DRY WELL SHALL EXCEED 15 FOOT IN DIAMETER NO ABSORPTION TRENCH TO EXCEED 100 FEET IN LENGTH

NOTE: ALL PIPE FROM HOUSE TO SEPTIC TANK MUST BE CAST IRON OR SCHEDULE 35/40 PVC OR ABS


PERMIT VOID AFTER TWO YEARS

NOTE: INSTALL STAND PIPE ON SEPTIC TANK AND DRY WELL STAND PIPES MUST BE 6 INCHES IN DIAMETER CAST IRON. CONCRETE OR TERRA COTTA OR PVA OR ABS ACCEPTED. IF TOP OF SEPTIC TANK IS DEEPER THAN 3 FEET. MANHOLE TO GRADE REQUIRED.

NOTE: DISTRIBUTION BOXES MUST HAVE BAFFLES

***INSTALLER IS RESPONSIBLE FOR OBTAINING FINAL APPROVAL ON THIS PERMIT**

A
38154

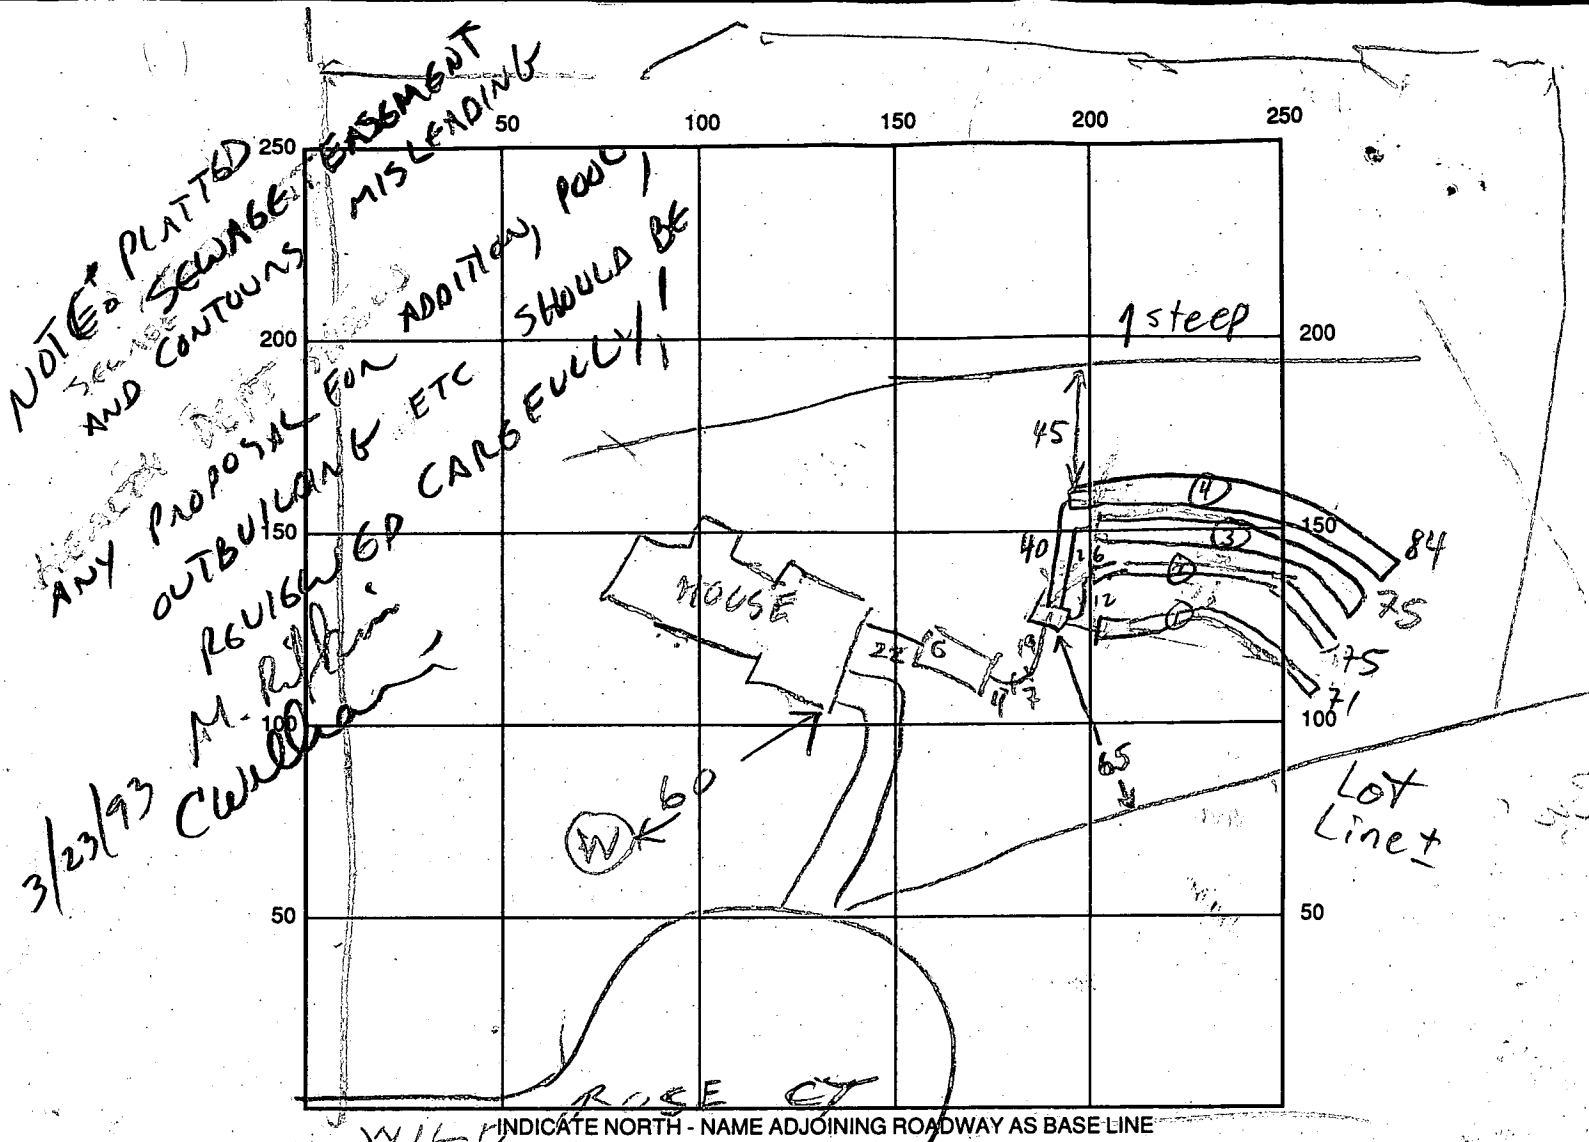

SEPTIC TANK LEVEL 1500 GAL - OK

CLEANOUTS OK

DISTRIBUTION BOX LEVEL OK - BAFFLE IN

DRAIN FIELD/TITLE DEPTH 1 1/2 3 1/4 5 1/2 4 5 FT.

TRENCH WIDTH 3 FT.

INLET DEPTH 1 1/2 3 1/4 3 1/2 5 2 FT.

EFFECTIVE GRAVEL DEPTH 2 1/2 2 1/2 2 FT.

TOTAL LENGTH 7 1/2 7 5 7 5 FT.

NUMBER OF TRENCHES 4

ONE SIDEWALL/BOTTOM AREA 1 2 1/3 2 2/5 2 5/2 SQ. FT.

DRYWALL INSIDE DIAMETER FT.

EFFECTIVE DEPTH BELOW INLET FT.

ABSORBENT AREA 915 SQ. FT.

REMARKS: 3/3/93 - 345 PM - OK TO COVER TANK RH

3/8/93 - 7 PM - TRENCH #1 OK TRENCH #2 STARTED +

3/8/93 4 PM - TRENCH #2 OK RH

3/9/93 #1 OK TO CONTINUE MR 3/9/93 #2 OK TO COVER

TOPO ON PLAN NOT ACCURATE, CAUSING LOC. ADJUSTMENT MR

DATE SYSTEM APPROVED

3/9/93

INSPECTOR

M. Rippin

APPLICATION

PERCOLATION TESTING

A 38/54

P _____

HOWARD COUNTY HEALTH DEPARTMENT
BUREAU OF ENVIRONMENTAL HEALTH
P.O. BOX 476 ELLICOTT CITY, MARYLAND 21043
TELEPHONE: 461-9933

*11/7/84
perc OK'd per
approved plat*

DISTRICT _____

DATE 11/28/84

TO: THE COUNTY HEALTH OFFICER
ELLICOTT CITY, MARYLAND

I, HEREBY, APPLY FOR THE NECESSARY TEST IN ORDER TO CONSTRUCT (OR RECONSTRUCT) A SEWAGE DISPOSAL SYSTEM.

PROPERTY OWNER Brian & Theresa Hamill
Springhill Associates - c/o D.S. Thaler & Associates, Inc.

ADDRESS 11 Warren Road, Baltimore, MD 21208 PHONE 750-9319
(301) 484-4100

PROSPECTIVE BUYER N/A

ADDRESS _____ PHONE _____

PROPERTY LOCATION:

SUBDIVISION Meadowood LOT NO. 44

*LOT 44 Sec 2 Phase 2
on prelim.*

ROAD AND DESCRIPTION Henryton Road - approximately 4000' north of Tunnel Road

Howard County, Maryland (1219 Wild Rose Court)

TAX MAP 10 PARCEL # 139

SIZE OF LOT 3+ Acres TYPE BLDG. Single Family

(SINGLE FAMILY DWELLING OR COMMERCIAL)

THE SYSTEM INSTALLED UNDER THIS APPLICATION IS ACCEPTABLE ONLY UNTIL PUBLIC FACILITIES BECOME AVAILABLE. I FULLY UNDERSTAND THE FEE CONNECTED WITH THE FILING OF THIS PERC TEST APPLICATION IS NON-REFUNDABLE UNDER ANY CIRCUMSTANCES. I ALSO AGREE TO COMPLY WITH ALL M.O.S.H.A. REQUIREMENTS IN TESTING THIS LOT.

Mike Sedgwick
(SIGNATURE OF APPLICANT)

APPROVED BY _____ FOR _____ DATE _____

REJECTED BY _____ FOR _____ DATE _____

HOLD PENDING FURTHER TESTS _____ DATE _____

REASONS FOR REJECTION OR HOLDING for field located holes & sub-plat

BLDG. PERMIT SIGNED

AND RETURNED 10/23/92

Seal # 45706 - SFD
(4 Bedrooms)

THIS IS NOT A PERMIT

174A/BORN
 TOLLET 2K
 MAX D. 4K
 X 2mm

LIMITED HOUSE SITE & PROBABLE ELEVATION PROBLEMS ON PRELIM PLAT


10/21/88

Also limited well area due to
 addition of utility easement.

SOIL PROFILE

grey/brown
 orange
 silt loam
 clay
 2'
 to grey
 brown
 w/ 15% s
 lge lapped
 frags
 weathered
 10'D

3

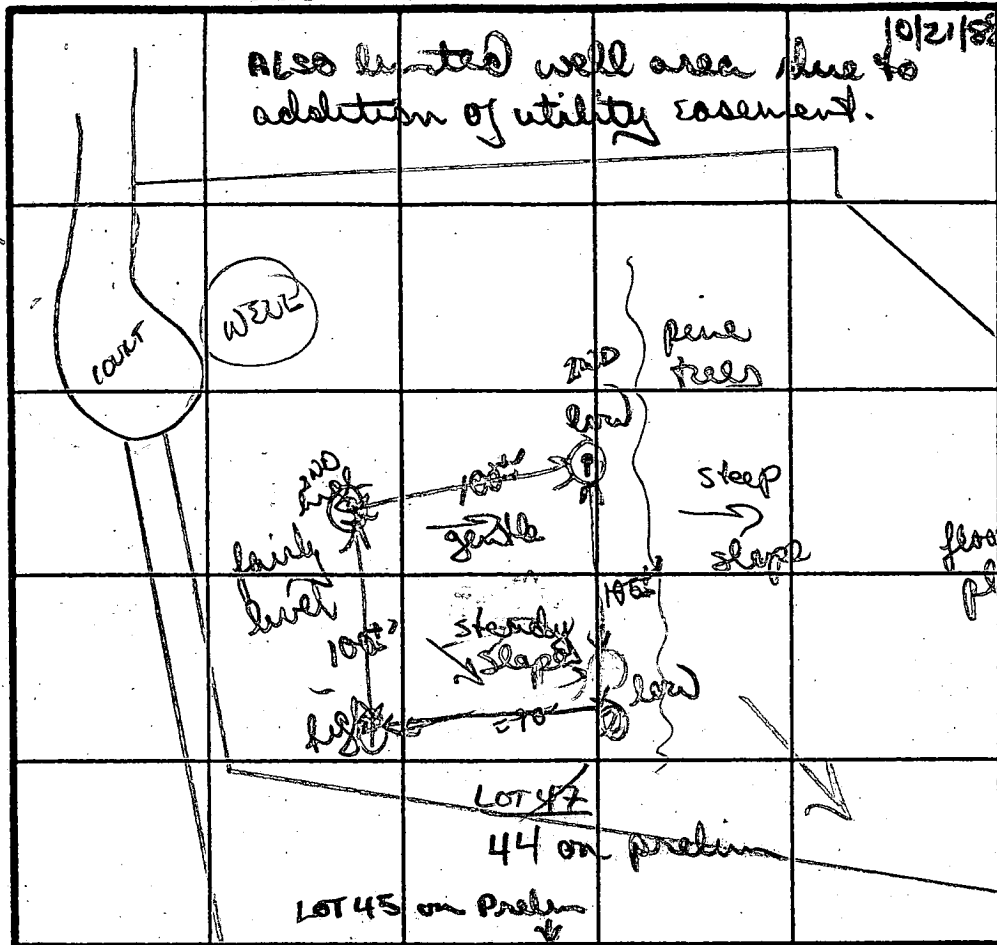

2

mix of orange
 tan/grey
 silty loam
 w/ 5% small
 weathered
 frags 5'

10 1/2'D

INDICATE NORTH - NAME ADJOINING ROADWAY AS BASE LINE.

TO HENRYTON Rd.

DATE	TEST NO.	DEPTH	PRE-WET		TEST - 1" DROP		TIME
			START	STOP	START	STOP	
11/7/87	①	2 1/2'S	1123	1124	1124	1126	20min
		10'D	bottom (see profile)				
	②	= 3'S	1126	1127	1127	1129	20min
		10 1/2'D	bottom (see profile)				
	③	VISUAL ONLY					
		10 1/2'D	bottom (see profile)				
	④	2'S	1128	1129	1129	1130	1min
		5'M	1128	1129	1129	1132	3min
		10'D	bottom (see profile)				

REMARKS

TYPE OF SOIL

TESTED BY

SHALLOW SYSTEM ONLY dug & tested as stated
 per field in scattered underbrush

mostly grey/orange silty loam; varying % frags

D. Wilson

ALSO PRESENT

Ed. Rocky

Similar to
 hole #1
 w/ 10-15%
 frags
 3 1/2 - 8"
 back to
 grey silty
 loam

④ 10 1/2

orange/yellow
 clay loam
 to orange
 grey silty
 loam 25%
 frags 5'
 to grey silty
 loam w/
 1 to 15-20%
 frags

B 1	9166	SEQUENCE NO. (DP USE ONLY)	STATE OF MARYLAND PERMIT TO DRILL WELL	STATE PERMIT NUMBER 40-88-0887
(THIS NUMBER IS TO BE PUNCHED IN COLS. 3-6 ON ALL CARDS)		please print or type		
Date Received (APA) 06/13/89		LOCATION OF WELL 40.00 12-44492 6/13/89		
OWNER INFORMATION SPRINGHILL ASSOC 1423 RT 32 W FRIENDSHIP MD 21794		HOWARD MEADOWOOD SECTION 2 LOT 44 SYKESVILLE MILES FROM TOWN (enter 0 if in town) 4 MI		
DRILLER INFORMATION George F. Easterday L. Franklin Easterday, Inc. 9265 Brown Church Rd. Mt. Airy, Md. 21771 Signature: George F. Easterday Date: 6/8/89		WILD ROSE CT NEAR WHAT ROAD ON WHICH SIDE OF ROAD (CIRCLE APPROPRIATE BOX) NORTH WEST EAST SOUTH DISTANCE FROM ROAD 50 FT		
WELL INFORMATION APPROX. PUMPING RATE (GAL. PER MIN.) 5 AVERAGE DAILY QUANTITY NEEDED (GAL. PER DAY) 500		DIRECTION OF WELL FROM TOWN (CIRCLE BOX) 		
USE FOR WATER (CIRCLE APPROPRIATE BOX) <input checked="" type="checkbox"/> HOME (SINGLE OR DOUBLE HOUSEHOLD UNIT ONLY) <input type="checkbox"/> FARMING (LIVESTOCK WATERING & AGRICULTURAL IRRIGATION) <input type="checkbox"/> INDUSTRIAL, COMMERCIAL, STATE AND FEDERAL GOV. OTHER (REQUIRES APPROPRIATION PERMIT) <input type="checkbox"/> PUBLIC OR PRIVATE WATER COMPANY (REQUIRES APPROPRIATION PERMIT AND STATE HEALTH DEPARTMENT APPROVAL) <input type="checkbox"/> TEST, OBSERVATION, MONITORING (MAY REQUIRE APPROPRIATION PERMIT)		NOT TO BE FILLED IN BY DRILLER HEALTH DEPARTMENT APPROVAL COUNTY NAME: HOWARD COUNTY NO.: A-3854 STATE SIGNATURE: [Signature] DATE ISSUED: 07/17/89 CO SIGNATURE: [Signature] EXP. DATE: 7/16/90 NORTH GRID: 547000 EAST GRID: 0820000 EXTENDED 12/5/89 MR		
APPROXIMATE DEPTH OF WELL 300 FEET APPROXIMATE DIAMETER OF WELL 6 INCH		SHOW MAJOR FEATURES OF BOX & LOCATE WELL WITH AN X SOURCES OF DRILLING WATER 1. well 2. 3. WRITE THE BOX NUMBER FROM THE MAP HERE E 820 0 N 540 7 000 000		
METHOD OF DRILLING (circle one) BORED (or Augered) JETTED Jetted & DRIVEN AIR-ROTARY AIR-PERCussion ROTARY (Hydraulic Rotary) CABLE REVERSE-ROTARY Drive-POINT other		DRAW A SKETCH BELOW SHOWING LOCATION OF WELL IN RELATION TO NEARBY TOWNS AND ROADS AND GIVE DISTANCE FROM WELL TO NEAREST ROAD JUNCTION 		
REPLACEMENT OR DEEPEMED WELLS (CIRCLE APPROPRIATE BOX) <input checked="" type="checkbox"/> THIS WELL WILL NOT REPLACE AN EXISTING WELL <input type="checkbox"/> THIS WELL WILL REPLACE A WELL THAT WILL BE ABANDONED AND SEALED <input type="checkbox"/> THIS WELL WILL REPLACE A WELL THAT WILL BE USED AS A STANDBY <input type="checkbox"/> THIS WELL WILL DEEPEMED AN EXISTING WELL PERMIT NUMBER OF WELL TO BE REPLACED OR DEEPEMED (IF AVAILABLE)		Not to be filled in by driller (OEP USE ONLY) APPROP. PERMIT NUMBER GAP FORCE SA WRITE INITIALS IN BOX PERMIT No. 40-88-0887 SPECIAL CONDITIONS		

C1 1022 (THIS NUMBER IS TO BE PUNCHED IN COLS. 3-6 ON ALL CARDS)	SEQUENCE NO. (DENY USE ONLY)	STATE OF MARYLAND WELL COMPLETION REPORT FILL IN THIS FORM COMPLETELY PLEASE PRINT OR TYPE	THIS REPORT MUST BE SUBMITTED WITHIN 45 DAYS AFTER WELL IS COMPLETED.
ST/CO USE ONLY DATE Received		DATE WELL COMPLETED	PERMIT NO. FROM "PERMIT TO DRILL WELL"
[] [] [] [] [] [] 8 13		04/17/90	H0-88-0887
		Depth of Well 22 500 26 (TO NEAREST FOOT)	28 29 30 31 32 33 34 35 36 37

OWNER	last name	first name	TOWN
STREET OR RFD	WINDY HILL CT.		SYKEVILLE
SUBDIVISION	MEADOWOOD	SECTION 2 Phase 2	LOT 44

WELL LOG		
Not required for driven wells		
STATE THE KIND OF FORMATIONS PENETRATED, THEIR COLOR, DEPTH, THICKNESS AND IF WATER BEARING		
DESCRIPTION (Use additional sheets if needed)	FEET	
	FROM	TO
Top Soil	0	2
Red Clay	2	5
Brown Mica	5	26
Gray Mica	26	30
Brown	30	31
Gray Mica	31	42
Tan	42	44
Gray Mica	44	69
Brown	69	70
Gray Mica	70	500
Flint at 160 to 340		

GROUTING RECORD	
WELL HAS BEEN GROUTED (Circle Appropriate Box)	
yes <input checked="" type="radio"/> Y	no <input type="radio"/> N
TYPE OF GROUTING MATERIAL	
CEMENT <input checked="" type="radio"/> CM	BENTONITE CLAY <input type="radio"/> BC
NO. OF BAGS 8	NO. OF POUNDS 800
GALLONS OF WATER 40	
DEPTH OF GROUT SEAL (to nearest foot)	
from 0	ft. to 26
(enter 0 if from surface)	

CASING RECORD		
casing types insert appropriate code below	STEEL <input checked="" type="radio"/> ST	CONCRETE <input type="radio"/> CO
	PLASTIC <input type="radio"/> PL	OTHER <input type="radio"/> OT
MAIN CASING TYPE	Nominal diameter top (main) casing (nearest inch)	Total depth of main casing (nearest foot)
ST	6	28

OTHER CASING (if used)	
diameter inch	depth (feet) from to

SCREEN RECORD		
screen type or open hole	insert appropriate code below	
STEEL <input checked="" type="radio"/> ST	BRASS <input type="radio"/> BR	OPEN HOLE <input type="radio"/> HO
PLASTIC <input type="radio"/> PL	BRONZE <input type="radio"/> OT	OTHER <input type="radio"/> OT


C2	
DEPTH (nearest ft.)	
1 14	2 26
3 500	
SLOT SIZE 1 2 3	
DIAMETER OF SCREEN (NEAREST INCH)	
from to	

GRAVEL PACK	
IF WELL DRILLED WAS FLOWING WELL INSERT F IN BOX 68	
68	

OEP USE ONLY (NOT TO BE FILLED IN BY DRILLER)		
T	(E.R.O.S.)	W Q
70	72	74 75 76
TELESCOPE CASING	LOG INDICATOR	OTHER DATA

C3		
PUMPING TEST		
HOURS PUMPED (nearest hour) 6		
PUMPING RATE (gal. per min. to nearest gal.) 4		
METHOD USED TO MEASURE PUMPING RATE Bucket		
WATER LEVEL (distance from land surface)		
BEFORE PUMPING 42		
WHEN PUMPING 17		
TYPE OF PUMP USED (for test)		
A air	P piston	T turbine
C centrifugal	R rotary	O other (describe below)
J jet	S submersible	

PUMP INSTALLED	
DRILLER WILL INSTALL PUMP. YES <input checked="" type="radio"/> NO <input type="radio"/>	
IF DRILLER INSTALLS PUMP, THIS SECTION MUST BE COMPLETED FOR ALL WELLS EXCEPT HOME USE	
TYPE OF PUMP INSTALLED	
PLACE (A,C,J,P,R,S,T,O) IN BOX - SEE ABOVE:	
CAPACITY: GALLONS PER MINUTE (to nearest gallon)	
PUMP HORSE POWER	
PUMP COLUMN LENGTH (nearest ft.)	
CASING HEIGHT (circle appropriate box and enter casing height)	
F above	LAND SURFACE
below	(nearest foot)

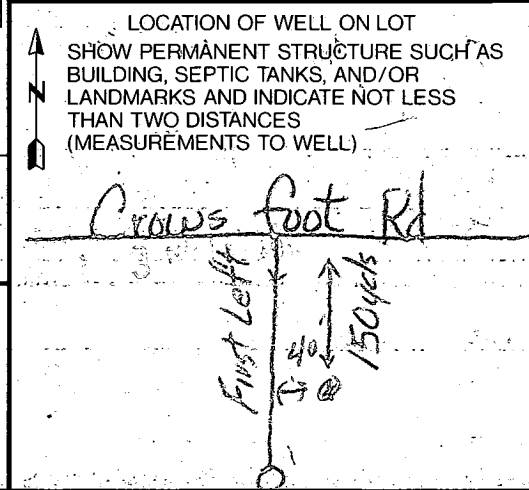

CIRCLE APPROPRIATE LETTER	
A	A WELL WAS ABANDONED AND SEALED WHEN THIS WELL WAS COMPLETED
E	ELECTRIC LOG OBTAINED
P	TEST WELL CONVERTED TO PRODUCTION WELL

I HEREBY CERTIFY THAT THIS WELL HAS BEEN CONSTRUCTED IN ACCORDANCE WITH COMAR 26.04.04 "WELL CONSTRUCTION" AND IN CONFORMANCE WITH ALL CONDITIONS STATED IN THE ABOVE CAPTIONED PERMIT, AND THAT THE INFORMATION PRESENTED HEREIN IS ACCURATE AND COMPLETE TO THE BEST OF MY KNOWLEDGE.

DRILLERS IDENT. NO.	40
DRILLERS SIGNATURE	(MUST MATCH SIGNATURE ON APPLICATION)
SITE SUPERVISOR (sign. of driller or journeyman responsible for sitework if different from permittee)	

Page _____ of _____
Date _____

4-14-90
8:00

~~6hr.~~ 6hr.

Review OR MR 6/1/90

FIELD DATA SHEET
HOWARD COUNTY WELL YIELD TEST

Well Permit No. HO - 88-0887
Location of property (road) Wild Rose Ct.
Subdivision MEADOWCROFT Lot 44 Block _____ Plat _____ Sec. 2 Phase 2
Well Driller G. EASERDAY Owner Springhill Assoc.

Depth of well 500 3/4 ft.
Distance of measuring point (M.P.) above ground 1 1/2 ft.
Static water level (S.W.L.) below M.P. 42 ft.

I. High rate pumping -- reservoir drawdown

Time pump started 8:00 Pumping rate 10 GPM
Total time 1 HR to reach pumping water level 170 ft. below M.P.

II. Recovery pump test data - observations to be recorded every 15 minutes

TIME (in 15 minute intervals)	WATER LEVEL below M.P.	PUMPING RATE time to fill #1 gallon bucket	FLOW METER READING (if used)	CALCULATED FLOW (gallons per minute)
9:00	170'	13 SEC	390 FT.	4.61 GPM
9:15	170'	13 SEC	20 - Hand	4.61 GPM
9:30	170'	13 SEC		4.61 GPM
9:45	170'	13 SEC		4.61 GPM
10:00	170'	13 SEC		4.61 GPM
10:15	170'	13 SEC		4.61 GPM
10:30	170'	13 SEC		4.61 GPM
10:45	170'	13 SEC		4.61 GPM
11:00	170'	13 SEC		4.61 GPM
11:15	170'	13 SEC		4.61 GPM
11:30	170'	13 SEC		4.61 GPM
11:45	170'	13 SEC		4.61 GPM
12:00	170'	13 SEC		4.61 GPM
12:15	170'	13 SEC		4.61 GPM
12:30	170'	13 SEC		4.61 GPM
12:45	170'	13 SEC		4.61 GPM
1:00	170'	13 SEC		4.61 GPM
1:15	170'	13 SEC		4.61 GPM
1:30	170'	13 SEC		4.61 GPM
1:45	170'	13 SEC		4.61 GPM
2:00	170'	13 SEC		4.61 GPM
2:15	170'	13 SEC		4.61 GPM
2:30	170'	13 SEC		4.61 GPM
2:45	170'	13 SEC		4.61 GPM
HD-224 3:00	170'	13 SEC		4.61 GPM

Well Permit

Robert L. Freezer

6321 Barnett Ave
Sykesville

795 1405

OK Cover Well Lane Get
Permit if not already have
a permit Put Cap on
Well casing

Pump and not yet
installed

RECEIVED
HOWARD COUNTY
HEALTH DEPT.
MAY 1 3 46 PM '90
DIVISION OF
ENVIRONMENTAL
HEALTH

HOWARD COUNTY HEALTH DEPARTMENT
Bureau of Environmental Health
3525-H Ellicott Mills Drive
Ellicott City, MD 21043
461-9933

APPLICATION FOR PITLESS ADAPTER, WELL PUMP AND PRESSURE TANK INSTALLATION

New Installation ☒
Replacement ☐

Receipt #
Date 3/3/92

Name of Installer ROBERT L. FREEZE CO., INC. Telephone 781-4655

License Number 2122

Certified Well Pump Installer ☒ Well Driller ☐ Registered Plumber ☒

Name of Property Owner Wesley Hays Telephone 785-1405

Subdivision 1219 WILDEROSE CT. Lot # 44 Well Tag # HO-88-0887

Site Address THURMAN WOOD

Pump

1. Type

- a. Deep well jet ☐
b. Shallow well jet ☐
c. Submersible ☒

2. Make Coult

3. Model # SES10412

4. Capacity 5 GPM

5. Pump exceeds well capacity Yes ☒ No ☐

6. If Yes, is low pressure cutoff switch installed? Yes ☐ No ☒

7. What methods are used to protect the pump and electrical wiring from vibrations? Torque arrestors ☐ Cable guards ☒ Other ☐

Motor

1. Horsepower 1

2. RPM 3450

3. Voltage ☐

a. 110 ☐

b. 220 ☒

Pitless Adapter

1. Make CARBEL

2. Model # B-10

3. Depth 42"

Tank CAPITOL AIR

1. Capacity UX-203

2. Pressure relief

valve? YES

Piping

1. Type PVC

2. Size 1"

3. NSF and/or BOCA

Code approved YES

4. Depth of supply

line 42"

Well data

1. Depth 482 ft.

2. Yield GPM

3. Static water

level ft.

4. Will water supply

be disinfected by

installer? YES

I understand that it is my responsibility to notify the Howard County Health Department when the installation is ready for inspection (otherwise this permit is null and void).


All information given above is true to the best of my knowledge.

Signature of Applicant: Robert L. Freeze

Date: 3/3/93

Note: A sticker indicating approval/status of the installation will be placed on the well casing at the time of the inspection.

3/3/93 OK TO COVER WELL
LINE
MR per RH

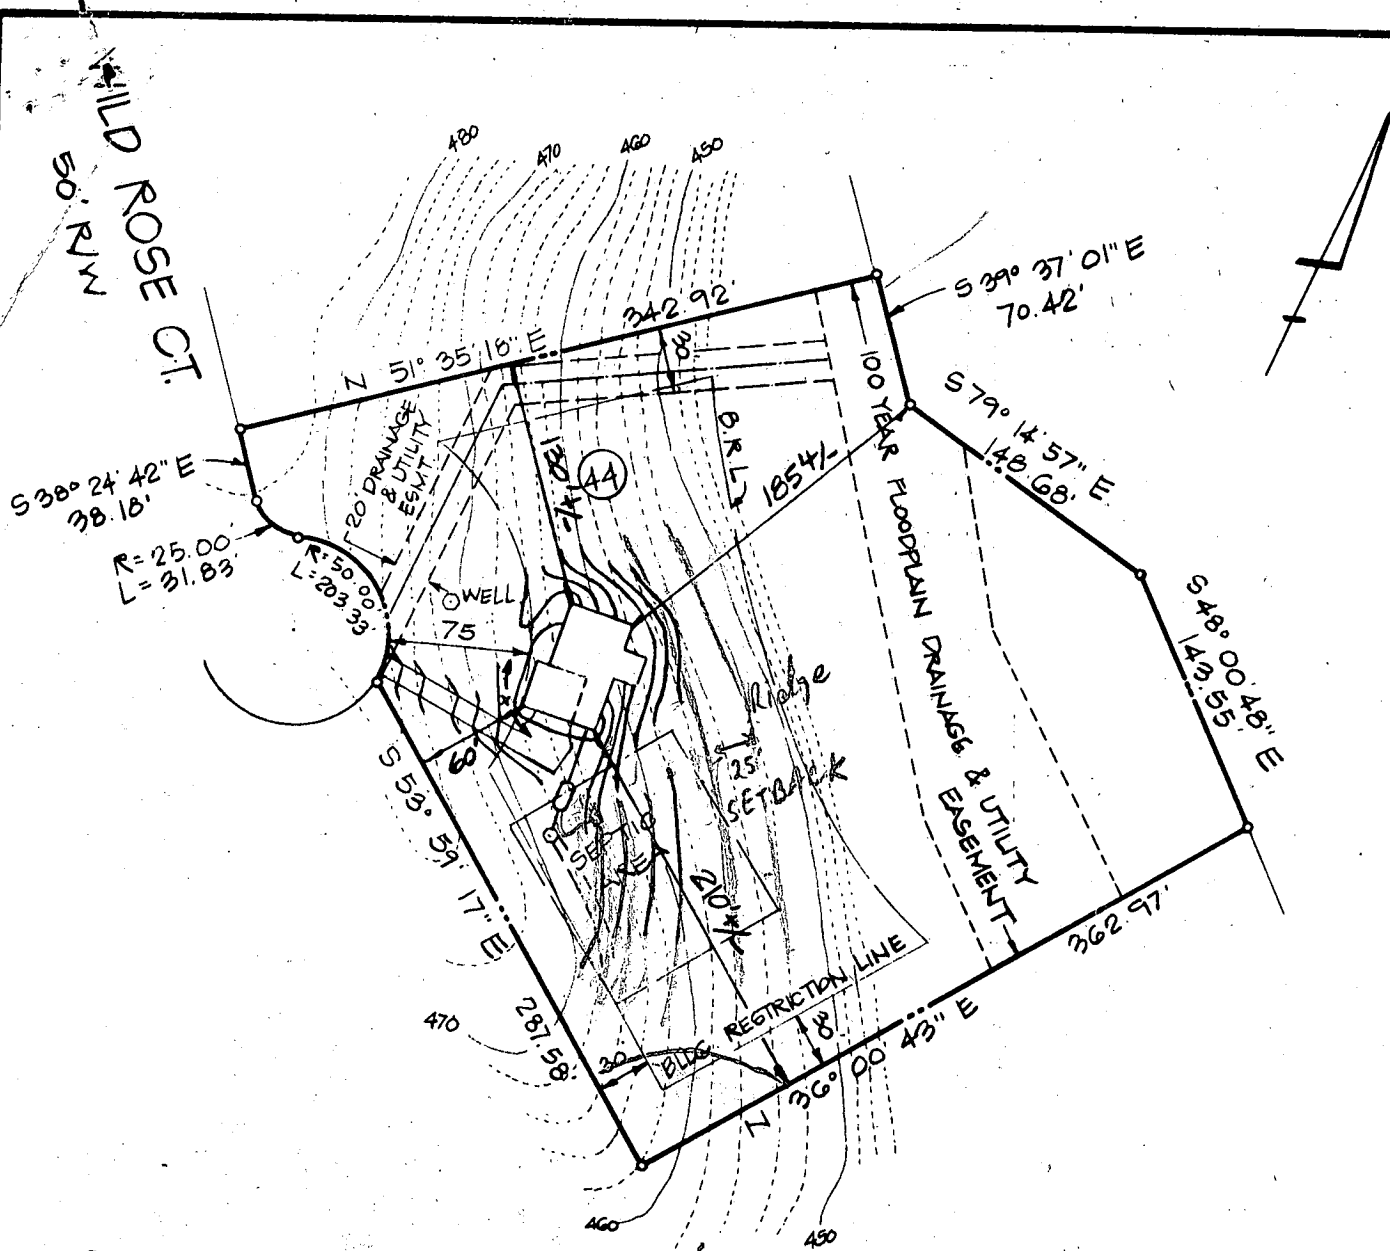


SITE ELEVATIONS

INV. OUT DWLG.	467.2
INV. IN SEPTIC TANK	466.6
INV. OUT SEPTIC TANK	466.5
INV. IN DIST. BOX	466.3
INV. OUT DIST BOX	466.2
INV. IN TRENCHES	466.0

CONTRACTOR IS TO PROVIDE
POSITIVE DRAINAGE AWAY FROM
FOUNDATION AT ALL TIMES

DISTURBED AREA = 15,000 S.F.±

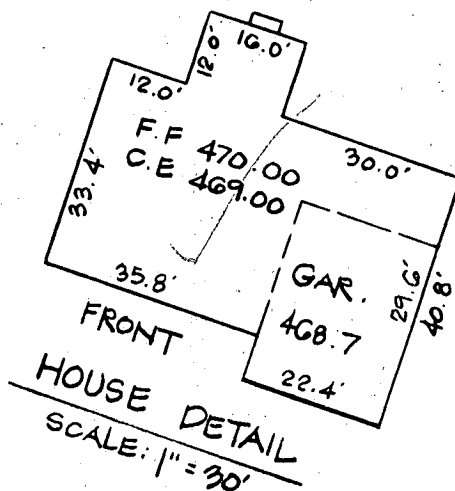

10/23/92
REVISED PLANS OK
BP 45706
R. J. Hodges

LOT 44
MEADOWOOD

SECT. 2 AREA 2
Δ 8980
3RD. ELECT. DIST. HOWARD CO. MD.

W. McKee

James W. McKee, MD Reg. 9012

10/7/92
Date

* REVISED 10/21/92 TO SHOW NEW
SEPTIC INVERT ELEVATIONS



drawn:
JGK

designed:
JGK

SITE PLAN
1219 WILD ROSE COURT

McKEE & ASSOCIATES, INC.

CIVIL ENGINEERS - LAND SURVEYORS
SHAWAN PLACE
5 SHAWAN ROAD HUNT VALLEY, MD 21030
301-527-1555

scale:
1" = 100'

date:
10.5.92

job no.:
MR-12