

04-346580

## PERMIT

SEWAGE DISPOSAL SYSTEM

MARYLAND STATE DEPARTMENT OF HEALTH

HOWARD COUNTY

BUREAU OF ENVIRONMENTAL HEALTH

461-9933

INDEXED

P 43112

A 38362

4th

DATE 11/28/88

DATE SYSTEM APPROVED 9/15/89

INSPECTOR M. Riffkin

~~Frederick Plumbing~~ Fall SepticIS PERMITTED TO INSTALL ☒ ALTER

ADDRESS PHONE 663-1475

SUBDIVISION Glenwood Springs ROAD 2816 Saddlebred Court LOT 15

PROPERTY OWNER Jerry Booth

ADDRESS

IF GARBAGE GRINDER IS USED INCREASE SEPTIC TANK CAPACITY BY 50% AND ABSORPTION AREA BY 22%.

GARBAGE GRINDER? YES ☒ NO

SEPTIC TANK CAPACITY 2000 GALLONS NUMBER OF BEDROOMS 4

TRENCHES - 220 sq. ft. per bedroom with garbage disposal. Trench to be 3 feet wide. Inlet 4 feet below original grade. Bottom maximum depth 6 feet below original grade. Effective area begins at 4 feet below original grade. 2 feet of stone below distribution pipe.

LOCATION - Place the distribution box 210 feet down the left (588.15') lot line and 70 feet off the same lot line as seen when facing the lot from Saddlebred Court. Run trenches on contour toward the left rear corner.

NOTE - No trench to exceed 100 feet in length. Provide 6" - 8" diameter cleanout and cap to grade or above on septic tank. ok/cw

PLANS APPROVED BY Sid Abel DATE 5/13/88

COVER NO WORK UNTIL INSPECTED AND APPROVED

NEITHER THE HOWARD COUNTY COUNCIL NOR THE HEALTH DEPARTMENT IS RESPONSIBLE FOR THE SUCCESSFUL OPERATION OF ANY SYSTEM

NOTE: CLEANOUT REQUIRED EVERY 70 FEET OF SEWER LINE AND/OR AT 90° SWEEPS IN LINES FROM HOUSE TO DRAIN FIELDS

NOTE: ALL PARTS OF SEPTIC SYSTEMS (I.E. TANK, DISTRIBUTION BOX, TRENCHES) TO BE 100 FEET FROM WELL (UNLESS OTHERWISE SPECIFICALLY AUTHORIZED)

NOTE: IF DEEP TRENCH(ES) ARE USED CALL FOR INSPECTION BEFORE AND AFTER PLACING GRAVEL IN TRENCH(ES)

NOTE: NO DRY WELL SHALL EXCEED 15 FOOT IN DIAMETER NO ABSORPTION TRENCH TO EXCEED 100 FEET IN LENGTH.

NOTE: ALL PIPE FROM HOUSE TO SEPTIC TANK MUST BE CAST IRON OR SCHEDULE 40 PVC OR ABS


PERMIT VOID AFTER TWO YEARS

NOTE: INSTALL STAND PIPE ON SEPTIC TANK AND DRY WELL. STAND PIPES MUST BE 6 INCHES IN DIAMETER. CAST IRON, CONCRETE OR TERRA COTTA OR PVC OR ABS ACCEPTED. IF TOP OF SEPTIC TANK IS DEEPER THAN 3 FEET, MANHOLE TO GRADE REQUIRED

NOTE: DISTRIBUTION BOXES MUST HAVE BAFFLES

\*INSTALLER IS RESPONSIBLE FOR OBTAINING FINAL APROVAL ON THIS PERMIT

\*CALL 461-9933 FOR INSPECTION OF SEPTIC SYSTEMS.

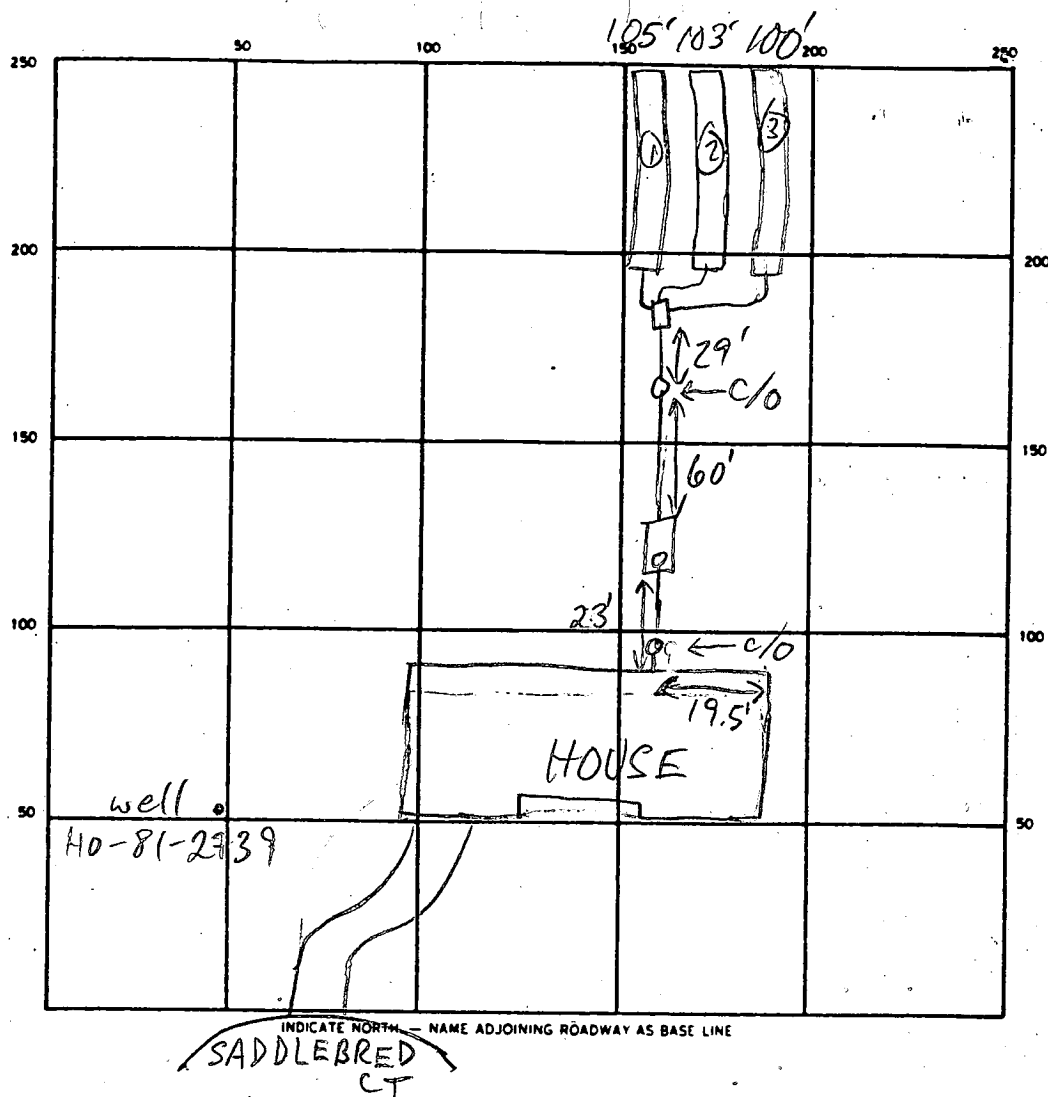

SEPTIC TANK. LEVEL 2000 GAL CLEANOUTS (2) INLINE - OK S.T. - OK

DISTRIBUTION BOX. LEVEL OK BAFFLE IN

DRAIN FIELD/TILE FIELD. DEPTH 6 FT. TRENCH WIDTH 3 FT. INLET DEPTH 4 FT.

EFFECTIVE GRAVEL DEPTH 2 FT. TOTAL LENGTH 105' 103' 100' } 300'

NUMBER OF TRENCHES 3 ONE SIDEWALL/BOTTOM AREA 900 SQ. FT.

DRYWELL INSIDE DIAMETER — FT. EFFECTIVE DEPTH BELOW INLET — FT.

ABSORBENT AREA — SQ. FT.

REMARKS 9/15/89 TRENCHES ① & ② COMPLETE, TRENCH ③  
DIG TO 65'; ADD 35" ADD'L & COVER; (SOME MINOR  
DIFFICULTY W/ROCK IN SOME AREAS - NO MAJOR PROBLEMS) MR

DATE SYSTEM APPROVED

9/15/89

INSPECTOR

M. Riskin

# APPLICATION

PERCOLATION TESTING

A 38362

P \_\_\_\_\_

HOWARD COUNTY HEALTH DEPARTMENT  
BUREAU OF ENVIRONMENTAL HEALTH  
P.O. BOX 476 ELLICOTT CITY, MARYLAND 21043  
TELEPHONE: 461-9933

DISTRICT \_\_\_\_\_

DATE 10-14-86

TO: THE COUNTY HEALTH OFFICER  
ELLICOTT CITY, MARYLAND

I HEREBY APPLY FOR THE NECESSARY TEST IN ORDER TO CONSTRUCT (OR RECONSTRUCT) A SEWAGE DISPOSAL SYSTEM.

PROPERTY OWNER JERRY BOOTH

ADDRESS \_\_\_\_\_ PHONE \_\_\_\_\_

PROSPECTIVE BUYER Ronald Carter

ADDRESS 8388 Court Ave., Elicott City, Md. 21043 PHONE 461-2855

PROPERTY LOCATION:

SUBDIVISION Hakes Property LOT NO. FIFTEEN

ROAD AND DESCRIPTION Hobbs Road 2816 Saddlebred Ct. 4/29/87

TAX MAP 14 PARCEL # 83,87,202

SIZE OF LOT 3+ acres TYPE BLDG. SFD  
(SINGLE FAMILY DWELLING OR COMMERCIAL)

THE SYSTEM INSTALLED UNDER THIS APPLICATION IS ACCEPTABLE ONLY UNTIL PUBLIC FACILITIES BECOME AVAILABLE. I FULLY UNDERSTAND THE FEE CONNECTED WITH THE FILING OF THIS PERC TEST APPLICATION IS NON-REFUNDABLE UNDER ANY CIRCUMSTANCES. I ALSO AGREE TO COMPLY WITH ALL M.O.S.H.A. REQUIREMENTS IN TESTING THIS LOT.

(SIGNATURE OF APPLICANT)

APPROVED BY Sid Alor FOR Shallow Trenches DATE 5-13-88

REJECTED BY \_\_\_\_\_ FOR \_\_\_\_\_ DATE \_\_\_\_\_

HOLD PENDING FURTHER TESTS \_\_\_\_\_ DATE \_\_\_\_\_

REASONS FOR REJECTION OR HOLDING 2-3-87 Perc Satisfactory; Hold For Subdivision Plat. S. Alor

BLDG. PERMIT SIGNED

AND RETURNED 8-3-88

BP 20359 8AL


# THIS IS NOT A PERMIT

00039  
SOIL PROFILE

AP

Yellow BR  
SILTY CLAY  
9-12% CLAY  
CLAY  
FESS

Yellow BR  
SAND CLAY  
20-25%  
FESS  
Slightly  
MICACIOUS

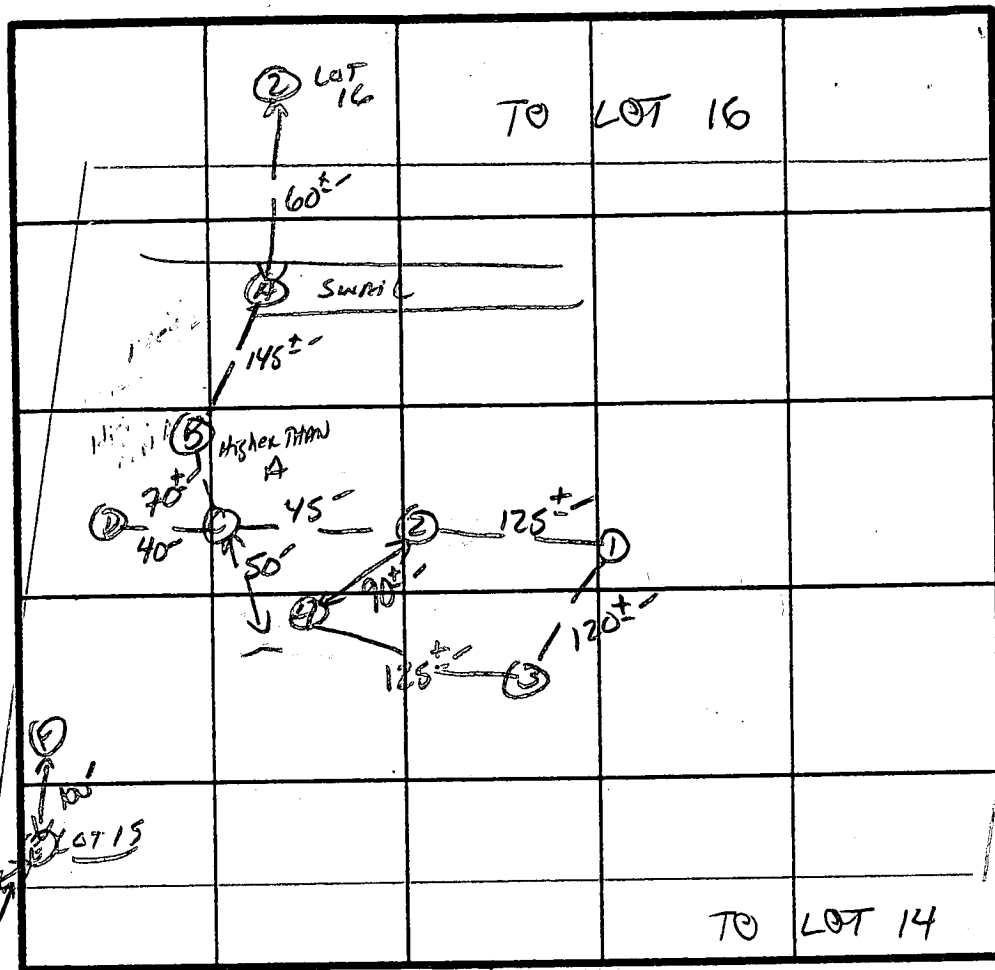

INDICATE NORTH - NAME ADJOINING ROADWAY AS BASE LINE.

X Perc.  
5 min

INLET 4.5

BOTTOM 6.0

780  $\phi$ /PR

DATE	TEST NO.	DEPTH	PRE-WET		TEST - 1" DROP		TIME
			START	STOP	START	STOP	
2/3/87	1 S	5"	1:54	1:56	1:56	2:00	4 min
	1 V	13"	UNIFORM SOIL below 5"				
	2 S	4"	2:08	2:10	2:10	2:14	4 min
	2 V	12"	UNIFORM SOIL below 4"				
	3 S	4.5	2:01	2:04	2:04	2:09	5 min
	3 M	8.5	1:58	2:01	2:01	2:05	4 min
	3 V	12.5"	UNIFORM SOIL below 4"				
	4 S	4"	2:05	2:06	2:06	2:09	3 min
	4 V	12"	UNIFORM SOIL below 4"				
	E	WATER AT	5 FE	MOTILES AT	35"		
	F	WATER AT	7 FE	MOTILES AT	5"		
	C+D	ROCK AT	9-8"	RESPECTIVELY			
	A-	WATER AT	11 FE				
	B-	WATER AT	8 FE	PERCHED			


REMARKS SHALLOW SYST. ONLY HOLES NOT PER PLAT

TYPE OF SOIL MARL / CHALK

TESTED BY S. Abel ALSO PRESENT Phil M. C. Cissel

PLOT PLAN  
LOT 15 SECTION 1  
GLENWOOD SPRINGS  
4TH ELECTION DISTRICT  
HOWARD COUNTY, MARYLAND

INSET  
SCALE - 1" = 30'

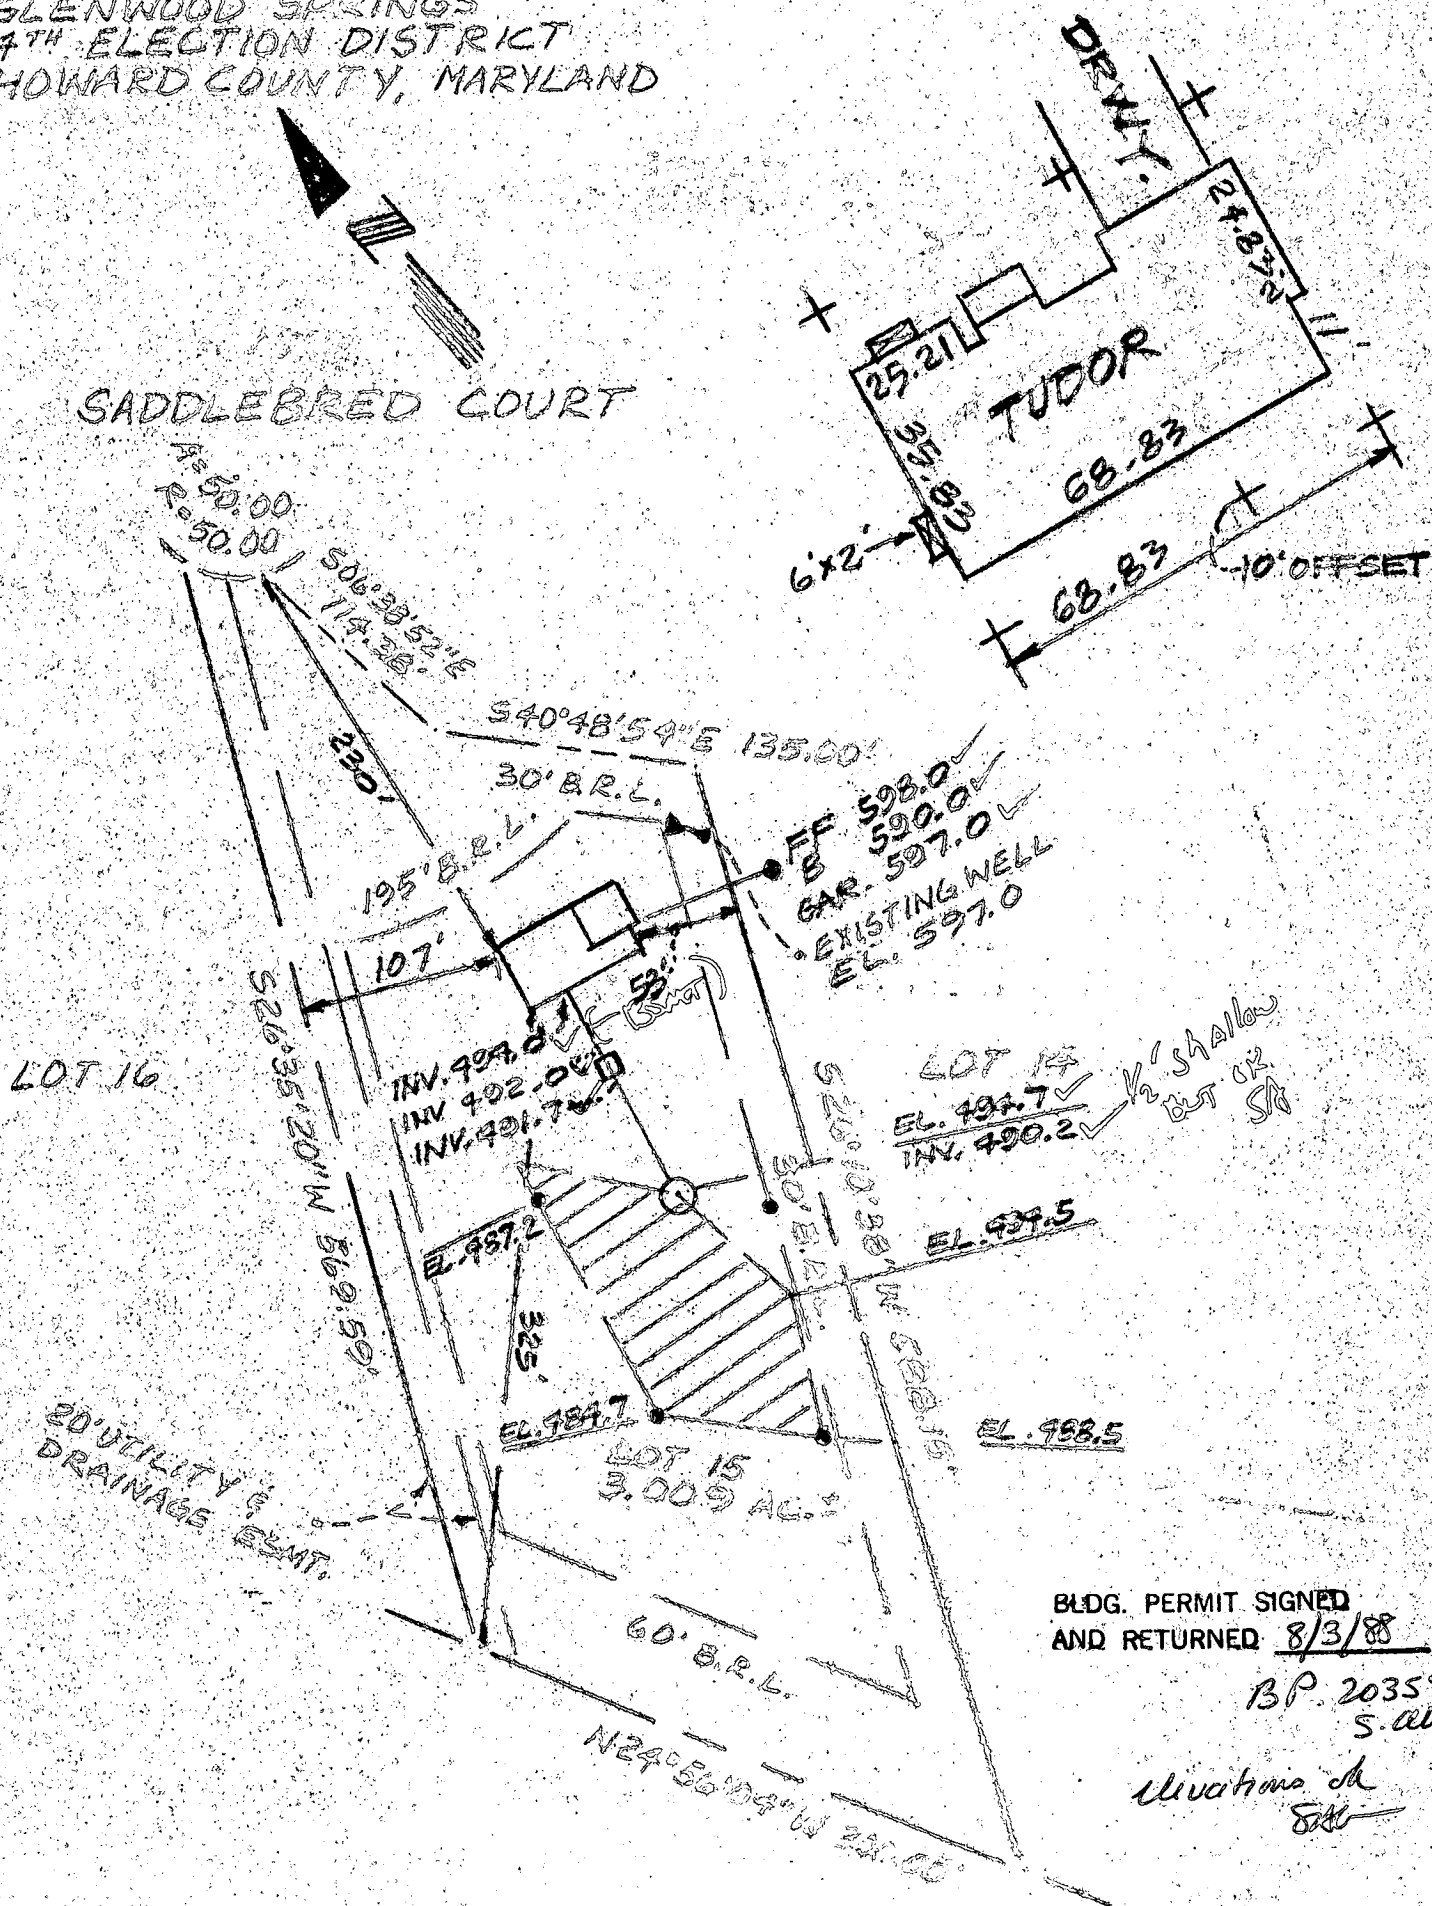


BLDG. PERMIT SIGNED  
AND RETURNED 8/3/88

B.P. 20359  
S. Alver

W. Williams  
EAL

<p><b>Tri - County Surveys, Inc.</b> BOX 55 • DAMASCUS, MARYLAND 20872 • (301) 831-3655 LAND PLANNING CONSULTANTS • SUBDIVISIONS • LOTS &amp; BOUNDARIES</p>	<p>REFERENCE Plot Book No. 7661</p>	<p>COUNTY OF Howard</p>	<p>Drawn by: CLW Checked by: Job No.: 88-029</p>
<p><b>SURVEYOR'S CERTIFICATION</b> I hereby certify that the property delineated herein is in accordance with the best of my knowledge and belief, and that the same is true and correct. This Plot is not for determining property lines, but for the purpose of showing the location of the building and the location of the easements. The owner of the property and also those who purchase, mortgage, or otherwise dispose of the property hereof, and as to them I warrant the accuracy of this Plot.</p> <p><i>William L. Wirts</i> 7/20/88 WILLIAM L. WIRTS - Registered Land Surveyor - Maryland No. 10721</p>			<p>Scale: 1" = 100' DATES Well Ck.: Final Loc.: Recert.:</p>
<p>NOTE: This drawing is not intended or represented to be a lot stake out survey, nor is it to be used, or relied upon, for the establishment of any fence, building or other improvements. No responsibility is assumed by the surveyor for any error or omission.</p>			

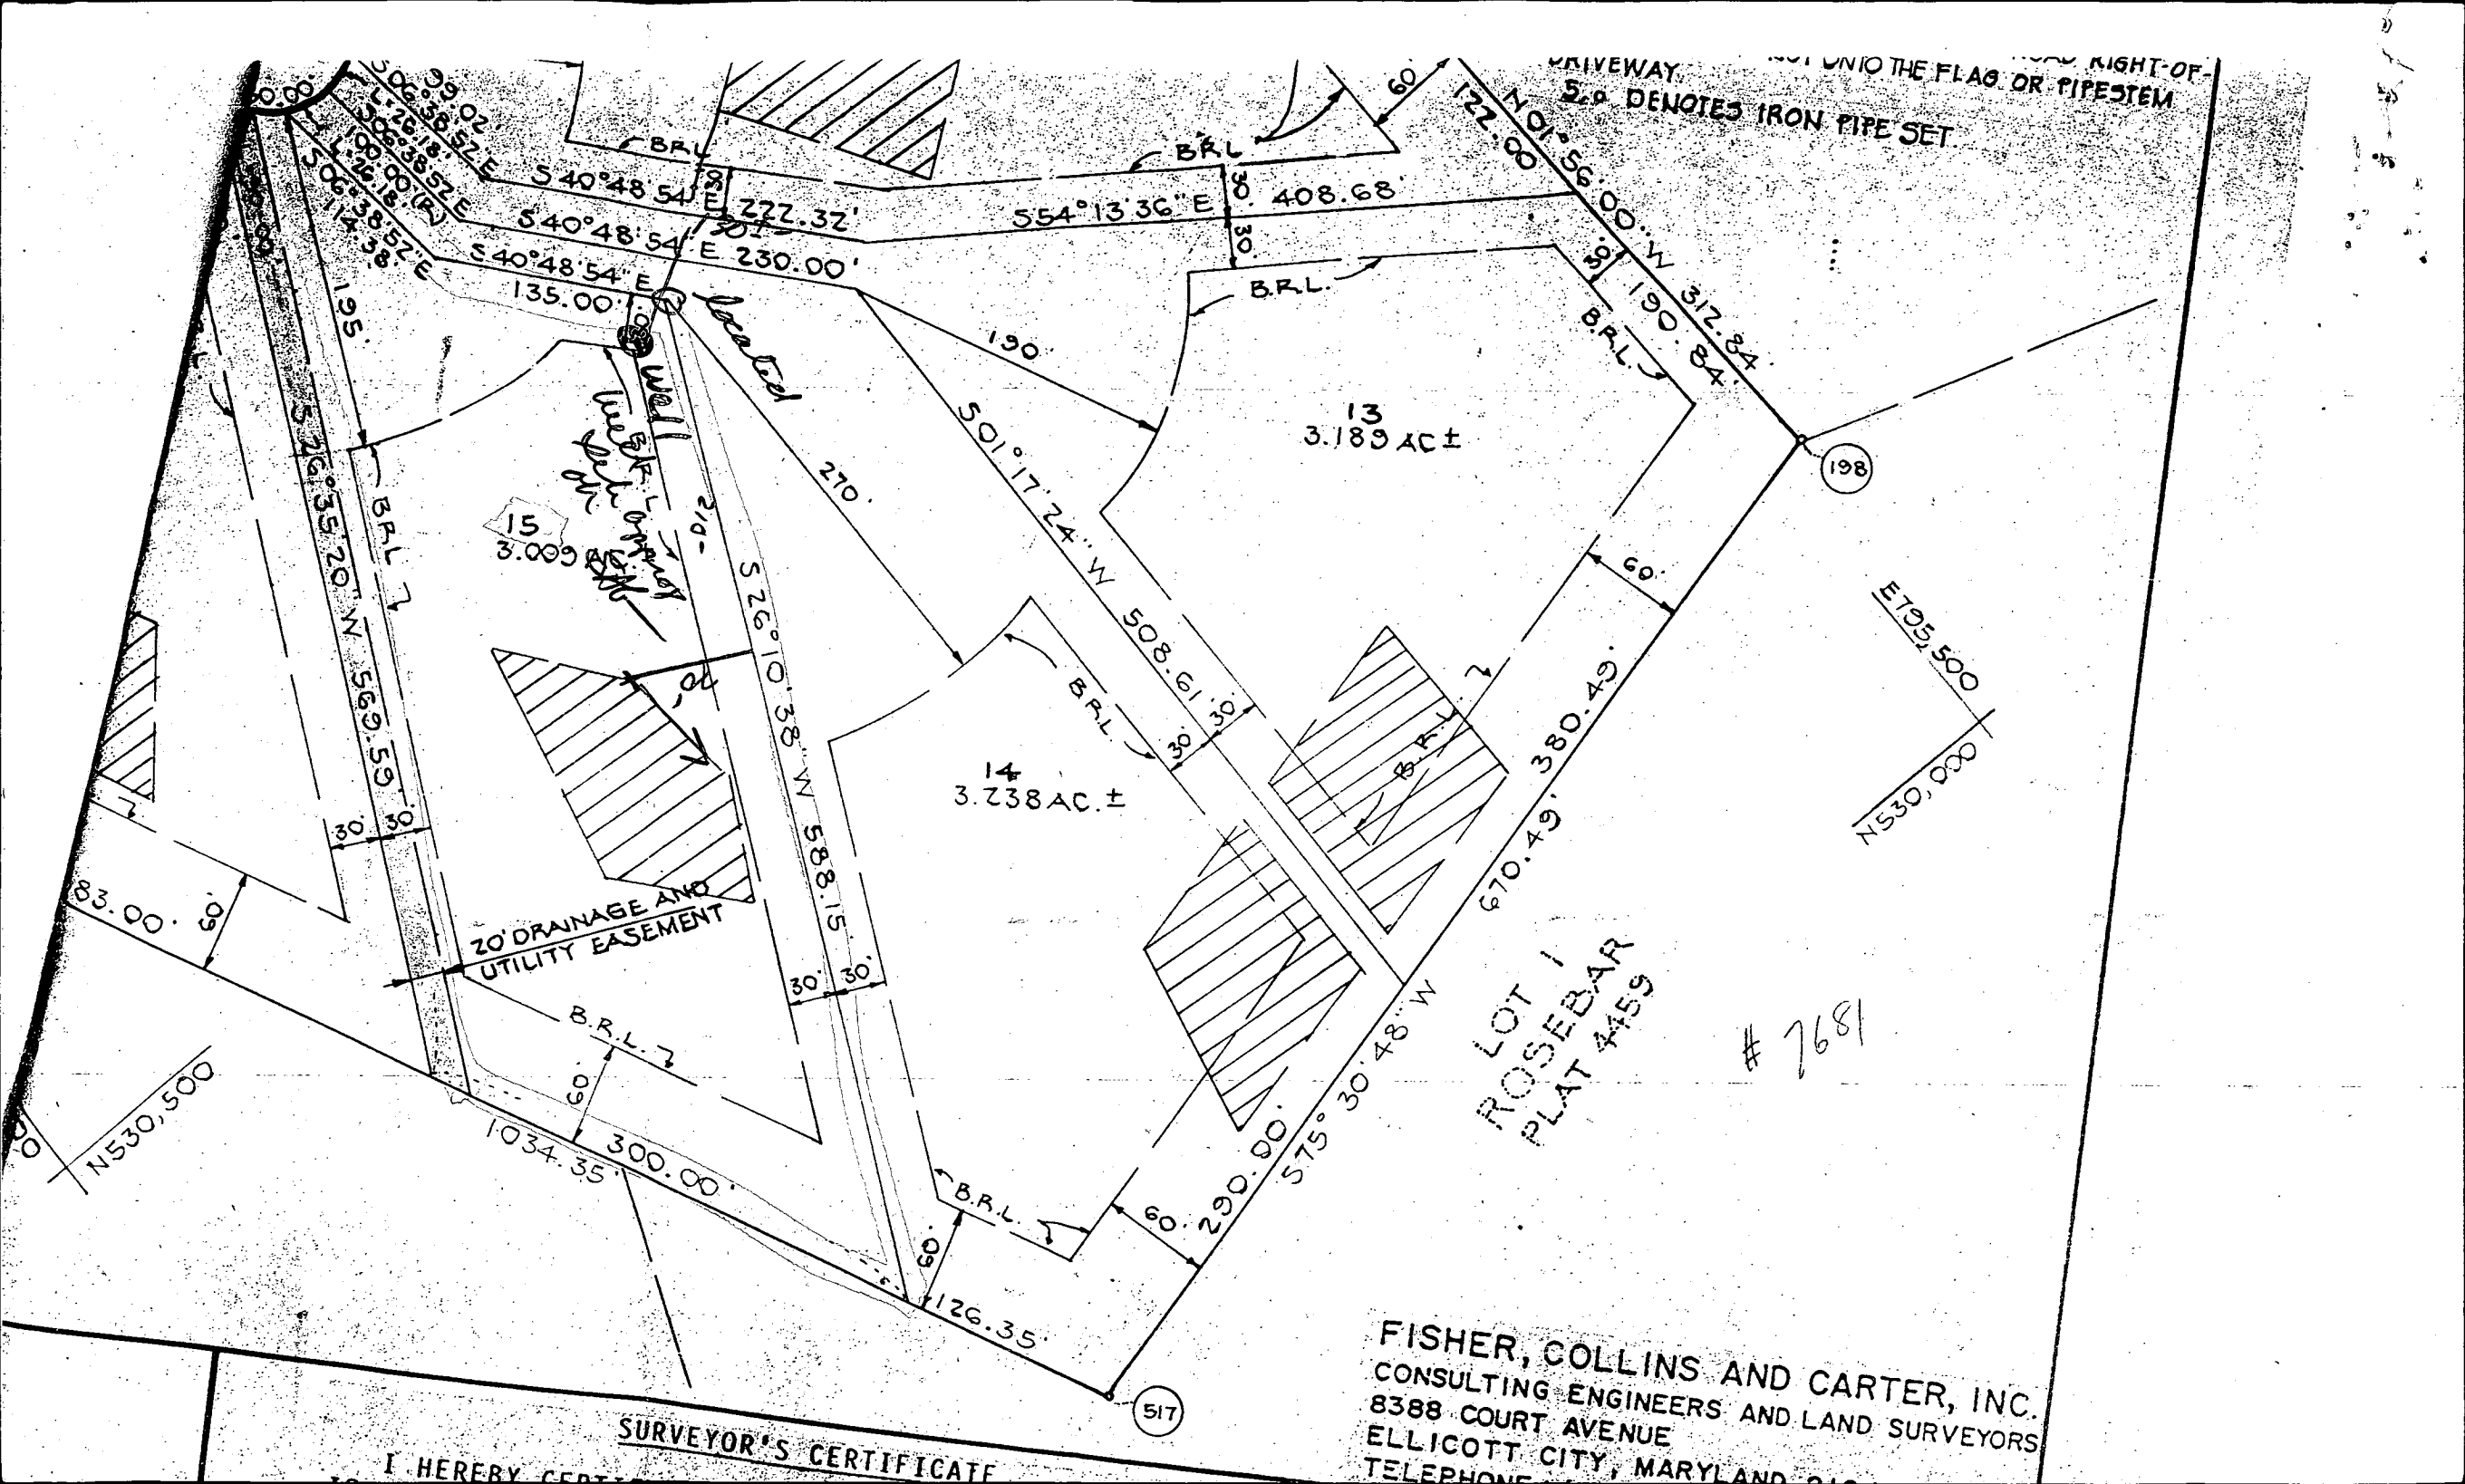

DRIVEWAY  
... UNTO THE FLAG OR PIPESTEM  
S.D. DENOTES IRON PIPE SET

13  
3.189 AC ±

14  
3.238 AC ±

15  
3.009 AC ±

20' DRAINAGE AND  
UTILITY EASEMENT


LOT 1  
ROSEBAR  
PLAT 4459

# 7681

FISHER, COLLINS AND CARTER, INC.  
CONSULTING ENGINEERS AND LAND SURVEYORS  
8388 COURT AVENUE  
ELLCOTT CITY, MARYLAND 21117  
TELEPHONE 444-1111

SURVEYOR'S CERTIFICATE

I HEREBY CERTIFY
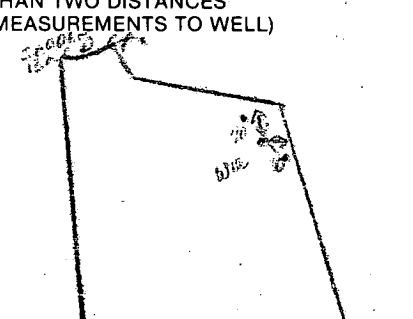
<div style="display: flex; justify-content: space-between;"><div><b>C1</b> <span style="font-size: 24pt;">7800</span></div><div>SEQUENCE NO. (OEP USE ONLY)</div></div> <div style="font-size: 8pt;">1 2 3 6 (THIS NUMBER IS TO BE PUNCHED IN COLS. 3-6 ON ALL CARDS)</div>		<b>STATE OF MARYLAND</b> <b>WELL COMPLETION REPORT</b> FILL IN THIS FORM COMPLETELY PLEASE PRINT OR TYPE		THIS REPORT MUST BE SUBMITTED WITHIN 45 DAYS AFTER WELL IS COMPLETED.												
						COUNTY NUMBER <span style="font-size: 18pt;">A-38362</span>										
DATE Received <div style="border: 1px solid black; width: 100px; height: 20px; display: flex; justify-content: space-between;"><div></div><div></div><div></div><div></div><div></div><div></div></div>		DATE WELL COMPLETED <span style="font-size: 18pt;">052488</span>		Depth of Well 22 <span style="font-size: 18pt;">245</span> 26 (TO NEAREST FOOT)												
				PERMIT NO. FROM "PERMIT TO DRILL WELL" <span style="font-size: 18pt;">HO-81-2739</span>												
OWNER <span style="font-size: 18pt;">CAHMAN ASSOCIATES</span>		last name <span style="font-size: 18pt;">SADDLEBACH CT.</span>		first name												
STREET OR RFD		TOWN <span style="font-size: 18pt;">(Pawwood)</span>														
SUBDIVISION <span style="font-size: 18pt;">CLEARWOOD SPACES</span>		SECTION		LOT <span style="font-size: 18pt;">15</span>												
<b>WELL LOG</b> Not required for driven wells  STATE THE KIND OF FORMATIONS PENETRATED, THEIR COLOR, DEPTH, THICKNESS AND IF WATER BEARING		<b>GROUTING RECORD</b> WELL HAS BEEN GROUTED (Circle Appropriate Box) <div style="display: flex; justify-content: space-around;"><div><div style="border: 1px solid black; border-radius: 50%; padding: 2px;">Y</div>yes</div><div><div style="border: 1px solid black; border-radius: 50%; padding: 2px;">N</div>no</div></div> TYPE OF GROUTING MATERIAL CEMENT <div style="border: 1px solid black; border-radius: 50%; padding: 2px;">CM</div> BENTONITE CLAY <div style="border: 1px solid black; border-radius: 50%; padding: 2px;">BC</div> NO. OF BAGS <span style="font-size: 18pt;">5</span> NO. OF POUNDS <span style="font-size: 18pt;">470</span> GALLONS OF WATER <span style="font-size: 18pt;">30</span> DEPTH OF GROUT SEAL (to nearest foot) from <span style="font-size: 18pt;">0</span> ft. to <span style="font-size: 18pt;">18</span> ft. <div style="display: flex; justify-content: space-between; font-size: 8pt;"><div>48 TOP 52</div><div>54 BOTTOM 58</div></div> (enter 0 if from surface)		<b>C3</b> 1 2  <b>PUMPING TEST</b> HOURS PUMPED (nearest hour) <span style="font-size: 18pt;">3</span> PUMPING RATE (gal. per min. to nearest gal.) <span style="font-size: 18pt;">15</span> METHOD USED TO MEASURE PUMPING RATE <span style="font-size: 18pt;">Bucket</span> WATER LEVEL (distance from land surface) BEFORE PUMPING <span style="font-size: 18pt;">20</span> WHEN PUMPING <span style="font-size: 18pt;">20</span>  TYPE OF PUMP USED (for test) <div style="display: flex; justify-content: space-around;"><div><div style="border: 1px solid black; border-radius: 50%; padding: 2px;">A</div>air</div><div><div style="border: 1px solid black; border-radius: 50%; padding: 2px;">P</div>piston</div><div><div style="border: 1px solid black; border-radius: 50%; padding: 2px;">T</div>turbine</div></div> <div style="display: flex; justify-content: space-around;"><div><div style="border: 1px solid black; border-radius: 50%; padding: 2px;">C</div>centrifugal</div><div><div style="border: 1px solid black; border-radius: 50%; padding: 2px;">R</div>rotary</div><div><div style="border: 1px solid black; border-radius: 50%; padding: 2px;">O</div>other (describe below)</div></div> <div style="display: flex; justify-content: space-around;"><div><div style="border: 1px solid black; border-radius: 50%; padding: 2px;">J</div>jet</div><div><div style="border: 1px solid black; border-radius: 50%; padding: 2px;">S</div>submersible</div></div>												
						<table border="1" style="width:100%; border-collapse: collapse;"><thead><tr><th rowspan="2">DESCRIPTION (Use additional sheets if needed)</th><th colspan="2">FEET</th><th rowspan="2">Check if water bearing</th></tr><tr><th>FROM</th><th>TO</th></tr></thead><tbody><tr><td rowspan="2" style="height: 100px; vertical-align: top;"><span style="font-size: 18pt;">SAND stone</span>  <span style="font-size: 18pt;">GRAY mica Rock</span></td><td style="text-align: center; vertical-align: middle;"><span style="font-size: 18pt;">0</span></td><td style="text-align: center; vertical-align: middle;"><span style="font-size: 18pt;">8</span></td><td></td></tr><tr><td style="text-align: center; vertical-align: middle;"><span style="font-size: 18pt;">8</span></td><td style="text-align: center; vertical-align: middle;"><span style="font-size: 18pt;">245</span></td><td></td></tr></tbody></table>		DESCRIPTION (Use additional sheets if needed)	FEET		Check if water bearing	FROM	TO	<span style="font-size: 18pt;">SAND stone</span>  <span style="font-size: 18pt;">GRAY mica Rock</span>	<span style="font-size: 18pt;">0</span>	<span style="font-size: 18pt;">8</span>
DESCRIPTION (Use additional sheets if needed)	FEET		Check if water bearing													
	FROM	TO														
<span style="font-size: 18pt;">SAND stone</span>  <span style="font-size: 18pt;">GRAY mica Rock</span>	<span style="font-size: 18pt;">0</span>	<span style="font-size: 18pt;">8</span>														
	<span style="font-size: 18pt;">8</span>	<span style="font-size: 18pt;">245</span>														
<b>SCREEN RECORD</b> screen type or open hole <div style="border: 1px solid black; border-radius: 50%; padding: 2px;">ST</div> insert appropriate code below <div style="display: flex; justify-content: space-around;"><div><div style="border: 1px solid black; border-radius: 50%; padding: 2px;">ST</div>STEEL</div><div><div style="border: 1px solid black; border-radius: 50%; padding: 2px;">BR</div>BRASS</div><div><div style="border: 1px solid black; border-radius: 50%; padding: 2px;">HO</div>OPEN HOLE</div></div> <div style="display: flex; justify-content: space-around;"><div><div style="border: 1px solid black; border-radius: 50%; padding: 2px;">PL</div>PLASTIC</div><div><div style="border: 1px solid black; border-radius: 50%; padding: 2px;">OT</div>OTHER</div></div> <b>C2</b> 1 2 EACH SCREEN DEPTH (nearest ft.) <div style="display: flex; justify-content: space-between;"><div><div style="border: 1px solid black; width: 40px; height: 20px;"></div><div style="border: 1px solid black; width: 40px; height: 20px;"></div></div><div><div style="border: 1px solid black; width: 40px; height: 20px;"></div><div style="border: 1px solid black; width: 40px; height: 20px;"></div></div><div><div style="border: 1px solid black; width: 40px; height: 20px;"></div><div style="border: 1px solid black; width: 40px; height: 20px;"></div></div></div> <div style="display: flex; justify-content: space-between; font-size: 8pt;"><div>8 9</div><div>11 15</div><div>17 21</div></div> <div style="display: flex; justify-content: space-between; font-size: 8pt;"><div>23 24</div><div>26 30</div><div>32 36</div></div> <div style="display: flex; justify-content: space-between; font-size: 8pt;"><div>38 39</div><div>41 45</div><div>47 51</div></div> SLOT SIZE 1 2 3 DIAMETER OF SCREEN <div style="border: 1px solid black; width: 40px; height: 20px;"></div> (NEAREST INCH) <div style="display: flex; justify-content: space-between; font-size: 8pt;"><div>56</div><div>60</div></div> from to  GRAVEL PACK <div style="border: 1px solid black; width: 40px; height: 20px;"></div> IF WELL DRILLED WAS FLOWING WELL INSERT F IN BOX 68 <div style="border: 1px solid black; width: 20px; height: 20px;"></div>																
		<div style="display: flex; justify-content: space-between;"><div><b>A</b> A WELL WAS ABANDONED AND SEALED WHEN THIS WELL WAS COMPLETED <b>E</b> ELECTRIC LOG OBTAINED <b>P</b> TEST WELL CONVERTED TO PRODUCTION WELL</div><div>I HEREBY CERTIFY THAT THIS WELL HAS BEEN CONSTRUCTED IN ACCORDANCE WITH COMAR 10.17.13 "WELL CONSTRUCTION" AND IN CONFORMANCE WITH ALL CONDITIONS STATED IN THE ABOVE CAPTIONED PERMIT, AND THAT THE INFORMATION PRESENTED HEREIN IS ACCURATE AND COMPLETE TO THE BEST OF MY KNOWLEDGE.</div></div> <div>DRILLERS IDENT. NO. <span style="font-size: 18pt;">238</span></div> <div>DRILLERS SIGNATURE <span style="font-size: 18pt;">James L. May...</span> (MUST MATCH SIGNATURE ON APPLICATION)</div> <div>SITE SUPERVISOR (sign. of driller or journeyman responsible for sitework if different from permittee)</div>		<div style="display: flex; justify-content: space-between;"><div><b>T</b> (E.R.O.S.) <div style="border: 1px solid black; width: 20px; height: 20px;"></div> TELESCOPE CASING</div><div><b>WQ</b> <div style="border: 1px solid black; width: 20px; height: 20px;"></div> LOG INDICATOR</div><div><b>OTHER DATA</b> <div style="border: 1px solid black; width: 20px; height: 20px;"></div></div></div>												
<div style="display: flex; justify-content: space-between;"><div><b>OEP USE ONLY</b> (NOT TO BE FILLED IN BY DRILLER)</div><div></div></div> <div style="display: flex; justify-content: space-between;"><div><b>T</b> (E.R.O.S.) <div style="border: 1px solid black; width: 20px; height: 20px;"></div> TELESCOPE CASING</div><div><b>WQ</b> <div style="border: 1px solid black; width: 20px; height: 20px;"></div> LOG INDICATOR</div><div><b>OTHER DATA</b> <div style="border: 1px solid black; width: 20px; height: 20px;"></div></div></div>																
		<div style="display: flex; justify-content: space-between;"><div><b>C3</b> 1 2  <b>PUMPING TEST</b> HOURS PUMPED (nearest hour) <span style="font-size: 18pt;">3</span> PUMPING RATE (gal. per min. to nearest gal.) <span style="font-size: 18pt;">15</span> METHOD USED TO MEASURE PUMPING RATE <span style="font-size: 18pt;">Bucket</span> WATER LEVEL (distance from land surface) BEFORE PUMPING <span style="font-size: 18pt;">20</span> WHEN PUMPING <span style="font-size: 18pt;">20</span>  TYPE OF PUMP USED (for test) <div style="display: flex; justify-content: space-around;"><div><div style="border: 1px solid black; border-radius: 50%; padding: 2px;">A</div>air</div><div><div style="border: 1px solid black; border-radius: 50%; padding: 2px;">P</div>piston</div><div><div style="border: 1px solid black; border-radius: 50%; padding: 2px;">T</div>turbine</div></div><div style="display: flex; justify-content: space-around;"><div><div style="border: 1px solid black; border-radius: 50%; padding: 2px;">C</div>centrifugal</div><div><div style="border: 1px solid black; border-radius: 50%; padding: 2px;">R</div>rotary</div><div><div style="border: 1px solid black; border-radius: 50%; padding: 2px;">O</div>other (describe below)</div></div><div style="display: flex; justify-content: space-around;"><div><div style="border: 1px solid black; border-radius: 50%; padding: 2px;">J</div>jet</div><div><div style="border: 1px solid black; border-radius: 50%; padding: 2px;">S</div>submersible</div></div></div></div> <div style="display: flex; justify-content: space-between;"><div><b>PUMP INSTALLED</b> DRILLER WILL INSTALL PUMP YES <div style="border: 1px solid black; border-radius: 50%; padding: 2px;">NO</div> (CIRCLE) (YES or NO) IF DRILLER INSTALLS PUMP, THIS SECTION MUST BE COMPLETED FOR ALL WELLS EXCEPT HOME USE TYPE OF PUMP INSTALLED PLACE (A,C,J,P,R,S,T,O) IN BOX - SEE ABOVE: <div style="border: 1px solid black; width: 20px; height: 20px;"></div> CAPACITY: GALLONS PER MINUTE (to nearest gallon) <div style="border: 1px solid black; width: 40px; height: 20px;"></div> PUMP HORSE POWER <div style="border: 1px solid black; width: 40px; height: 20px;"></div> PUMP COLUMN LENGTH (nearest ft.) <div style="border: 1px solid black; width: 40px; height: 20px;"></div> CASING HEIGHT (circle appropriate box and enter casing height) <div style="display: flex; justify-content: space-around;"><div><div style="border: 1px solid black; border-radius: 50%; padding: 2px;">+</div>above</div><div><div style="border: 1px solid black; border-radius: 50%; padding: 2px;">-</div>below</div></div><div style="display: flex; justify-content: space-between;"><div>LAND SURFACE (nearest foot)</div><div><div style="border: 1px solid black; width: 20px; height: 20px;"></div> 50 51</div></div></div></div>														
<div style="display: flex; justify-content: space-between;"><div><b>LOCATION OF WELL ON LOT</b> SHOW PERMANENT STRUCTURE SUCH AS BUILDING, SEPTIC TANKS, AND/OR LANDMARKS AND INDICATE NOT LESS THAN TWO DISTANCES (MEASUREMENTS TO WELL)</div><div></div></div>																

Well Permit No. HO - 81-2739  
Location of property (road) SADDLEBRED CT.  
Subdivision Glenwood Springs Lot 15 Block \_\_\_\_\_ Plat \_\_\_\_\_ Sec. \_\_\_\_\_  
Well Driller V. MAHNE Owner CADMAN ASSOC.

Depth of well 245'  
Distance of measuring point (M.P.) above ground 2'  
Static water level (S.W.L.) below M.P. 20'

Time pump started 11:35 Pumping rate 1500 u.  
Total time 15 min to reach pumping water level 20 ft. below M.P.

[illegible]



# HOWARD COUNTY HEALTH DEPARTMENT

JOYCE M. BOYD, M.D., M.P.H.  
COUNTY HEALTH OFFICER



Bureau of Environmental Health  
3525 Ellicott Mills Drive  
Ellicott City, Maryland 21043

Director - 461-9956  
Water & Sewerage, Permits - 461-9933  
Community Environmental Health - 461-9944  
Technical Services - 461-9955

June 16, 1988

Carman Associates  
P. O. Box 122  
Ellicott City, Maryland 21043

RE: Glenwood Springs - Lot 15  
Well Tag Number: HO-81-2739  
Saddlebred Court

To Whom It May Concern:

At the time of the yield test on the above referenced lot, the water sample taken showed an unacceptable nitrate-nitrogen concentration (18.0 parts per million), turbidity index (11 NTU's) and above normal iron content (1.86 parts per million). These problems are potentially correctable with the use of treatment filters.

Approval of this water supply at the time of sampling for use and occupancy will depend on the installation of a nitrate removal system and an iron removal device. Both of these devices should bring the water supply into compliance with the State Regulations.

The nitrate-nitrogen level was present at a concentration of 18.0 parts per million (See Enclosure). COMAR 10.17.13.09 prohibits approval of any water supply with a nitrate-nitrogen contaminant level in excess of 10 parts per million.

This department will grant a Permanent Deviation from that regulation if a nitrate removal device is installed that effectively maintains the nitrate-nitrogen contaminant level below the 10 parts per million requirements. Once this device is installed, it will be necessary for you to comply with the following conditions before a Final Certificate of Potability can be issued:

1. Within six months, you must have your water re-tested to insure that the installed nitrate removal system is operating properly. Thereafter, a yearly nitrate analysis is recommended.
2. There must be a continuing service contract with a plumbing contractor or water treatment service company to maintain the efficiency of the nitrate removal device. You must supply this department with a copy of that contract.

June 14, 1988

3. If in the future, you decide to sell or rent your home, you must make any potential buyer/tenant aware of the above condition.

If the above conditions are not improved by the installation of these treatment devices, then reconstruction or replacement of the well will be required.

If you have any questions relative to this matter, please call me at 461-9933.

Very truly yours,

*Jane E. Nadeau*  
Jane Nadeau, Sanitarian  
Water and Sewerage Program

JN:JR

Enclosure

cc: Mr. Joseph Mayne