

PERMIT

04-346734

P 511089

SEWAGE DISPOSAL SYSTEM

A 38376

DEPARTMENT OF HEALTH AND MENTAL HYGIENE

DISTRICT 4th

HOWARD COUNTY HEALTH DEPARTMENT

DATE 11/5/98

BUREAU OF ENVIRONMENTAL HEALTH

DATE SYSTEM APPROVED 12/11/98

~~XXXXXX~~ 410-313-2640

INSPECTOR KM

INDEXED

C & C Utility Service

IS PERMITTED TO INSTALL ☒ ALTER ☐

ADDRESS 7398 Gaither Road Sykesville, MD 21784 PHONE (410) 549-4987

SUBDIVISION Glenwood Springs LOT 28 ROAD 2827 Shadow Roll Court

PROPERTY OWNER Michael C. Preece

ADDRESS

SEPTIC TANK CAPACITY 1000 GALLONS

NUMBER OF BEDROOMS 3

180 SQUARE FEET PER BEDROOM

LINEAR FEET OF TRENCH REQUIRED 180

TRENCHES - Trench to be 3 feet wide. Inlet 3 feet below original grade. Bottom maximum depth 5 feet below original grade. Effective area begins at 3 feet below original grade. 2 feet of stone below distribution pipe.

LOCATION - Start the first trench 240 feet down the right (678.34') lot line and 115 feet off the right line as seen when facing property from Shadow Roll Court. Run trenches along contour in both directions.

NOTES - No trench to exceed 100 feet in length. Provide 6" - 8" diameter cleanout and cap to grade or above on septic tank. OK 7/29/98 JCS

PLANS APPROVED BY Bert Nixon/Kim Maiste

REVISED

DATE 7/23/98

COVER NO WORK UNTIL INSPECTED AND APPROVED

NEITHER THE HOWARD COUNTY COUNCIL NOR THE HEALTH DEPARTMENT IS RESPONSIBLE FOR THE SUCCESSFUL OPERATION OF ANY SYSTEM

NOTE: CLEANOUT REQUIRED EVERY 70 FEET OF SEWER LINE AND/OR AT 90° SWEEPS IN LINES FROM HOUSE TO DRAIN FIELDS, 90° ELBOWS NOT ACCEPTABLE.

NOTE: ALL PARTS OF SEPTIC SYSTEMS (I.E. TANK, DISTRIBUTION BOX TRENCHES) TO BE 100 FEET FROM WELL (UNLESS OTHERWISE SPECIFICALLY AUTHORIZED)

NOTE: IF DEEP TRENCH(ES) ARE USED CALL FOR INSPECTION BEFORE AND AFTER PLACING GRAVEL IN TRENCH(ES)

NOTE: NO DRY WELL SHALL EXCEED 15 FOOT IN DIAMETER NO ABSORPTION TRENCH TO EXCEED 100 FEET IN LENGTH

NOTE: ALL PIPE FROM HOUSE TO SEPTIC TANK MUST BE CAST IRON OR SCHEDULE 35/40 PVC OR ABS

PERMIT VOID AFTER TWO YEARS

NOTE: INSTALL STAND PIPE ON SEPTIC TANK AND DRY WELL STAND PIPES MUST BE 6 INCHES IN DIAMETER CAST IRON, CONCRETE OR TERRA COTTA OR PVA OR ABS ACCEPTED. IF TOP OF SEPTIC TANK IS DEEPER THAN 3 FEET, MANHOLE TO GRADE REQUIRED.

NOTE: DISTRIBUTION BOXES MUST HAVE BAFFLES


*INSTALLER IS RESPONSIBLE FOR OBTAINING FINAL APPROVAL ON THIS PERMIT

HD-260(5-90)

*CALL 461-9933 FOR INSPECTION OF SEPTIC SYSTEM.

A 38376

* solid pipe installed in shaded blue area due to rock outcrop encountered in trench. (KM)

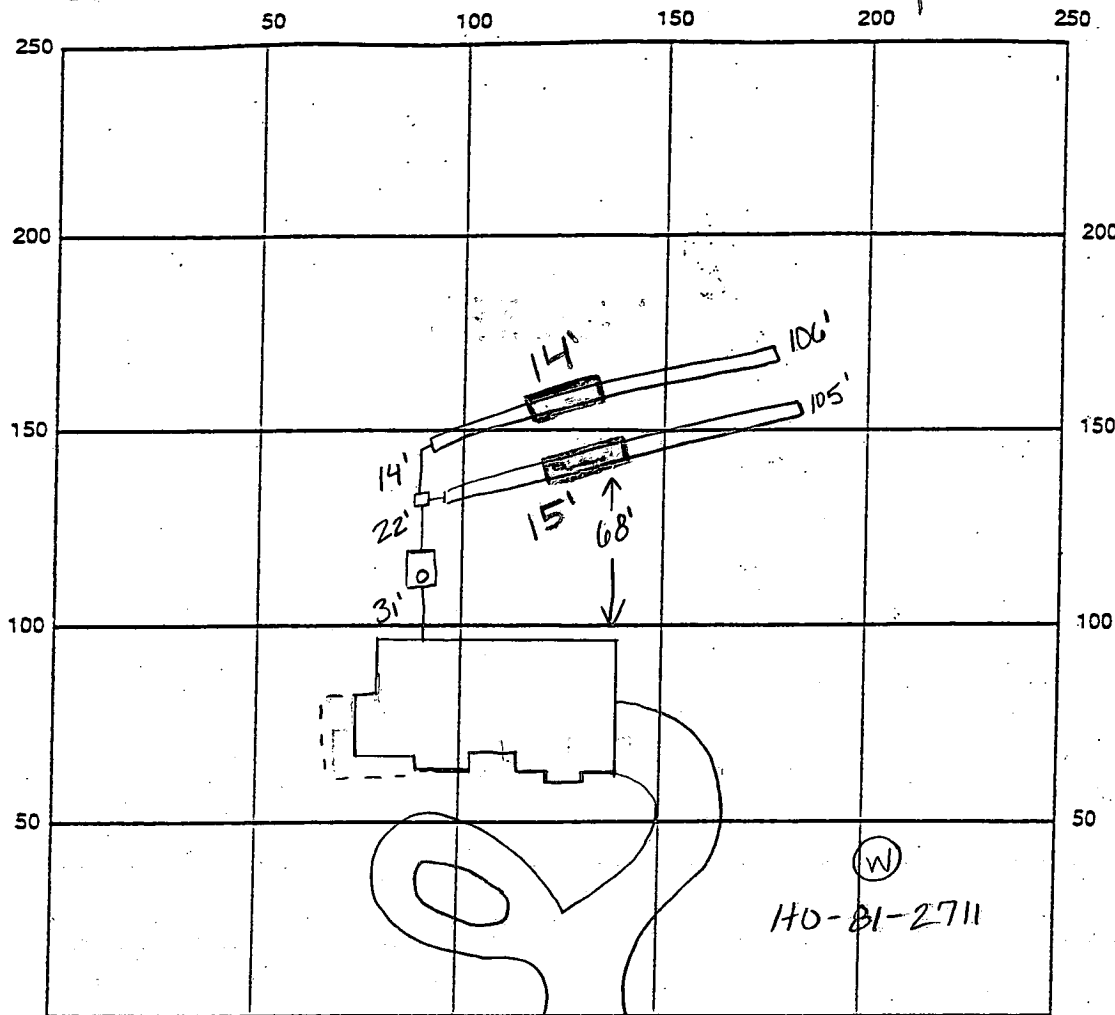

INDICATE NORTH - NAME ADJOINING ROADWAY AS BASE LINE

SEPTIC TANK LEVEL OK, 1000 gallons CLEANOUTS 1 on tank
 DISTRIBUTION BOX LEVEL OK, has baffle
 DRAIN FIELD/TITLE DEPTH 5 FT. TRENCH WIDTH 3 FT. INLET DEPTH 3 FT.
 EFFECTIVE GRAVEL DEPTH 2 FT. TOTAL LENGTH 1 x 105 FT. 1 x 106 FT. → 211' - 29' solid pipe = 182'
 NUMBER OF TRENCHES 2 ONE SIDEWALL/BOTTOM AREA 546 SQ. FT.
 DRYWALL INSIDE DIAMETER FT. EFFECTIVE DEPTH BELOW INLET FT.
 ABSORBENT AREA SQ. FT.

REMARKS: 12/10/98 met contractor at site, rock was hit in middle area of 1st trench.
Solid pipe will be used through rock portion of trench and trench will be extended
to make up lost area (KM)
12/11/98 OK to cover all work (KM)
WPTI-OK to cover well line P.A. 3.5' below grade, casing 8" above grade,
line sleeved out of house, contractor will put on 2pc cap and electrical conduit (KM)

DATE SYSTEM APPROVED 12/11/98

INSPECTOR

Kimberly Maisto

APPLICATION

PERCOLATION TESTING

A 38376

P _____

HOWARD COUNTY HEALTH DEPARTMENT
BUREAU OF ENVIRONMENTAL HEALTH

P.O. BOX 476 ELLICOTT CITY, MARYLAND 21043
TELEPHONE: 461-9933

DISTRICT _____

DATE 10-14-86

*1/25/87
perc OK'd pending
approved plans*

TO: THE COUNTY HEALTH OFFICER
ELLICOTT CITY, MARYLAND

I, HEREBY, APPLY FOR THE NECESSARY TEST IN ORDER TO CONSTRUCT (OR RECONSTRUCT) A SEWAGE DISPOSAL SYSTEM.

PROPERTY OWNER MICHAEL C. PREECE

ADDRESS _____ PHONE _____

PROSPECTIVE BUYER Ronald Carter

ADDRESS 8388 Court Ave., Ellicott City, Md. 21043 PHONE 461-2855

PROPERTY LOCATION:

SUBDIVISION Hakes Property LOT NO. Twenty Eight

ROAD AND DESCRIPTION 2827 Shadow Roll Court
Hobbs Road *Revised 4/29/87*

TAX MAP 14 PARCEL # 87,83,202

SIZE OF LOT 3+ ACRES TYPE BLDG. SFD + 3 Bm
(SINGLE FAMILY DWELLING OR COMMERCIAL)

BLDG. PERMIT SIGNED

AND RETURNED 7-23-98
Small Bldg 1/28/85

THE SYSTEM INSTALLED UNDER THIS APPLICATION IS ACCEPTABLE ONLY UNTIL PUBLIC FACILITIES BECOME AVAILABLE. I FULLY UNDERSTAND THE FEE CONNECTED WITH THE FILING OF THIS PERC TEST APPLICATION IS NON-REFUNDABLE UNDER ANY CIRCUMSTANCES. I ALSO AGREE TO COMPLY WITH ALL M.O.S.H.A. REQUIREMENTS IN TESTING THIS LOT.

Ronald D. Carter
(SIGNATURE OF APPLICANT)

APPROVED BY _____ FOR _____ DATE _____

REJECTED BY _____ FOR _____ DATE _____

HOLD PENDING FURTHER TESTS _____ DATE _____

REASONS FOR REJECTION OR HOLDING for field located holes & sub-plat

THIS IS NOT A PERMIT

SOIL PROFILE

0'

INDICATE NORTH - NAME ADJOINING ROADWAY AS BASE LINE

DATE	TEST NO.	DEPTH	PRE-WET		TEST - 1" DROP		TIME
			START	STOP	START	STOP	

REMARKS _____

TYPE OF SOIL _____

TESTED BY _____ ALSO PRESENT _____

APPLICATION

PERCOLATION TESTING

HOWARD COUNTY HEALTH DEPARTMENT
BUREAU OF ENVIRONMENTAL HEALTH
P.O. BOX 476 ELLICOTT CITY, MARYLAND 21043
TELEPHONE: 461-9933

A _____

P _____

DISTRICT _____

DATE _____

TO: THE COUNTY HEALTH OFFICER,
ELLICOTT CITY, MARYLAND

I, HEREBY, APPLY FOR THE NECESSARY TEST IN ORDER TO CONSTRUCT (OR RECONSTRUCT) A SEWAGE DISPOSAL SYSTEM.

PROPERTY OWNER _____

ADDRESS _____ PHONE _____

PROSPECTIVE BUYER _____

ADDRESS _____ PHONE _____

PROPERTY LOCATION:

SUBDIVISION _____ LOT NO. 28

ROAD AND DESCRIPTION _____

TAX MAP _____ PARCEL # _____

SIZE OF LOT _____ TYPE BLDG. _____
(SINGLE FAMILY DWELLING OR COMMERCIAL)

THE SYSTEM INSTALLED UNDER THIS APPLICATION IS ACCEPTABLE ONLY UNTIL PUBLIC FACILITIES BECOME AVAILABLE. I FULLY UNDERSTAND THE
FEE CONNECTED WITH THE FILING OF THIS PERC TEST APPLICATION IS NON-REFUNDABLE UNDER ANY CIRCUMSTANCES. I ALSO AGREE TO COMPLY
WITH ALL M.O.S.H.A. REQUIREMENTS IN TESTING THIS LOT. _____

(SIGNATURE OF APPLICANT)

APPROVED BY _____ FOR _____ DATE _____

REJECTED BY _____ FOR _____ DATE _____

HOLD PENDING FURTHER TESTS _____ DATE _____

REASONS FOR REJECTION OR HOLDING _____

THIS IS NOT A PERMIT

LOT EXTENDS BACK

42
58


17
34
23

prop corner

SOIL PROFILE

①
brown/orange
clay 3'
to clay
brown 2'
to orange
tan
silty
mic
loam 1/2'
12' D

③

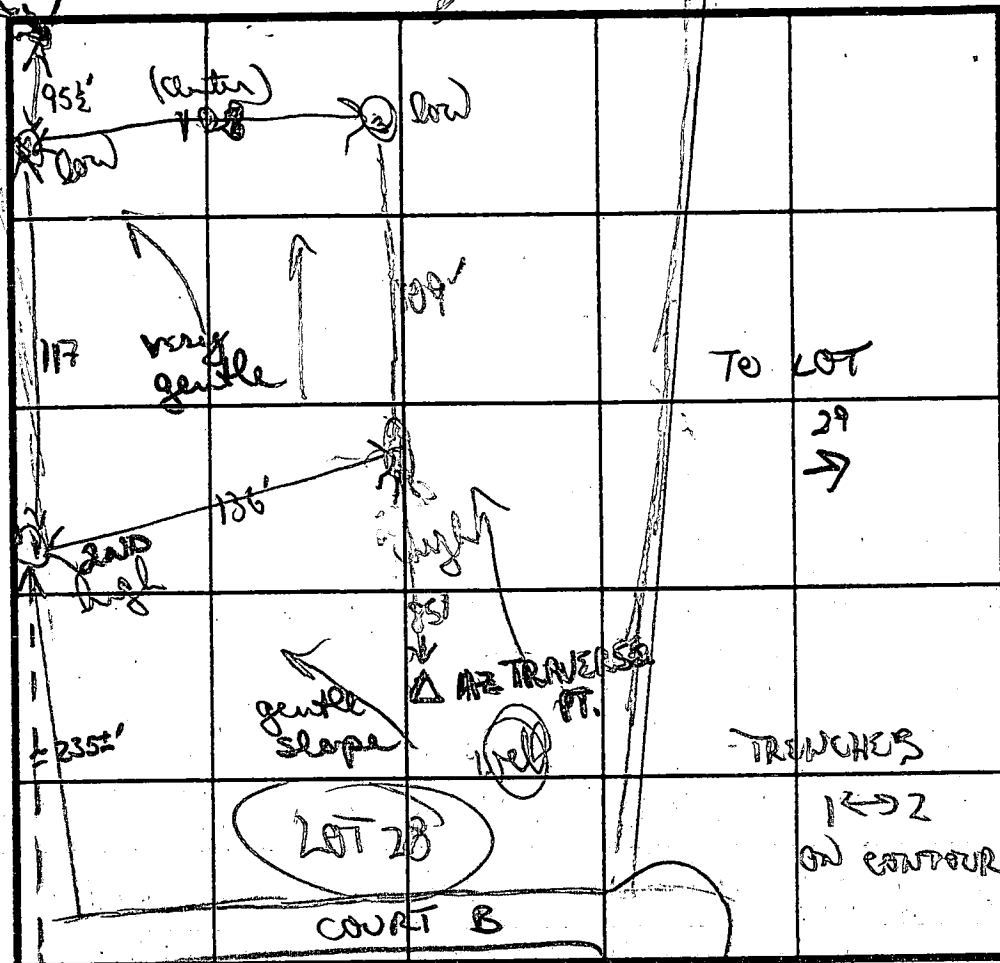

②
brown/orange
clay loam 2'
to tan/brown
silty mic
loam

11 1/2' D

INLET 4'
MAX D 6'
X ≈ 4 MIN

180°/B/D

DATE	TEST NO.	DEPTH	PRE-WET		TEST - 1" DROP		TIME
			START	STOP	START	STOP	
12/1/87	①	4 1/2 S	243	245	245	250	5 MIN
		4 1/2 M	243	245	245	248	3 MIN
		11' D	bottom (see profile)				
	②	4' S	219	221	221	224	3 MIN
		11 1/2' D	bottom (see profile)				
	③	4' S	227	231	231	235	7 MIN
		8' M	227	231	231	236	5 MIN
		12' D	bottom (see profile)				
	④	4 1/2 S	302	303	303	305	2 MIN
		11 1/2' D	bottom (see profile)				

REMARKS

common holes 1 & 2 w/ lot 27

TYPE OF SOIL

orange/brown clay/clay loam 3-4'; orange/tan brown silty mic

TESTED BY

B Nixen

ALSO PRESENT

Phil Cliff Kathy

brown chunky
gitty clay
sand loam 3 1/2'

to purple/
brown powder
silty loam

11' D

④

orange/brown
clay loam 3'

to brown/
orange
silty loam
w/ scattered
small root
fragments 11 1/2' D

3.983 尺±

SCALE: 1" = 60' 0"

MICHAEL & LARA FREECE
3375 FLORENCE BL
WOODBINE IL 61777

410-372-

410-489-7559

BASEMENT ELEV.: 595
1ST FLOOR ELEV.: 601.5
INVERT OUT OF HOUSE: 594.5
INVERT INTO SEPTIC: 593.0
INVERT OUT OF SEPTIC: 592.7

INVERT INTO DIST. BOX: 590.0
INVERT INTO TRENCHES: 590.0

EXISTING GRADE AT SEPTIC: 594
EXIST. GRADE AT DIST. BOX: 594
EXIST. GRADE AT TRENCHES: 594
ELEV. OF WELL AT GRADE: 604

Approved Septic System Plan
Howard County Health Department


Kimberly Maisto 7.28.97
Signature Date


Total linear feet of trench
required 180 feet

Width of trench(es) 3 feet.

Depth of trench(es) 5 feet

Depth of stone required below
distribution pipe 2 feet

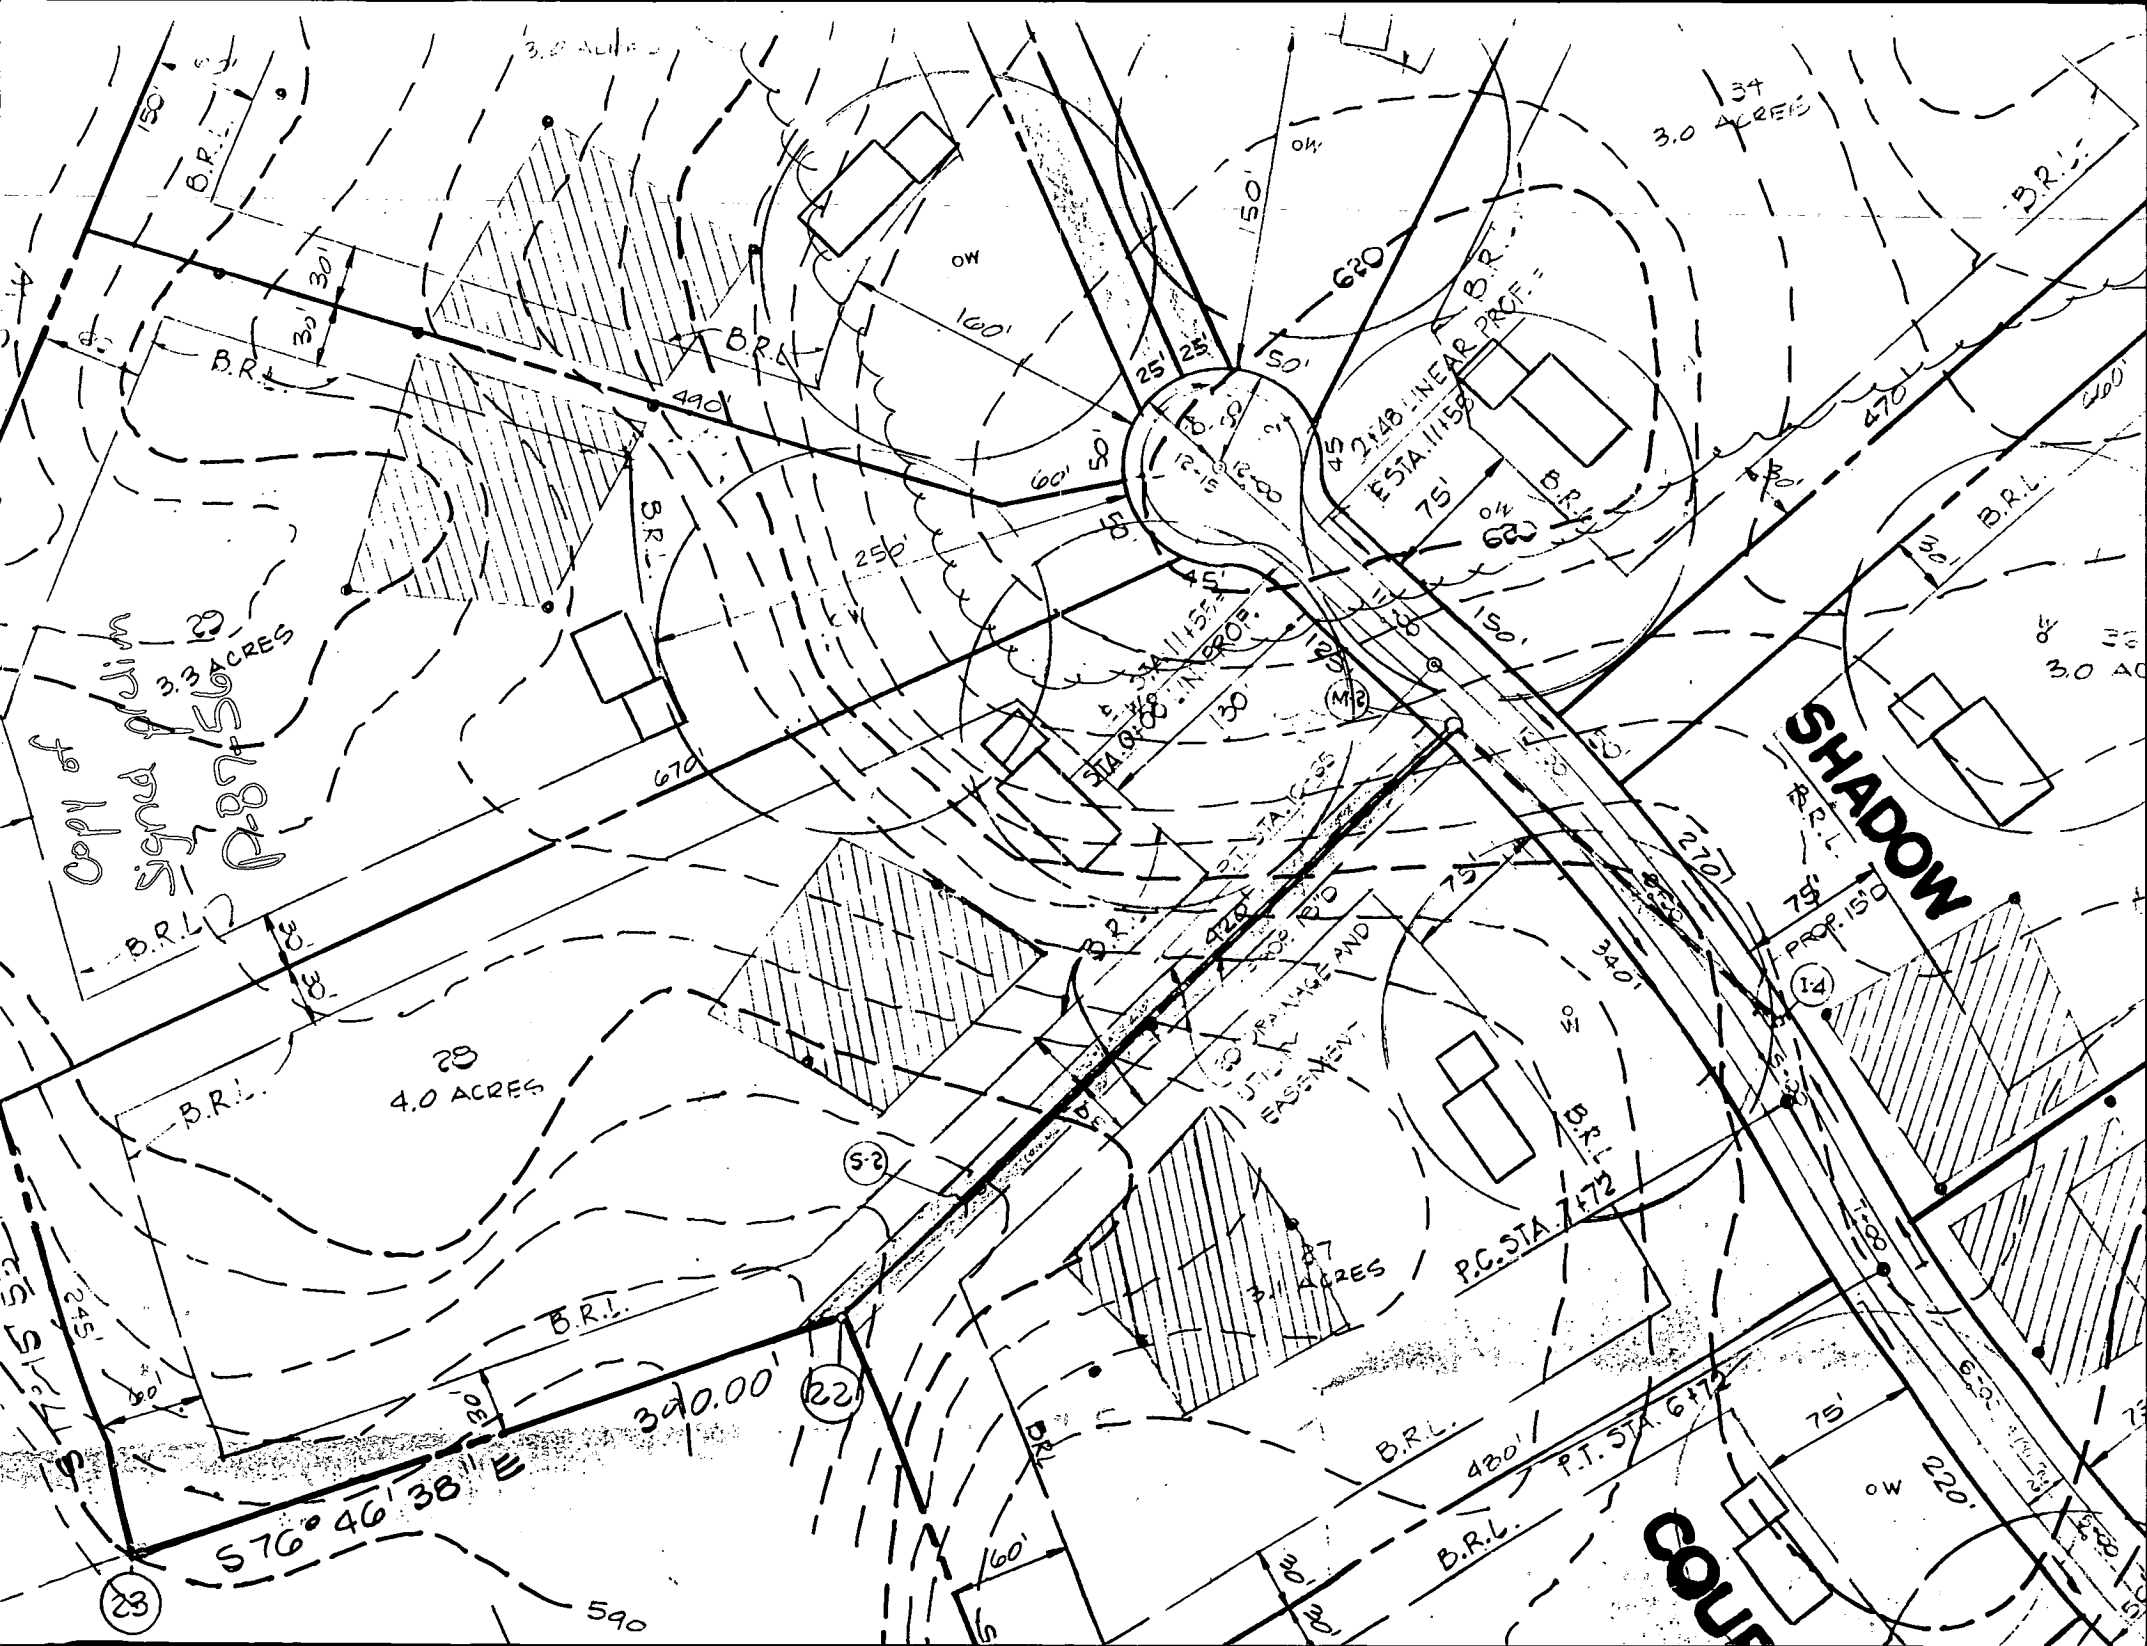

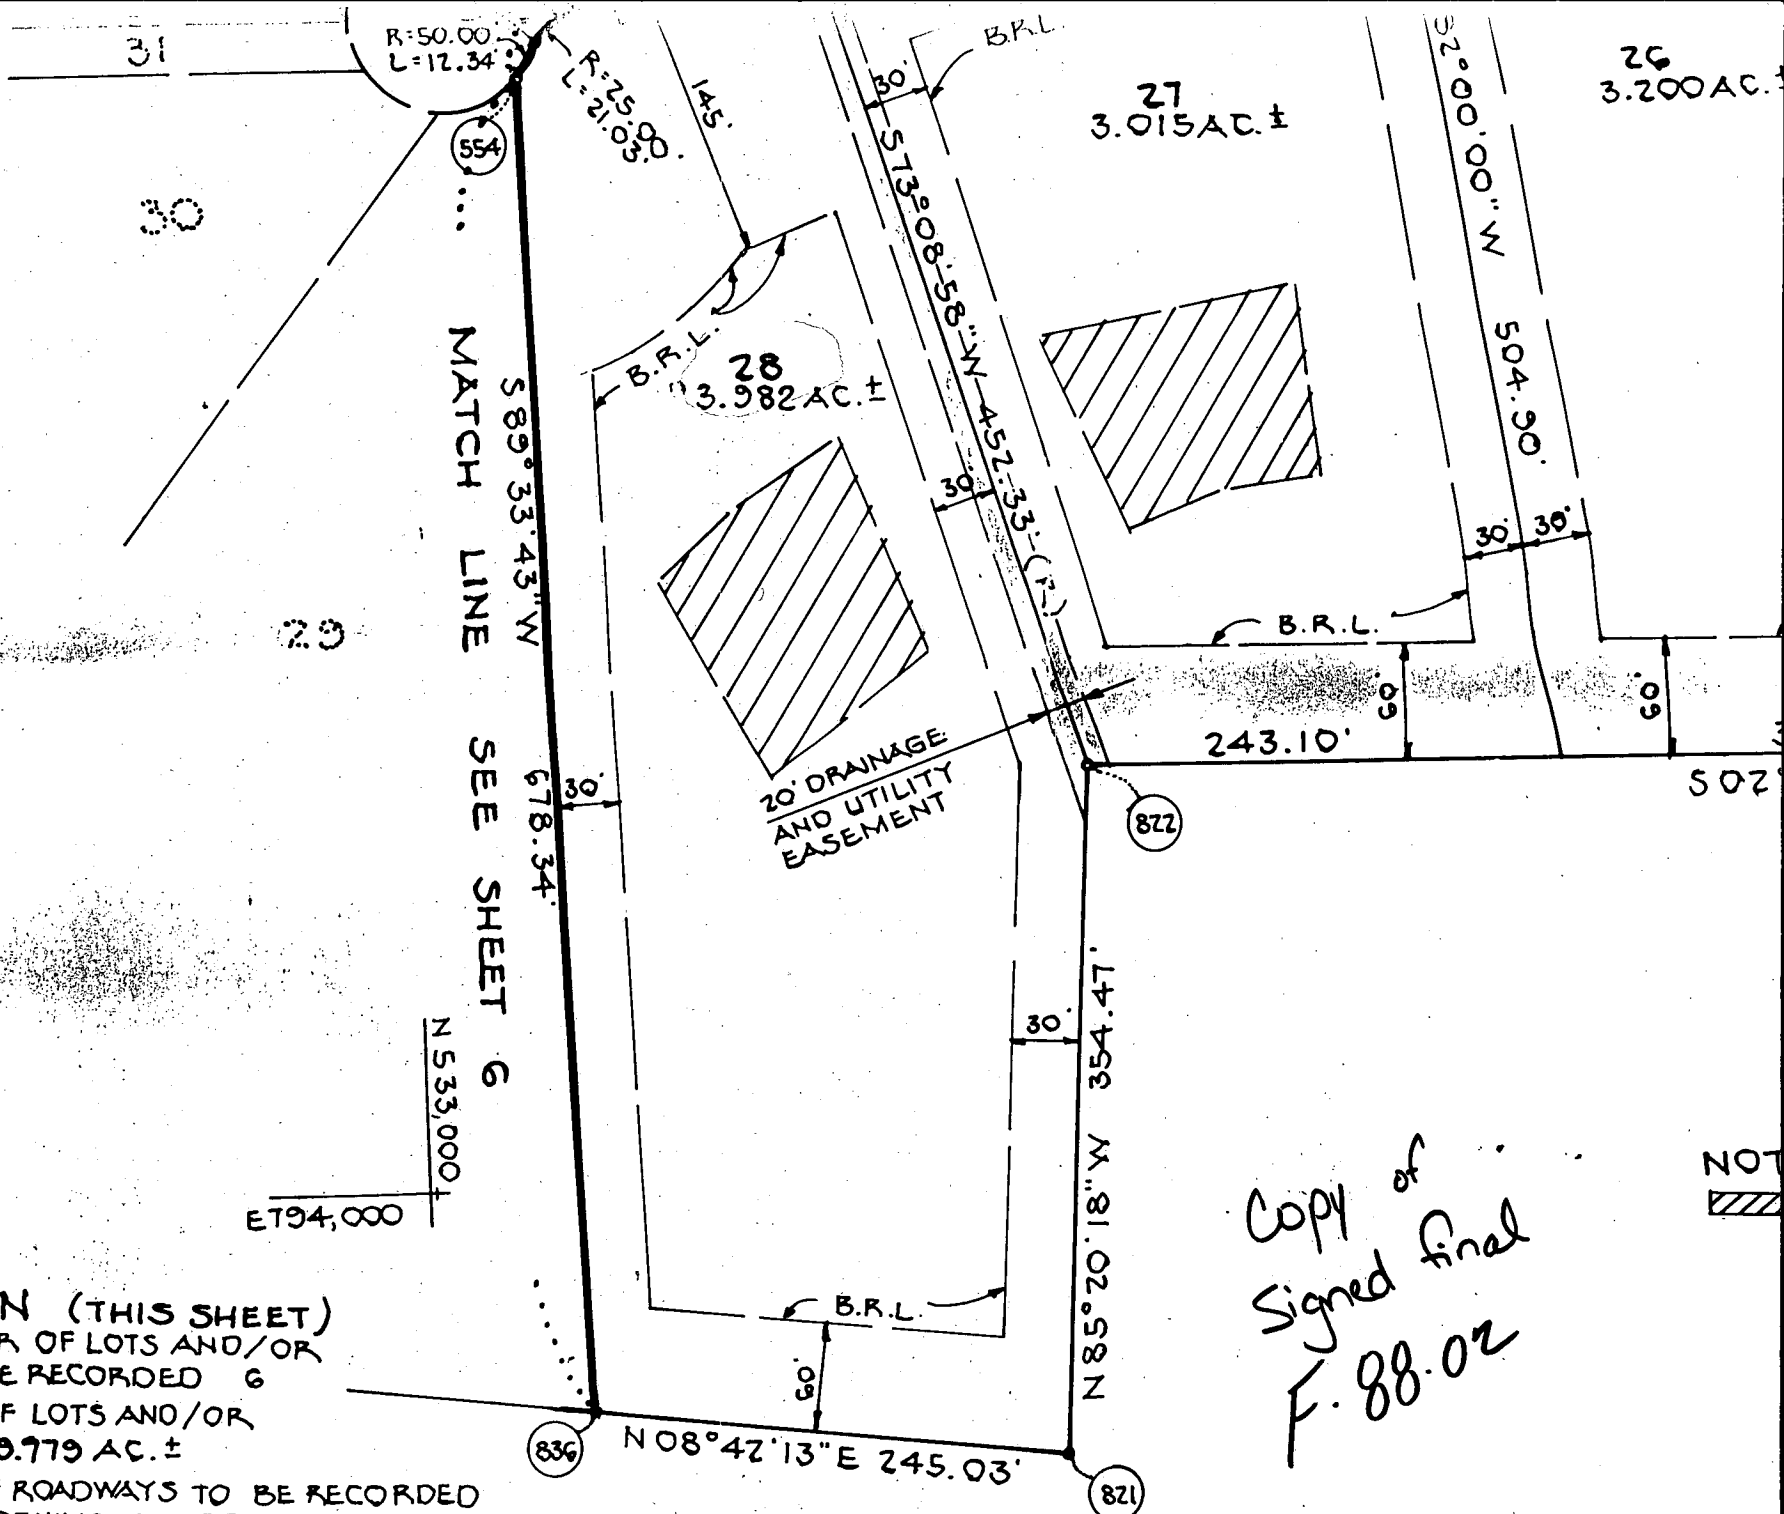

TABULATION (THIS SHEET)

1. TOTAL NUMBER OF LOTS AND/OR PARCELS TO BE RECORDED 6
2. TOTAL AREA OF LOTS AND/OR PARCELS = 19.779 AC. ±
3. TOTAL AREA OF ROADWAYS TO BE RECORDED INCLUDING WIDENING STRIPS = 0.00 ACRES
4. TOTAL AREA OF SUBDIVISION TO BE RECORDED = 19.779 AC. ±

APPROVED: FOR PRIVATE WATER AND PRIVATE SEWERAGE

OWNER'S CERTIFICATE:

Page 1 of 1
Date 5/3/88

Review 8/10/88 R/H

FIELD DATA SHEET
HOWARD COUNTY WELL YIELD TEST

Well Permit No. HO - 81-2761
Location of property (road) Shawnee Hall Ct.
Subdivision Oakwood Acres Lot 28 Block Plat Sec.
Well Driller Joseph M. Byrne Owner Nick Campanile

Depth of well 305'
Distance of measuring point (M.P.) above ground 1'
Static water level (S.W.L.) below M.P. 37'

I. High rate pumping -- reservoir drawdown

Time pump started 12:00 Pumping rate 20 gpm.
Total time 30 min. to reach pumping water level 205' ft. below M.P.

II. Recovery pump test data - observations to be recorded every 15 minutes

TIME (in 15 minute intervals)	WATER LEVEL below M.P.	PUMPING RATE time to fill 5 gallon bucket	FLOW METER READING (if used)	CALCULATED FLOW (gallons per minute)
12:15	125'	3 sec.		20
12:30	205'	4 sec.		15
12:45	205'	20 sec.		3
1:00	205'	20		3
1:15	205'	20		3
1:30	205'	20		3
1:45	205'	20		3
2:00	205'	20		3
2:15	205'	20		3
2:30	205'	20		3
2:45	205'	20		3
3:00	205'	20		3
3:15	205'	20		3
3:30	205'	20		3
3:45	205'	20		3
4:00	205'	20		3
4:15	205'	20		3
4:30	205'	20		3
4:45	205'	20		3
5:00	205'	20		3
5:15	205'	20		3
5:30	205'	20		3
5:45	205'	20		3
6:00	205'	20		3

HD-224 6:15 205' 20
6:30 205' 20

B 1 5623 (THIS NUMBER IS TO BE PUNCHED IN COLS. 3-6 ON ALL CARDS)	SEQUENCE NO. (DP USE ONLY)	STATE OF MARYLAND PERMIT TO DRILL WELL please print or type	STATE PERMIT NUMBER HO-81-2711 fill in this form completely
Date Received (APA) 042788		B 3 LOCATION OF WELL	
OWNER INFORMATION 15- Last Name CAMPANILE Owner 34 First Name NICK 36 Street or RFD 3375 FLORENCE RD. 55 57 Town WOODBINE 70 State 72 MD 74 Zip 21797 76		8 COUNTY HOWARD 21 23 SUBDIVISION OLENWOOD SPRINGS 42 SECTION 44 46 LOT 28 48 50 52 NEAREST TOWN OLENWOOD 71 MILES FROM TOWN (enter 0 if in town) 2 73 76 77 78 M. I.	
DRILLER INFORMATION Driller's Name Joseph L. Wagner 77 License No: 80 Firm Name Joseph L. Wagner Well Drilling Address 5512 Ridge Rd. Mt. Airy 21771 Signature Joseph L. Wagner Date 4/26/88		B 4 DIRECTION OF WELL FROM TOWN (CIRCLE BOX) 11 NEAR WHAT ROAD Shadow Rock Ct. 30 ON WHICH SIDE OF ROAD (CIRCLE APPROPRIATE BOX) NORTH ☒ N ☐ NE ☐ E ☐ SE ☐ S ☐ SW ☐ W ☐ NW SOUTH 34 DISTANCE FROM ROAD 130 37 ENTER FT or MI F 7 38 39	
B 2 WELL INFORMATION APPROX. PUMPING RATE (GAL. PER MIN.) 5 8 12 AVERAGE DAILY QUANTITY NEEDED (GAL. PER DAY) 500 14 20		NOT TO BE FILLED IN BY DRILLER HEALTH DEPARTMENT APPROVAL HOWARD COUNTY NAME A 38376 COUNTY NO. STATE SIGNATURE _____ INSERT S ☐ 41 DATE ISSUED 050388 43 48 CO-SIGNATURE R. N. Wilson 49 EXP. DATE 11/03/88 NORTH GRID 532000 50 55 EAST GRID 0795000 57 63	
USE FOR WATER (CIRCLE APPROPRIATE BOX) ☒ D HOME (SINGLE OR DOUBLE HOUSEHOLD UNIT ONLY) ☐ F FARMING (LIVESTOCK WATERING & AGRICULTURAL IRRIGATION) ☐ I INDUSTRIAL, COMMERCIAL, STATE AND FEDERAL GOV. OTHER (REQUIRES APPROPRIATION PERMIT) ☐ P PUBLIC OR PRIVATE WATER COMPANY (REQUIRES APPROPRIATION PERMIT AND STATE HEALTH DEPARTMENT APPROVAL) ☐ T TEST, OBSERVATION, MONITORING (MAY REQUIRE APPROPRIATION PERMIT)		SHOW MAJOR FEATURES OF BOX & LOCATE WELL WITH AN X SOURCES OF DRILLING WATER 1. WELL 2. 3. WRITE THE BOX NUMBER FROM THE MAP HERE E 19A 5 N 53A 2 → 5/3/88 locations per staked 39' pipe (1") 34' open hole 10 bags cement 120 sample taken	
APPROXIMATE DEPTH OF WELL 200 24 28 FEET APPROXIMATE DIAMETER OF WELL 6 NEAREST INCH		DRAW A SKETCH BELOW SHOWING LOCATION OF WELL IN RELATION TO NEARBY TOWNS AND ROADS AND GIVE DISTANCE FROM WELL TO NEAREST ROAD JUNCTION 	
METHOD OF DRILLING (circle one) BORED (or Augered) ☒ JETTED ☐ Jetted & DRIVEN ☐ 30. AIR-ROTary ☒ AIR-PERCussion ☐ ROTARY (Hydraulic Rotary) ☐ 37. CABLE ☐ REVERSE-ROTary ☐ Drive-POINT ☐ other _____		REPLACEMENT OR DEEPENED WELLS (CIRCLE APPROPRIATE BOX) ☒ N THIS WELL WILL NOT REPLACE AN EXISTING WELL ☐ Y THIS WELL WILL REPLACE A WELL THAT WILL BE ABANDONED AND SEALED 39. ☐ S THIS WELL WILL REPLACE A WELL THAT WILL BE USED AS A STANDBY ☐ D THIS WELL WILL DEEPEN AN EXISTING WELL PERMIT NUMBER OF WELL TO BE REPLACED OR DEEPENED (IF AVAILABLE) 41: _____ 52	
Not to be filled in by driller (OEP USE ONLY) APPROP. PERMIT NUMBER _____ 54 GAP _____ 63 FORCE AW WRITE INITIALS IN BOX PERMIT NO. HO-81-2711 67 68 70 71 72 73 74 75 76 77 78 79		SPECIAL CONDITIONS	

HOWARD COUNTY HEALTH DEPARTMENT
Bureau of Environmental Health
3525-H Ellicott Mills Drive
Ellicott City, MD 21043

Fax 410-313-2648

~~461-0000~~
410-313-2640

APPLICATION FOR PITLESS ADAPTER, WELL PUMP AND PRESSURE TANK INSTALLATION

New Installation ☒
Replacement ☐

Receipt # _____
Date _____

Name of Installer Charles W. Small Inc

Telephone 301-926-7464

License Number 1890

Certified Well Pump Installer _____ Well Driller _____

Registered Plumber ☒

Name of Property Owner Michael Preece

Telephone 410-388-6382

Subdivision Glenwood Springs Lot # 28

Well Tag # HO-BI-2911

Site Address 2827 Shadow Roll Court

Pump

1. Type

- a. Deep well jet _____
b. Shallow well jet _____
c. Submersible ☒

2. Make Jacuzzi

3. Model # T754712P32

4. Capacity 5 GPM

5. Pump exceeds well capacity Yes ☒ No ☐

6. If Yes, is low pressure cutoff switch installed? Yes ☐ No ☒

7. What methods are used to protect the pump and electrical wiring from vibrations? Torque arrestors ☒ Cable guards ☒ Other _____

Motor

1. Horsepower 3/4

2. RPM _____

3. Voltage _____

a. 110 _____

b. 220 ☒

Pitless Adapter

1. Make MARTINSON

2. Model # B10X

3. Depth 42"

Tank

1. Capacity 82 gal Bladder

2. Pressure relief valve? yes

Piping

1. Type Poly

2. Size 1"

3. NSF and/or BOCA

Code approved yes

4. Depth of supply

line 42"

Well data

1. Depth 305 ft.

2. Yield 5 GPM

3. Static water

level 37 ft.

4. Will water supply

be disinfected by

installer? yes

I understand that it is my responsibility to notify the Howard County Health Department when the installation is ready for inspection (otherwise this permit is null and void).

All information given above is true to the best of my knowledge.

Signature of Applicant: Charles W. Small Jr.

Date: 9/24/97

Note: A sticker indicating approval/status of the installation will be placed on the well casing at the time of the inspection.