

PERMIT

SEWAGE DISPOSAL SYSTEM

DEPARTMENT OF HEALTH AND MENTAL HYGIENE

P 47280
38379
A REPAIR

DISTRICT 4th

DATE 7/8/91

DATE SYSTEM APPROVED 9/11/91

INSPECTOR R/L

HOWARD COUNTY HEALTH DEPARTMENT
BUREAU OF ENVIRONMENTAL HEALTH
461-9933

INDEXED

Paul Friedman

IS PERMITTED TO INSTALL ☒ ALTER ☐

ADDRESS 12617 Washington Ave., Rockville, Maryland 20847 PHONE

SUBDIVISION Glenwood Springs LOT 31 ROAD 2846 Shadow Roll Court

PROPERTY OWNER Mr. & Mrs. Matthew M. Dillon

ADDRESS

SEPTIC TANK CAPACITY 1250 GALLONS

NUMBER OF BEDROOMS 4

190 SQUARE FEET PER BEDROOM

LINEAR FEET OF TRENCH REQUIRED 253

REPAIR - New home under construction; to adjust septic system location due to change in plumbed elevation.

Trenches 190 sq ft per bedroom Trench to be 3 FT wet
Inlet 4 FT below original grade Effective Depth
at 4 ft below original grade 2 FT stone below distribution pipe
Location Place the box 150 FT from the existing well

PLANS APPROVED BY Craig Williams cm DATE 7/8/91

COVER NO WORK UNTIL INSPECTED AND APPROVED and 25 FT FROM THE GARAGE RUN THE TRENCHES TOWARD THE BACK

NEITHER THE HOWARD COUNTY COUNCIL NOR THE HEALTH DEPARTMENT IS RESPONSIBLE FOR THE SUCCESSFUL OPERATION OF ANY SYSTEM

NOTE: CLEANOUT REQUIRED EVERY 70 FEET OF SEWER LINE AND/OR AT 90° SWEEPS IN LINES FROM HOUSE TO DRAIN FIELDS, 90° ELBOWS NOT ACCEPTABLE. REVISED LOCATION AFTER RETEST

NOTE: ALL PARTS OF SEPTIC SYSTEMS (I.E. TANK, DISTRIBUTION BOX TRENCHES) TO BE 100 FEET FROM WELL (UNLESS OTHERWISE SPECIFICALLY AUTHORIZED)

NOTE: IF DEEP TRENCH(ES) ARE USED CALL FOR INSPECTION BEFORE AND AFTER PLACING GRAVEL IN TRENCH(ES)

NOTE: NO DRY WELL SHALL EXCEED 15 FOOT IN DIAMETER NO ABSORPTION TRENCH TO EXCEED 100 FEET IN LENGTH

NOTE: ALL PIPE FROM HOUSE TO SEPTIC TANK MUST BE CAST IRON OR SCHEDULE 35/40 PVC OR ABS

PERMIT VOID AFTER TWO YEARS

NOTE: INSTALL STAND PIPE ON SEPTIC TANK AND DRY WELL STAND PIPES MUST BE 6 INCHES IN DIAMETER CAST IRON. CONCRETE OR TERRA COTTA OR PVA OR ABS ACCEPTED. IF TOP OF SEPTIC TANK IS DEEPER THAN 3 FEET. MANHOLE TO GRADE REQUIRED.

NOTE: DISTRIBUTION BOXES MUST HAVE BAFFLES

*INSTALLER IS RESPONSIBLE FOR OBTAINING FINAL APPROVAL ON THIS PERMIT

*CALL 461-9933 FOR INSPECTION OF SEPTIC SYSTEM.

APPLICATION

PERCOLATION TESTING

A 38379

P _____

HOWARD COUNTY HEALTH DEPARTMENT
BUREAU OF ENVIRONMENTAL HEALTH

P.O. BOX 476 ELLICOTT CITY, MARYLAND 21043
TELEPHONE: 461-9933

DISTRICT _____

DATE 10-14-86

TO: THE COUNTY HEALTH OFFICER
ELLICOTT CITY, MARYLAND

I, HEREBY, APPLY FOR THE NECESSARY TEST IN ORDER TO CONSTRUCT (OR RECONSTRUCT) A SEWAGE DISPOSAL SYSTEM.

PROPERTY OWNER Mr. + Mrs. Matthew M. Dillon

ADDRESS _____ PHONE Fax # also (call first) 570-4400

PROSPECTIVE BUYER Ronald Carter

ADDRESS 8388 Court Ave., Ellicott City, Md PHONE 21043 461-2855

PROPERTY LOCATION: GLENWOOD SPRINGS

SUBDIVISION Hakes Property LOT NO. Thirty ONE

ROAD AND DESCRIPTION Hobbs Road (2846 Shadow Roll Ct) Permit on 7/29/87

TAX MAP 14 PARCEL # 87,83,202

SIZE OF LOT 3+ ACRES TYPE BLDG. SFD
(SINGLE FAMILY DWELLING OR COMMERCIAL)

THE SYSTEM INSTALLED UNDER THIS APPLICATION IS ACCEPTABLE ONLY UNTIL PUBLIC FACILITIES BECOME AVAILABLE. I FULLY UNDERSTAND THE
FEE CONNECTED WITH THE FILING OF THIS PERC TEST APPLICATION IS NON-REFUNDABLE UNDER ANY CIRCUMSTANCES. I ALSO AGREE TO COMPLY
WITH ALL M.O.S.H.A. REQUIREMENTS IN TESTING THIS LOT.

Ronald S. Carter
(SIGNATURE OF APPLICANT)

APPROVED BY _____ FOR _____ DATE _____

REJECTED BY _____ FOR _____ DATE _____

HOLD PENDING FURTHER TESTS _____ DATE _____

REASONS FOR REJECTION OR HOLDING 2/3/87 Perc Satisfactory - hold for subdivision plat. S. 1160


BLDG. PERMIT, SIGNED
AND RETURNED 4/16/91
Local # 57351
SFD

THIS IS NOT A PERMIT

① - ③
SOIL PROFILE

0'
6'
4-4.5'
13.5'

A1-3
Yellow Red
Silty loam
7-12% clay
100%
FRAGS
Yellow Red
Silty sand
loam
15-20%
FRAGS
Yellow Bl
in # 3 & 4
+ 2

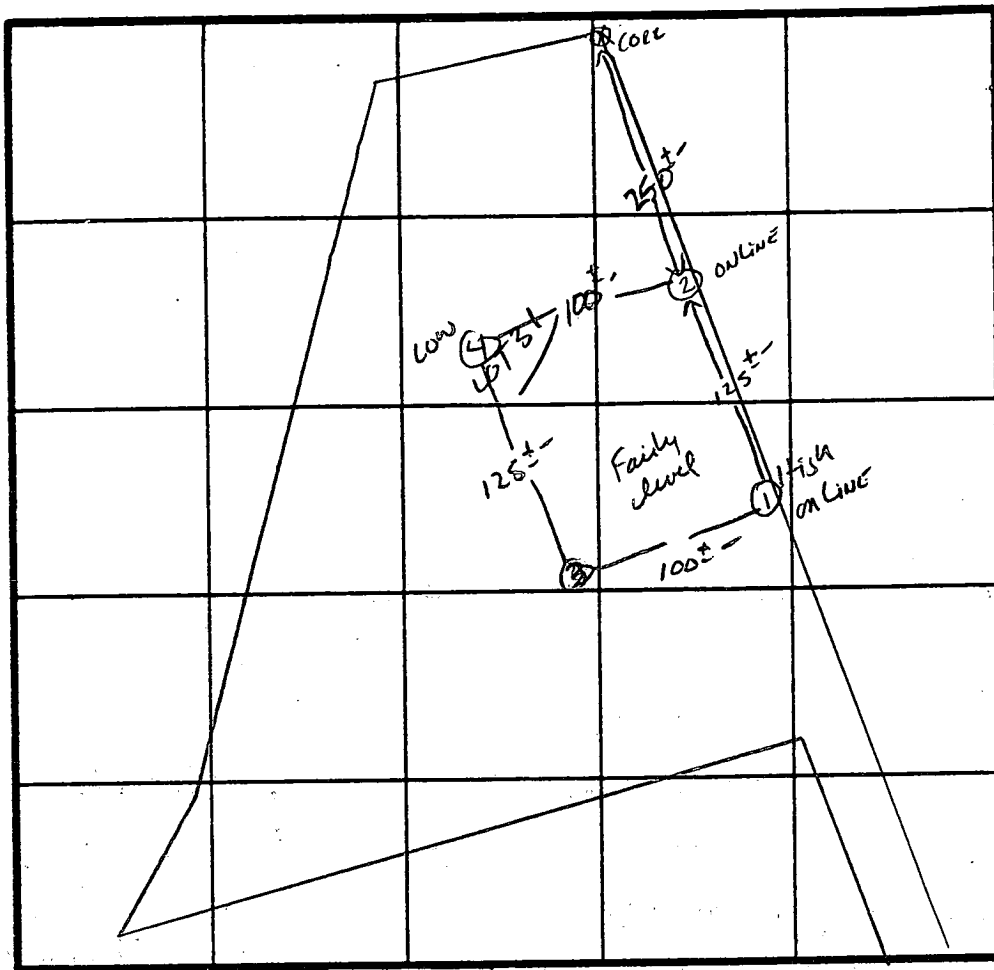

INDICATE NORTH - NAME ADJOINING ROADWAY AS BASE LINE.

DATE	TEST NO.	DEPTH	PRE-WET		TEST - 1" DROP		TIME
			START	STOP	START	STOP	
2/3/87	1 S	4.5'	11:01	11:05	11:05	11:15	10 min
	1 M	8'	10:58	11:00	11:00	11:05	5 min
	1 V	13.5	UNIFORM SOIL below 4.5'		4.5'		
	2 V	12.5'	UNIFORM SOIL below 4.5'		4.5'		
	3 S	5'	11:04	11:06	11:06	11:14	8 min
	3 V	12.5'	SAME AS # 1 w/ yellow brown C layer				
	4 S	4.5'	11:10	11:12	11:12	11:17	5 min
	4 V	13'	UNIFORM SOIL below 4'		4'		

REMARKS: Holes DIFF. THAN PLAT (make shallow due to rock frags)

TYPE OF SOIL: MANOK

TESTED BY: S. Abel

ALSO PRESENT: Phil M. C. Cissi

APPLICATION

PERCOLATION TESTING

A 38379

P 47280

HOWARD COUNTY HEALTH DEPARTMENT
BUREAU OF ENVIRONMENTAL HEALTH
P.O. BOX 476 ELLICOTT CITY, MARYLAND 21043
TELEPHONE: 461-9933

DISTRICT _____

DATE 7/8/91

Retest

TO: THE COUNTY HEALTH OFFICER
ELLICOTT CITY, MARYLAND

I, HEREBY, APPLY FOR THE NECESSARY TEST IN ORDER TO CONSTRUCT (OR RECONSTRUCT) A SEWAGE DISPOSAL SYSTEM.

PROPERTY OWNER M. Dillon

ADDRESS 29465 Shadow Roll PHONE 5704400

PROSPECTIVE BUYER _____

ADDRESS _____ PHONE _____

PROPERTY LOCATION:

SUBDIVISION Glenwood Springs LOT NO. 31

ROAD AND DESCRIPTION _____

TAX MAP _____ PARCEL # _____

SIZE OF LOT _____ TYPE BLDG _____
(SINGLE FAMILY DWELLING OR COMMERCIAL)

THE SYSTEM INSTALLED UNDER THIS APPLICATION IS ACCEPTABLE ONLY UNTIL PUBLIC FACILITIES BECOME AVAILABLE. I FULLY UNDERSTAND THE FEE CONNECTED WITH THE FILING OF THIS PERC TEST APPLICATION IS NON-REFUNDABLE UNDER ANY CIRCUMSTANCES. I ALSO AGREE TO COMPLY WITH ALL M.O.S.H.A. REQUIREMENTS IN TESTING THIS LOT.

(SIGNATURE OF APPLICANT) _____

APPROVED BY _____ FOR _____ DATE _____

REJECTED BY _____ FOR _____ DATE _____

HOLD PENDING FURTHER TESTS _____ DATE _____

REASONS FOR REJECTION OR HOLDING 9/10/91 Retest O/K Change

location only a little

HD-216

THIS IS NOT A PERMIT

SOIL PROFILE

0'

INDICATE NORTH - NAME ADJOINING ROADWAY AS BASE LINE.

DATE	TEST NO.	DEPTH	PRE-WET		TEST - 1" DROP		TIME
			START	STOP	START	STOP	

REMARKS _____

TYPE OF SOIL _____





TESTED BY _____ ALSO PRESENT _____

P 47085
A 38379

GLENWOOD SPRINGS LOT 31 REPAIR PERC

SEE ATTACHED DRAWING

FOR LOCATION OF PERC HOLES

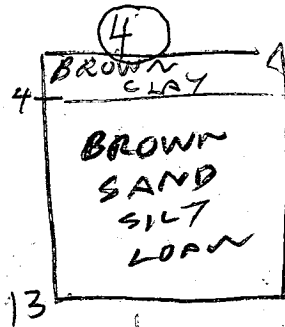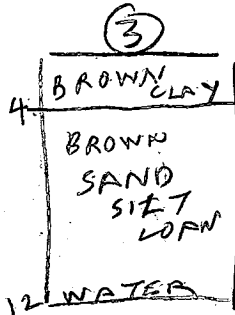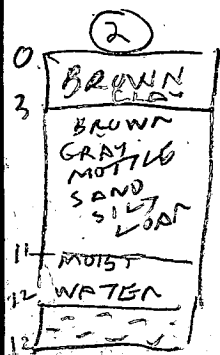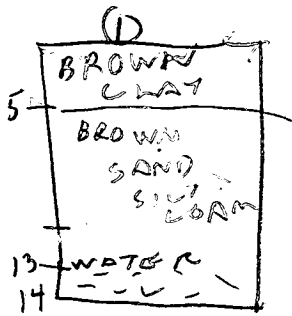


			START	STOP	START	STOP	TIME	
7/9/91	1S	5	103	128	128	216	248	FAIL
7/9/91	1V	14	WET SEASON FAIL					
	2V	13	WATER 12F7 MOIST 11 FAIL MORE SOIL & WATER					
	3S	5	228	235	235	258	23	
	3V	12	OK SHALLOW WET SEASON RECOMMENDED					
	4S	5	335	337	337	347	10	
	4V	13	OK					

Tested by R. Jodger

Avery McCoy Backhoe
Mrs. Pullon Owner


GREEN MEADOW
PLAT 3994

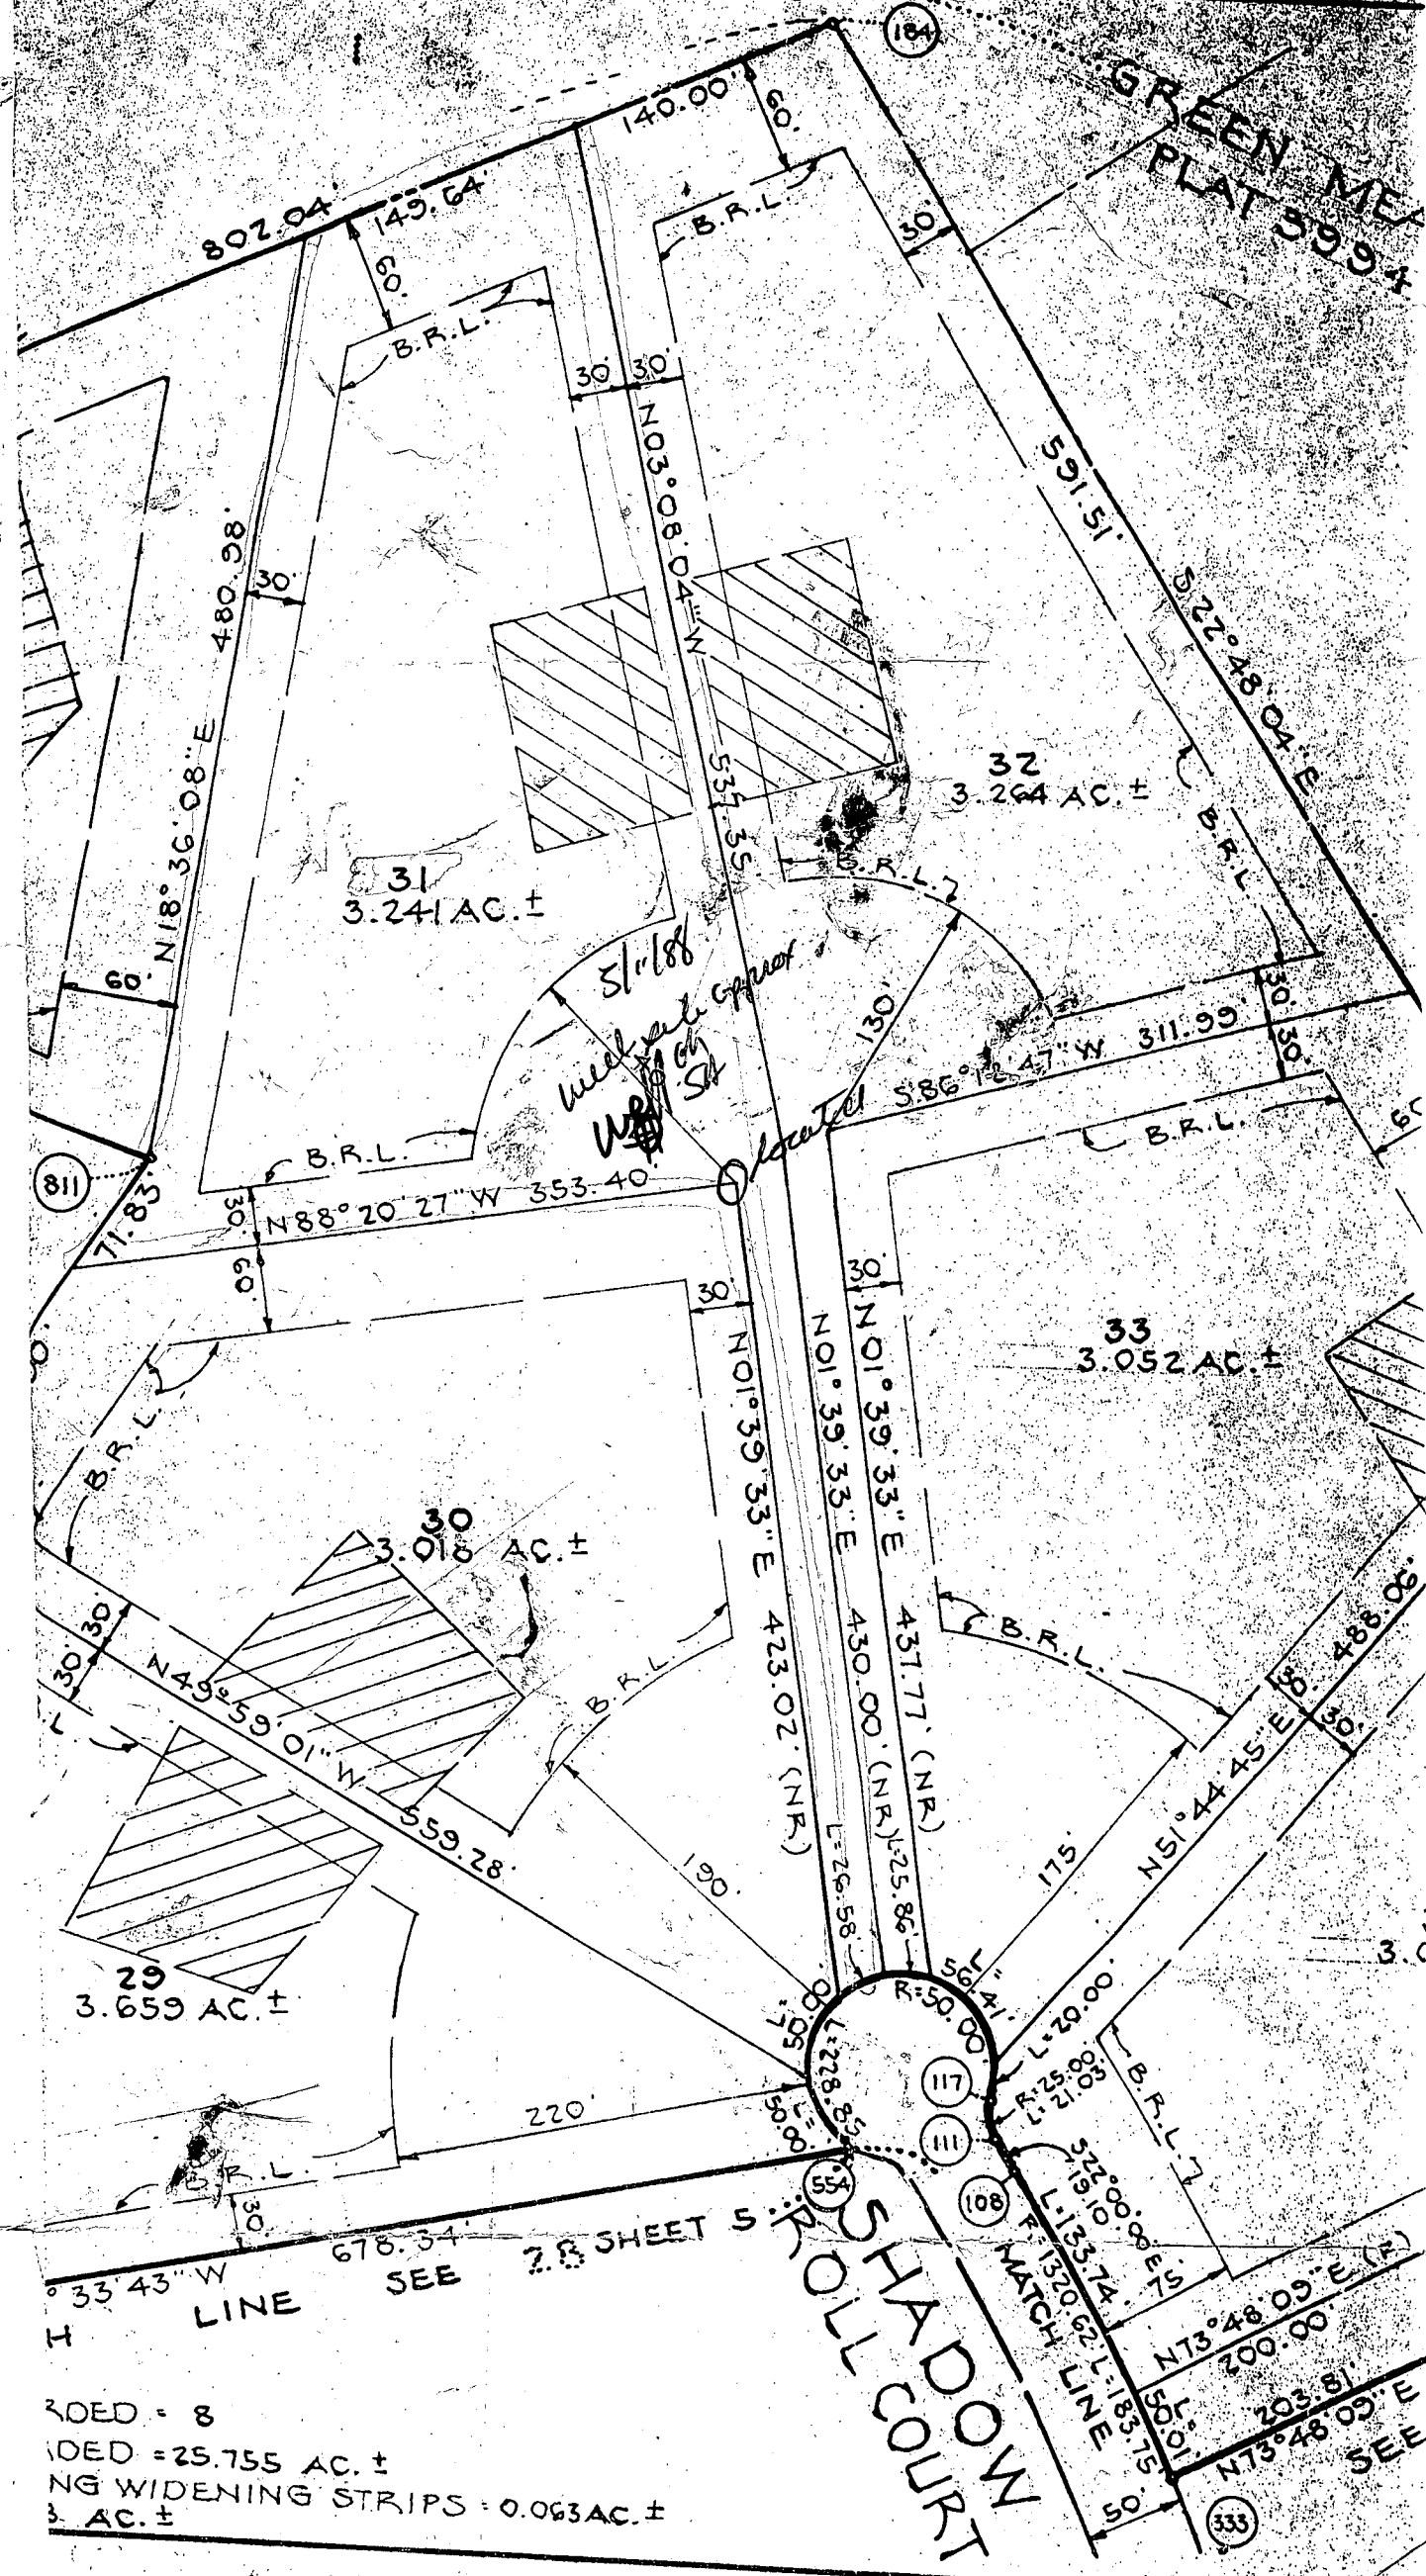

ROAD - 8
 DED = 25.755 AC. ±
 NG WIDENING STRIPS = 0.063 AC. ±
 3 AC. ±

OWNER'S CERTIFICATE:

WE, GLENWOOD SPRINGS PARTNERSHIP, A MARYLAND GENERAL PARTNERSHIP,
 OWNER OF THE PROPERTY SHOWN AND DESCRIBED HEREON, HEREBY ADOPT THIS PLAN
 OF SUBDIVISION, AND IN CONSIDERATION OF THE FACTS AND CIRCUMSTANCES

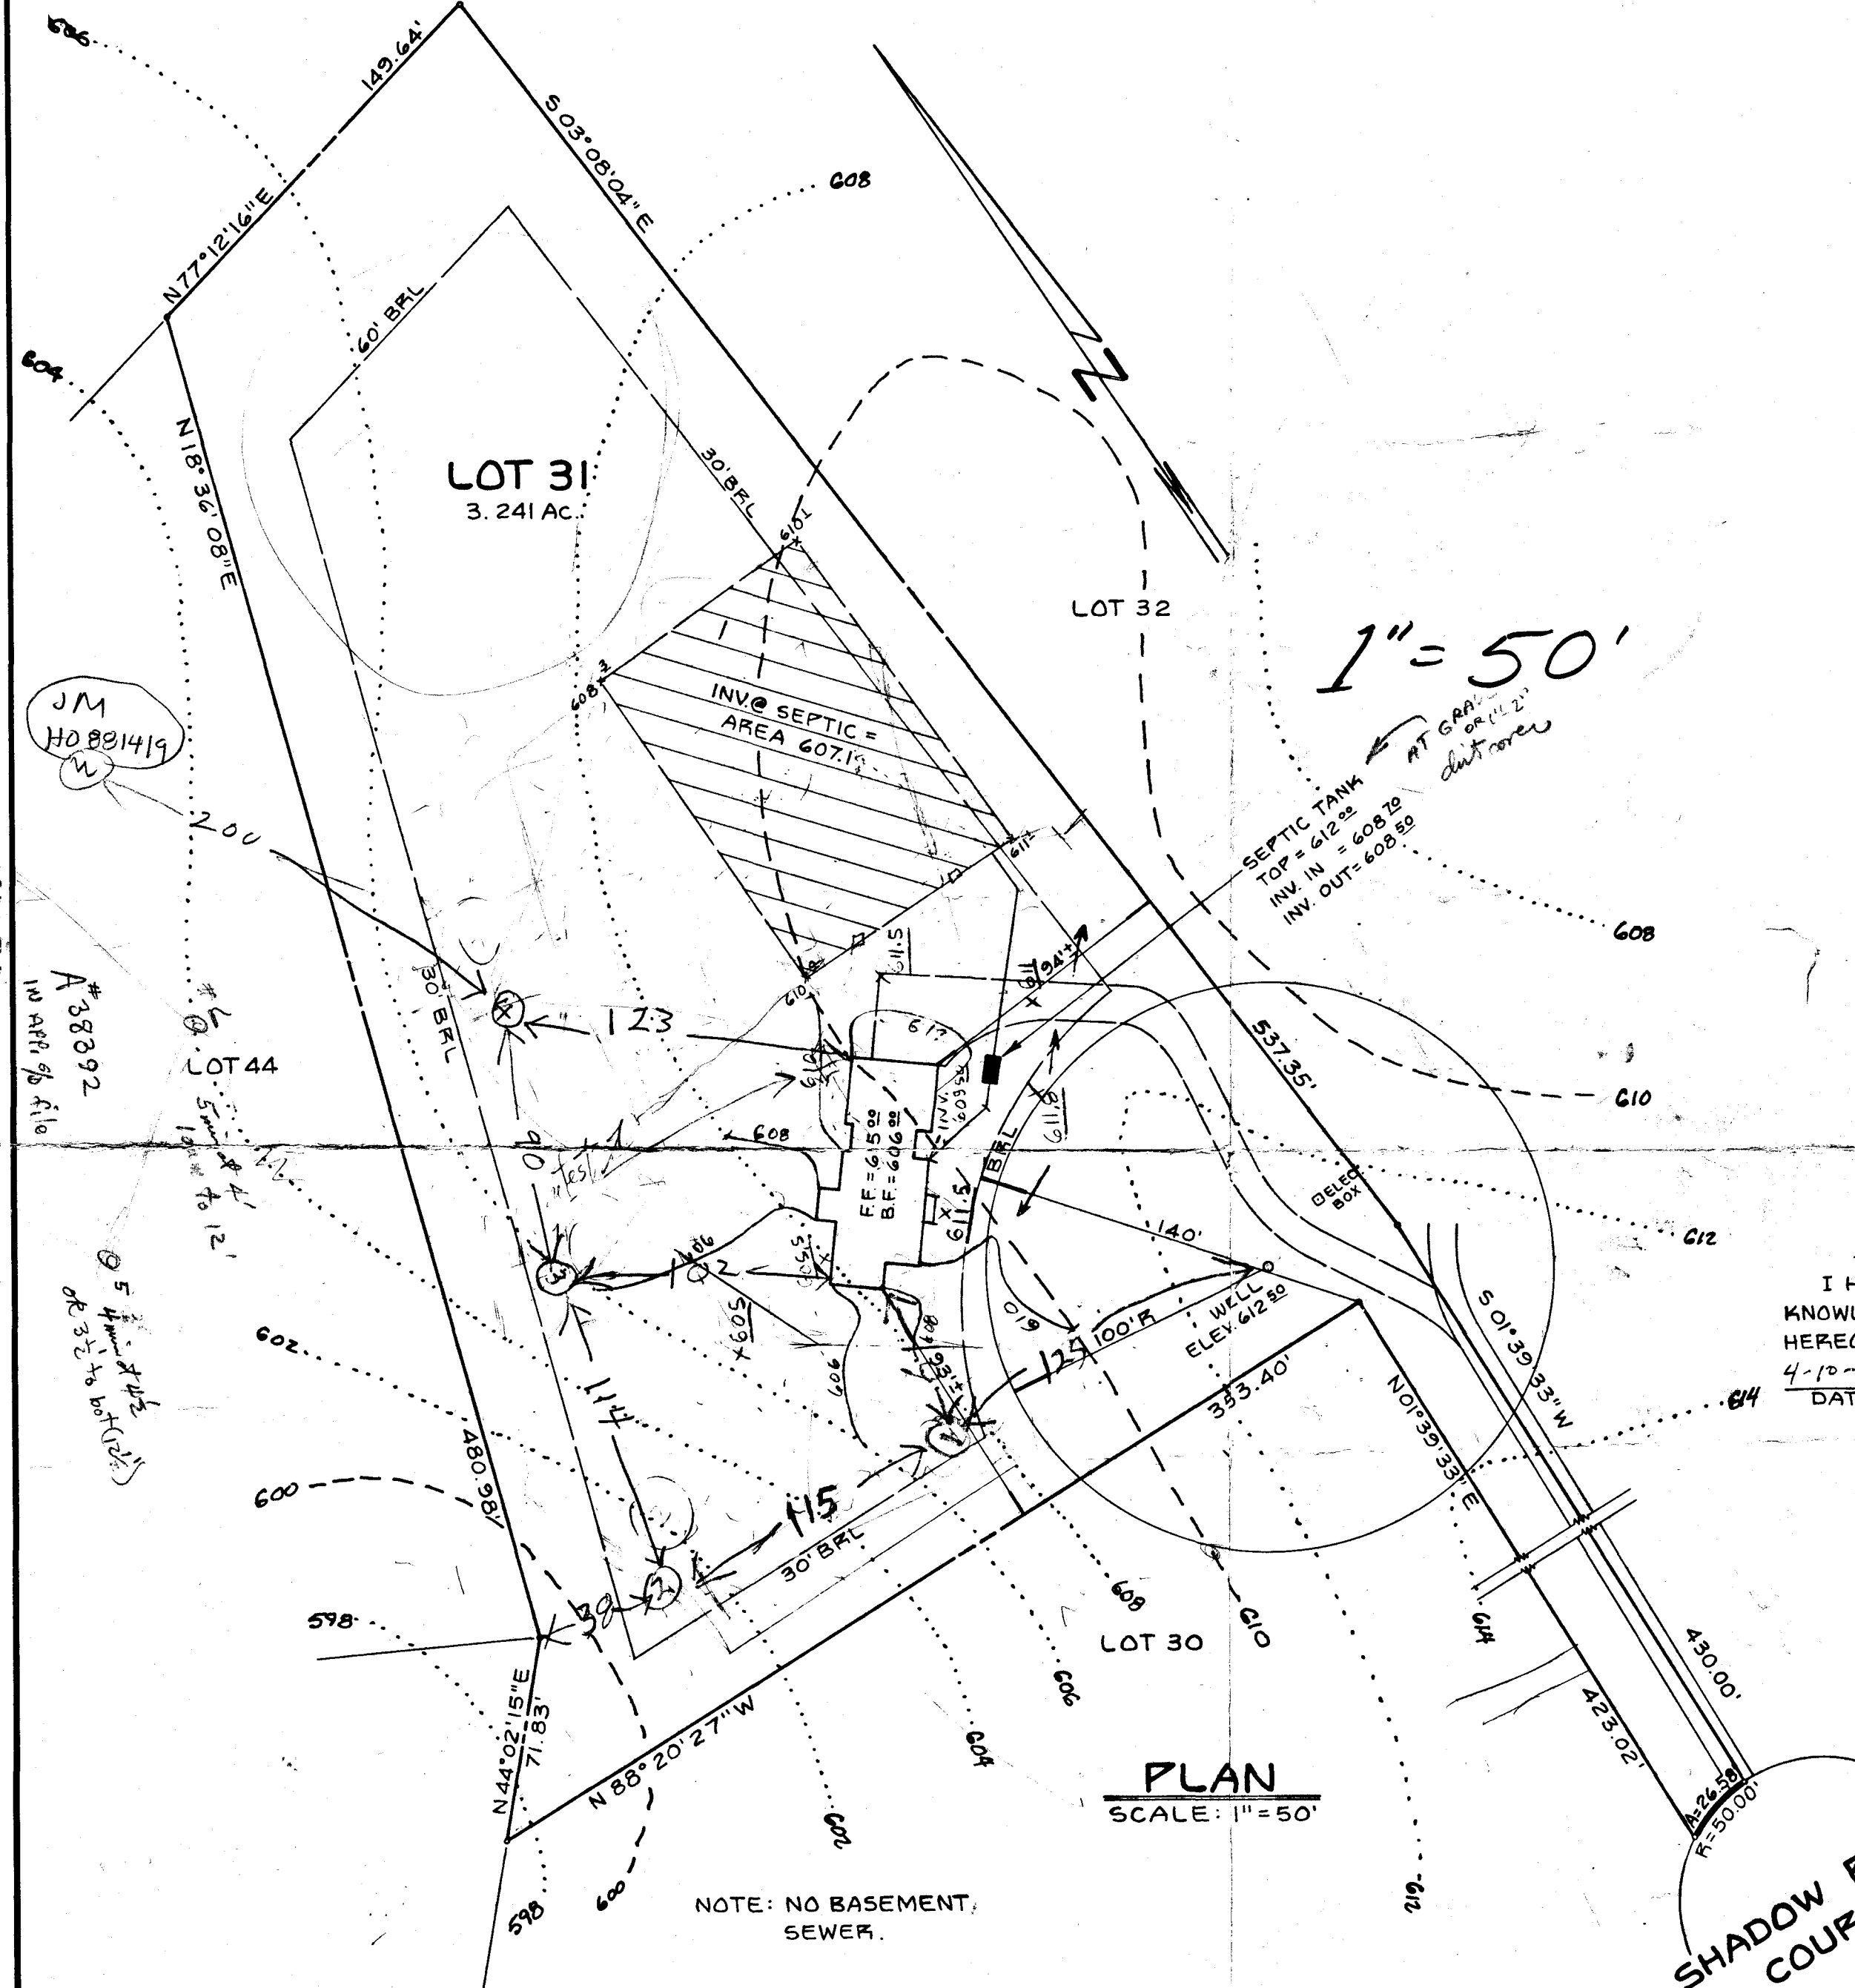

SURVEYOR'S CERTIFICATE

I HEREBY CERTIFY THAT TO THE BEST OF MY KNOWLEDGE AND BELIEF, THE INFORMATION SHOWN HEREON IS CORRECT.

4-10-91
DATE
JEFFERSON D. LAWRENCE
Reg. MD Land Surveyor # 5216

SHADOW ROLL
COURT

4/16/91
PLANS OK
RIT

OWNER:

21309 RIDGE CROFT DR.
BROOKVILLE, MD. 20833
301 - 774 - 0016





DEVELOPMENT
CONSULTANTS
GROUP, INC.

17904 GEORGIA AVENUE S. 102
OLNEY MARYLAND, 20832
(301) 924-4570

SITE PLAN
LOT 31
SECTION 1, AREA 1
GLENWOOD SPRINGS
4TH ELECTION DISTRICT
HOWARD COUNTY, MARYLAND

DATE
APRIL, 1991
DRAWN
E.M.
CHECKED
J.D.L.
SCALE
1"=50'

SHEET
1
OF 1
PROJECT No.
21-857

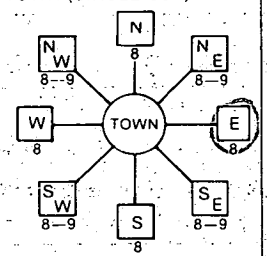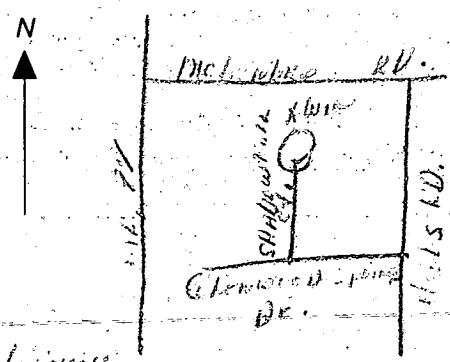B 1 5617 (THIS NUMBER IS TO BE PUNCHED IN COLS. 3-6 ON ALL CARDS)	SEQUENCE NO. (DP USE ONLY) 042788	STATE OF MARYLAND PERMIT TO DRILL WELL please print or type	STATE PERMIT NUMBER. 110-81-2798 fill in this form completely
Date Received (APA) 042788		LOCATION OF WELL B 3 COUNTY HOWARD SUBDIVISION OLD WOOD SPRINGS SECTION 31 LOT 31 NEAREST TOWN CLEVERWOOD MILES FROM TOWN (enter 0 if in town) 0.5 MI	
OWNER INFORMATION Last Name CARMAN Owner D S S C R I A T A - S First Name S Street or RFD LOC ROK 122 Town FALLICEA State MD Zip 21043		DRILLER INFORMATION Driller's Name Joseph L. Mayne License No. 238 Firm Name Joseph L. Mayne Well Drilling Address 5512 Ridge Rd. Hillside Y 21771 Signature Joseph L. Mayne Date 4/26/88	
WELL INFORMATION B 2 APPROX. PUMPING RATE (GAL. PER MIN.) 5 AVERAGE DAILY QUANTITY NEEDED (GAL. PER DAY) 500		DIRECTION OF WELL FROM TOWN (CIRCLE BOX) 	
USE FOR WATER (CIRCLE APPROPRIATE BOX) ☒ HOME (SINGLE OR DOUBLE HOUSEHOLD UNIT ONLY) ☐ FARMING (LIVESTOCK WATERING & AGRICULTURAL IRRIGATION) ☐ INDUSTRIAL, COMMERCIAL, STATE AND FEDERAL GOV. OTHER (REQUIRES APPROPRIATION PERMIT) ☐ PUBLIC OR PRIVATE WATER COMPANY (REQUIRES APPROPRIATION PERMIT AND STATE HEALTH DEPARTMENT APPROVAL) ☐ TEST, OBSERVATION, MONITORING (MAY REQUIRE APPROPRIATION PERMIT)		NOT TO BE FILLED IN BY DRILLER HEALTH DEPARTMENT APPROVAL COUNTY NAME Howard COUNTY NO. A-38379 STATE SIGNATURE _____ DATE ISSUED 06/13/88 CO SIGNATURE Seamus Adel EXP. DATE 04/27/88 NORTH GRID 533000 EAST GRID 0798000	
APPROXIMATE DEPTH OF WELL 200 FEET APPROXIMATE DIAMETER OF WELL 6 INCH		SHOW MAJOR FEATURES OF BOX & LOCATE WELL WITH AN X SOURCES OF DRILLING WATER 1. well 2. 3. WRITE THE BOX NUMBER FROM THE MAP HERE E 790 34 N 520 23	
METHOD OF DRILLING (circle one) BORED (or Augered) ☒ JETTED ☐ Jetted & DRIVEN ☐ AIR-ROtary ☒ AIR-PERcussion ☐ ROTARY (Hydraulic Rotary) ☐ CABLE ☐ REVerse-ROtary ☐ DRive-POINT ☐ other _____		REPLACEMENT OR DEEPEMED WELLS (CIRCLE APPROPRIATE BOX) ☒ THIS WELL WILL NOT REPLACE AN EXISTING WELL ☐ THIS WELL WILL REPLACE A WELL THAT WILL BE ABANDONED AND SEALED ☐ THIS WELL WILL REPLACE A WELL THAT WILL BE USED AS A STANDBY ☐ THIS WELL WILL DEEPEMED AN EXISTING WELL PERMIT NUMBER OF WELL TO BE REPLACED OR DEEPEMED (IF AVAILABLE) _____	
Not to be filled in by driller (OEP USE ONLY) APPROP. PERMIT NUMBER _____ FORCE 50 INITIALS GA PERMIT NO. 110-81-2798 SPECIAL CONDITIONS _____		DRAW A SKETCH BELOW SHOWING LOCATION OF WELL RELATION TO NEARBY TOWNS AND ROADS AND GIVE DISTANCE FROM WELL TO NEAREST ROAD JUNCTION 	

9657

SEQUENCE NO. (DENY USE ONLY)

STATE OF MARYLAND
WELL COMPLETION REPORT
FILL IN THIS FORM COMPLETELY
PLEASE PRINT OR TYPE

THIS REPORT MUST BE SUBMITTED WITHIN
45 DAYS AFTER WELL IS COMPLETED.

COUNTY NUMBER A-38379

DATE Received 10/14/97

DATE WELL COMPLETED 10/14/97

Depth of Well 365 (TO NEAREST FOOT)

PERMIT NO. 110-21-2798

OWNER CHAMMAN Associates

STREET OR RD Shadow Roll Ct

SUBDIVISION Glenwood Springs

SECTION 1

LOT 31

WELL LOG

Not required for driven wells

STATE THE KIND OF FORMATIONS PENETRATED, THEIR COLOR, DEPTH, THICKNESS AND IF WATER BEARING

DESCRIPTION (Use additional sheets if needed)

FEET

Check if water bearing

SANDSTONE 0 57

GRAY MINE 57 365

WELL HAS BEEN GROUTED (Circle Appropriate Box)

TYPE OF GROUTING MATERIAL

CEMENT CM BENTONITE CLAY BC

NO. OF BAGS 7 NO. OF POUNDS 846

GALLONS OF WATER 54

DEPTH OF GROUT SEAT (to nearest foot)

from 0 to 32 ft.

CASING RECORD

ST CO PL OT

STEEL CONCRETE PLASTIC OTHER

MAIN CASING TYPE SF

Nominal diameter top (main) casing (nearest inch) 6

Total depth of main casing (nearest foot) 13

OTHER CASING (if used)

diameter inch

depth (feet) from to

SCREEN RECORD

ST BR HO PL OT

STEEL BRASS OPEN HOLE PLASTIC OTHER

DEPTH (nearest ft.)

1 2 3 100

SLOT SIZE 1 2 3

DIAMETER OF SCREEN 56 60 (NEAREST INCH)

GRAVEL PACK IF WELL DRILLED WAS FLOWING WELL INSERT F IN BOX 68

OEP USE ONLY (NOT TO BE FILLED IN BY DRILLER)

TELESCOPE CASING 70 72 74 75 76

LOG INDICATOR

OTHER DATA

PUMPING TEST

HOURS PUMPED (nearest hour) 3

PUMPING RATE (gal. per min. to nearest gal.) 145

METHOD USED TO MEASURE PUMPING RATE Ruler

WATER LEVEL (distance from land surface)

BEFORE PUMPING 23

WHEN PUMPING 93

TYPE OF PUMP USED (for test)

A air P piston T turbine C centrifugal R rotary O other (describe below) J jet S submersible

PUMP INSTALLED

DRILLER WILL INSTALL PUMP YES NO

IF DRILLER INSTALLS PUMP, THIS SECTION MUST BE COMPLETED FOR ALL WELLS EXCEPT HOME USE

TYPE OF PUMP INSTALLED PLACE (A,C,J,P,R,S,T,O) IN BOX - SEE ABOVE:

CAPACITY: GALLONS PER MINUTE (to nearest gallon)

PUMP HORSE POWER

PUMP COLUMN LENGTH (nearest ft.)

CASING HEIGHT (circle appropriate box and enter casing height)

LAND SURFACE (nearest foot)

LOCATION OF WELL ON LOT

SHOW PERMANENT STRUCTURE SUCH AS BUILDING, SEPTIC TANKS, AND/OR LANDMARKS AND INDICATE NOT LESS THAN TWO DISTANCES (MEASUREMENTS TO WELL)

CIRCLE APPROPRIATE LETTER

A A WELL WAS ABANDONED AND SEALED WHEN THIS WELL WAS COMPLETED

E ELECTRIC LOG OBTAINED

P TEST WELL CONVERTED TO PRODUCTION WELL

I HEREBY CERTIFY THAT THIS WELL HAS BEEN CONSTRUCTED IN ACCORDANCE WITH COMAR 10.17.13 "WELL CONSTRUCTION" AND IN CONFORMANCE WITH ALL CONDITIONS STATED IN THE ABOVE CAPTIONED PERMIT, AND THAT THE INFORMATION PRESENTED HEREIN IS ACCURATE AND COMPLETE TO THE BEST OF MY KNOWLEDGE.

DRILLERS IDENT. NO. 338

DRILLERS SIGNATURE

SITE SUPERVISOR (sign. of driller or journeyman responsible for sitework if different from permittee)

COUNTY

Well Permit No. HO - 81-2798
Location of property (road) Shadow Roll Ct.
Subdivision Glenwood Springs Lot 31 Block - Plat - Sec. -
Well Driller Joseph MAYNE Owner ~~E. MAYNE~~ CARMAN Assoc

HD-224

7/10/91 10:00

FEE WAIVED
VARIOUS EXTENUATING
CIRCUMSTANCES
10/10/91 CWL

HOWARD COUNTY HEALTH DEPARTMENT
Bureau of Environmental Health
3525-H Ellicott Mills Drive
Ellicott City, MD 21043
461-9933

APPLICATION FOR PITLESS ADAPTER, WELL PUMP AND PRESSURE TANK INSTALLATION

New Installation ☒ Replacement ☐
Name of Installer PAUL FRIDMAN-Darco Plumbing, Inc. Telephone 977-6665
License Number _____
Certified Well Pump Installer ☐ Well Driller ☐ Registered Plumber ☒
Name of Property Owner Matthew M. & Julia M. Dillon Telephone 301-881-8660
Subdivision Glenwood Springs Lot # 31 Well Tag # 206 (301) 774-0016
Site Address 2846 Shadow Roll Ct.
Glenwood, MD 21738

Pump
1. Type
a. Deep well jet ☐
b. Shallow well jet ☐
c. Submersible ☒
2. Make JACUZZI
3. Model # 7B54101152
4. Capacity 10 GPM
5. Pump exceeds well capacity Yes ☒ No ☐
6. If Yes, is low pressure cutoff switch installed? Yes ☒ No ☐
7. What methods are used to protect the pump and electrical wiring from vibrations? Torque arrestors ☒ Cable guards ☒ Other ☐
Motor
1. Horsepower 3/4
2. RPM 3450
3. Voltage _____
a. 110 _____
b. 220 ☒
Pitless Adapter
1. Make Harvard
2. Model # PT800
3. Depth 9 Ft.

Tank
1. Capacity 42
2. Pressure relief valve? ☒
Piping
1. Type 1"
2. Size 1"
3. NSF and/or BOCA Code approved ☒
4. Depth of supply line 235
Well data
1. Depth 250 ft.
2. Yield 8 1/2 GPM
3. Static water level 70 ft.
4. Will water supply be disinfected by installer? YES

I understand that it is my responsibility to notify the Howard County Health Department when the installation is ready for inspection (otherwise this permit is null and void).

All information given above is true to the best of my knowledge. Completed by Julie Dillon on 10/10/91
Signature of Applicant: _____

9/10/91 - OK TO COVER OUTSIDE WORK
Note: A sticker indicating approval/status of the installation will be placed on the well casing at the time of the inspection.

HD-215
PRESSURE TANK NOT INSTALLED
LEFT NOTE TO CALL ABOUT PERMIT RH