

12/16/86 AM

Page 1 of 2

05-347718

PERMIT

P 3825-4

A REPAIR

SEWAGE DISPOSAL SYSTEM

MARYLAND STATE DEPARTMENT OF HEALTH

DISTRICT _____

HOWARD COUNTY

BUREAU OF ENVIRONMENTAL HEALTH
461-9933

INDEXED

DATE 12/16/86

DATE SYSTEM APPROVED _____

INSPECTOR _____

Wayne Thompson IS PERMITTED TO INSTALL _____ ALTER X

ADDRESS 11974 Route 216, Fulton, Maryland PHONE 498-6138
725-2392

SUBDIVISION _____ ROAD SCAGGSVILLE ROAD LOT _____
11974 Route 216

PROPERTY OWNER Wayne Thompson

ADDRESS - TERESA -

IF GARBAGE GRINDER IS USED INCREASE SEPTIC TANK CAPACITY BY 50% AND ABSORPTION AREA BY 22%.

GARBAGE GRINDER? YES _____ NO ✓

SEPTIC TANK CAPACITY _____ GALLONS NUMBER OF BEDROOMS 3

PLAN OF COMPLIANCE
PRESENTED END OF JAN 87.
PLAN TO PUMP AS NECESSARY,
REPAIR IN SPRING.
OK IF NO OVERFLOW 2/25/87
CW

REPAIR - CALL FOR INSPECTION WHEN GROUND IS OPENED UP SO SANITARIAN CAN RECOMMEND

REPAIR.

12/16/86 soil of 1 hole - red/orange clay top 2-3'; patches of yellow orange clay w/ silty mica loam predominately below
6' (13' D). Will have additional hole dug plus septic tank uncovered to evaluate

12/23/86 see over for additional notes
C. Williams

PLANS APPROVED BY _____ DATE 12/15/86

COVER NO WORK UNTIL INSPECTED AND APPROVED.

NEITHER THE HOWARD COUNTY COUNCIL NOR THE HEALTH DEPARTMENT IS RESPONSIBLE FOR THE SUCCESSFUL OPERATION OF ANY SYSTEM.

NOTE: CLEANOUT REQUIRED EVERY 70 FEET OF SEWER LINE AND/OR AT 90° SWEEPS IN LINES FROM HOUSE TO DRAIN FIELDS.

NOTE: ALL PARTS OF SEPTIC SYSTEMS (I.E., TANK, DISTRIBUTION BOX, TRENCHES) TO BE 100 FEET FROM WELL. (UNLESS OTHERWISE SPECIFICALLY AUTHORIZED)

NOTE: IF DEEP TRENCH(ES) ARE USED CALL FOR INSPECTION BEFORE AND AFTER PLACING GRAVEL IN TRENCH(ES).

NOTE: NO DRY WELL SHALL EXCEED 15 FOOT IN DIAMETER. NO ABSORPTION TRENCH TO EXCEED 100 FEET IN LENGTH.

NOTE: ALL PIPE FROM HOUSE TO SEPTIC TANK MUST BE CAST IRON OR SCHEDULE 40 PVC OR ABS.

PERMIT VOID AFTER TWO YEARS.

NOTE: INSTALL STAND PIPE ON SEPTIC TANK AND DRY WELL. STAND PIPES MUST BE 6 INCHES IN DIAMETER. CAST IRON, CONCRETE OR TERRA COTTA OR PVC OR ABS ACCEPTED. IF TOP OF SEPTIC TANK IS DEEPER THAN 3 FEET, MANHOLE TO GRADE REQUIRED.

NOTE: DISTRIBUTION BOXES MUST HAVE BAFFLES.

*INSTALLER IS RESPONSIBLE FOR OBTAINING FINAL APPROVAL ON THIS PERMIT

*CALL 461-9933 FOR INSPECTION OF SEPTIC SYSTEMS.

EH - 2-1186

P
A
38257

	50	100	150	200	250
250	soils of test hole #2				
200	more clay throughout - appears to be in layers of yellow brown / brown 4-5'				
150	Test shall was dug at 4 1/2' Questionable at that depth.				
100	① 4 1/2' 13' D	START 12:20 bottom	PRE STOP 12:38	START 12:38	STOP 1:05
50	② 4 1/2' 12+ D	12:30 bottom	12:55 (not moved)		
see other sheet for hole locations					

INDICATE NORTH. — NAME ADJOINING ROADWAY AS BASE LINE.

are 2 access covers

SEPTIC TANK, LEVEL _____ CLEANOUTS _____

DISTRIBUTION BOX, LEVEL would need one for system

DRAIN FIELD/TILE FIELD, DEPTH _____ FT. TRENCH WIDTH _____ FT. INLET DEPTH _____ FT.

EFFECTIVE GRAVEL DEPTH _____ FT. TOTAL LENGTH _____ FT.

NUMBER OF TRENCHES _____ ONE SIDEWALL/BOTTOM AREA _____ SQ. FT.

DRYWELL INSIDE DIAMETER _____ FT. EFFECTIVE DEPTH BELOW INLET _____ FT.

ABSORBENT AREA _____ SQ. FT.

REMARKS 12/23/86 Tank is concrete = 750 gal (if that) - dual compartment
need w/ 2 access ports (2x2 sq) concrete slab covers. Appears
that chamber set up acts as baffle. If upgrading system
still recommend new tank
(want 2 100' long trenches 4 1/2-9' w/ slope (total
per bed 220 ft - for four bed, then some)

DATE SYSTEM APPROVED _____ INSPECTOR _____

Page 2 of 2

Approved
3/24/87
38251
P
A Repair

PERMIT

SEWAGE DISPOSAL SYSTEM
MARYLAND STATE DEPARTMENT OF HEALTH*

HOWARD COUNTY
BUREAU OF ENVIRONMENTAL HEALTH

ELLICOTT CITY

DISTRICT _____

DATE 12/16/86

Wayne Thompson IS PERMITTED TO INSTALL _____ ALTER ☒
ADDRESS 11974 Route 216 PHONE 725 2392

SUBDIVISION _____ ROAD 11974 Rt 216 LOT _____

PROPERTY OWNER Wayne Thompson
ADDRESS _____

IF GARBAGE GRINDER IS USED INCREASE SEPTIC TANK CAPACITY BY 50% AND ABSORPTION AREA BY 22%.

GARBAGE GRINDER? YES _____ NO ☒

SEPTIC TANK CAPACITY _____ GALLONS NUMBER OF BEDROOMS 3

2 TRENCHES EACH 100 FT LONG
220 SQ FT DEEP BEDROOM
660 SQ FT NEEDED TRENCH SHOULD
BE ABOUT 12 FT DEEP & TOP
6 FT NOT TO BE COUNTED ABSORBENT AREA

PLANS APPROVED BY _____ DATE _____

COVER NO WORK UNTIL INSPECTED AND APPROVED.

NEITHER THE HOWARD COUNTY COUNCIL NOR THE HEALTH DEPARTMENT IS RESPONSIBLE FOR THE SUCCESSFUL OPERATION OF ANY SYSTEM.

NOTE: IF TRENCH IS USED CALL FOR INSPECTION BEFORE AND AFTER PLACING GRAVEL IN TRENCH.

NOTE: NO DRY WELL SHALL EXCEED 15 FOOT IN DIAMETER. NO ABSORPTION TRENCH TO EXCEED 100 FEET IN LENGTH.

NOTE: ALL PIPE FROM HOUSE TO SEPTIC TANK MUST BE CAST IRON OR SCHEDULE 40 PVC OR ABS.


PERMIT VOID AFTER THREE YEARS.

NOTE: INSTALL STAND PIPE ON SEPTIC TANK AND DRY WELL. STAND PIPES MUST BE 6 INCHES IN DIAMETER. CAST IRON, CONCRETE OR TERRA COTTA, OR PVC OR ABS ACCEPTED. IF TOP OF SEPTIC TANK IS DEEPER THAN 3 FEET MANHOLE TO GRADE REQUIRED.

*INSTALLER IS RESPONSIBLE FOR OBTAINING FINAL APROVAL ON THIS PERMIT

*C 2330 FOR INSPECTION OF SEPTIC SYSTEMS.

EH - 2-1082

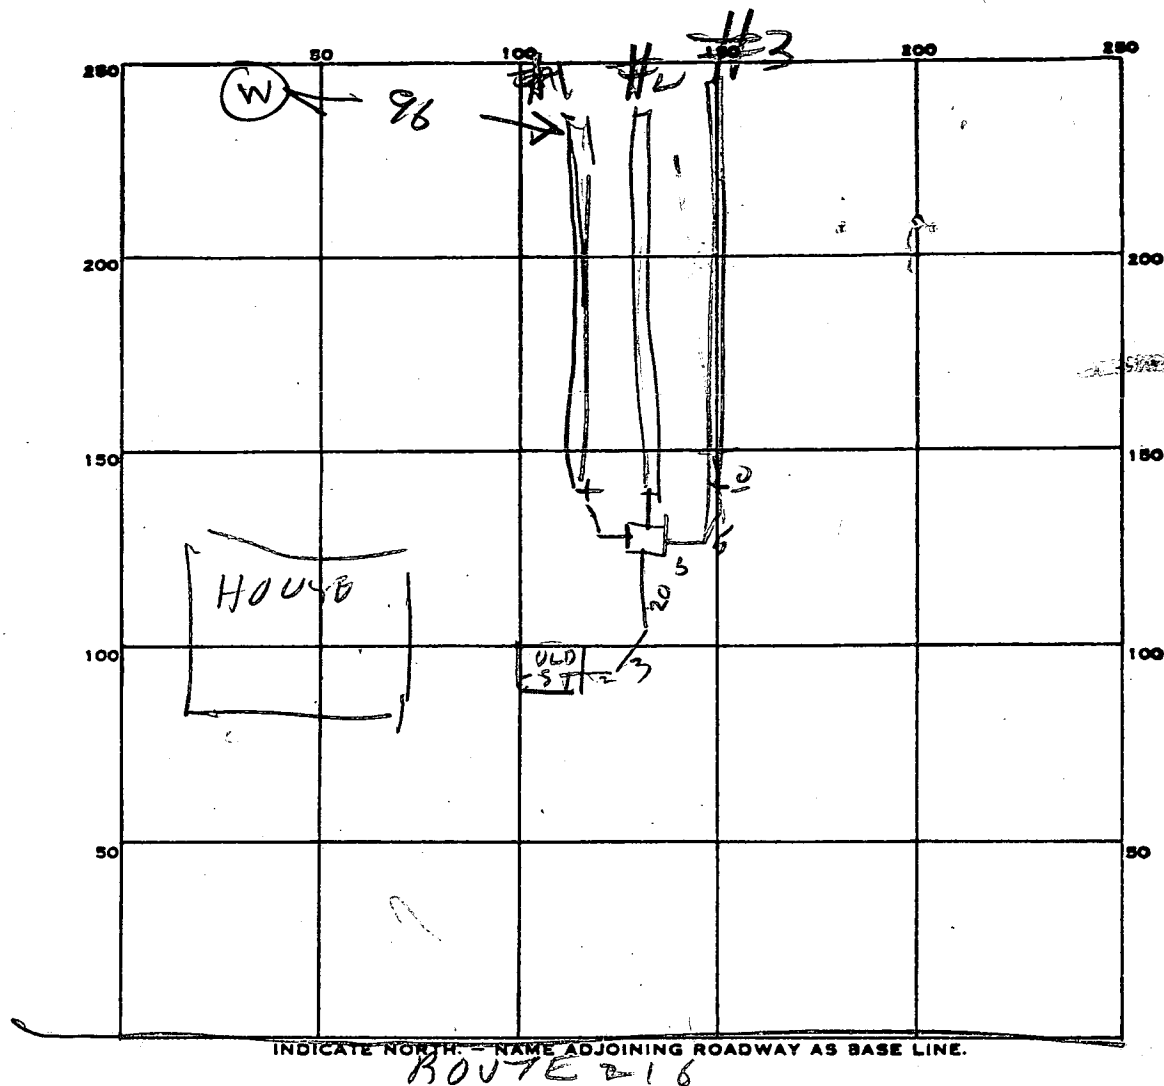

PERMIT CARD _____

SEPTIC TANK, LEVEL _____

CLEANOUTS _____

DISTRIBUTION BOX, LEVEL _____

TILE FIELD, DEPTH

#1	#2	#3
13.5	11	11

 FT. TRENCH WIDTH

#1	#2	#3
2	2	2

 FT.

GRAVEL DEPTH

#1	#2	#3
7.5	7.5	7.5

 IN. TOTAL LENGTH

#1	#2	#3	TOTAL
75	75	75	225

 FT.

NUMBER OF TRENCHES 3 TOTAL BOTTOM AREA

#1	#2	#3	TOTAL
552	525	375	1452

 SQ. FT.

SEEPAGE PITS, INSIDE DIAMETER _____ FT. DEPTH BELOW INLET _____ FT.

ABSORBENT AREA _____ SQ. FT.

REMARKS 3/187 - STONE ALREADY ADDED TO TRENCHES
& TRENCHES HARDLY COVERED BUT STAND PIPE
ENDS TO MEASURE DEPTH, EXTRA
LARGE SYSTEM

DATE SYSTEM APPROVED 3/29/81

INSPECTOR Raymond Stodola

12

101

6

75
5
375

75
2
525

75
75
375
515
552.5

552
525
375
1452

REGION

(3)

Copy for Mr. Williams recall 12/16 + 12/29 } C =

III

AREA

RATING

ACKNOWLEDGMENT AND CONTROLS	DATE
T/C = 4:26 P.M.	12/12
To Mr & Mrs. Thompson	
Secretary answered	
Hold for a call.	

Howard County Department of Health

BUREAU OF ENVIRONMENTAL HEALTH

RECORD OF INVESTIGATION

DISPOSITION	DATE

LOCATION B.W. Thompson, 11974 R2.216 ZIP 792-8140
 OWNER ☐ ADDRESS Same as above. PHONE (W) 301-277-7873
 OCCUPANT ☐ ADDRESS Same as above. PHONE 301-864-3234 (H)

COMPLAINANT Vacant lot owner ADDRESS adjacent to 11974 PHONE Anonymous

REASON FOR INVESTIGATION 12/11 Sanitarian received a call from adjacent property owner - Vacant lot may have an overflow on adj. property. (4:00 P.M.)

RECEIVED BY C.B.D. DATE 12/11/86 ASSIGNED TO C.B.D. DATE (4:00 P.M. 12/11/86)

DATE OF INVESTIGATION 12/12/86 TIME 1:05-1:45 WEATHER Overcast

REPORT 12/12/86 Sanitarian inspected area found - an overflowing septic. Left card.
12/12/86 Sanitarian contacted owner.
Owner to get a repair permit out as soon as possible.


DATE SUBMITTED

12/1/86

SANITARIAN

Charles, Bryan, Stecker

Pendell School Road

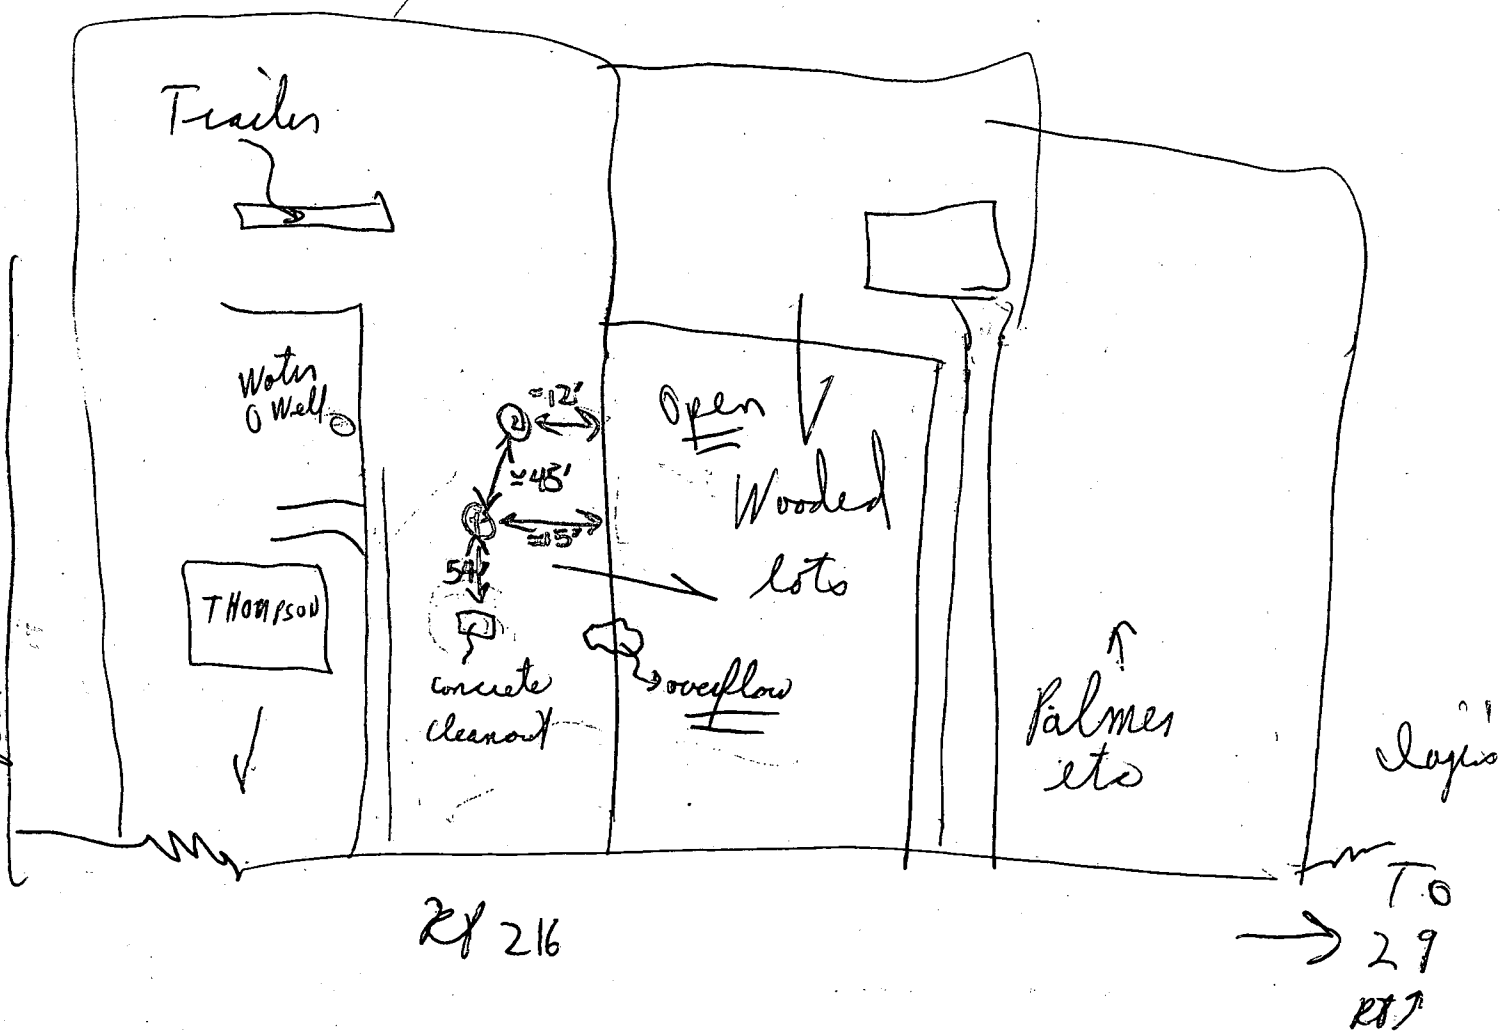

B 1 1035

SEQUENCE NO.
(OEP USE ONLY)STATE OF MARYLAND
PERMIT TO DRILL WELL

OEP PERMIT NUMBER

40-31-1715

(THIS NUMBER IS TO BE PUNCHED
IN COLS. 3-6 ON ALL CARDS)

please print or type

fill in this form completely

Date Received

8 4 13

OWNER INFORMATION

15 Last Name 34 Owner First Name

36 Street or RFD 55

57 Town 70 State 72 Zip 76

DRILLER INFORMATION

Driller's Name 77 License No. 80

Firm Name

Address

Signature Date

B 3

LOCATION OF WELL

8 COUNTY 21


23 SUBDIVISION 42

SECTION 44 46 LOT 48 50

52 NEAREST TOWN 71

MILES FROM TOWN (enter 0 if in town) 73 76 77 78

B 4

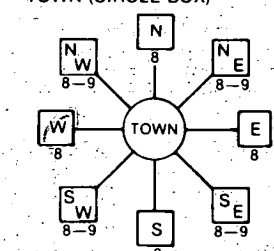DIRECTION OF WELL FROM
TOWN (CIRCLE BOX)

11974 Scaggsville Rd. 30

ON WHICH SIDE OF ROAD
(CIRCLE APPROPRIATE BOX)

DISTANCE FROM ROAD 34 37 ENTER FT or MI 38 39

WELL INFORMATION

APPROX. PUMPING RATE (GAL. PER MIN.) 5 8 12

AVERAGE DAILY QUANTITY NEEDED (GAL. PER DAY) 500 14 20

USE FOR WATER (CIRCLE APPROPRIATE BOX)

- ☒ HOME (SINGLE OR DOUBLE HOUSEHOLD UNIT ONLY)
- ☐ F FARMING (LIVESTOCK WATERING & AGRICULTURAL IRRIGATION)
- ☐ I INDUSTRIAL, COMMERCIAL, STATE AND FEDERAL GOV. OTHER (REQUIRES APPROPRIATION PERMIT)
- ☐ P PUBLIC OR PRIVATE WATER COMPANY (REQUIRES APPROPRIATION PERMIT AND STATE HEALTH DEPARTMENT APPROVAL)
- ☐ T TEST, OBSERVATION, MONITORING (MAY REQUIRE APPROPRIATION PERMIT)

APPROXIMATE DEPTH OF WELL 200 24 28 FEET

APPROXIMATE DIAMETER OF WELL 6 INCH NEAREST INCH

METHOD OF DRILLING (circle one)

- BORED (or Augered) JETTED Jetted & DRIVEN
- AIR-ROTARY AIR-PERCussion ROTARY (Hydraulic Rotary)
- CABLE REVERSE-ROTARY Drive-POINT
- other

REPLACEMENT OR DEEPEMED WELLS
(CIRCLE APPROPRIATE BOX)

- ☐ N THIS WELL WILL NOT REPLACE AN EXISTING WELL
- ☒ Y THIS WELL WILL REPLACE A WELL THAT WILL BE ABANDONED AND SEALED (HAND DUG)
- ☐ S THIS WELL WILL REPLACE A WELL THAT WILL BE USED AS A STANDBY
- ☐ D THIS WELL WILL DEEPMED AN EXISTING WELL
- PERMIT NUMBER OF WELL TO BE REPLACED OR DEEPMED (IF AVAILABLE) 41 52

Not to be filled in by driller (OEP USE ONLY)

APPROX. PERMIT NUMBER 54 GAP 63

FORCE 2A WRITE INITIALS IN BOX PERMIT NO. 40-31-1715

SPECIAL CONDITIONS

NOT TO BE FILLED IN BY DRILLER
HEALTH DEPARTMENT APPROVAL

COUNTY NAME HAWARD COUNTY NO. A-37912-6

OEP SIGNATURE DATE ISSUED 10/17/86

CO SIGNATURE EXP. DATE 04/17/87

NORTH GRID 481000 EAST GRID 0870000

SHOW MAJOR FEATURES OF
BOX & LOCATE WELL WITH AN X


SOURCES OF DRILLING WATER

- WELL
-
-

WRITE THE BOX NUMBER
FROM THE MAP HERE

820

480

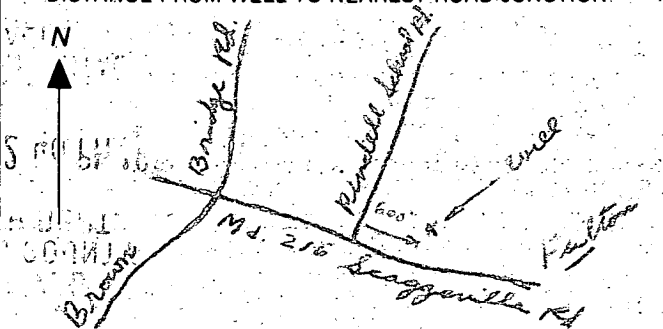DRAW A SKETCH BELOW SHOWING LOCATION OF WELL IN
RELATION TO NEARBY TOWNS AND ROADS AND GIVE
DISTANCE FROM WELL TO NEAREST ROAD JUNCTION

11/7/86

Location per approved
set

65' casing
~ 16' open
(jetted to 30')

9 bags cement
(tag attached)

185' deep
~ 7 gpm est. yield

DIVISION OF
ENVIRONMENTAL
HEALTH

NOV 16 12 40 PM '86

RECEIVED
HOWARD COUNTY
HEALTH DEPT.

C1 5349

SEQUENCE NO.
(OEP USE ONLY)STATE OF MARYLAND
WELL COMPLETION REPORTFILL IN THIS FORM COMPLETELY
PLEASE PRINT OR TYPETHIS REPORT MUST BE SUBMITTED WITHIN
45 DAYS AFTER WELL IS COMPLETED.

COUNTY

NUMBER A-37912-W

DATE Received

8	9	10	11	12	13
---	---	----	----	----	----

DATE WELL COMPLETED

1	1	1	7	8	6
---	---	---	---	---	---

Depth of Well

22	7	8	5	26
----	---	---	---	----

(TO NEAREST FOOT)PERMIT NO.
FROM "PERMIT TO DRILL WELL"

10	-	8	1	-	1	7	1	5
----	---	---	---	---	---	---	---	---

28 29 30 31 32 33 34 35 36 37

OWNER

STREET OR RFD

SUBDIVISION

SECTION

TOWN

LOT

WELL LOG

Not required for driven wells

STATE THE KIND OF FORMATIONS
PENETRATED, THEIR COLOR, DEPTH,
THICKNESS AND IF WATER BEARINGDESCRIPTION (Use
additional sheets if needed)

FEET

FROM

TO

Check
if water
bearing

SPUD	0	60	
Hard Mer Rock	60	185	

GROUTING RECORD

WELL HAS BEEN GROUTED
(Circle Appropriate Box)

Y	N
---	---

TYPE OF GROUTING MATERIAL

CEMENT CM BENTONITE CLAY BCNO. OF BAGS 9 NO. OF POUNDS 846GALLONS OF WATER 54

DEPTH OF GROUT SEAL (to nearest foot)

from	0	1	2	3	4	5	6	7	8	9	ft. to	3	0	0	ft.
	48												54		58

(enter 0 if from surface)casing
types
insert
appropriate
code
below

CASING RECORD

ST	CO
STEEL	CONCRETE
PL	OT
PLASTIC	OTHER

MAIN Casing Nominal diameter Total depth
Casing top (main) casing of main casing
TYPE (nearest inch) (nearest foot)

3	1	6	1	5	6	7	0
---	---	---	---	---	---	---	---

OTHER CASING (if used)

Each	diameter	depth (feet)
Casing	inch	from to

screen type
or open hole

SCREEN RECORD

ST	BR	HO
STEEL	BRASS	OPEN
	BRONZE	HOLE
PL	OT	
PLASTIC	OTHER	

C2

1	2	3	4	5	6	7	8	9	10	11	12	13	14	15	16	17	18	19	20	21
8	9	11	12	13	14	15	16	17	18	19	20	21	22	23	24	25	26	27	28	29
23	24	25	26	27	28	29	30	31	32	33	34	35	36	37	38	39	40	41	42	43
38	39	40	41	42	43	44	45	46	47	48	49	50	51	52	53	54	55	56	57	58

SLOT SIZE 1 2 3

DIAMETER OF SCREEN (NEAREST INCH)

GRAVEL PACK
IF WELL DRILLED WAS
FLOWING WELL INSERT
F IN BOX 68OEP USE ONLY
(NOT TO BE FILLED IN BY DRILLER)

T	(E.R.O.S.)	W.Q.
70	72	74 75 76
TELESCOPE	LOG	OTHER DATA
CASING	INDICATOR	

C3

PUMPING TEST

HOURS PUMPED (nearest hour) 3PUMPING RATE (gal. per min. to nearest gal.) 7METHOD USED TO MEASURE PUMPING RATE air

WATER LEVEL (distance from land surface)

BEFORE PUMPING 43WHEN PUMPING 110

TYPE OF PUMP USED (for test)

A	P	T
air	piston	turbine
C	R	O
centrifugal	rotary	other (describe below)
J	S	
jet	submersible	

PUMP INSTALLED

DRILLER WILL INSTALL PUMP YES NO
(CIRCLE) (YES or NO)
IF DRILLER INSTALLS PUMP, THIS SECTION
MUST BE COMPLETED FOR ALL WELLS
EXCEPT HOME USE
TYPE OF PUMP INSTALLED
PLACE (A,C,J,P,R,S,T,O)
IN BOX - SEE ABOVE:CAPACITY:
GALLONS PER MINUTE (to nearest gallon) 31PUMP HORSE POWER 37PUMP COLUMN LENGTH (nearest ft.) 43

CASING HEIGHT (circle appropriate box and enter casing height)

LAND SURFACE (nearest foot) 1

LOCATION OF WELL ON LOT

SHOW PERMANENT STRUCTURE SUCH AS
BUILDING, SEPTIC TANKS, AND/OR
LANDMARKS AND INDICATE NOT LESS
THAN TWO DISTANCES
(MEASUREMENTS TO WELL)CIRCLE APPROPRIATE LETTER
A WELL WAS ABANDONED AND SEALED
WHEN THIS WELL WAS COMPLETED

E ELECTRIC LOG OBTAINED

P TEST WELL CONVERTED TO PRODUCTION
WELLI HEREBY CERTIFY THAT THIS WELL HAS BEEN CONSTRUCTED IN
ACCORDANCE WITH COMAR 10.17.13 "WELL CONSTRUCTION"
AND IN CONFORMANCE WITH ALL CONDITIONS STATED IN THE
ABOVE CAPTIONED PERMIT, AND THAT THE INFORMATION
PRESENTED HEREIN IS ACCURATE AND COMPLETE TO THE BEST
OF MY KNOWLEDGEDRILLERS IDENT. NO. 338DRILLERS SIGNATURE
(MUST MATCH SIGNATURE ON APPLICATION)SITE SUPERVISOR (sign. of driller or journeyman
responsible for sitework if different from permittee)

APPLICATION FOR PITLESS ADAPTER, WELL PUMP AND PRESSURE TANK INSTALLATION

38257

Howard County Health Department
Bureau of Environmental Health
3525-H Ellicott Mills Drive
Court House Square
Ellicott City, Md. 21043
461-9933

New Installation ☒
Replacement ☐

Receipt # 38067
Date NOV 7, 1986

Name of Installer T & R Pumps & Htg Inc.

Telephone 705-2392

License number 7079

Certified Well Pump Installer ☐ Well Driller ☐ Registered Plumber ☒

Name of Property Owner Bernard W & Brenda L Thompson Telephone 705-3856

Subdivision none Lot # none Well tag # 10-81-1715

Site Address 11974 Scaggsville Rd
Fulton, Md 20759

Pump

1. Type
 - a. Deep well jet ☐
 - b. Shallow well jet ☐
 - c. Submersible ☒

Motor

1. Horsepower 1/2
2. RPM ☐
3. Voltage ☐
 - a. 110 ☐
 - b. 220 ☒

Pitless Adapter

1. Make Harvard
2. Model # ☐
3. Depth 4'

2. Make Sacuzzi

3. Model # ☐

4. Capacity 10 GPM

5. Pump exceeds well capacity Yes ☒ No ☐

6. If Yes, is low pressure cutoff switch installed? Yes ☒ No ☐

7. What methods are used to protect the pump and electrical wiring from vibrations? Torque arrestors ☒ Cable guards ☐ Other ☐

Tank

1. Capacity 42 gal Equil
2. Pressure relief valve? yes

Piping

1. Type Creston
2. Size 1"
3. NSF and/or BOCA Code approved yes
4. Depth of supply line 4

Well data

1. Depth 180 ft.
2. Yield 7.5 GPM
3. Static water level ☐ ft.
4. Will water supply be disinfected by installer? yes

I understand that it is my responsibility to notify the Howard County Health Department when the installation is ready for inspection (otherwise this permit is null and void).

All information given above is true to the best of my knowledge.

Signature of Applicant: [Signature]

Date: 11-7-86

Note: A sticker indicating approval/status of the installation will be placed on the well casing at the time of the inspection.

Well Proposed Site

Bernard W + Brenda Thompson

11974 Scoopville Rd

Fulton Md 20759

301-725-3856

Property Line

