

3/9/87
ASAP

05-346703

PERMIT

SEWAGE DISPOSAL SYSTEM

MARYLAND STATE DEPARTMENT OF HEALTH

HOWARD COUNTY

BUREAU OF ENVIRONMENTAL HEALTH

461-9933

P 38852

A REPAIR

DISTRICT _____

DATE 3/5/87

DATE SYSTEM APPROVED 3-9-87

INSPECTOR S. Alvo

INDEXED

Jack Fyock

IS PERMITTED TO INSTALL _____ ALTER X

ADDRESS _____ PHONE 988-9270

SUBDIVISION Clarksville Ridge ROAD 6667 Surrey Lane LOT Lt 4

PROPERTY OWNER Gilbert Hoffman

ADDRESS _____

IF GARBAGE GRINDER IS USED INCREASE SEPTIC TANK CAPACITY BY 50% AND ABSORPTION AREA BY 22%.

GARBAGE GRINDER? YES _____ NO _____

SEPTIC TANK CAPACITY _____ GALLONS NUMBER OF BEDROOMS _____

REPAIR - CALL FOR INSPECTION WHEN GROUND IS OPENED UP SO SANITARIAN CAN RECOMMEND

REPAIR.

PLANS APPROVED BY C. Williams DATE 3/05/87

COVER NO WORK UNTIL INSPECTED AND APPROVED.

NEITHER THE HOWARD COUNTY COUNCIL NOR THE HEALTH DEPARTMENT IS RESPONSIBLE FOR THE SUCCESSFUL OPERATION OF ANY SYSTEM.

NOTE: CLEANOUT REQUIRED EVERY 70 FEET OF SEWER LINE AND/OR AT 90° SWEEPS IN LINES FROM HOUSE TO DRAIN FIELDS.

NOTE: ALL PARTS OF SEPTIC SYSTEMS (I.E., TANK, DISTRIBUTION BOX, TRENCHES) TO BE 100 FEET FROM WELL. (UNLESS OTHERWISE SPECIFICALLY AUTHORIZED)

NOTE: IF DEEP TRENCH(ES) ARE USED CALL FOR INSPECTION BEFORE AND AFTER PLACING GRAVEL IN TRENCH(ES).

NOTE: NO DRY WELL SHALL EXCEED 15 FOOT IN DIAMETER. NO ABSORPTION TRENCH TO EXCEED 100 FEET IN LENGTH.

NOTE: ALL PIPE FROM HOUSE TO SEPTIC TANK MUST BE CAST IRON OR SCHEDULE 40 PVC OR ABS.

PERMIT VOID AFTER TWO YEARS.

NOTE: INSTALL STAND PIPE ON SEPTIC TANK AND DRY WELL. STAND PIPES MUST BE 6 INCHES IN DIAMETER. CAST IRON, CONCRETE OR TERRA COTTA OR PVC OR ABS ACCEPTED. IF TOP OF SEPTIC TANK IS DEEPER THAN 3 FEET, MANHOLE TO GRADE REQUIRED.


NOTE: DISTRIBUTION BOXES MUST HAVE BAFFLES.

*INSTALLER IS RESPONSIBLE FOR OBTAINING FINAL APROVAL ON THIS PERMIT

*CALL 461-9933 FOR INSPECTION OF SEPTIC SYSTEMS.

EH - 2-1186

P-38852

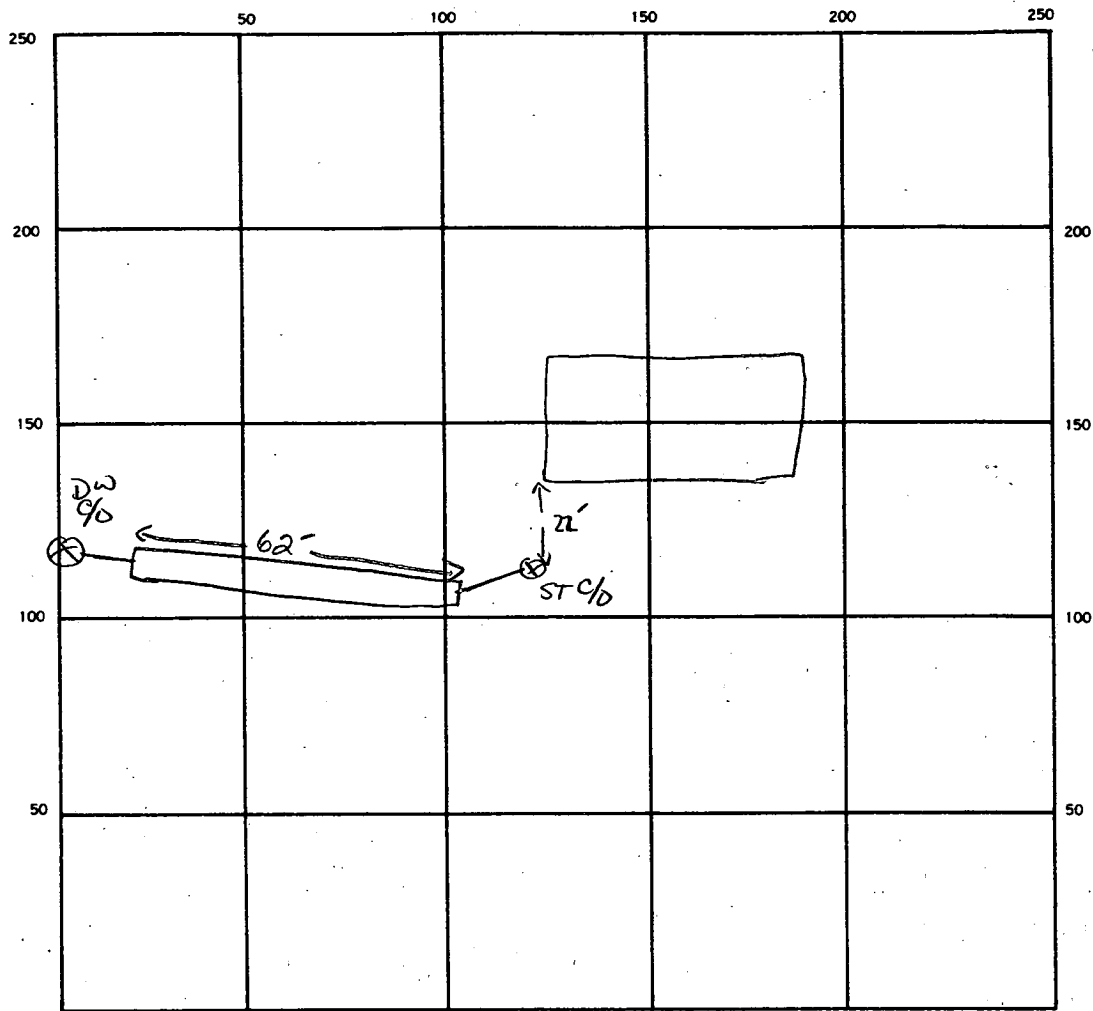

INDICATE NORTH. — NAME ADJOINING ROADWAY AS BASE LINE.

SURLEY DR.

SEPTIC TANK. LEVEL EXISTING CLEANOUTS EXISTING DW/ST

DISTRIBUTION BOX. LEVEL N/A

DRAIN FIELD/TILE FIELD. DEPTH 9-10 FT. TRENCH WIDTH 2 FT. INLET DEPTH 3-4 FT.

EFFECTIVE GRAVEL DEPTH 6 FT. TOTAL LENGTH 62 FT.

NUMBER OF TRENCHES 1 ONE SIDEWALL/BOTTOM AREA 372 SQ. FT.

DRYWELL INSIDE DIAMETER — FT. EFFECTIVE DEPTH BELOW INLET — FT.

ABSORBENT AREA 372 SQ. FT.

REMARKS TRENCH BETWEEN ST & DW 5' deep

DATE SYSTEM APPROVED 3-9-67 INSPECTOR S. Abel

5/8/70
9:30 - 12:30
PERMIT

SEWAGE DISPOSAL SYSTEM

MARYLAND STATE DEPARTMENT OF HEALTH

HOWARD COUNTY

ELLICOTT CITY

DISTRICT 5

DATE 3/31/70

INDEXED

Robert Dubin

IS PERMITTED TO INSTALL ALTER X

ADDRESS Rt. 2, Clarksville, Maryland 21029

PHONE 286-3432

A SEWAGE DISPOSAL SYSTEM LOCATED AT

SUBDIVISION Clarksville Ridge

ROAD Rt. 32

LOT 4

PROPERTY OWNER Charles B. Roebuck

ADDRESS

SPECIFICATIONS

DRAIN FIELD DEPTH FEET, BOTTOM AREA SQ. FT.

SEEPAGE PITS ABSORBENT SIDE-WALL AREA SQ. FT.

SEPTIC TANK CAPACITY GALLONS

FOR GARBAGE GRINDER, INCREASE DISPOSAL AREA 22% & TANK CAPACITY 50%.

OTHER REPAIR - Deep trench - 1 deep trench 50 ft. long - 10 ft. deep -
bucket width - gravel below outlet pipe.

NOTE: CALL FOR INSPECTION WHEN GROUND IS EXCAVATED BEFORE ANY GRAVEL IS INSTALLED.


PLANS APPROVED BY Palmer F. Wine

DATE 3/31/70

FILL SEPTIC TANK AND DISTRIBUTION BOX WITH WATER BEFORE CALLING FOR AN INSPECTION. COVER NO WORK UNTIL INSPECTED AND APPROVED.

NEITHER THE HOWARD COUNTY COMMISSIONERS NOR THE HEALTH DEPARTMENT IS RESPONSIBLE FOR THE SUCCESSFUL OPERATION OF ANY SYSTEM.

15153

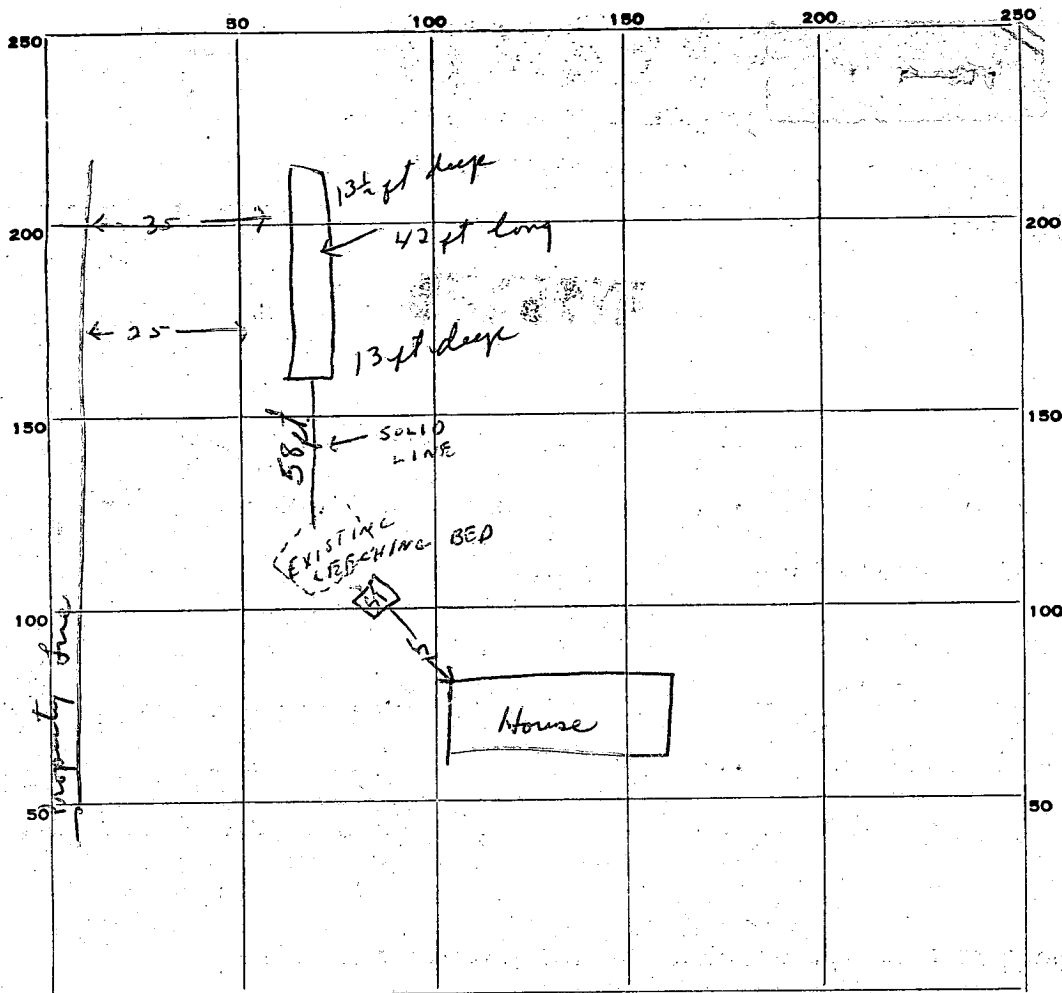

INDICATE NORTH. — NAME ADJOINING ROADWAY AS BASE LINE.

PERMIT CARD _____

SEPTIC TANK, LEVEL _____

CLEANOUTS _____

DISTRIBUTION BOX, LEVEL _____

TILE FIELD, DEPTH 13-13 1/2 FT. TRENCH WIDTH 18 in. FT.

GRAVEL DEPTH 11 ft. IN. TOTAL LENGTH 42 ft. FT.

NUMBER OF TRENCHES 1 ^{absorbent Sidewall} TOTAL BOTTOM AREA 588 sq. ft.

SEEPAGE PITS, INSIDE DIAMETER _____ FT. DEPTH BELOW INLET _____ FT.

ABSORBENT AREA _____ SQ. FT.

REMARKS _____

Absorbent sidewall area starts at 6-7 ft.

DATE SYSTEM APPROVED 5/8/70

INSPECTOR R. Toner

HOWARD COUNTY HEALTH DEPARTMENT

PERMIT-SEWAGE DISPOSAL SYSTEM

Permit No. A69 P00057

District 5

Date 9-19-58

INDEXED

Claude Cissel

is permitted to

Install ☒

Alter ☐

a sewage disposal system located: Clarksville Ridge, Lot No. 4, Rt. 32.

Property Owner Charles Roebuck

Address Rt. 32, Clarksville

Location _____

SPECIFICATIONS:

TILE FIELDS ☐ Length ☐ Width ☐ Depth ☐ Bottom area ☐

SEEPAGE PITS ☒ Number ☐ Inside Diam. ☐ Depth below inlet ☐

Absorbent area ☒ below 5 ft. 699 sq. ft.

SEPTIC TANK CAPACITY ☐ 750 gallon

OTHER: _____

Fee \$1.00


PLANS APPROVED BY: Milton M. Beekman, Sanitarian

Fill septic tank and distribution box with water before calling for inspection.

No work is to be covered until inspected and approved.

Neither the Howard County Commissioners nor the Health Department is responsible for the successful operation of any installation.

A69

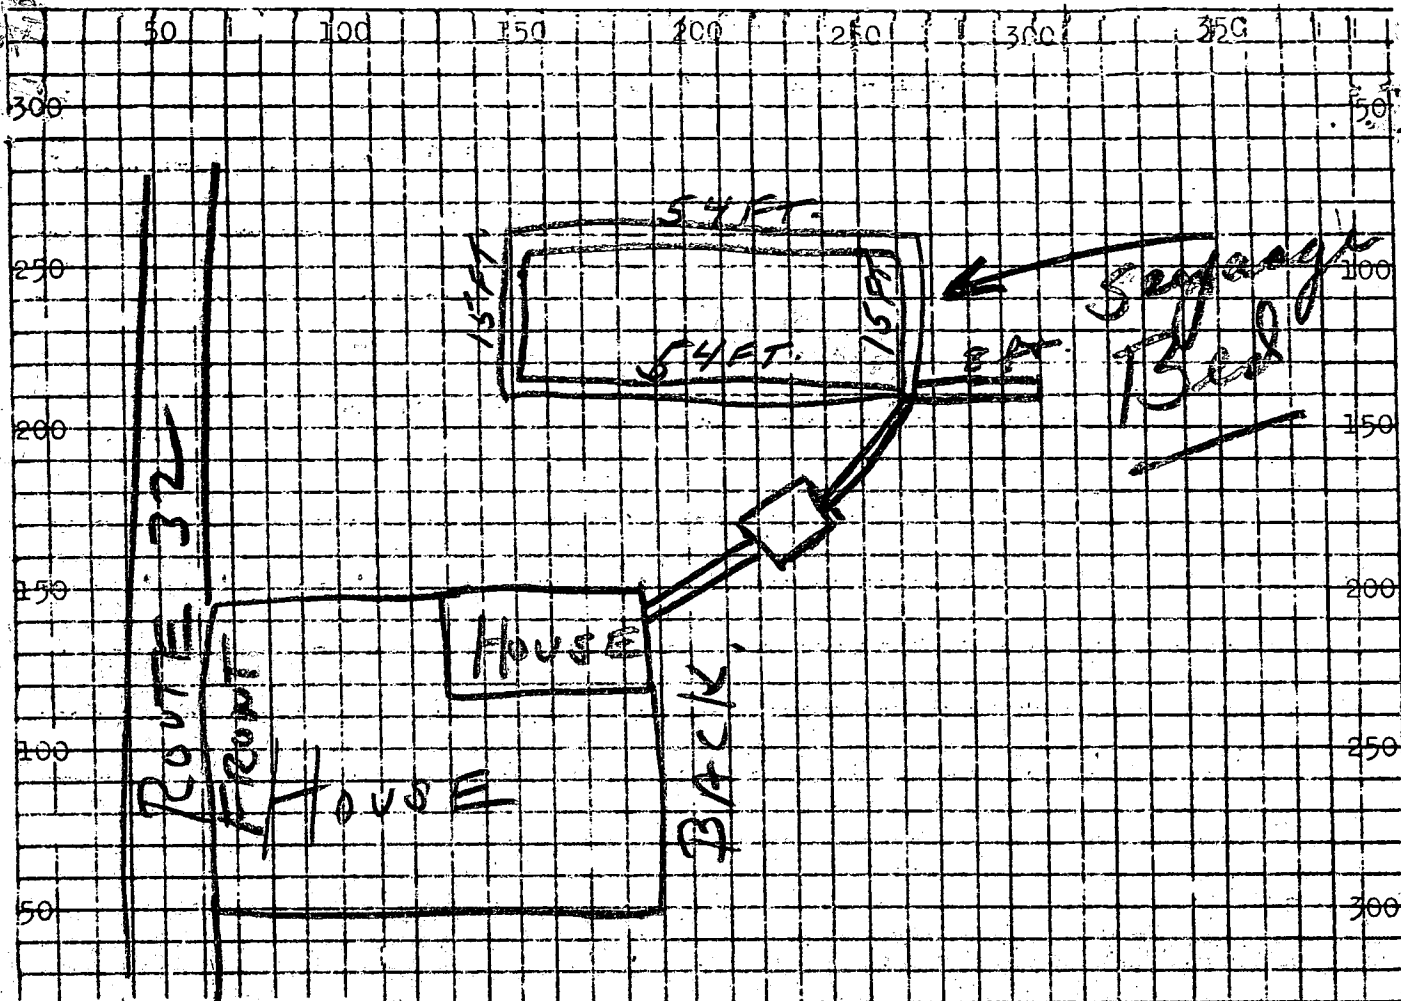

Each square = 10 feet.

Locate system with reference to house and adjoining properties & Perc. Tests.

PERMIT CARD ☐

Septic Tank ☐ Distance from Ground Surface ^{3 ft.} ☐ Filled ☐

Level ☒ Cleanouts (2) ^{one cover top on vent}
^{one stand pipe on vent}

Distribution Box: Filled ☐ Level ☐

Tile Field:

Depth of Tile ☐ ^{4 1/2 ft.} Width of Trenches ☐

Grade Board ☐ Total Length ☐ ^{810 sq ft. bed.}

Gravel Depth ☐ ^{2 ft. under} Fall ☐ ^{2 inches}

No. of Trenches ☐ ^{2 in. over} Backfill on Hand ☐

Seepage Pit:

Inside Diameter ☐ Depth below inlet ☐

Remarks:

Satisfactory at time of inspection

Date System Approved and
Ready for Covering

11-20-58

Inspector

J. Hanning

HOWARD COUNTY HEALTH DEPARTMENT

APPLICATION-SEWAGE DISPOSAL TESTING

750 gal tank
absorption tank 5' below surface
699 sq ft absorption

Application No. A 69

District 5

Date 8-14-58

TO: THE COUNTY HEALTH OFFICER
Ellicott City, Maryland

I, hereby, apply for the necessary tests in order to construct (or re-construct) a sewage disposal system.

PROPERTY OWNER Charles Roebuck

Address Rt. 32, Clarksville Phone _____

LOCATION OF PROPERTY: Subdivision Clarksville Ridge Lot No. 4

Road Rt. 32

OCCUPANT OF PROPERTY Above

Address _____ Phone _____

PERSON TO CONSTRUCT PLANT Claude Cissel

Address Highland Phone _____

SIZE OF LOT 1.1 acre

TYPE OF BUILDING TO BE SERVED Residence

SYSTEM TO SERVE _____ PEOPLE NO. OF BEDROOMS 3

PERMIT NUMBER _____ FEE _____

SIGNATURE OF APPLICANT Charles E. Luscomb


APPROVED BY W.B. 9/18/58 for Dry Wells DATE _____

REJECTED BY James E. Hennigan for tile field DATE 8/19/58

REASONS FOR REJECTION No percolation

A69

FOR TEST FINDINGS, SEE OTHER SIDE.

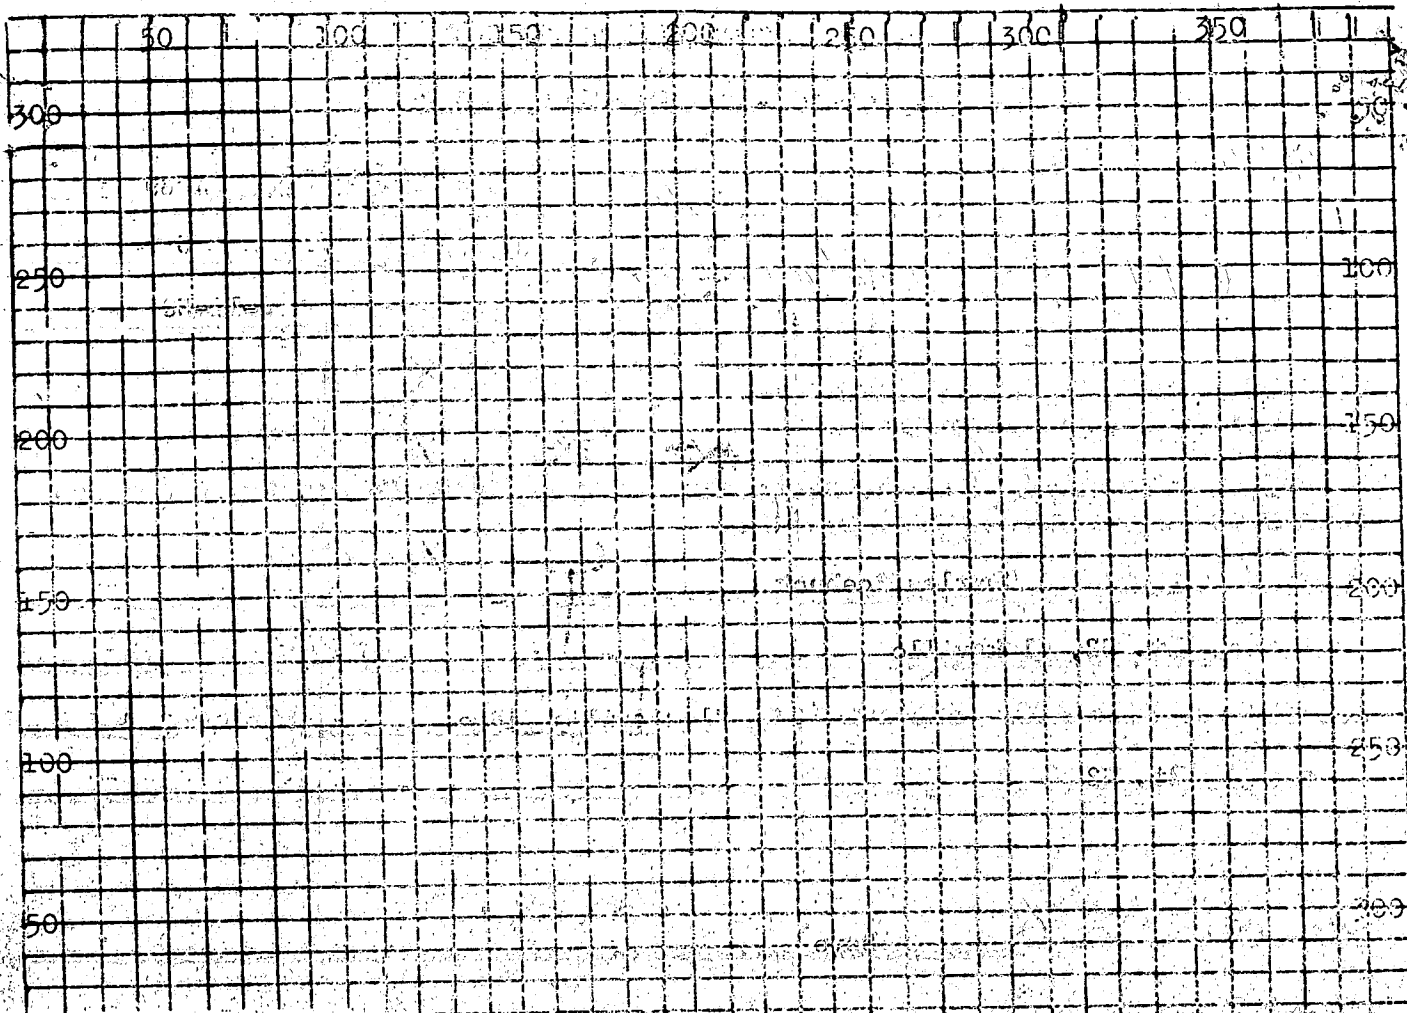

Each square = 10 feet.

Locate system with reference to house and adjoining properties & Perc. Tests.

PERMIT CARD ☐

Septic Tank ☐ Distance from Ground Surface ☐ Filled ☐

Level ☐ Cleanouts ☐ etc.

Distribution Box: Filled ☐ Level ☐

Tile Field:

Depth of Tile ☐

Width of Trenches ☐

Grade Board ☐

Total Length ☐

Gravel Depth ☐

Fall ☐

No. of Trenches ☐

Backfill on Hand ☐

Seepage Pit:


Inside Diameter ☐

Depth below inlet ☐

Remarks:

Date System Approved and
Ready for Covering

Inspector

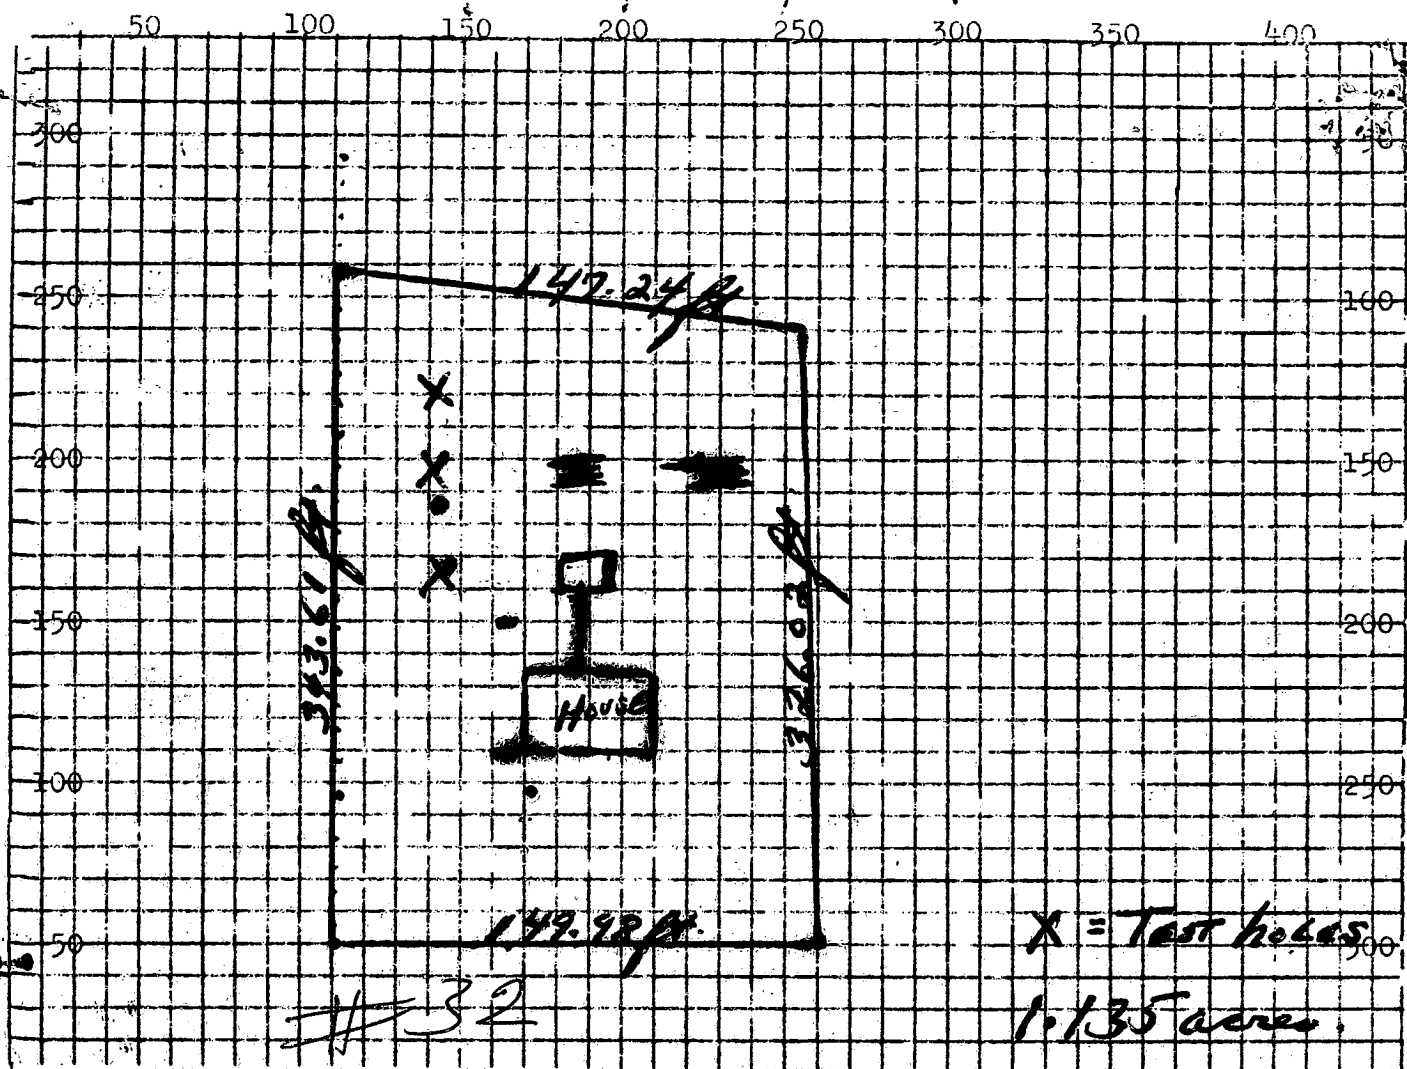

Above: Sketch property showing dimensions, location and numbers of test holes distance to adjoining wells and slope of ground. Each square = 10 ft.

LAST PREVIOUS RAIN _____

RAINFALL FOR YEAR _____

DATE	TEST NO.	TEST DEPTH	PRE-WET 6"		TIME START	TIME STOP	TOTAL TIME
			START	STOP			
8/19/58	1	3 feet	1:21	1:38	1:38	2:20	42 Minutes
8/19/58	2	3 feet	1:25	2:05	2:05	2:45	40 Minutes
8/19/58	3	13 feet	1:29	2:11	2:11	2:55	44 Minutes
9/18/58	4	7'	1:58	2:16	2:16	2:44	28 min

SOIL AUGER FINDING: _____

TEST CONDUCTED BY

James Hennigan

DATE

8/19/58

ALSO, PRESENT

SIGNATURE

By Kuscomb

REMARKS:

TITLE