

1-24-89
3:30 PM
1-25-89
Amplifier

1/27/89
Amplifier

Tax ID - 03-313549

1/24/89 P.C.O.
Not ready
C.B.O.

PERMIT

P 43527
A 39686

SEWAGE DISPOSAL SYSTEM

MARYLAND STATE DEPARTMENT OF HEALTH

DISTRICT 3rd

HOWARD COUNTY
BUREAU OF ENVIRONMENTAL HEALTH
461-9933

INDEXED

DATE 1/20/89

DATE SYSTEM APPROVED 1/27/89

INSPECTOR M. Riffkin

Kastner Plumbing & Heating, Inc. 1/24/89

Kastner Plumbing & Heating, Inc.

IS PERMITTED TO INSTALL X ALTER

ADDRESS 13556 Argo Drive, Dayton, Maryland 21036 PHONE 727-5000

SUBDIVISION Pond View ROAD 2615 Sand Hill Road LOT 6

PROPERTY OWNER Ken Varney

ADDRESS

IF GARBAGE GRINDER IS USED INCREASE SEPTIC TANK CAPACITY BY 50% AND ABSORPTION AREA BY 22%.

GARBAGE GRINDER? YES NO X

SEPTIC TANK CAPACITY 1250 GALLONS NUMBER OF BEDROOMS 4 3 cu

TRENCHES - 180 sq. ft. per bedroom. Trench to be 2 feet wide. Inlet 3 feet below original grade. Bottom maximum depth 7 feet below original grade. Effective area begins at 3 feet below original grade. 4 feet of stone below distribution pipe.

LOCATION - Place the first trench 170 feet up the left (607.88') lot line and 115 feet off the same line as seen when facing the lot from Sand Hill Road. Run trenches on contour toward the right lot line.

NOTE - No trench to exceed 100 feet in length. Provide 6" - 8" diameter cleanout and cap to grade or above on septic tank. ok/cw

PLANS APPROVED BY Sid Abel DATE 8/15/88

COVER NO WORK UNTIL INSPECTED AND APPROVED

NEITHER THE HOWARD COUNTY COUNCIL NOR THE HEALTH DEPARTMENT IS RESPONSIBLE FOR THE SUCCESSFUL OPERATION OF ANY SYSTEM

NOTE: CLEANOUT REQUIRED EVERY 70 FEET OF SEWER LINE AND/OR AT 90° SWEEPS IN LINES FROM HOUSE TO DRAIN FIELDS

NOTE: ALL PARTS OF SEPTIC SYSTEMS (I.E. TANK, DISTRIBUTION BOX, TRENCHES) TO BE 100 FEET FROM WELL (UNLESS OTHERWISE SPECIFICALLY AUTHORIZED)

NOTE: IF DEEP TRENCH(IES) ARE USED CALL FOR INSPECTION BEFORE AND AFTER PLACING GRAVEL IN TRENCH(IES)

NOTE: NO DRY WELL SHALL EXCEED 15 FOOT IN DIAMETER NO ABSORPTION TRENCH TO EXCEED 100 FEET IN LENGTH.

NOTE: ALL PIPE FROM HOUSE TO SEPTIC TANK MUST BE CAST IRON OR SCHEDULE 40 PVC OR ABS

PERMIT VOID AFTER TWO YEARS


NOTE: INSTALL STAND PIPE ON SEPTIC TANK AND DRY WELL. STAND PIPES MUST BE 6 INCHES IN DIAMETER. CAST IRON, CONCRETE OR TERRA COTTA OR PVC OR ABS ACCEPTED. IF TOP OF SEPTIC TANK IS DEEPER THAN 3 FEET, MANHOLE TO GRADE REQUIRED

NOTE: DISTRIBUTION BOXES MUST HAVE BAFFLES

*INSTALLER IS RESPONSIBLE FOR OBTAINING FINAL APROVAL ON THIS PERMIT

*CALL 461-9933 FOR INSPECTION OF SEPTIC SYSTEMS.

A 39686

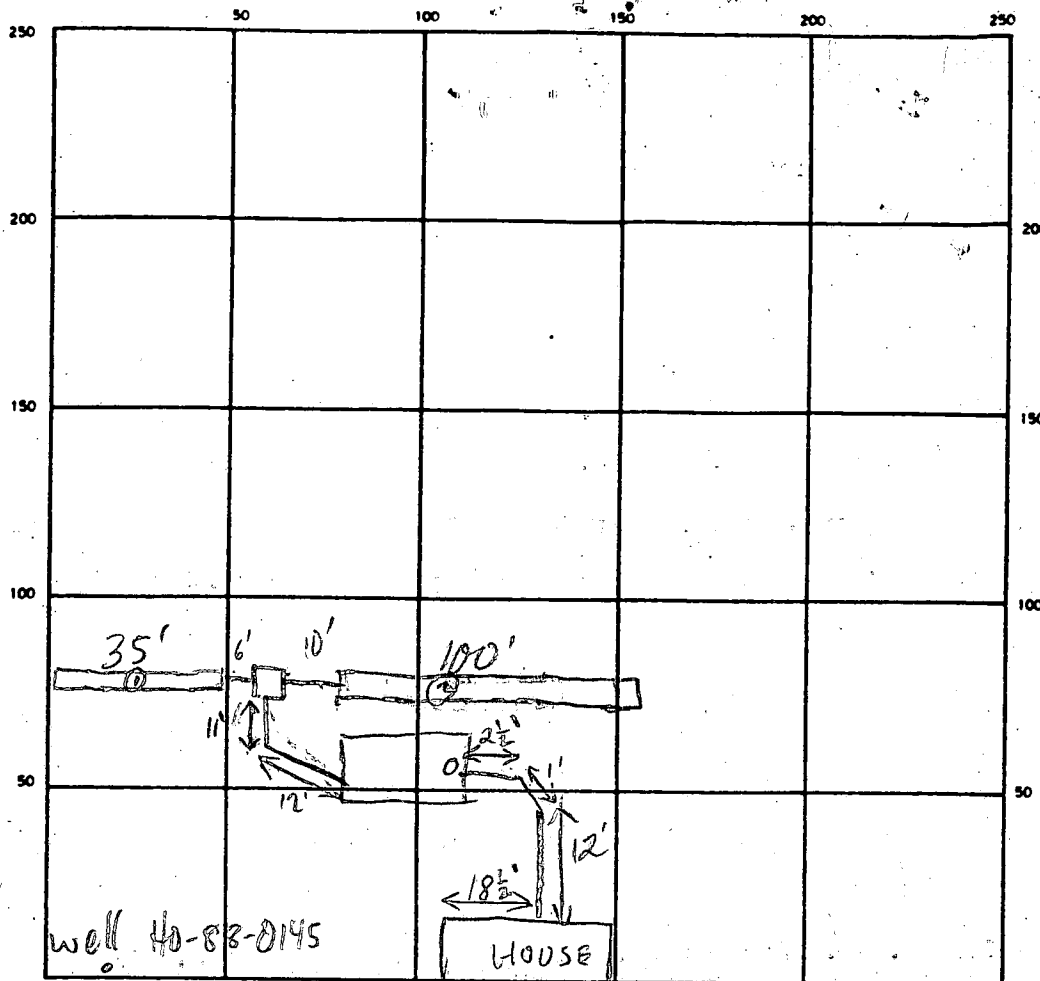

INDICATE NORTH - NAME ADJOINING ROADWAY AS BASE LINE

SAND HILL RD

SEPTIC TANK. LEVEL OK (8' x 4') CLEANOUTS OK S.T.

DISTRIBUTION BOX. LEVEL Box IN BAFFLE OK

DRAIN FIELD/TILE FIELD. DEPTH 12.7 FT. TRENCH WIDTH 2 FT. INLET DEPTH 3 FT.

EFFECTIVE GRAVEL DEPTH 4 FT. TOTAL LENGTH 335 FT.

NUMBER OF TRENCHES 2 ONE SIDEWALL/BOTTOM AREA 4 SQ. FT.

DRYWELL INSIDE DIAMETER 18 1/2 FT. EFFECTIVE DEPTH BELOW INLET 4 FT.

ABSORBENT AREA 540 SQ. FT.

REMARKS (Late P.M.) 1/24/89 Partial - existing trench, needs to be 2' ± deeper below hill 1/2' Mr. Kastner to call for inspection on trench on 1/25/89 A.M. + P.M. - possibly C.B.D. permit card / road entrance. C.B.D.; 1/24/89 Nothing approach. 1/25/89 TRENCHES DUG READY FOR STONE, WILL CALL FOR FINAL MR 1/26/89 TRENCHES OK TO COVER, CALL FOR FINAL MR 1/27/89 ALL WORK OK TO COVER

DATE SYSTEM APPROVED 1/27/89 INSPECTOR M. Rifkin

APPLICATION

PERCOLATION TESTING

A 39686

P _____

HOWARD COUNTY HEALTH DEPARTMENT
BUREAU OF ENVIRONMENTAL HEALTH
P.O. BOX 476 ELLICOTT CITY, MARYLAND 21043
TELEPHONE: 461-9933

DISTRICT _____

DATE 7/20/87

TO: THE COUNTY HEALTH OFFICER
ELLICOTT CITY, MARYLAND

I HEREBY APPLY FOR THE NECESSARY TEST IN ORDER TO CONSTRUCT (OR RECONSTRUCT) A SEWAGE DISPOSAL SYSTEM.

PROPERTY OWNER CHARLES L. WRIGHT Ken Varney

ADDRESS 12000 FREDERICK RD. 21043 PHONE 988-9275

PROSPECTIVE BUYER _____

ADDRESS _____ PHONE _____

PROPERTY LOCATION:

SUBDIVISION POND VIEW LOT NO. New 6 Resubdivision LOT 4

ROAD AND DESCRIPTION ~~RT 144~~ 2615 SAND HILL RD. (4B)

TAX MAP #16 PARCEL # 6

SIZE OF LOT _____ TYPE BLDG. SFD
(SINGLE FAMILY DWELLING OR COMMERCIAL)

THE SYSTEM INSTALLED UNDER THIS APPLICATION IS ACCEPTABLE ONLY UNTIL PUBLIC FACILITIES BECOME AVAILABLE. I FULLY UNDERSTAND THE

FEE CONNECTED WITH THE FILING OF THIS PERC TEST APPLICATION IS NON-REFUNDABLE UNDER ANY CIRCUMSTANCES. I ALSO AGREE TO COMPLY

WITH ALL M.O.S.H.A. REQUIREMENTS IN TESTING THIS LOT. Charles L. Wright
(SIGNATURE OF APPLICANT)

APPROVED BY Sidy Alul FOR Deep trenches DATE 8-15-88

REJECTED BY _____ FOR _____ DATE _____

HOLD PENDING FURTHER TESTS _____ DATE _____

REASONS FOR REJECTION OR HOLDING 8/14/87 PERC OK HOLD FOR CERTIFIED

HOLD 3 PLAT

BLDG. PERMIT SIGNED
AND RETURNED 9-14-88



BP 20694 SAL

THIS IS NOT A PERMIT

Lot 6
SAND HILL RD

LOT 6

X 4min
160#15R
Inlet 3"
Bottom 8"

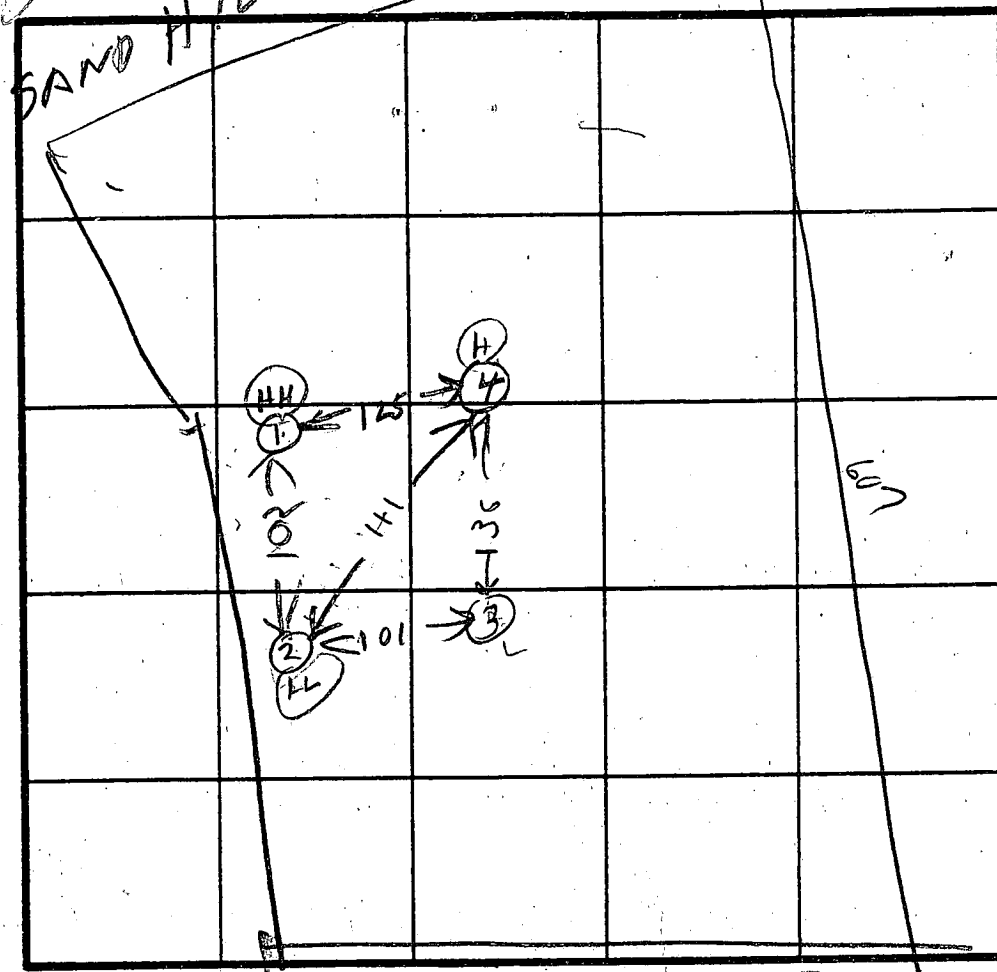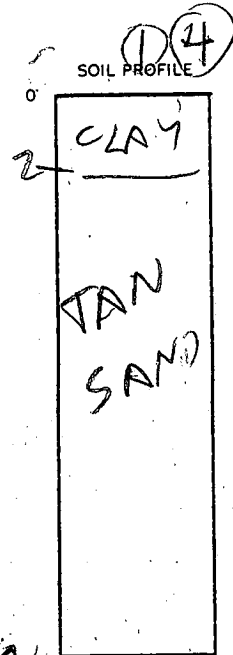

INDICATE NORTH - NAME ADJOINING ROADWAY AS BASE LINE.



DATE	TEST NO.	DEPTH	PRE-WET		TEST - 1" DROP		TIME
			START	STOP	START	STOP	
8/13/07	1D	6	258	301	301	304	3
	1S	3	300	302	302	304	7
8/13/07	1V	12	OK				
	2S	3.5	311	314	314	318	4
	2V	14	015				
	3S	3.5	320	322	322	328	6
	3V	13	OK				
	4V	11.5	OK				

REMARKS

TYPE OF SOIL
TESTED BY R. HODGES
BACKHOE { PROP KETTERMAN
ALSO PRESENT DAVE
OWNER CHARLES WRIGHT

HOUSE:

FIRST FLOOR 504.5 ✓
BASEMENT 495.5 ✓
INVERT 492.0 ✓

SEPTIC TANK:

EXISTING GRADE 493.1 ✓
PROPOSED GRADE 494.0 ✓
INVERT IN 490.0 ✓
INVERT OUT 489.8


DISTRIBUTION BOX:

EXISTING GRADE 491.0 ✓
INVERT IN 487.7 ✓
INVERT OUT 487.6 ✓

TRENCHES:

	#1	#2
EXISTING GRADE	490.5 ✓	488.0 ✓
INVERT	487.5 ✓	485.0 ✓
BOTTOM	483.5 ✓	481.0 ✓
STONE	4.0 ✓	4.0 ✓
LENGTH	100.0	60.0 ✓
WIDTH	2.0 ✓	2.0 ✓

OK FOR
48A
NO DISP.
HOUSE
SA

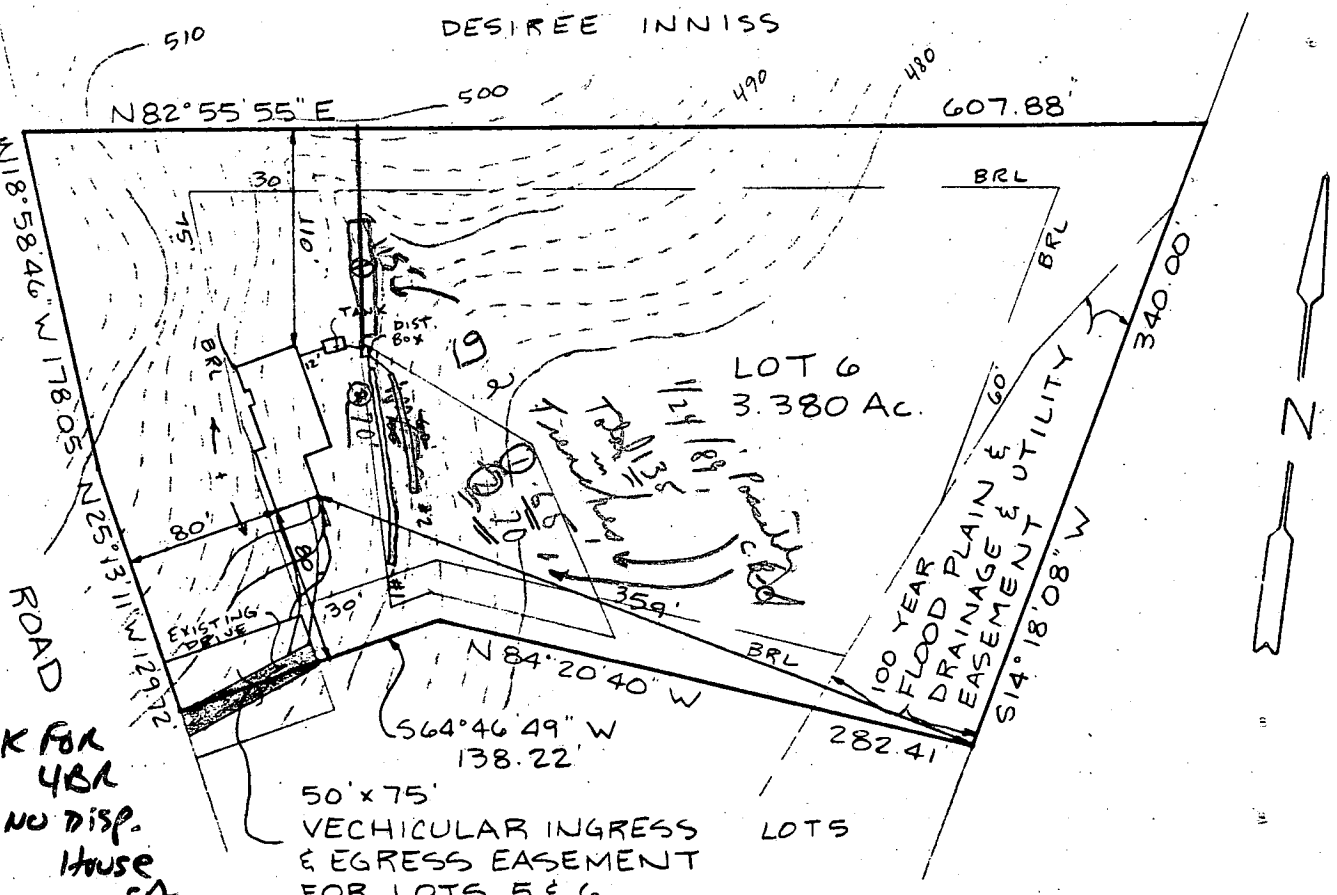

I certify that the above measurements and elevations are actual and true for this property.

J. Carl Hudgins
J. Carl Hudgins

8/15/88

elevations ok

No well

BLDG. PERMIT SIGNED
AND RETURNED 9-14-88

BP 20684
SCL

PLOT PLAN
LOT 6
POND VIEW

3rd ELECTION DISTRICT
HOWARD COUNTY, MD.
SCALE 1"=100'
DATE 27JULY88

COORDINATE SCHEDULE		
Nos.	North	East
1	533,076.76	819,658.21
2	533,085.57	819,612.79
3	533,151.72	819,573.74
4	533,253.84	819,559.75
5	533,346.67	819,522.55
6	533,540.11	819,437.28
7	533,766.46	819,330.68
8	533,934.83	819,272.77
9	534,009.63	819,876.03

Md. State Grid System based on
Ho. Co. Mon. # 3437003 & 3437004

NOTES:

- Private Sewer Easement of approx. 10,000 sq. ft. as req'd. by the Md. State Dept. of Health and Mental Hygiene for individual sewage disposal. Improvements of any nature in this area are restricted until public sewage is available. This easement shall become null and void upon connection to a public sewage system. The County Health Officer shall have the authority to grant variances for encroachments into the private sewer easement. Recordation of a modified sewage easement shall not be necessary.
- Subject property Zoned R as per B-2-85 Comprehensive Zoning Plan.
- The lots shown hereon comply with the min. ownership width and lot areas as req'd. by the Md. State Dept. of Health and Mental Hygiene.
- Subject to VP-88-08.

TABULATION:

TOTAL NO. OF LOTS to be recorded	2
TOTAL AREA OF LOTS	6.426 Acres
TOTAL AREA OF ROADWAY incl. widening strips	0
TOTAL AREA OF SUBDIVISION	6.426 Acres

N 534,000

E 819,000

E 819,000

N 533,000

50' x 75' VEHICULAR
INGRESS & EGRESS
EASEMENT FOR LOTS
5 & 6


SAND HILL ROAD

DESIREE INNIS
1099/607
P. 292

MD. RTE. 144

N 534,000

E 820,000

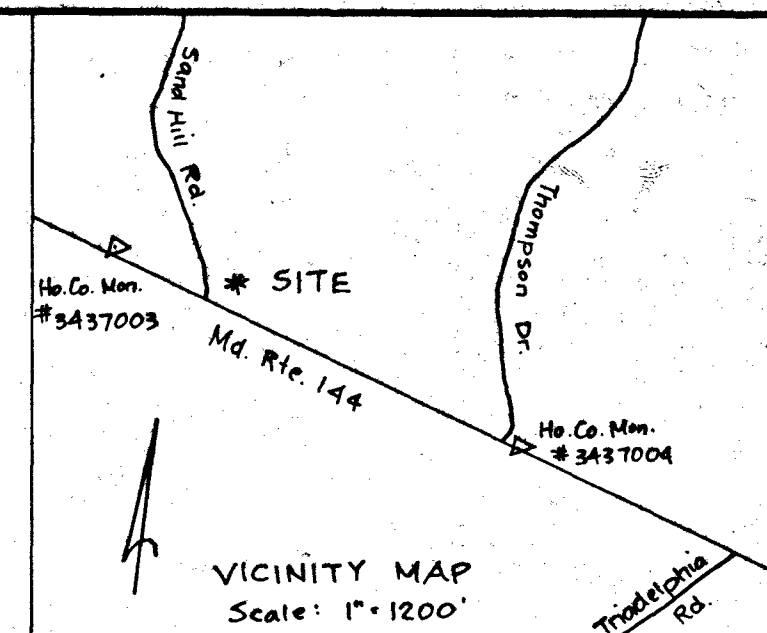

OWNER & DEVELOPER
CHARLES L. WRIGHT
12000 FREDERICK ROAD
ELLICOTT CITY, Md. 21043

ASSOCIATES, INC.
SURVEYING & LAND DEVELOPMENT
16205 Old Frederick Road
Mt. Airy, Maryland 21771
(501) 442-2031

APPROVED: FOR Private WATER and Private SEWERAGE SYSTEMS, IN CONFORMANCE WITH THE MASTER PLAN OF WATER AND SEWERAGE FOR HOWARD CO., HOWARD CO. DEPT. OF HEALTH AND MENTAL HYGIENE

County Health Officer _____ Date _____

APPROVED: HOWARD COUNTY OFFICE OF PLANNING AND ZONING.

Director _____ Date _____

APPROVED: FOR STORM DRAINAGE SYSTEMS, PUBLIC-WATER and PUBLIC SEWER, and PUBLIC ROADS, HOWARD CO. DEPT. OF PUBLIC WORKS.

Director _____ Date _____


OWNER'S DEDICATION

I, (We) CHARLES L. WRIGHT AND MARLENE A. WRIGHT owner(s) of the property shown and described hereon, hereby adopt this plan of subdivision and in consideration of the approval of this Final Plat by the Office of Planning and Zoning, establish the min. Bldg. Restriction Lines and grant unto Howard Co., Md., its successors and assigns, (1) the right to lay, construct and maintain sewers, drains, water pipes and other municipal utilities and services, in and under all roads and street rights-of-way and the specific easement areas shown hereon; (2) the right to require dedication for public use the beds of the streets and/or roads and floodplains and open space where applicable, and for good and other valuable consideration, hereby grant the right and option to Howard County, Md., to acquire the fee simple title to the beds of the streets and/or roads and floodplains, storm drainage facilities and open space where applicable; (3) the right to require dedication of waterways and drainage easements for the specific purpose of their construction, repair and maintenance; and (4) that no bldg. or similar structure of any kind shall be erected on or over the said easements and rights-of-way.

Owner Charles L. Wright, Marlene A. Wright Date 10/28/87
Witness J. Carl Hudgins Date 10/29/87

SURVEYOR'S CERTIFICATE

I hereby certify that the Final Plat shown hereon is correct, that it is a subdivision of PART the lands conveyed by LEILA E. THOMAS to CHARLES L. AND MARLENE A. WRIGHT deed dated JUNE 13, 1985 and recorded in the Land Records of Howard County in Liber 1357 Folio 419, and that all monuments are in place, or will be in place prior to the acceptance of the streets in the subdivision by Howard Co. as shown, in accordance with the Annotated Code of Maryland, as amended.

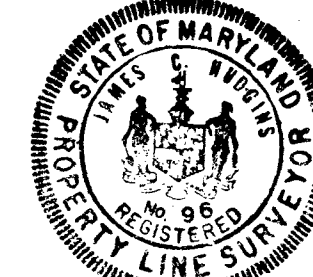




Surveyor J. Carl Hudgins PLS #96
Date 10-28-87

POND VIEW

LOTS 5 and 6
A Resubdivision of Lot 4
Tax Map 16 Parcel 6

F-88-118
Sept 8

3rd Election District, Howard County, Md.
Scale: 1"=100' Date: October, 1987

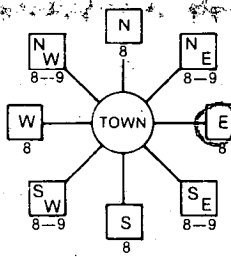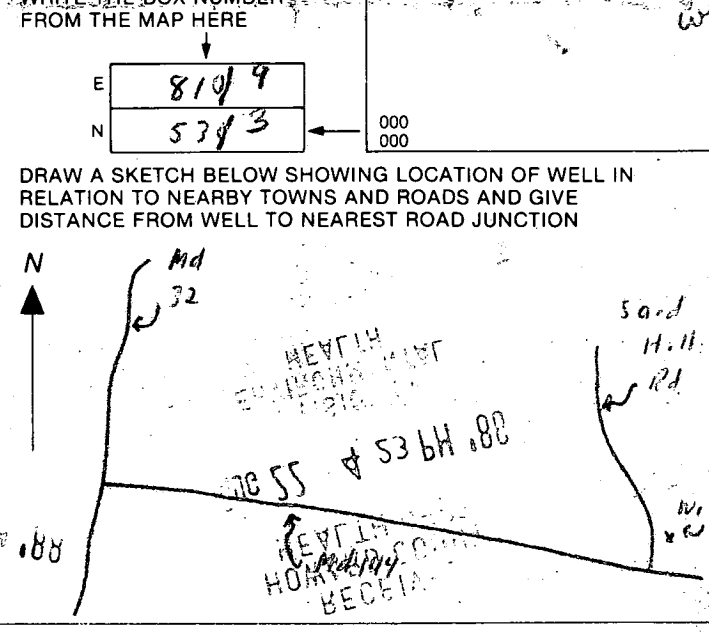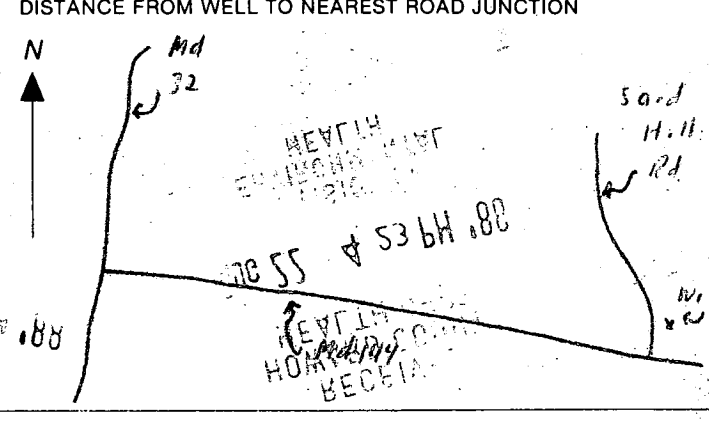B 1 9245 <small>(THIS NUMBER IS TO BE PUNCHED IN COLS. 3-6 ON ALL CARDS)</small>	SEQUENCE NO. (DP USE ONLY)	STATE OF MARYLAND PERMIT TO DRILL WELL please print or type	STATE PERMIT NUMBER 40-88-0145 <small>fill in this form completely</small>
Date Received (APA) 082388 OWNER INFORMATION 15 Last Name Varnancy Owner Kenna L. First Name L. 36 Street or RFD 10401 Hickory Ridge 57 Town Columbia 70 State MD 72 Zip 21044		B 3 LOCATION OF WELL 8 COUNTY Howard 21 23 SUBDIVISION Pond View 42 SECTION 44 46 LOT 6 48 50 52 NEAREST TOWN West Friendship 71 MILES FROM TOWN (enter 0 if in town) 1 73 76 77 78 MI	
DRILLER INFORMATION Driller's Name Robert W. Reichert 77 License No. 80 Firm Name W. Reichert, Inc. Address 1772 Baltimore Pike, Hanover, Pa. 17331 Signature Robert W. Reichert Date 8/17/88		B 4 1 2 DIRECTION OF WELL FROM TOWN (CIRCLE BOX)  11 NEAR WHAT ROAD Sand Hill Rd. 30 ON WHICH SIDE OF ROAD (CIRCLE APPROPRIATE BOX) NORTH <input checked="" type="checkbox"/> WEST <input type="checkbox"/> EAST <input type="checkbox"/> SOUTH <input type="checkbox"/> 34 20 37 DISTANCE FROM ROAD ENTER FT or MI FT 38 39	
B 2 WELL INFORMATION 1 2 APPROX. PUMPING RATE (GAL. PER MIN.) 5 8 12 AVERAGE DAILY QUANTITY NEEDED (GAL. PER DAY) 500 14 20		NOT TO BE FILLED IN BY DRILLER - HEALTH DEPARTMENT APPROVAL COUNTY NAME Howard COUNTY NO. A-39686 STATE SIGNATURE _____ INSERT S. <input type="checkbox"/> 41 DATE ISSUED 082988 CO SIGNATURE Sally Abel EXP. DATE 02-28-89 NORTH GRID 533000 50 55 EAST GRID 0819000 57 63	
USE FOR WATER (CIRCLE APPROPRIATE BOX) <input checked="" type="checkbox"/> HOME (SINGLE OR DOUBLE HOUSEHOLD UNIT ONLY) <input type="checkbox"/> FARMING (LIVESTOCK WATERING & AGRICULTURAL IRRIGATION) <input type="checkbox"/> INDUSTRIAL, COMMERCIAL, STATE AND FEDERAL GOV. OTHER (REQUIRES APPROPRIATION PERMIT) <input type="checkbox"/> PUBLIC OR PRIVATE WATER COMPANY (REQUIRES APPROPRIATION PERMIT AND STATE HEALTH DEPARTMENT APPROVAL) <input type="checkbox"/> TEST, OBSERVATION, MONITORING (MAY REQUIRE APPROPRIATION PERMIT)		SHOW MAJOR FEATURES OF BOX & LOCATE WELL WITH AN X SOURCES OF DRILLING WATER 1. Approved well 2. 3. WRITE THE BOX NUMBER FROM THE MAP HERE 	
APPROXIMATE DEPTH OF WELL 250 24 28 FEET APPROXIMATE DIAMETER OF WELL _____ NEAREST INCH		METHOD OF DRILLING (circle one) BORED (or Augered) <input type="checkbox"/> JETTED <input type="checkbox"/> Jetted & DRIVEN <input type="checkbox"/> 30 AIR-ROTary <input checked="" type="checkbox"/> AIR-PERCussion <input type="checkbox"/> ROTARY (Hydraulic Rotary) 37 CABLE <input type="checkbox"/> REVERSE-ROTary <input type="checkbox"/> DRIVE-POINT <input type="checkbox"/> other _____	
REPLACEMENT OR DEEPEMED WELLS (CIRCLE APPROPRIATE BOX) <input checked="" type="checkbox"/> THIS WELL WILL NOT REPLACE AN EXISTING WELL <input type="checkbox"/> THIS WELL WILL REPLACE A WELL THAT WILL BE ABANDONED AND SEALED 39 <input type="checkbox"/> THIS WELL WILL REPLACE A WELL THAT WILL BE USED AS A STANDBY <input type="checkbox"/> THIS WELL WILL DEEPEMED AN EXISTING WELL PERMIT NUMBER OF WELL TO BE REPLACED OR DEEPEMED (IF AVAILABLE) 41 _____ 52		DRAW A SKETCH BELOW SHOWING LOCATION OF WELL IN RELATION TO NEARBY TOWNS AND ROADS AND GIVE DISTANCE FROM WELL TO NEAREST ROAD JUNCTION 	
Not to be filled in by driller (OEP USE ONLY)			
APPROX. PERMIT NUMBER _____ 54 63 FORCE SA WRITE INITIALS IN BOX PERMIT No. 40-88-0145 70 71 72 73 74 75 76 77 78 79			
SPECIAL CONDITIONS			

9/9/88
1200

- ① Location 01
- ② 47 ft. Canyon
- ③ 41 ft open hole measured with
string

RECEIVED
HOWARD COUNTY
HEALTH DEPT
AUG 22 4 23 PM '88
ENVIRONMENTAL
HEALTH

RECEIVED
HOWARD COUNTY
HEALTH DEPT
AUG 22 8 58 AM '88
ELICOTT CITY, MD

C1 0647 SEQUENCE NO. (DENV USE ONLY)

(THIS NUMBER IS TO BE PUNCHED IN COLS. 3-6 ON ALL CARDS)

STATE OF MARYLAND
WELL COMPLETION REPORTFILL IN THIS FORM COMPLETELY
PLEASE PRINT OR TYPETHIS REPORT MUST BE SUBMITTED WITHIN
45 DAYS AFTER WELL IS COMPLETED.COUNTY
NUMBER A-39686

DATE Received

DATE WELL COMPLETED

Depth of Well

PERMIT NO.
FROM "PERMIT TO DRILL WELL"

8 13

090988

22 300 26
(TO NEAREST FOOT)

28 29 30 31 32 33 34 35 36 37

OWNER

VACCA

KEWNA

STREET OR RFD

last name

SAND 144

Rd.

first name

(TOWN

W. FRIENDSHIP

SUBDIVISION

ROAD View

SECTION

LOT

6

WELL LOG

Not required for driven wells

STATE THE KIND OF FORMATIONS
PENETRATED, THEIR COLOR, DEPTH,
THICKNESS AND IF WATER BEARINGDESCRIPTION (Use
additional sheets if needed)

FEET

FROM

TO

Check
if water
bearingrolling stone
gravel

0

7'

brown shale

7'

56'

brown & gray
shale

56'

65'

water

brown & gray
shale

65'

127'

water

flat & gray
sandstone

127'

215'

water

flat & gray
sandstone

215'

291'

water

flat & gray
sandstone

291'

300'

GROUTING RECORD

WELL HAS BEEN GROUTED
(Circle Appropriate Box)

yes

Y

no

N

TYPE OF GROUTING MATERIAL

CEMENT **CM**BENTONITE CLAY **BC**

NO. OF BAGS 19 NO. OF POUNDS 1824

GALLONS OF WATER 114

DEPTH OF GROUT SEAL (to nearest foot)

from 0 TOP 52 ft. to 41 BOTTOM 58 ft.
(enter 0 if from surface)casing
types
insert
appropriate
code
below

CASING RECORD

ST**CO**

STEEL CONCRETE

PL**OT**

PLASTIC OTHER

MAIN Nominal diameter Total depth
CASING top (main) casing of main casing
TYPE (nearest inch) (nearest foot)

5 6 1 2 3 4 5 6 7 8 9 10

E
A
C
H
C
A
S
I
N
G

OTHER CASING (if used)

diameter depth (feet)

inch from to

screen type
or open hole
insert
appropriate
code
below

SCREEN RECORD

ST**BR****HO**

STEEL

BRASS

OPEN

PL

BRONZE

HOLE

OT

PLASTIC

OTHER

C2

DEPTH (nearest ft.)

1 2 3 100

SLOT SIZE 1 2 3

DIAMETER OF SCREEN (NEAREST INCH)

from to

GRAVEL PACK

IF WELL DRILLED WAS
FLOWING WELL INSERT
F IN BOX 68

OEP USE ONLY

(NOT TO BE FILLED IN BY DRILLER)

T

(E.R.O.S.)

WQ

70

72

74 75 76

TELESCOPE
CASINGLOG
INDICATOR

OTHER DATA

C3 0-18-0145

PUMPING TEST

HOURS PUMPED (nearest hour) 5

PUMPING RATE (gal. per min. to nearest gal.) 4

METHOD USED TO
MEASURE PUMPING RATE. with bucket

WATER LEVEL (distance from land surface)

BEFORE PUMPING 45

WHEN PUMPING 245

TYPE OF PUMP USED (for test)

A air **P** piston **T** turbine**C** centrifugal **R** rotary **O** other (describe below)**J** jet **S** submersible

PUMP INSTALLED

DRILLER WILL INSTALL PUMP YES NO

(CIRCLE) (YES or NO)

IF DRILLER INSTALLS PUMP, THIS SECTION

MUST BE COMPLETED FOR ALL WELLS

EXCEPT HOME USE

TYPE OF PUMP INSTALLED

PLACE (A,C,J,P,R,S,T,O)

IN BOX - SEE ABOVE:

CAPACITY:

GALLONS PER MINUTE (to nearest gallon)

PUMP HORSE POWER

PUMP COLUMN LENGTH (nearest ft.)

CASING HEIGHT (circle appropriate box and enter casing height)

+ above**-** below

LAND SURFACE

(nearest foot)

LOCATION OF WELL ON LOT

SHOW PERMANENT STRUCTURE SUCH AS

BUILDING, SEPTIC TANKS, AND/OR

LANDMARKS AND INDICATE NOT LESS

THAN TWO DISTANCES

(MEASUREMENTS TO WELL)

CIRCLE APPROPRIATE LETTER
A A WELL WAS ABANDONED AND SEALED
WHEN THIS WELL WAS COMPLETED

E ELECTRIC LOG OBTAINED

P TEST WELL CONVERTED TO PRODUCTION
WELLI HEREBY CERTIFY THAT THIS WELL HAS BEEN CONSTRUCTED IN
ACCORDANCE WITH COMAR 10.17.13 "WELL CONSTRUCTION"
AND IN CONFORMANCE WITH ALL CONDITIONS STATED IN THE
ABOVE CAPTIONED PERMIT, AND THAT THE INFORMATION
PRESENTED HEREIN IS ACCURATE AND COMPLETE TO THE BEST
OF MY KNOWLEDGE.

DRILLERS IDENT. NO. 353

DRILLERS SIGNATURE

(MUST MATCH SIGNATURE ON APPLICATION)

SITE SUPERVISOR (sign. of driller or journeyman
responsible for sitework if different from permittee)

COUNTY