

Tax ID - 05 - 359651

PERMIT

SEWAGE DISPOSAL SYSTEM

MARYLAND STATE DEPARTMENT OF HEALTH

P 39254
REPAIR
A 00874

DISTRICT 5th

HOWARD COUNTY

BUREAU OF ENVIRONMENTAL HEALTH

461-9933

DATE 4/27/87

DATE SYSTEM APPROVED 4-28-87

INSPECTOR S. Abel

INDEXED

Norman Collins

IS PERMITTED TO INSTALL ALTER X

ADDRESS _____ PHONE _____

SUBDIVISION Holiday Hills ROAD 10518 Vista Road LOT 29

PROPERTY OWNER Robert N. McKeen

ADDRESS _____

IF GARBAGE GRINDER IS USED INCREASE SEPTIC TANK CAPACITY BY 50% AND ABSORPTION AREA BY 22%.

GARBAGE GRINDER? YES _____ NO _____

SEPTIC TANK CAPACITY 1000 GALLONS NUMBER OF BEDROOMS 3

REPAIR - CALL FOR INSPECTION WHEN GROUND IS OPENED UP SO SANITARIAN CAN RECOMMEND

REPAIR.

PLANS APPROVED BY C. Williams DATE 4/27/87

COVER NO WORK UNTIL INSPECTED AND APPROVED.

NEITHER THE HOWARD COUNTY COUNCIL NOR THE HEALTH DEPARTMENT IS RESPONSIBLE FOR THE SUCCESSFUL OPERATION OF ANY SYSTEM.

NOTE: CLEANOUT REQUIRED EVERY 70 FEET OF SEWER LINE AND/OR AT 90° SWEEPS IN LINES FROM HOUSE TO DRAIN FIELDS.

NOTE: ALL PARTS OF SEPTIC SYSTEMS (I.E., TANK, DISTRIBUTION BOX, TRENCHES) TO BE 100 FEET FROM WELL. (UNLESS OTHERWISE SPECIFICALLY AUTHORIZED)

NOTE: IF DEEP TRENCHES ARE USED CALL FOR INSPECTION BEFORE AND AFTER PLACING GRAVEL IN TRENCHES.

NOTE: NO DRY WELL SHALL EXCEED 15 FOOT IN DIAMETER. NO ABSORPTION TRENCH TO EXCEED 100 FEET IN LENGTH.

NOTE: ALL PIPE FROM HOUSE TO SEPTIC TANK MUST BE CAST IRON OR SCHEDULE 40 PVC OR ABS.

PERMIT VOID AFTER TWO YEARS.

NOTE: INSTALL STAND PIPE ON SEPTIC TANK AND DRY WELL. STAND PIPES MUST BE 6 INCHES IN DIAMETER. CAST IRON, CONCRETE OR TERRA COTTA OR PVC OR ABS ACCEPTED. IF TOP OF SEPTIC TANK IS DEEPER THAN 3 FEET, MANHOLE TO GRADE REQUIRED.


NOTE: DISTRIBUTION BOXES MUST HAVE BAFFLES.

*INSTALLER IS RESPONSIBLE FOR OBTAINING FINAL APPROVAL ON THIS PERMIT

*CALL 461-9933 FOR INSPECTION OF SEPTIC SYSTEMS.

EH - 2-1186

1039054

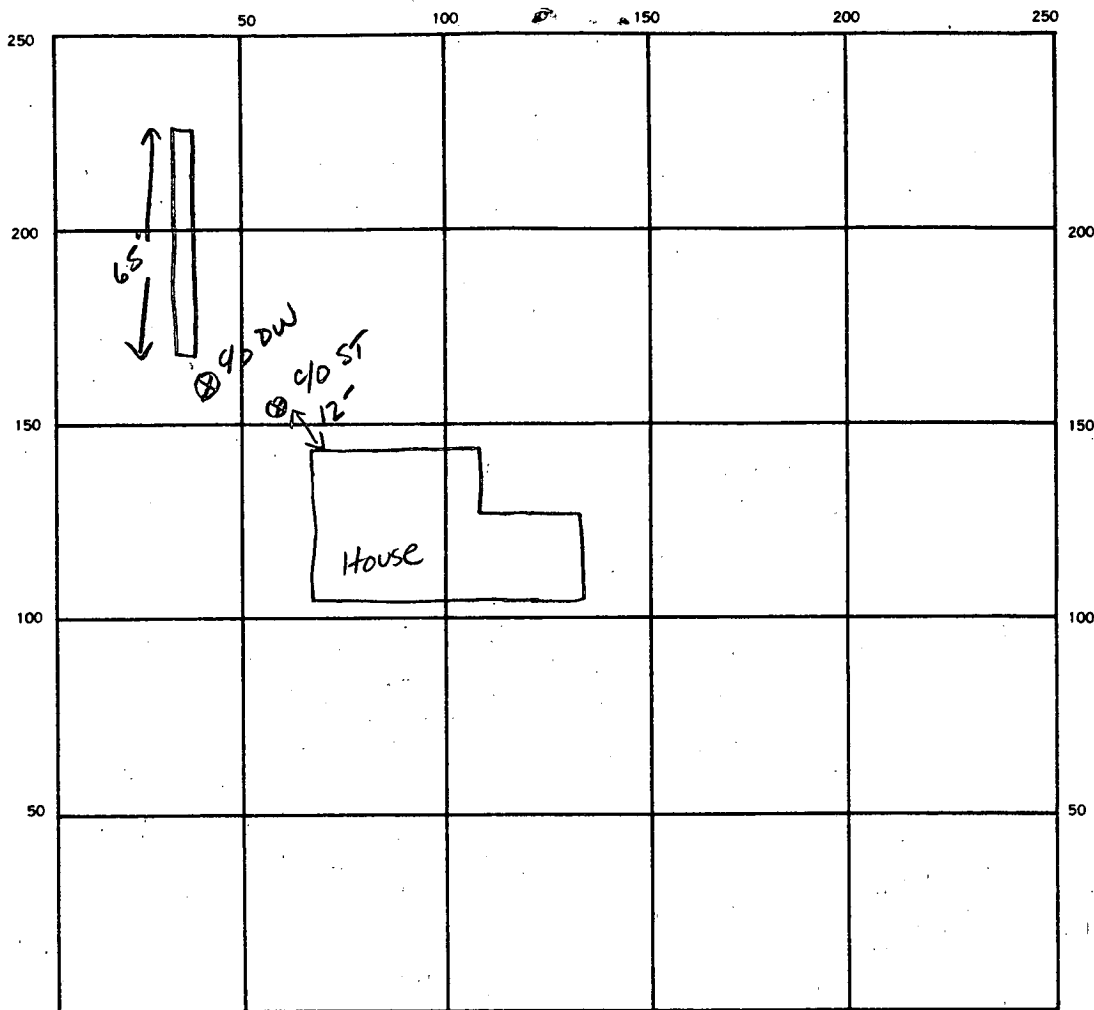

INDICATE NORTH. — NAME ADJOINING ROADWAY AS BASE LINE.

VISTA Rd.

SEPTIC TANK. LEVEL EXISTING CLEANOUTS EXISTING

DISTRIBUTION BOX. LEVEL _____

DRAIN FIELD/TILE FIELD. DEPTH 9 FT. TRENCH WIDTH 2 FT. INLET DEPTH 4 FT.

EFFECTIVE GRAVEL DEPTH 5 FT. TOTAL LENGTH 65 FT.

NUMBER OF TRENCHES 1 ONE SIDEWALL BOTTOM AREA 325 SQ. FT.

DRYWELL INSIDE DIAMETER _____ FT. EFFECTIVE DEPTH BELOW INLET _____ FT.

ABSORBENT AREA 325 SQ. FT.

REMARKS _____

DATE SYSTEM APPROVED 4-28-87 INSPECTOR S. Hill

about

PERMIT

SEWAGE DISPOSAL SYSTEM

MARYLAND STATE DEPARTMENT OF HEALTH

HOWARD COUNTY

Incomplete 3/9/60

ELLICOTT CITY

DISTRICT 5

DATE 10/15/59

INDEXED

Tattrie & Levy

IS PERMITTED TO INSTALL ☒ ALTER

ADDRESS Simpsonville

PHONE

A SEWAGE DISPOSAL SYSTEM LOCATED AT

SUBDIVISION Holiday Hills

1057Y
ROAD

Vista

LOT 29

PROPERTY OWNER Tattrie & Levy

ADDRESS Simpsonville

SPECIFICATIONS

DRAIN FIELD DEPTH FEET, BOTTOM AREA SQ. FT.

SEEPAGE PITS ☒ ABSORBENT SIDE-WALL AREA 300 SQ. FT.

SEPTIC TANK CAPACITY 750 GALLONS

FOR GARBAGE GRINDER, INCREASE DISPOSAL AREA 22% & TANK CAPACITY 50%.

OTHER Do not include top 3 ft. in computing the absorbent sidewall area.

Place the dry well about 125 ft. from the road and 40 ft. from lot no 30.

System must be installed in area that passed perc. tests.

PLANS APPROVED BY Raymond Hodges

DATE 5/12/59


FILL SEPTIC TANK AND DISTRIBUTION BOX WITH WATER BEFORE CALLING FOR AN INSPECTION. COVER NO WORK UNTIL INSPECTED AND APPROVED.

NEITHER THE HOWARD COUNTY COMMISSIONERS NOR THE HEALTH DEPARTMENT IS RESPONSIBLE FOR THE SUCCESSFUL OPERATION OF ANY SYSTEM.

BLDG. PERMIT SIGNED
AND RETURNED 10/15/59

*Serial # 9370
2-car garage
Re Frank Balk*

A 00874

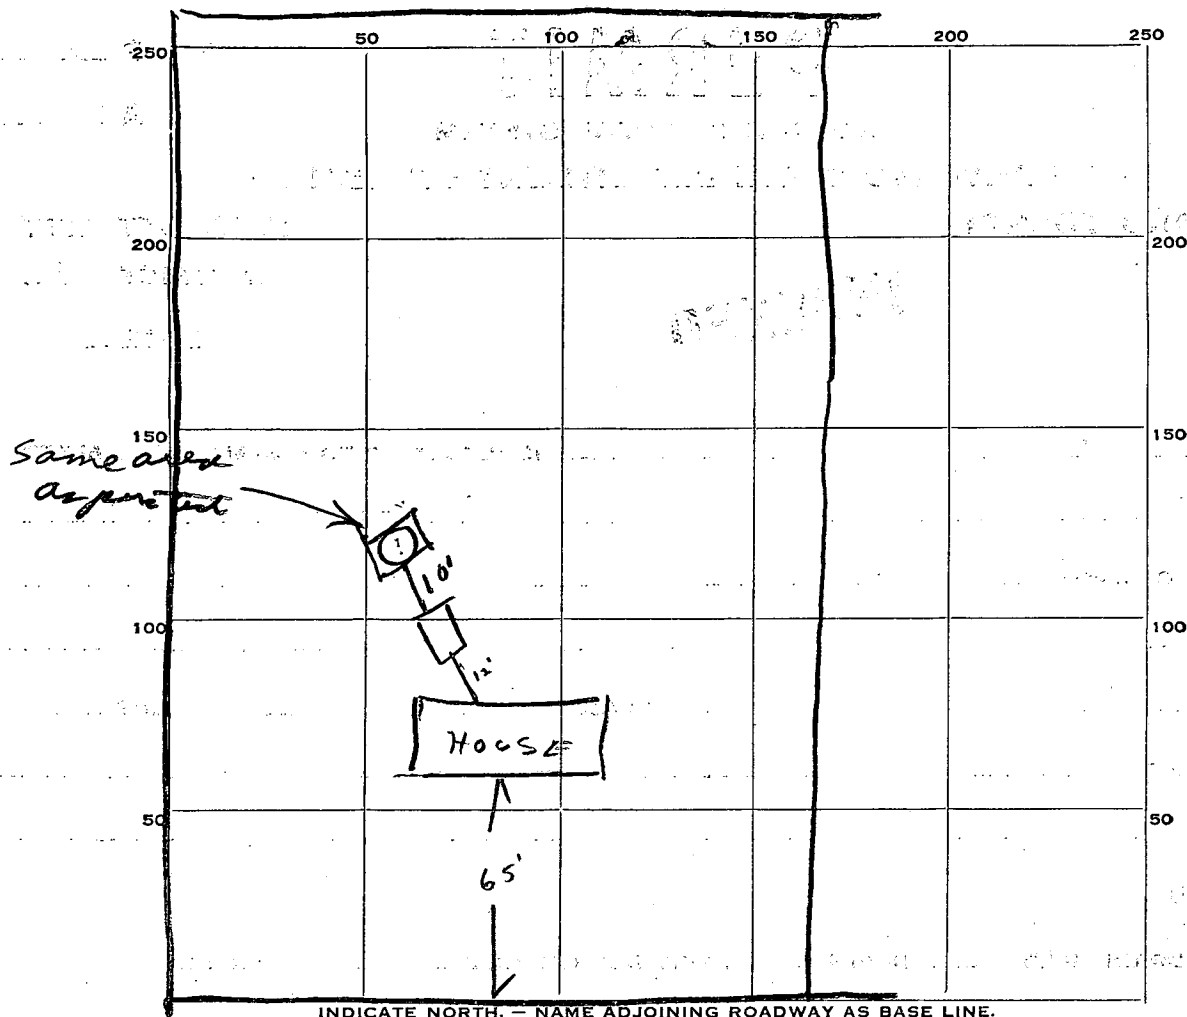

INDICATE NORTH. — NAME ADJOINING ROADWAY AS BASE LINE.

Vista Rd

PERMIT CARD

SEPTIC TANK, LEVEL OK

CLEANOUTS OK 8" Tank

DISTRIBUTION BOX, LEVEL

TILE FIELD, DEPTH _____ FT. TRENCH WIDTH _____ FT.

GRAVEL DEPTH _____ IN. TOTAL LENGTH _____ FT.

NUMBER OF TRENCHES _____ TOTAL BOTTOM AREA _____

SEEPAGE PITS, INSIDE DIAMETER 12 FT. DEPTH BELOW INLET 9 1/3 FT.

ABSORBENT AREA 334 SQ. FT. 450 sq ft counting dirt wall do dirt wall
not counting gravel

REMARKS 3/9/60 Gravel needs to be added & top poured
4-4-60 OK - complied with JH

DATE SYSTEM APPROVED

4-4-60

INSPECTOR

J. Hemminger

APPLICATION

SEWAGE DISPOSAL TESTING

MARYLAND STATE DEPARTMENT OF HEALTH

HOWARD COUNTY

ELLICOTT CITY

750 GALLON TANK

DISTRICT 5

DRY WELL 300 SQ FT SIDEWALL AREA DATE 5-4-59

DO NOT INCLUDE TOP 3' IN COMPUTING
THE ABSORBENT SIDEWALL AREA

PLACE THE DRY WELL ABOUT 125'
FROM THE ROAD & 40' FROM

TO: THE COUNTY HEALTH OFFICER LOT #30
ELLICOTT CITY, MARYLAND

I, HEREBY, APPLY FOR THE NECESSARY TESTS IN ORDER TO CONSTRUCT (OR RECONSTRUCT) A SEWAGE DISPOSAL SYSTEM.

PROPERTY OWNER Tattrie & Levy

ADDRESS Simpsonville PHONE Atlas 6-3241

PROPERTY LOCATION:

SUBDIVISION Holiday Hills LOT NO. 29

ROAD AND DESCRIPTION Vista Rd.

OCCUPANT

PERSON TO CONSTRUCT SYSTEM above

ADDRESS PHONE

SIZE OF LOT 1 acre TYPE BLDG. 3
NUMBER OF BEDROOMS

IF NOT SINGLE RESIDENCE DESCRIBE

SIGNATURE OF APPLICANT

APPROVED BY

FOR

(KIND OF SYSTEM)

DATE

REJECTED BY

FOR

(KIND OF SYSTEM)

DATE


HOLD PENDING FURTHER TESTS

DATE

REASONS FOR REJECTION OR HOLDING

THIS IS NOT A PERMIT

A 00874

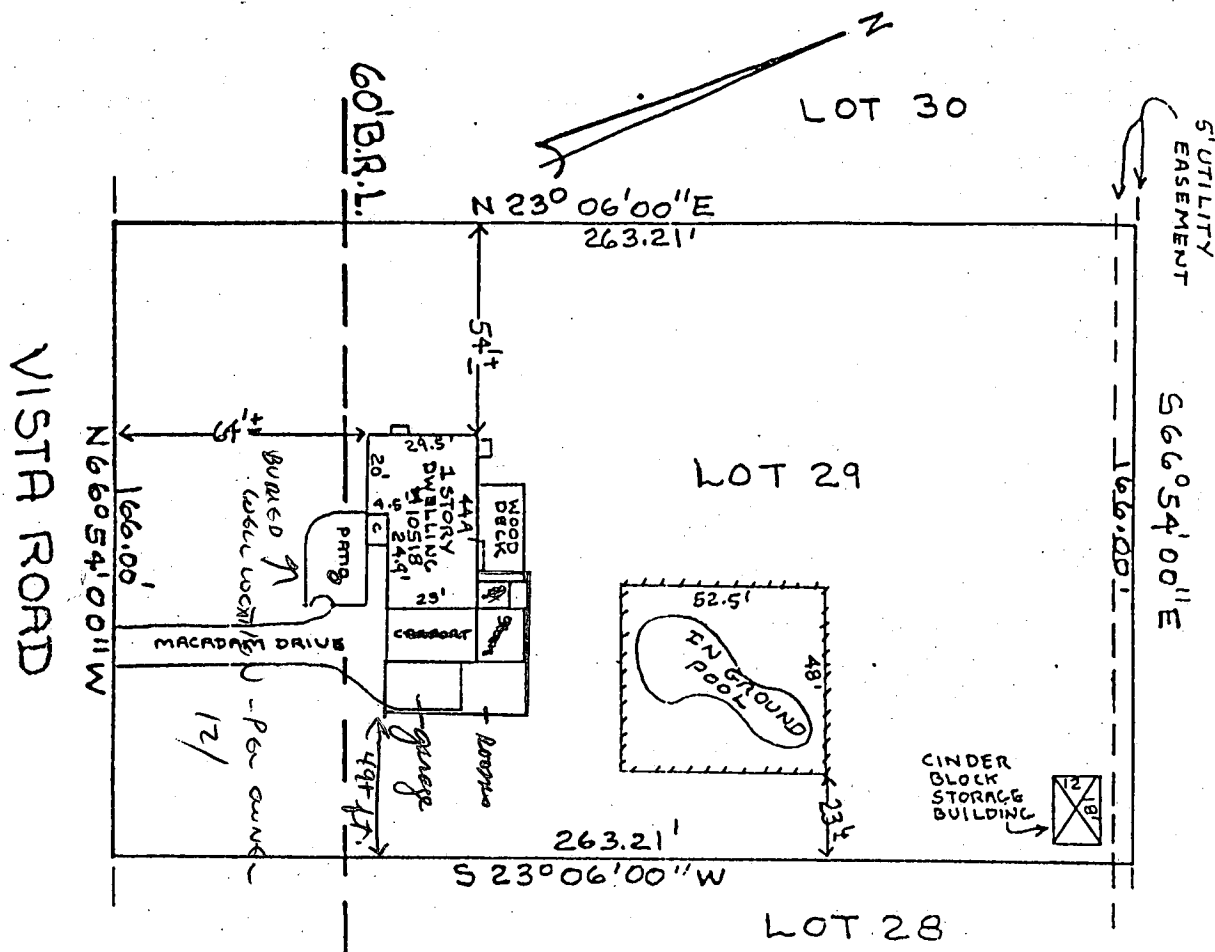

THIS IS TO CERTIFY that I have surveyed
the property known as Lot 29 in the sub-
division known as 2ND ADDITION TO
HOLIDAY HILLS as per plat recorded among
the Land Records of Howard County, Maryland
in Plat Book RHM No. 7, at folio 41, for
the purpose of locating the improvements
thereon.



James C. Hudgins
JAMES C. HUDGINS
P. L. S. #96

LOCATION SURVEY
10518 Vista Road
HOLIDAY HILLS
5th. Election District
Howard County, Md.
Scale 1"=50' DATE 4-2-86