

PERMIT

SEWAGE DISPOSAL SYSTEM

MARYLAND STATE DEPARTMENT OF HEALTH

HOWARD COUNTY

INDEXED

ELLICOTT CITY

DISTRICT 4th

DATE _____

William Hopkins

IS PERMITTED TO INSTALL X ALTER _____

ADDRESS Jennings Chapel Road, Washington, Md.

PHONE 442-4711

A SEWAGE DISPOSAL SYSTEM LOCATED AT _____

SUBDIVISION Timberleigh Village

ROAD 17505 Timberleigh Way

LOT 6, Sec. 1

PROPERTY OWNER William R. Martin

Wayne Fortin

ADDRESS Larry & Barbara Miller

SPECIFICATIONS - 4 bedrooms

DRAIN FIELD _____ DEPTH _____ FEET. BOTTOM AREA _____ SQ. FT.

SEEPAGE PITS _____ ABSORBENT SIDE-WALL AREA _____ SQ. FT.

SEPTIC TANK CAPACITY 1800 GALLONS

FOR GARBAGE GRINDER, INCREASE DISPOSAL AREA 22% & TANK CAPACITY 80%.

OTHER dry well to have 185/ft. effective absorbent sidewall area per bottom below

least 3 ft. of original grade. Must run down in at 4 ft. and maximum depth 12 ft.

Location 15 ft. from road and 150 ft. from rear property line when facing lot from

street road. dry well - trench can be made 1/4/74 - 11:21 AM

NOTE: ALL PIPE FROM HOUSE TO DRY WELL MUST BE CAST IRON.

PERMIT VOID AFTER THREE YEARS.

NOTE: INSTALL STEEL PIPE ON SEPTIC TANK AND DRY WELL.

PLANS APPROVED BY H. Snyder/CSE

DATE 9/29/73

FILL SEPTIC TANK AND DISTRIBUTION BOX WITH WATER BEFORE CALLING FOR AN INSPECTION. COVER NO WORK UNTIL INSPECTED AND APPROVED.

NEITHER THE HOWARD COUNTY COMMISSIONERS NOR THE HEALTH DEPARTMENT IS RESPONSIBLE FOR THE SUCCESSFUL OPERATION OF ANY SYSTEM.

BDDG. PERMIT SIGNED

AND RETURNED 2-4-99

Serial # B 10116 002

Sennoon

BDDG. PERMIT SIGNED

AND RETURNED 4/10/91

Serial # 57412

addition to


BDDG. PERMIT SIGNED

AND RETURNED 4/10/91

Serial # 17339

Heck

39598-B

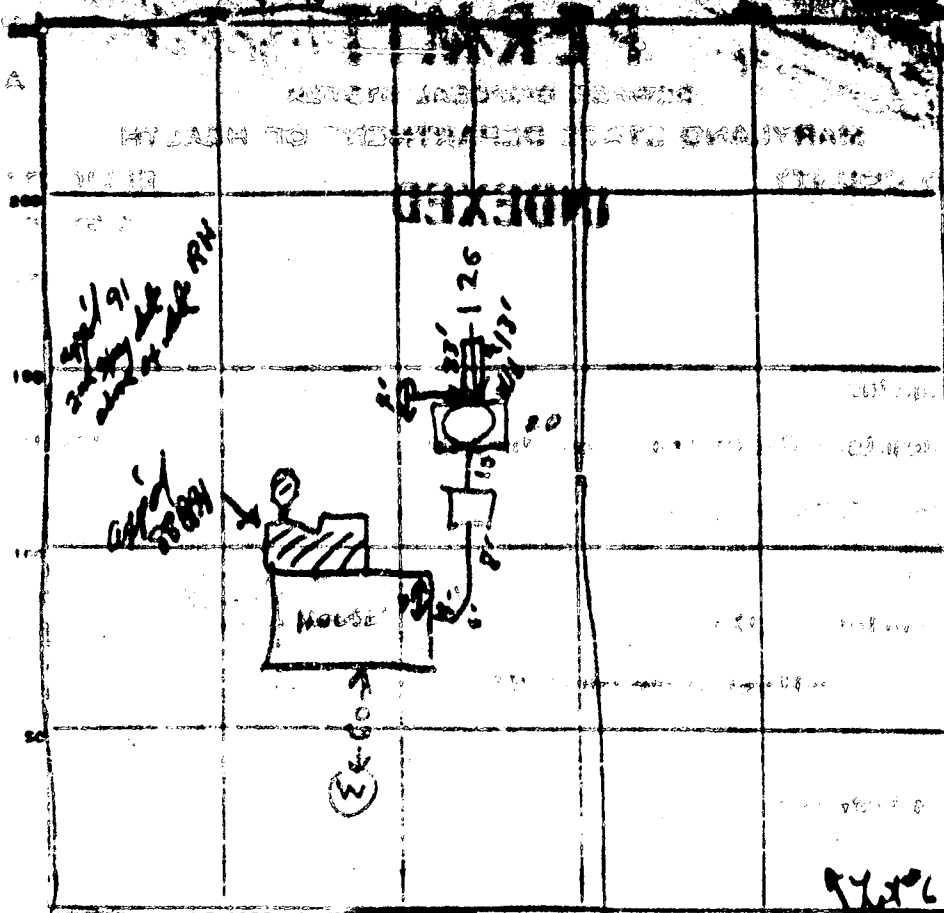

185
748
596
244

12 1/2
5
7 1/2

72
31
216
246

PERMIT CARD _____

SEPTIC TANK, LEVEL 10' 10" CLEANOUTS OK

DISTRIBUTION BOX, LEVEL 10' 15" 1 FT BELOW GRAVE

TILE FIELD, DEPTH _____ FT. TRENCH WIDTH _____ FT.

GRAVEL DEPTH _____ IN. TOTAL LENGTH _____ FT.

NUMBER OF TRENCHES 1 TOTAL BOTTOM AREA 5 FT x 10 FT = 50 SQ FT

SEEPAGE PITS, INSIDE DIAMETER 8 FT. DEPTH BELOW INLET 8 FT.

ABSORBENT AREA 496 + 247 = 743 SQ. FT. COUNTING STONE BELOW TOP OF CLAY

REMARKS 5/10/75 DRILL INLET 1 5 FT BELOW GRAVE

PERMIT TO P.D.M. = 50 FT

5 FT BELOW TOP 5 FT CLAY

5000 2000 - 740 SQ FT NEEDED TOTAL

DITCH - 240 SQ FT SIDEWALL DITCH ONE SIDE BELOW TOP

5 FT OF CLAY (30 FT LONG 13 FT DEEP 8 FT STONE)

OK TO COVER TANK & D.M. 6/15/75 Used gravel + plus 2000

OK for gravel 4/23/75

DATE SYSTEM APPROVED 4/23/75 INSPECTOR C. [Signature]

APPLICATION

HOWARD COUNTY

PERMIT APPLICATION

DEPARTMENT OF INSPECTIONS, LICENSES & PERMIT
3430 COURT HOUSE DRIVE, ELLICOTT CITY, MARYLAND 21043

SERIAL NUMBER

25-131-1
750116002

BUILDING ADDRESS (HOUSE NO., STREET, TOWN OR AREA)

17505 Timberleigh Way
Woodbine, Md 217977113
39516GRADING/SEDIMENT CONTROL ☐ YES ☐ NO

SDP #

DESCRIPTION OF WORK AUTHORIZED

Build 13'2" x 14'2" x 11'2"
Sunroom on existing deck.
Need to extend existing deck
2 to attach Sunroom.

LOT NO. PARCEL NO. SEC. AREA BLOCK NO. LIBER FOLIO

6 1 4 81

SUB DIVISION

ZONE

ZONE MAP

ELEC. DIST.

CENSUS TR.

Timberleigh Village

4

OWNER NAME AND ADDRESS

PHONE NO.

Larry & Barbara Miller
17505 Timberleigh Way
Woodbine, Md 21797410-489-
7345

OCCUPANT'S NAME AND ADDRESS

PHONE NO.

Same as above

ARCHITECT OR ENGINEER'S NAME AND ADDRESS

PHONE NO.

NONE

CONTRACTOR'S NAME AND ADDRESS

PHONE NO.

Southside Builders, Inc.
86 John Street Unit B
Westminster, Md 21157410-857-
7829

EXISTING USE

PROPOSED USE

Deck

Sunroom

EST. CONSTRUCTION COST

LICENSE NUMBER

PERMIT FEE

26,000.00

25870

25

W/S CODE

FOR OFFICE USE ONLY

DISTANCE IN FEET FROM R/W LINE TO FRONT BUILDING LINE

SIDE YARD

(DISTANCE IN FEET FROM SIDE BLDG. LINE TO SIDE PROPERTY LINE)

TO SIDE BUILDING LINE

DISTANCE IN FEET, REAR YD. REQUIRING SET

BACK (CORNER LOT ONLY)

SDP #

Check payable to: DIRECTOR OF FINANCE OF HOWARD COUNTY

CAUTION

To begin construction before a permit placard has been issued
and displayed on the job is a violation of the law.
Use and occupancy permit must be applied for two weeks
before it will be issued.

IMPORTANT: PLEASE SHOW ZIP CODES AND AREA CODES WHEREVER REQUIRED.

LP-69-591

SIZE OF BLDG.	FRONT	DEPTH	HEIGHT
approx. 13'2" x 14'2"	13'2"	14'2"	11'2"
TYPE OF BLDG.	AREA	VOLUME	ROOF
B. ROOMS			
ROOMS			
BATHS			
FIREPLACES			

FOOTINGS	FOUNDATION	S. WALLS
Post & Pier		

WATER/WELL	SEWER/SEPTIC	GAS	ELECTRICITY	TYPE OF HEAT	AC
			415	None	

I have carefully examined and read this application and know the same is true and correct,
and that is doing this work, all provisions of Howard County Ordinances and the State
Laws of Maryland will be complied with, whether specified or not; and I will notify the
Department of Inspections, and Permits twenty-four hours in advance when I am ready for
the inspections called for elsewhere in the application; and that no work will be covered up
until such inspections have been complied with.

Signature: [Signature]
Title: [Title]
Date: 7/14/99


FUNCTION	DATE	SIGNATURE/APPROVAL
ZONING/PLANNING	X	
SHA		
SEDIMENT/GRADING		
BUILDING OFFICIAL	7/14/99	[Signature]
WATER & SEWER		
HEALTH DEPT.	7-24-99	Kim Maste
FIRE PROTECTION		
STORM WATER MGM.	X	

APPROVED

DATE

Distribution of Copies:
White - Building Official
Green - Planning & ZoningYellow - Engineering
Pink - Health Dept.
Gold - S.H.A.

(50' R/W)
TIMBERLEIGH WAY

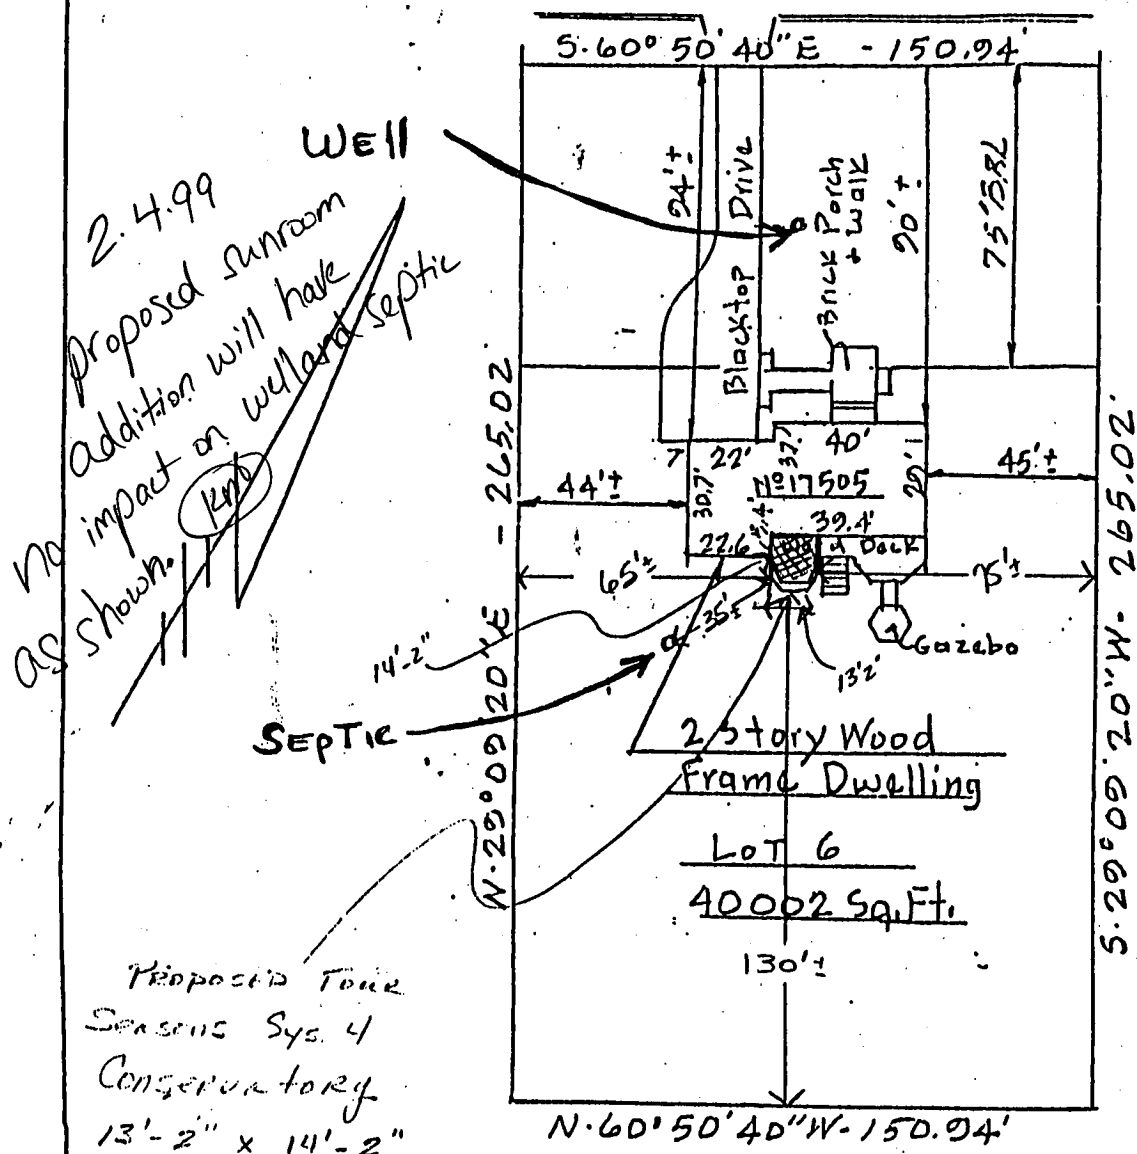

Existing ditch
13'2" wide
12'2" deep
to be
extended
to
14'2" deep



The Lot shown hereon does not lie within the
limits of a recorded Floodplain Easement

Plat Reference: Timberleigh Village - Section 1
recorded in Platbook 25 Folio 81.

TITLE LOCATION SURVEY					THIS IS TO CERTIFY THAT WE HAVE CONDUCTED A LOCATION SURVEY OF THE IMPROVEMENTS AND THAT THEY ARE LOCATED AS SHOWN HEREON. <i>William G. Harter</i> SIGNATURE REG. NO. 9436 DATE 7-23-93	
PROJECT 17505 TIMBERLEIGH WAY						
LOCATION 4TH ELECTION DISTRICT, HOWARD CO., MD.						
FIELD BOOK 137	PAGE NO. 46	DRAWN BY: BTJ	CHECKED BY WGH	DATE: 7-23-93	Boender Associates 3230 BETHANY LANE ELLICOTT CITY, MD. 21043 (301) 465-7777 FAX: (301) 465-7966	
SCALE 1" = 50'			JOB NO.: 93129			
THE INFORMATION ON THIS PLAT SHOWS ONLY THAT THE IMPROVEMENTS INDICATED HEREON ARE CONTAINED WITHIN THE CONFINES OF THE LOT UPON WHICH THEY ARE ERECTED. THIS PLAT IS NOT TO BE CONSTRUED AS, OR USED FOR THE ESTABLISHMENT OF PROPERTY LINES.						