

SEWAGE DISPOSAL SYSTEM
MARYLAND STATE DEPARTMENT OF HEALTH
HOWARD COUNTY

INDEXED

ELLCOTT CITY

DISTRICT 311

DATE 1/6/74

Jack Pyock

PERMITTED TO INSTALL ☒ OR ALTER

ADDRESS Ten Oaks Road, Glenelg, Maryland

PHONE 286-2330

A SEWAGE DISPOSAL SYSTEM LOCATED AT

SUBDIVISION Bancroft Park

ROAD Reservoir Road

LOT 6, Blk. B, B

PROPERTY OWNER Mr. Alfred H. Schrider

ADDRESS 13517 Grenoble Drive, Rockville, Maryland 20853

Phone: 942-5487

SPECIFICATIONS 4 bedrooms

DRAIN FIELD _____ DEPTH _____ FEET. BOTTOM AREA _____ SQ. FT.

SEEPAGE PITS _____ ABSORBENT SIDE-WALL AREA _____ SQ. FT.

SEPTIC TANK CAPACITY 1250 GALLONS

FOR GARBAGE GRINDER, INCREASE DISPOSAL AREA 25% & TANK CAPACITY 50%.

OTHER DRY WELL - To have 115 sq. ft. effective absorbent sidewall area per
section below inlet. Inlet to be 4 ft. below original grade and maximum depth
for dry well 10 1/2 ft. Locate dry well 25 ft. off right property line and 80 ft.
back from front lot line. (Per Sales J and K).

NOTE: ALL PIPE FROM HOUSE TO DRY WELL MUST BE CAST IRON.
PERMIT VOID AFTER THREE YEARS.

NOTE: INSTALL STAND PIPE ON SEPTIC TANK AND DRY WELL.

PLANS APPROVED BY H. Snyder & Charles B. Streaker DATE 11/9/73

FILL SEPTIC TANK AND DISTRIBUTION BOX WITH WATER BEFORE CALLING FOR AN INSPECTION. COVER NO WORK UNTIL INSPECTED AND APPROVED.

NEITHER THE HOWARD COUNTY COMMISSIONERS NOR THE HEALTH DEPARTMENT IS RESPONSIBLE FOR THE SUCCESSFUL OPERATION OF ANY SYSTEM.


BLDG. PERMIT SIGNED

AND RETURNED 10-22-98

Serial # 20114633

Sealed pouch

39598-11

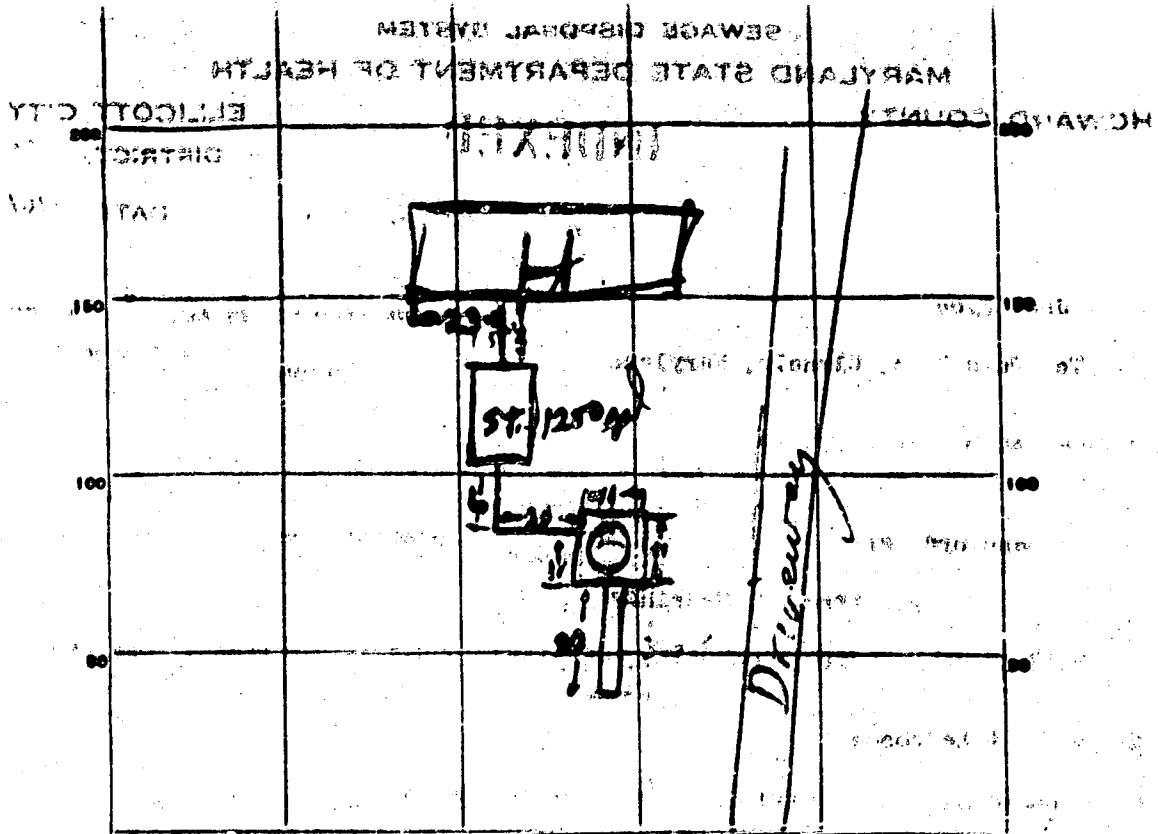

INDICATE NORTH - NAME ADJOINING ROADWAY AS BASE LINE.

PERMIT CARD 19633 Revised 10

~~SEPTIC TANK, LEVEL~~ ✓ ~~CLEANOUTS~~ ✓

~~DISTRIBUTION BOX, LEVEL~~ ✓

~~TILE INLET, DEPTH~~ ✓ ~~FT.~~ ✓

~~INLET, IN.~~ ✓ ~~IN.~~ ✓ ~~FT.~~ ✓


NUMBER OF TRENCHES 1 TOTAL side wall 210 ft.

SEEPAGE PITS, Perimeter 44 ft. DEPTH BELOW INLET 7 ft. 308 sq. ft.

ABSORBENT AREA 518 sq. ft.

REMARKS _____

DATE SYSTEM APPROVED 3/29/74 INSPECTOR R. M. [signature]

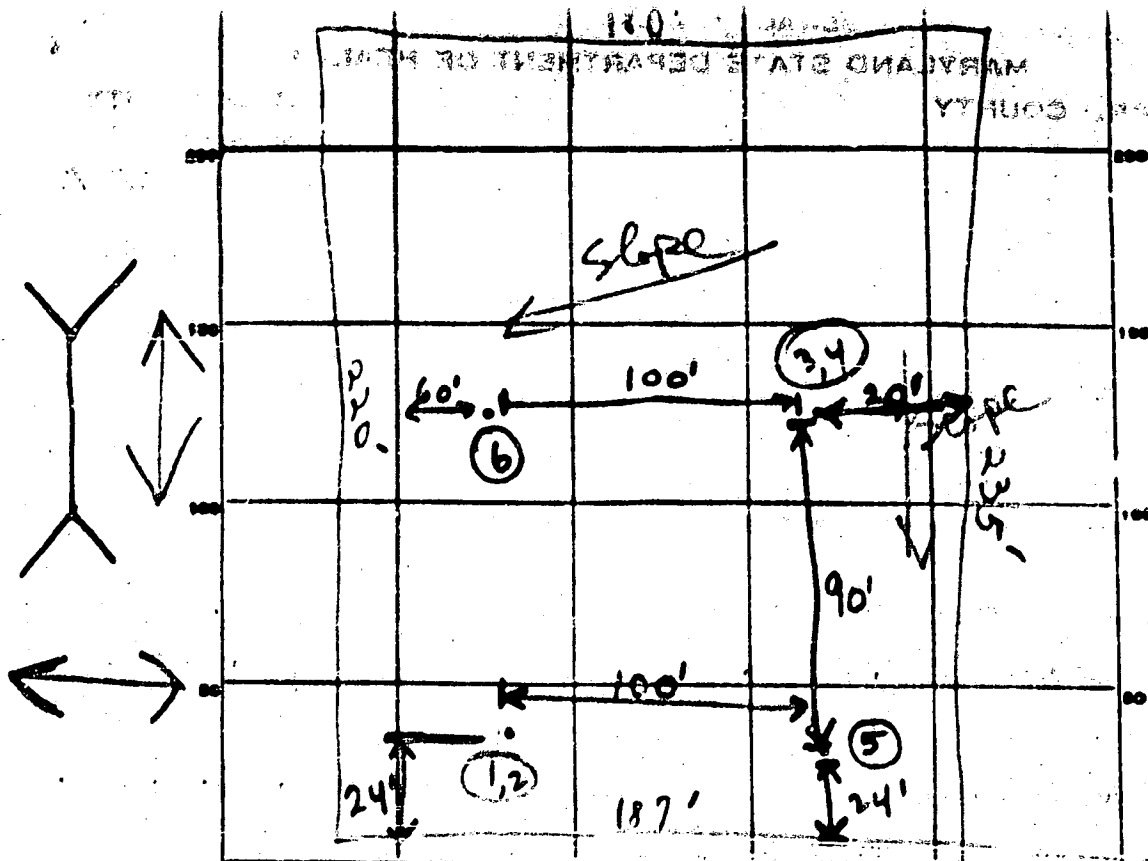

INDICATE NORTH. - NAME ADJOINING ROADWAY AS BASE LINE.

Reservoir Rd

Lot #9 B

correct
section 4
Holes not
included
in perc 0

DATE	TEST NO.	DEPTH	PRE-WET		TEST - 1" DROP		TIME
			START	STOP	START	STOP	
	1	3 1/2'	11:25	11:27	11:27	11:28	1
	2	9'	11:25	11:31	11:31	11:37	6
	3	4'	11:30	11:36	11:36	11:48	12
	4	10 1/2'	11:30	11:35	11:35	11:40	5
	5	TOP 3' - clay BOTTOM 6' - Good Soil (Rocky)					Dry
	6	TOP 3' - clay BOTTOM 8' - Good Soil					(Dry)

6 min
av


SOIL AUGER FINDINGS

TESTED BY

H. Snyder

REMARKS

Dry Well 3, 4
inlet

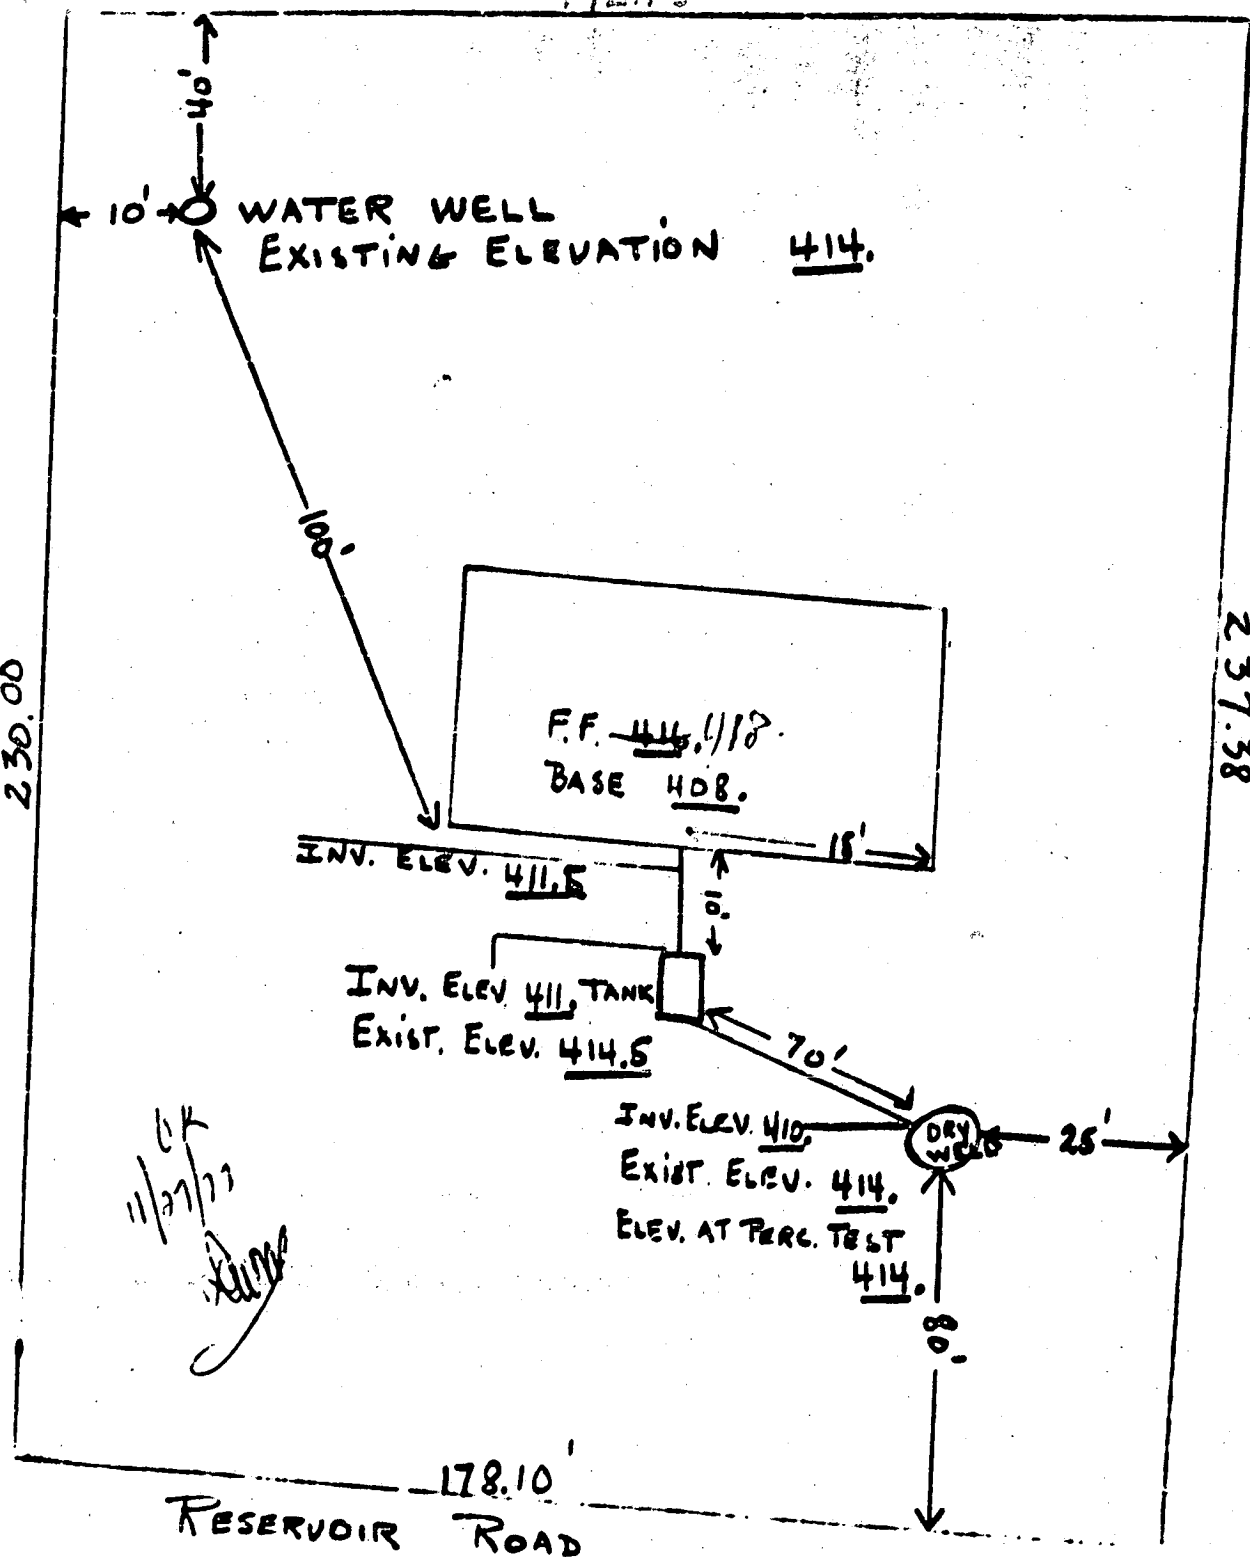

I CERTIFY THE ABOVE MEASUREMENTS AND ELEVATION DIFFERENCES ARE ACTUAL AND CORRECT FOR THIS PROPERTY

Alfred M. Schneider
 ALFRED M. SCHNEIDER - OWNER

17217 MHIL

DEPARTMENT OF INSPECTIONS, LICENSES AND PERMITS 3430 COURT HOUSE DRIVE EIGHTH CITY, MD 21043 PERMITS (410)313-2456 INSPECTIONS (410)313-1810 AUTOMATED INFORMATION (410) 313-3800	HOWARD COUNTY PERMIT APPLICATION	PERMIT NUMBER B 00146 33
---	---	------------------------------------

Building Address <u>8372 Reservoir Rd</u> <u>FULTON, MD 20757</u>	Owner's Name <u>Harvey M. & Joyce A. Schrider</u>
Suite/Apt. #: _____ SDP/WP/Petition #: _____	Address <u>8372 Reservoir Rd</u>
Census Tract _____ Subdivision <u>BRADY PARK</u>	City <u>FULTON</u> State <u>MD</u> Zip Code <u>20757</u>
Section <u>4</u> Area <u>ONE</u> Lot <u>6</u>	Home Phone <u>301-490-0315</u> Work Phone _____
Tax Map _____ Parcel _____ Grid _____	Applicant's Name & Mailing Address, (if other than stated hereon): _____
Zoning _____ Map Coordinates _____ Lot size <u>1 ACRE</u>	Phone _____ Fax _____
Existing Use <u>Single Family Home</u>	Contractor Company <u>SELF</u>
Proposed Use <u>Single Family Home</u>	Contact Person _____
Estimated Construction Cost \$ <u>22000</u>	Address _____
Description of Work <u>16x16 screened Ponds</u> <u>Pond on Home</u>	City _____ State _____ Zip Code _____
Occupant or Tenant <u>OWNER</u>	License No. _____
Contact Name _____	Phone _____ Fax _____
Address _____	Engineer or Architect Company _____
City _____ State _____ Zip Code _____	Contact Person _____
Phone _____ Fax _____	Address _____
	City _____ State _____ Zip Code _____
	Phone _____ Fax _____

BUILDING DESCRIPTION - COMMERCIAL		BUILDING DESCRIPTION - RESIDENTIAL	
Building Characteristics	Utilities	Building Characteristics	Utilities
Height: _____	Water Supply: _____ Public _____ Private _____	SF Dwelling ☐ SF Townhouse ☐ Depth Width	Water Supply: _____ Public _____ Private ☒
No. of stories: _____	Sewage Disposal: _____ Public _____ Private _____	1st floor: _____	Sewage Disposal: _____ Public _____ Private ☒
Gross area, sq. ft. per floor: _____	Electric Yes ☐ No ☐	2nd floor: _____	Electric Yes ☐ No ☐
Use group: _____	Gas Yes ☐ No ☐	Basement: _____	Gas Yes ☐ No ☐
Construction type: _____ Reinforced Concrete _____ Structural Steel _____ Masonry _____ Wood Frame _____	Heating System: _____ Electric ☐ Oil ☐ Natural Gas ☐ Propane Gas ☐	Finished Basement ☐ Unfinished Basement ☐ Crawl space ☐ Slab on Grade ☐ No. of Bedrooms _____	Heating System: _____ Electric ☐ Oil ☐ Natural Gas ☐ Propane Gas ☐
State Certified Modular _____	Sprinkler system: N/A ☐ NFPA #13 _____ Full _____ Partial _____ Other Suppression _____	Multi-family dwellings: _____ No. of efficiency units: _____ No. of 1 BR units: _____ No. of 2 BR units: _____ No. of 3 BR units: _____ Other: _____ Dimensions: _____ Footings: <u>ACE + POST</u> Roof: <u>Asph/Flt</u>	Sprinkler system: N/A ☐ NFPA #13D _____ NFPA #13R _____ Other: _____

THE UNDERSIGNED HEREBY CERTIFIES AND AGREES AS FOLLOWS: (1) THAT HE/SHE IS AUTHORIZED TO MAKE THIS APPLICATION; (2) THAT THE INFORMATION IS CORRECT; (3) THAT HE/SHE WILL COMPLY WITH ALL REGULATIONS OF HOWARD COUNTY WHICH ARE APPLICABLE THERETO; (4) THAT HE/SHE WILL PERFORM NO WORK ON THE ABOVE REFERENCED PROPERTY NOT SPECIFICALLY DESCRIBED IN THIS APPLICATION; (5) THAT HE/SHE GRANTS COUNTY OFFICIALS THE RIGHT TO ENTER ONTO THIS PROPERTY FOR THE PURPOSE OF INSPECTING THE WORK PERMITTED AND POSTING NOTICES.

Applicant's Signature Alfred M. Schrider Print Name
Title/Company _____ Date _____

Checks payable to: **DIRECTOR OF FINANCE OF HOWARD COUNTY**
** PLEASE WRITE NEATLY AND LEGIBLY. **

- FOR OFFICE USE ONLY -

AGENCY	DATE	SIGNATURE APPROVAL
Land Development, DPZ		
State Highways		
Building Official		
Dev. Engineering, DPZ		
Health	<u>10/22/98</u>	<u>A. McMillen</u>
Fire Protection		
Is Sediment Control approval required prior to issuance? YES ☐ NO ☐		
CONTINGENCY CONSTRUCTION START: ☐		
ONE STOP SHOP: ☐		

DPZ SETBACK INFORMATION
Front: _____
Rear: _____
Side: _____
Side St.: _____
All minimum setbacks met? YES ☐ NO ☐
Is Entrance Permit required? YES ☐ NO ☐
Historic District? YES ☐ NO ☐
Lot Coverage for NewTown Zone _____
SDP/Red-line approval date _____

PROPERTY ID#:	<u>38186</u>
Filing Fee \$	<u>25</u>
Permit Fee \$	<u>26</u>
(.10 sq. ft. □) (.15 sq. ft. □)	
Excise Tax \$	
(.40 sq. ft. □) (.80 sq. ft. □)	
TOTAL FEES	<u>51</u>
Check #	
Validation #	
Accepted by:	

