

PERMIT

SEWAGE DISPOSAL SYSTEM

MARYLAND STATE DEPARTMENT OF HEALTH*

HOWARD COUNTY

BUREAU OF ENVIRONMENTAL HEALTH

461-9933

INDEXED

P 39738A REPAIR

DISTRICT _____

DATE 7/28/87DATE SYSTEM APPROVED 5/12/87INSPECTOR BAJack FyockIS PERMITTED TO INSTALL _____ ALTER XADDRESS _____ PHONE 988-9270SUBDIVISION _____ ROAD 8601 Reservoir Road LOT _____PROPERTY OWNER G. C. Munro PHONE: 725-04577438 Cherrytree Drive

ADDRESS _____

IF GARBAGE GRINDER IS USED INCREASE SEPTIC TANK CAPACITY BY 50% AND ABSORPTION AREA BY 22%.

GARBAGE GRINDER? YES _____ NO _____

SEPTIC TANK CAPACITY _____ GALLONS NUMBER OF BEDROOMS _____

REPAIR - CALL FOR INSPECTION WHEN GROUND IS OPENED UP SO SANITARIAN CAN RECOMMEND REPAIR.

orange brown clay 3'
brown powdery silty near loc

NOTE See remarks concerning well construction

PLANS APPROVED BY C. Williams DATE 5/11/87

COVER NO WORK UNTIL INSPECTED AND APPROVED.

NEITHER THE HOWARD COUNTY COUNCIL NOR THE HEALTH DEPARTMENT IS RESPONSIBLE FOR THE SUCCESSFUL OPERATION OF ANY SYSTEM.

NOTE: CLEANOUT REQUIRED EVERY 70 FEET OF SEWER LINE AND/OR AT 90° SWEEPS IN LINES FROM HOUSE TO DRAIN FIELDS.

NOTE: ALL PARTS OF SEPTIC SYSTEMS (I.E., TANK, DISTRIBUTION BOX, TRENCHES) TO BE 100 FEET FROM WELL. (UNLESS OTHERWISE SPECIFICALLY AUTHORIZED)

NOTE: IF DEEP TRENCH(ES) ARE USED CALL FOR INSPECTION BEFORE AND AFTER PLACING GRAVEL IN TRENCH(ES).

NOTE: NO DRY WELL SHALL EXCEED 15 FOOT IN DIAMETER. NO ABSORPTION TRENCH TO EXCEED 100 FEET IN LENGTH.

NOTE: ALL PIPE FROM HOUSE TO SEPTIC TANK MUST BE CAST IRON OR SCHEDULE 40 PVC OR ABS.

PERMIT VOID AFTER TWO YEARS.

NOTE: INSTALL STAND PIPE ON SEPTIC TANK AND DRY WELL. STAND PIPES MUST BE 6 INCHES IN DIAMETER. CAST IRON, CONCRETE OR TERRA COTTA OR PVC OR ABS ACCEPTED. IF TOP OF SEPTIC TANK IS DEEPER THAN 3 FEET, MANHOLE TO GRADE REQUIRED.

NOTE: DISTRIBUTION BOXES MUST HAVE BAFFLES.


*INSTALLER IS RESPONSIBLE FOR OBTAINING FINAL APROVAL ON THIS PERMIT

*CALL 461-9933 FOR INSPECTION OF SEPTIC SYSTEMS.

EH - 2-1186

P # 39738

8601 Reservoir Rd
HEALTH DEPT
P39738

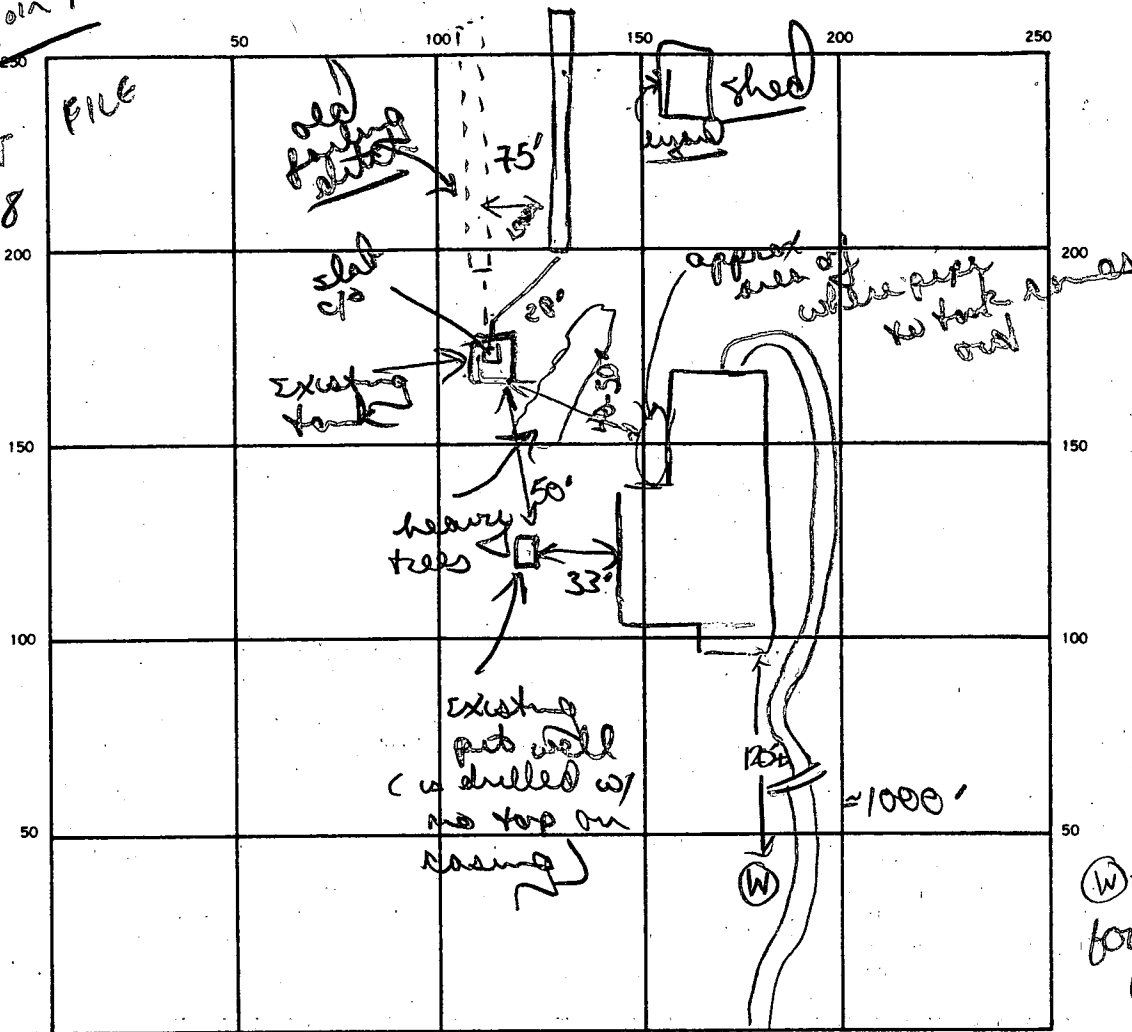

INDICATE NORTH — NAME ADJOINING ROADWAY AS BASE LINE
RESERVOIR ROAD

Ⓢ = site approved
for replacement
well 3/23/88
(DKS)

SEPTIC TANK. LEVEL existing (concrete) (~1000 gal) CLEANOUTS concrete slab

DISTRIBUTION BOX. LEVEL _____

DRAIN FIELD/TILE FIELD. DEPTH 10 FT. TRENCH WIDTH 2 FT. INLET DEPTH 3 FT.

EFFECTIVE GRAVEL DEPTH 7' FT. TOTAL LENGTH 75 FT.

NUMBER OF TRENCHES 1 ONE SIDEWALL/BOTTOM AREA 525 SQ. FT.

DRYWELL INSIDE DIAMETER _____ FT. EFFECTIVE DEPTH BELOW INLET _____ FT.

ABSORBENT AREA 525 SQ. FT.


REMARKS 5/12/87 Installed new baffle in tank. OK to go
3-10' for repair. OK to finish storming trench. OK
to cover trench & all work.

condition of well suspect. No exp on casing (mouse
running around in pit), need to contact owner @
capping + rechlorinating well. (UNABLE TO REACH OWNER BY PHONE)

DATE SYSTEM APPROVED 5/12/87 INSPECTOR B. Wilson

Property Known as: DEED 3704:0323
5th ELECTION DISTRICT
HOWARD COUNTY
MARYLAND

THIS PLAT CAN NOT BE USED TO ESTABLISH PROPERTY
LINES OR CORNERS.

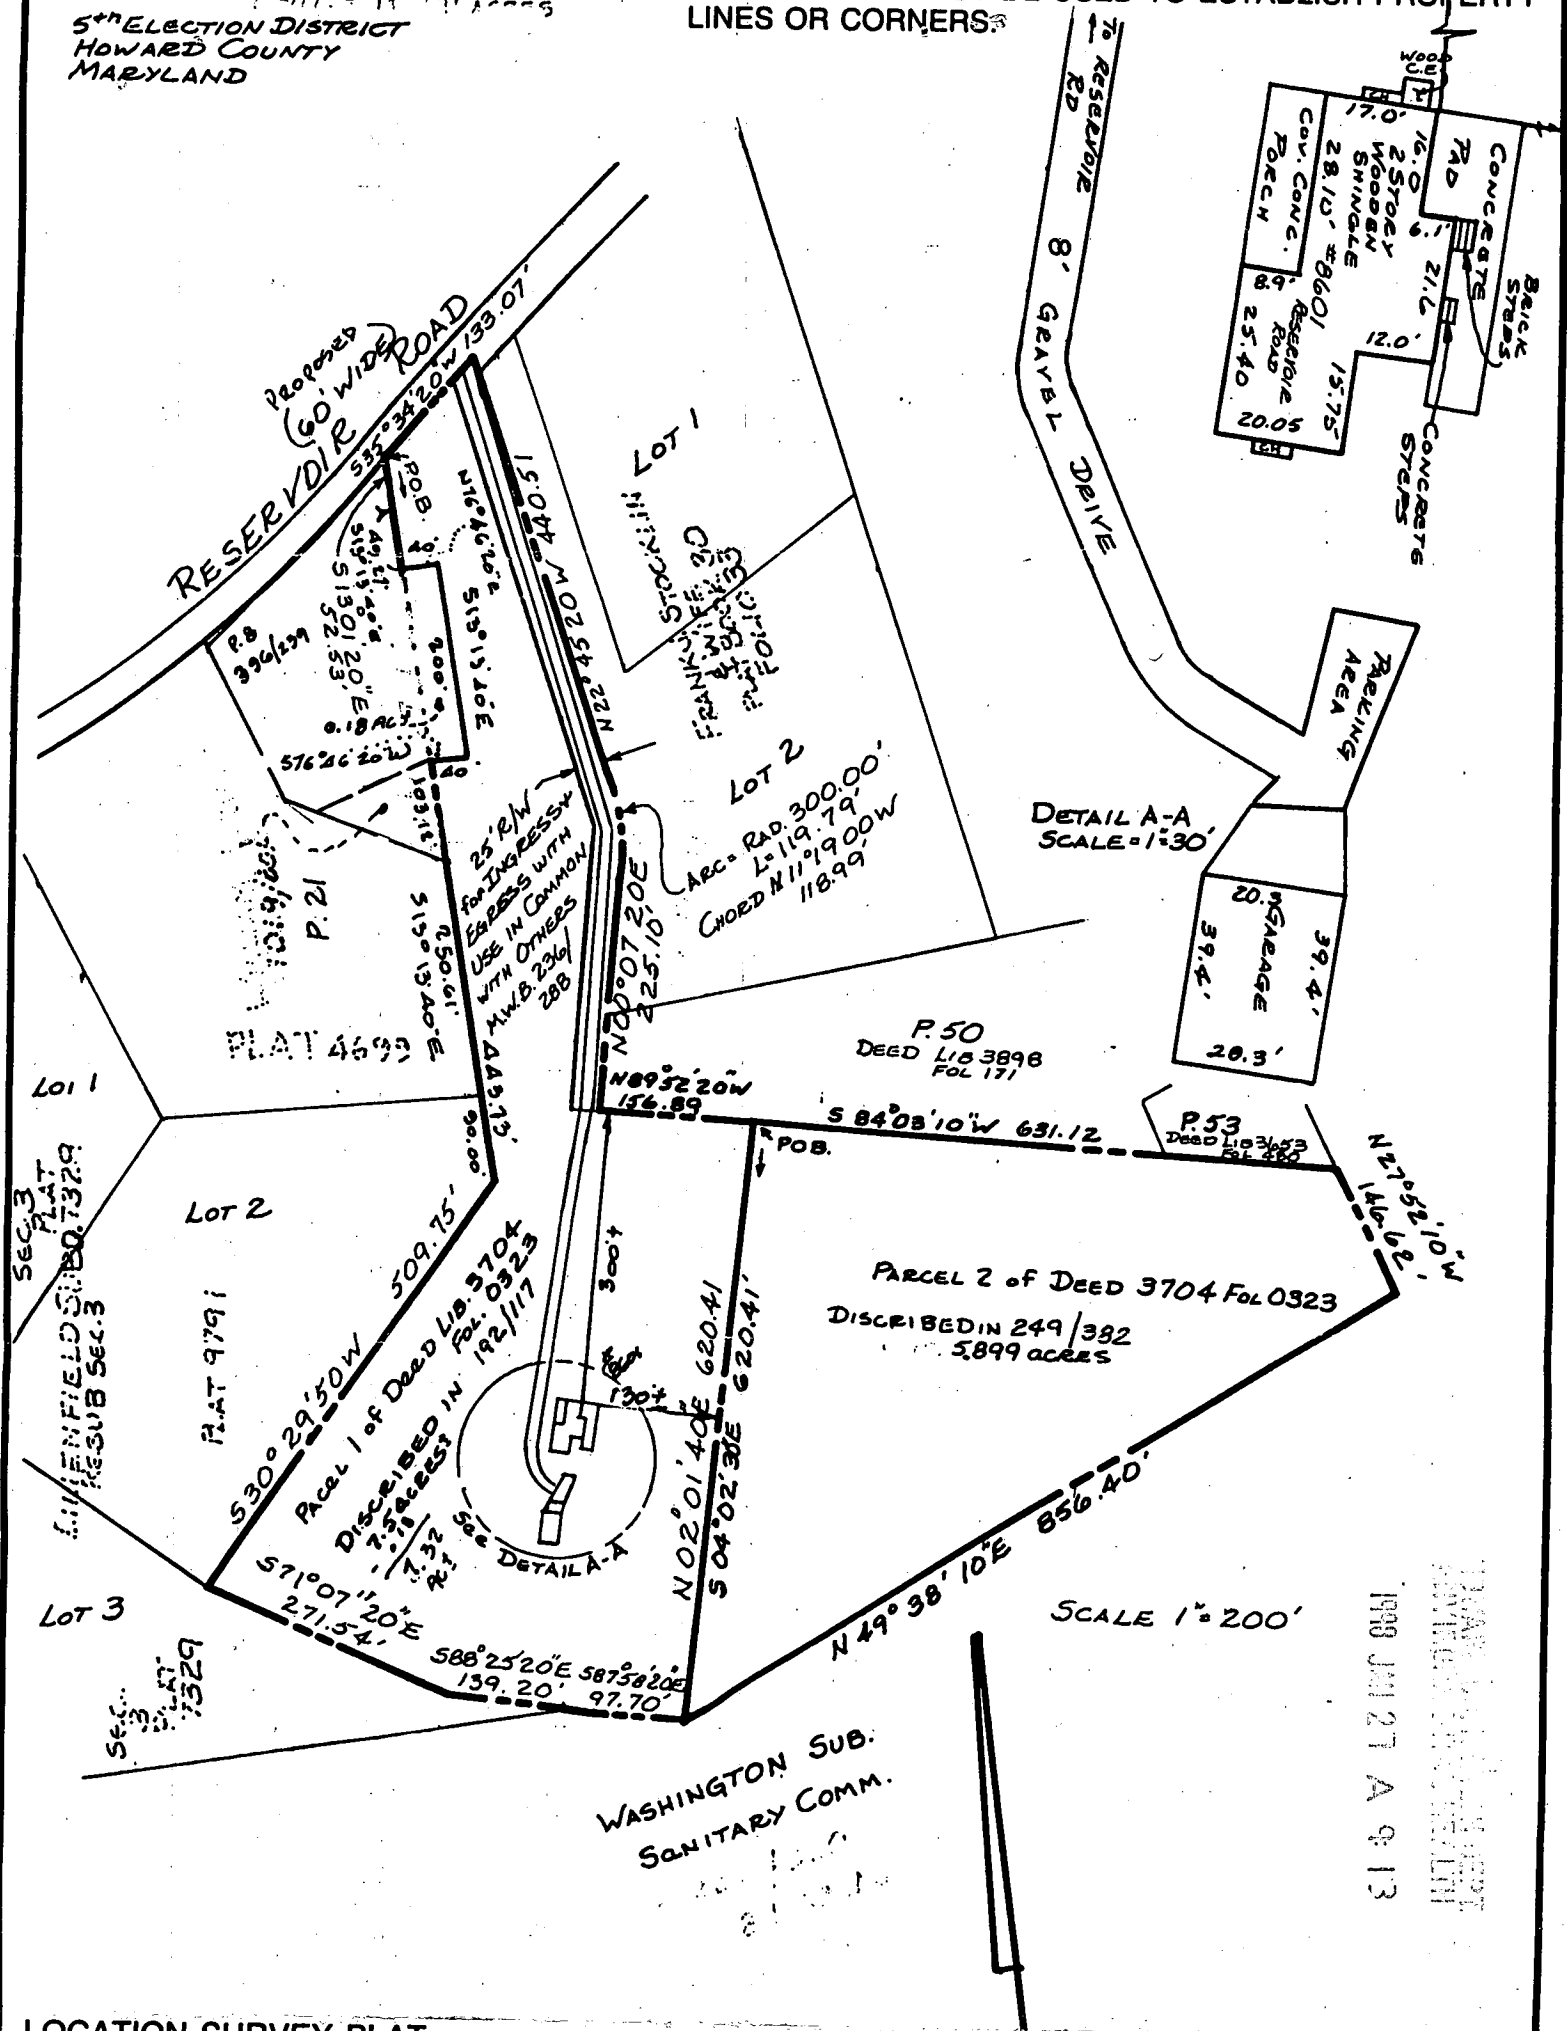

LOCATION SURVEY PLAT
SUBJECT PROPERTY NOT LOCATED IN A FLOOD PLAIN AREA UNLESS OTHERWISE NOTED

CERTIFICATION

This is to certify that I have surveyed
the property known as: 8601

RESEVOIR ROAD

for the purpose of locating the im-
provements thereon, and the improvements
are located as shown.

SEAL



Walter Park


SCALE: As NOTED DATE: 1-6-98

LDE Inc.

9250 Rumsey Road Suite 106
Columbia, Maryland 21045

(Balt.) 410-715-1070
(Wash.) 301-596-3424
(FAX) 410-715-9540

8601 Reservoir Rd
HOCO DEPT
P39738

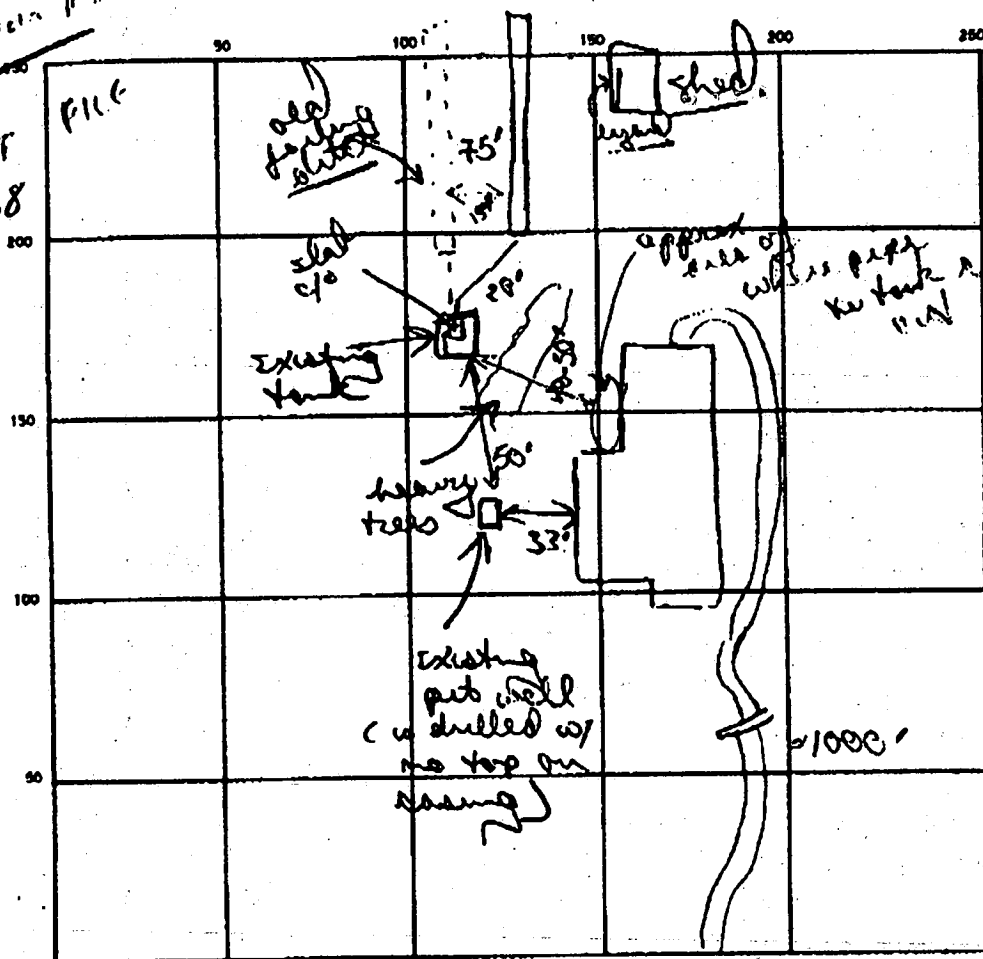

PROJ. NO. 97148
PROJ. NAME MUNRO
CLIENT _____

Post# Fax Note	7671	Date	5/12/87
To	BR Ender	From	Chad Williams
Co/Dept		Co	
Phone #		Phone #	
Fax #		Fax #	

INDICATE NORTH — NAME ADJOINING ROADWAY AS BASE LINE
RESERVOIR ROAD

SEPTIC TANK LEVEL existing (concrete) CLEANOUTS concrete slab

DISTRIBUTION BOX LEVEL _____

DRAIN FIELD/TILE FIELD DEPTH 10 FT. TRENCH WIDTH 2 FT. INLET DEPTH 3 FT.

EFFECTIVE GRAVEL DEPTH 7' FT. TOTAL LENGTH 75 FT.


NUMBER OF TRENCHES 1 ONE SIDEWALL BOTTOM AREA 525 SQ. FT.

DRYWELL INSIDE DIAMETER _____ FT. EFFECTIVE DEPTH BELOW INLET _____ FT.

ABSORBENT AREA 525 SQ. FT.

REMARKS 5/12/87 Installed new baffle in tank. OK to go
3-10' for repair OK to finish storming trench. OK
to serve trench & all work.
condition of well suspect. No cap on casing (mouse
running around in pit), need to contact owner (
capping + reclamation well). (unable to contact owner at time)

DATE SYSTEM APPROVED 5/12/87 INSPECTOR W. Wilson

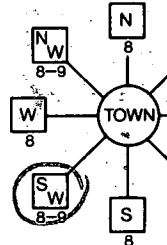B 1	5414 SEQUENCE NO. (MDE USE ONLY)	STATE OF MARYLAND PERMIT TO DRILL WELL please print or type	STATE PERMIT NUMBER HO-94-1495 fill in this form completely
Date Received (APA) 3/23/98 (THIS NUMBER IS TO BE PUNCHED IN COLS. 3-6 ON ALL CARDS)		OWNER INFORMATION RN 7405	
8: MM DD YY 13 Monroe Don 15 Last Name Owner First Name 34 8601 Reservoir Road 36 Street or RFD 55 Fulton, Md. 20759 57 Town 70 State 72 Zip 76		LOCATION OF WELL Howard CC# 8 COUNTY 21 23 SUBDIVISION 42 SECTION 44 46 LOT 48 50 Fulton 52 NEAREST TOWN 71 MILES FROM TOWN (enter 0 if in town) 2 M I 73 76 77 78	
DRILLER INFORMATION George F. Easterday M WD 040 Driller's Name 76 License No. 81 L. Franklin Easterday, Inc. Firm Name 9265 Brown Church Rd., MT. Airy, Md. 21771 Address George F. Easterday 3/19/98 Signature Date		DIRECTION OF WELL FROM TOWN (CIRCLE BOX) 	
WELL INFORMATION APPROX. PUMPING RATE 5 (GAL. PER MIN.) 8 12 AVERAGE DAILY QUANTITY NEEDED 500 (GAL. PER DAY) 14 20		ON WHICH SIDE OF ROAD (CIRCLE APPROPRIATE BOX) 8601 Reservoir Rd 11 NEAR WHAT ROAD 30 ON WHICH SIDE OF ROAD (CIRCLE APPROPRIATE BOX) 34 50 37 DISTANCE FROM ROAD ENTER FT OR MI FT 38 39 TAX MAP: _____ BLK. _____ PARCEL _____	
USE FOR WATER (CIRCLE APPROPRIATE BOX) ☒ HOME (SINGLE OR DOUBLE HOUSEHOLD UNIT ONLY) ☐ FARMING (LIVESTOCK WATERING & AGRICULTURAL IRRIGATION) ☐ INDUSTRIAL, COMMERCIAL, STATE AND FEDERAL GOV. OTHER (REQUIRES APPROPRIATION PERMIT) ☐ PUBLIC OR PRIVATE WATER COMPANY (REQUIRES APPROPRIATION PERMIT AND STATE APPROVAL) ☐ TEST; OBSERVATION, MONITORING (MAY REQUIRE APPROPRIATION PERMIT)		NOT TO BE FILLED IN BY DRILLER HEALTH DEPARTMENT APPROVAL Howard 39738 COUNTY NAME COUNTY NO. STATE SIGNATURE DATE ISSUED 3/25/98 Howard 3/24/99 43 MM DD YY 48 CO SIGNATURE EXP. DATE NORTH GRID 474 000 EAST GRID 0815 000 50 55 57 63	
APPROXIMATE DEPTH OF WELL 300 FEET 24 28 APPROXIMATE DIAMETER OF WELL 6 INCH NEAREST INCH		SHOW MAJOR FEATURES OF BOX & LOCATE WELL WITH AN X SOURCES OF DRILLING WATER 1. wells 2. 3. WRITE THE BOX NUMBER FROM THE MAP HERE E 810 N 480	
METHOD OF DRILLING (circle one) BORED (or Augered) JETTED Jetted & DRIVEN 30 AIR-ROTARY AIR-PERCussion ROTARY (Hydraulic Rotary) 37 CABLE REVERSE-ROTARY DRIVE-POINT other		DRAW A SKETCH BELOW SHOWING LOCATION OF WELL IN RELATION TO NEARBY TOWNS AND ROADS AND GIVE DISTANCE FROM WELL TO NEAREST ROAD JUNCTION FULTON MAP 18 D7	
REPLACEMENT OR DEEPEMED WELLS (CIRCLE APPROPRIATE BOX) ☒ THIS WELL WILL NOT REPLACE AN EXISTING WELL ☐ THIS WELL WILL REPLACE A WELL THAT WILL BE ABANDONED AND SEALED ☐ THIS WELL WILL REPLACE A WELL THAT WILL BE USED AS A STANDBY-CONTACT LOCAL APPROVING AUTHORITY FOR POLICY ON STANDBY WELLS ☐ THIS WELL WILL DEEPEMED AN EXISTING WELL PERMIT NUMBER OF WELL TO BE REPLACED OR DEEPEMED (IF AVAILABLE) 41 52		Not to be filled in by driller (MDE OR COUNTY USE ONLY) APPROX. PERMIT NUMBER 80 FORCE DS WRITE INITIALS IN BOX HO-94-1495 67 68 PERMIT No. 70 71 72 73 74 75 76 77 78 79	
SPECIAL CONDITIONS NOTE - APPROVING AUTHORITIES SHOULD USE SEPARATE SHEET IF NEEDED -			


Well 15.
50
Reservoir RD,
Drive way

PLAT 4693

LOT 2

PLAT 9791

1329

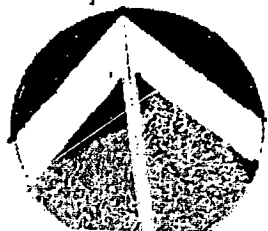

S 30° 29' 50" W

Parcel 1 of Deed L.B. 9704
Disclosed in 192/117
7.32
7.32

S 71° 07' 20" E
271.54'

NOTE: INFO. RE: EXISTG.
SEPTIC CONDITIONS TAKEN
FROM HEALTH DEPT. FILE
P 39738.

S 88° 23' 20" E 387.38' 20"
139.20' 97.70'

N 89° 52' 20" W
156.89'

100'

130'

N 02° 01' 40" E

S 04° 02' 30" E

S 84° 08' 10" W 631.12'

PARCEL 2 of DEED 3704 Fol 0323

Disclosed in 249/382
5.899 acres

EXISTING STRUCTURE
NEW ADDITION
EXISTING WELL
APPROX. LOCATION
FOR NEW WELL
EXISTING SEPTIC
TANK.

N 49° 38' 10" E 856.40'

S I T E P L A N

MR. DONALD J. MUNRO
8601 RESERVOIR ROAD
FULTON, MARYLAND 20701
DR BRASHER ARCHITECT
COLUMBIA, MARYLAND.

SCALE: 1" = 100' 27 JANU

2/5/98
BP 3001091070
ok to proceed
please see letter
from applicant
dated 2/4/98