

PERMIT

SEWAGE DISPOSAL SYSTEM

DEPARTMENT OF HEALTH AND MENTAL HYGIENE

HOWARD COUNTY HEALTH DEPARTMENT

BUREAU OF ENVIRONMENTAL HEALTH

461-9933

INDEXED

P 47390

A 40708

DISTRICT 5th

DATE 8/6/91

DATE SYSTEM APPROVED 8/9/91

INSPECTOR M. Eifkin

05-409829

VanSant Plumbing & Heating

IS PERMITTED TO INSTALL ☒ ALTER ☐

ADDRESS 1009 N. Main Street, Mt. Airy, Maryland 21771 PHONE 829-0444

SUBDIVISION Ashleigh Green LOT 1 ROAD 6992 Westcott Place

PROPERTY OWNER Winchester Homes, Inc.

ADDRESS JOEL SHIAN

SEPTIC TANK CAPACITY 1250 GALLONS

NUMBER OF BEDROOMS 4

180 SQUARE FEET PER BEDROOM

LINEAR FEET OF TRENCH REQUIRED 180

BLDG. PERMIT SIGNED
AND RETURNED 1/23/95
Serial # 57913
1-Story addition

TRENCHES - Trench to be 2 feet wide. Inlet 3 feet below original grade. Bottom maximum depth 7 feet below original grade. Effective area begins at 3 feet below original grade. 4 feet of stone below distribution pipe.

LOCATION - Start the first trench 175 feet from the front lot line and 85 feet from the right lot line as seen when facing the lot from Westcott Place. Run 2 - 90 ft.

NOTE - trenches on contour toward the left lot line (Simpson Road).
- No trench to exceed 100 feet in length. Provide 6" - 8" diameter cleanout and cap above septic tank or grade. B-6-91 JEN

BLDG. PERMIT SIGNED
AND RETURNED 8/13/90
Serial # 31113530
S. R. R. R.

PLANS APPROVED BY Sid Abel cm DATE 5/10/89

COVER NO WORK UNTIL INSPECTED AND APPROVED

NEITHER THE HOWARD COUNTY COUNCIL NOR THE HEALTH DEPARTMENT IS RESPONSIBLE FOR THE SUCCESSFUL OPERATION OF ANY SYSTEM

NOTE: CLEANOUT REQUIRED EVERY 70 FEET OF SEWER LINE AND/OR AT 90° SWEEPS IN LINES FROM HOUSE TO DRAIN FIELDS, 90° ELBOWS NOT ACCEPTABLE.

NOTE: ALL PARTS OF SEPTIC SYSTEMS (I.E. TANK, DISTRIBUTION BOX TRENCHES) TO BE 100 FEET FROM WELL (UNLESS OTHERWISE SPECIFICALLY AUTHORIZED)

NOTE: IF DEEP TRENCH(ES) ARE USED CALL FOR INSPECTION BEFORE AND AFTER PLACING GRAVEL IN TRENCH(ES)

NOTE: NO DRY WELL SHALL EXCEED 15 FOOT IN DIAMETER NO ABSORPTION TRENCH TO EXCEED 100 FEET IN LENGTH

NOTE: ALL PIPE FROM HOUSE TO SEPTIC TANK MUST BE CAST IRON OR SCHEDULE 35/40 PVC OR ABS


PERMIT VOID AFTER TWO YEARS

BLDG. PERMIT SIGNED
AND RETURNED 8/17/92
Serial # 93051 - deck

NOTE: INSTALL STAND PIPE ON SEPTIC TANK AND DRY WELL STAND PIPES MUST BE 6 INCHES IN DIAMETER CAST IRON, CONCRETE OR TERRA COTTA OR PVA OR ABS ACCEPTED. IF TOP OF SEPTIC TANK IS DEEPER THAN 3 FEET. MANHOLE TO GRADE REQUIRED.

NOTE: DISTRIBUTION BOXES MUST HAVE BAFFLES

*INSTALLER IS RESPONSIBLE FOR OBTAINING FINAL APPROVAL ON THIS PERMIT

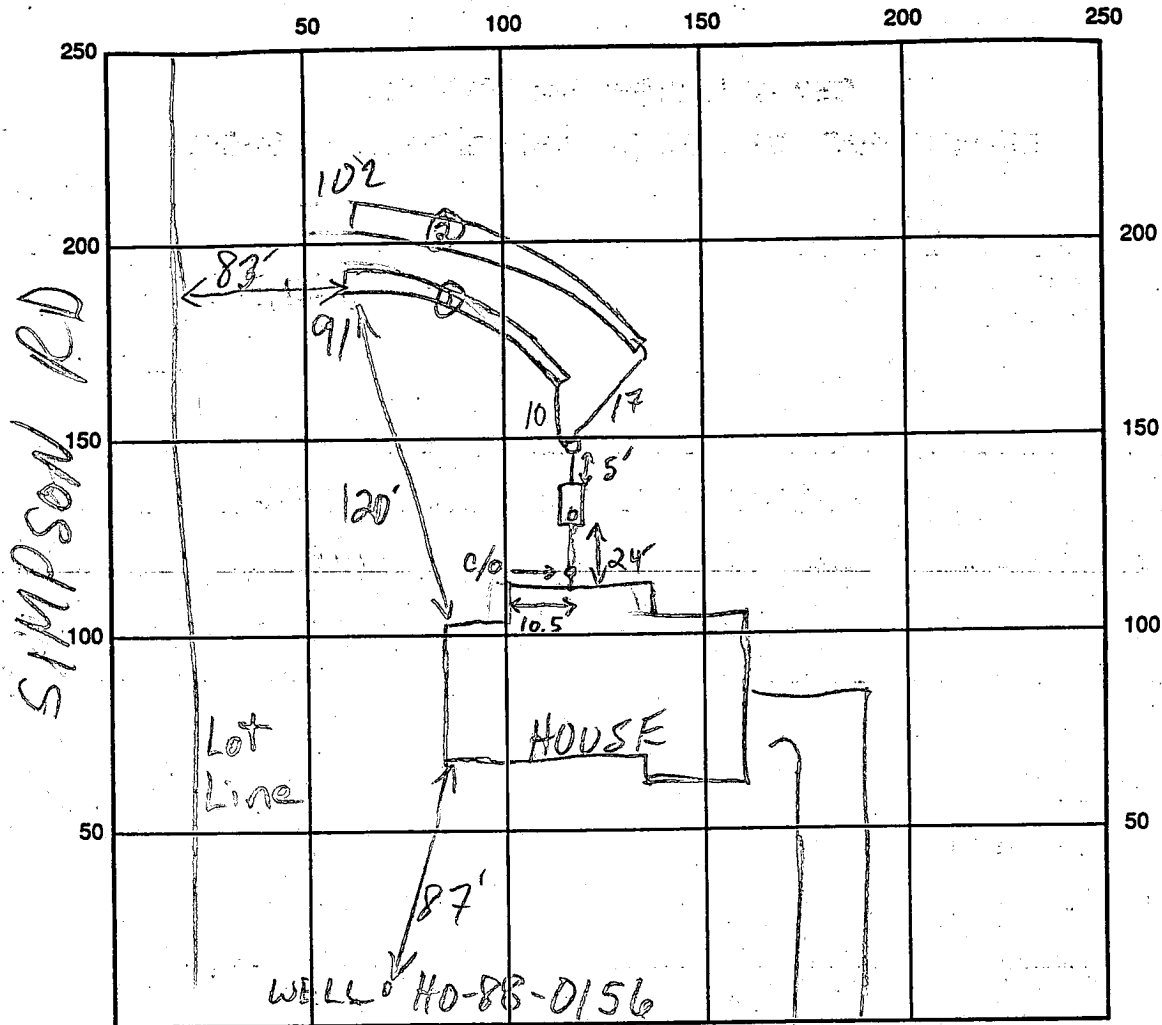

WESTCOTT PL INDICATE NORTH - NAME ADJOINING ROADWAY AS BASE LINE

SEPTIC TANK LEVEL 1250 GAL CLEANOUTS S.T. & INLINE - OK
 DISTRIBUTION BOX LEVEL OK - BAFFLE IN
 DRAIN FIELD/TITLE DEPTH 7-7 1/2 FT. TRENCH WIDTH 2 FT. INLET DEPTH 3 FT.
 EFFECTIVE GRAVEL DEPTH 4-4 1/2 FT. TOTAL LENGTH 091 102 FT.
 NUMBER OF TRENCHES 2 ONE SIDEWALL/BOTTOM AREA 0364 0408 SQ. FT.
 DRYWALL INSIDE DIAMETER — FT. EFFECTIVE DEPTH BELOW INLET — FT.
 ABSORBENT AREA 772 SQ. FT.

REMARKS: 8/8/91 OK TO STONE TRENCHES MR
8/9/91 OK TO COVER ALL

DATE SYSTEM APPROVED 8/9/91 INSPECTOR M. R. F. Kin

APPLICATION

PERCOLATION TESTING

A 40708

P _____

HOWARD COUNTY HEALTH DEPARTMENT
BUREAU OF ENVIRONMENTAL HEALTH

P.O. BOX 476 ELLICOTT CITY, MARYLAND 21043
TELEPHONE: 461-9933

DISTRICT 5th

DATE 12-1-87

TO: THE COUNTY HEALTH OFFICER
ELLICOTT CITY, MARYLAND

I, HEREBY, APPLY FOR THE NECESSARY TEST IN ORDER TO CONSTRUCT (OR RECONSTRUCT) A SEWAGE DISPOSAL SYSTEM.

PROPERTY OWNER Winchester Homes, Inc. Real Estate Development Group ✓

ADDRESS 6301 Ivy Lane Greenbelt, MD 20770 PHONE 301-220-1117
474-4411

PROSPECTIVE BUYER N/A

ADDRESS N/A PHONE _____

PROPERTY LOCATION:

SUBDIVISION Ashleigh Greene - Section I LOT NO. 1

ROAD AND DESCRIPTION Intersection Hall Shop Road & Simpson Road-
6992 Westcott Place

TAX MAP 41 PARCEL # 139

SIZE OF LOT 3.0 AC TYPE BLDG Single Family
(SINGLE FAMILY DWELLING OR COMMERCIAL)

THE SYSTEM INSTALLED UNDER THIS APPLICATION IS ACCEPTABLE ONLY UNTIL PUBLIC FACILITIES BECOME AVAILABLE. I FULLY UNDERSTAND THE

FEE CONNECTED WITH THE FILING OF THIS PERC TEST APPLICATION IS NON-REFUNDABLE UNDER ANY CIRCUMSTANCES. I ALSO AGREE TO COMPLY

WITH ALL M.O.S.H.A. REQUIREMENTS IN TESTING THIS LOT. Burling G. Handley
(SIGNATURE OF APPLICANT)

APPROVED BY Ed Abel FOR Dupont DATE 5-10-89

REJECTED BY _____ FOR _____ DATE _____

HOLD PENDING FURTHER TESTS _____ DATE _____

REASONS FOR REJECTION OR HOLDING 2-17-88 for subdivision plat approval and perc
hole locations JEN

BOG. PERMIT SIGNED
AND RETURNED 5-10-89
BP25456 8AC

THIS IS NOT A PERMIT


High 1
2
4
Low 3

Westcott Place

Lot 2

①
SOIL PROFILE

0-5.0 Rd-br sa si clay loam
5.0-11.0 Red-br micaceous sandy silt
11.0 Bottom

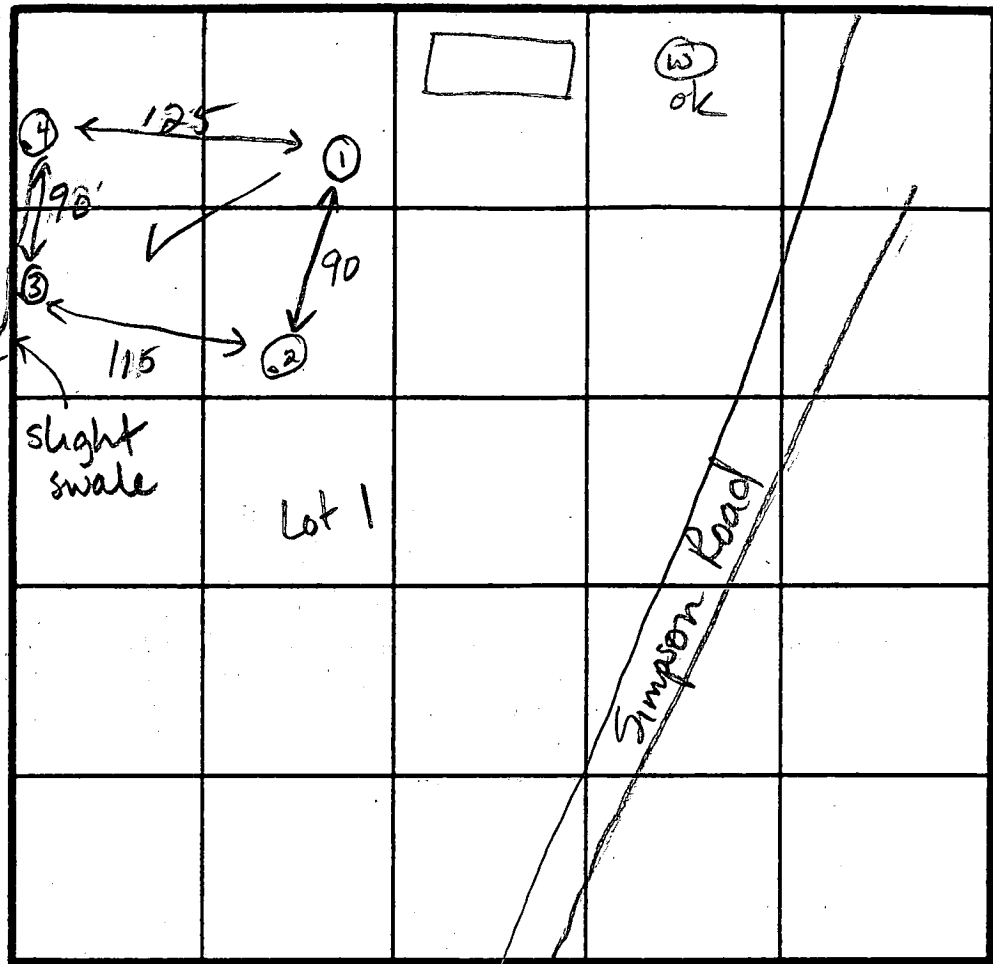

③
0-5.0 Rd-br sa si cl
5.0-12.0 Rd-br silty sand
12.0 Bottom

X = 5 min
Inlet 3.0 ft
Bottom 7.0 ft
160 sq ft/bdrm



INDICATE NORTH - NAME ADJOINING ROADWAY AS BASE LINE.
Hall Shop Road

②
0-4.5 Rd-br si cl lm, tr mica
4.5-11.5 Rd-br si sandy loam
11.5 Bottom

④
0-6.0 Rd-br si clay
6.0-12.5 Rd-br micaceous sa silty loam
12.5 Bottom

DATE	TEST NO.	DEPTH	PRE-WET		TEST - 1" DROP		TIME
			START	STOP	START	STOP	
2-17-89	1	3.0 S	11:13	11:17	11:17	11:21	4
		11.0 D	Bottom (see profile)				
	2	3.0 S	11:15	11:17	11:17	11:19	2
		11.5 D	Bottom (see profile)				
	3	4.0 S	11:16	11:19	11:19	11:23	4
		12.0 D	Bottom (see profile)				
	4	4.5 S	11:22	11:26	11:26	11:37	11
		7.5 M	11:23	11:25	11:25	11:27	2
		12.5 D	Bottom (see profile)				

REMARKS All holes moved from plat location.
TYPE OF SOIL 0-5 Rd-br sa si cl lm, 5-12.5 Rd-br mica sa si lm
TESTED BY Jane E. Nadeau ALSO PRESENT Jack F. Skipsey

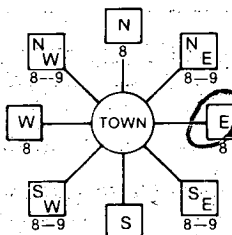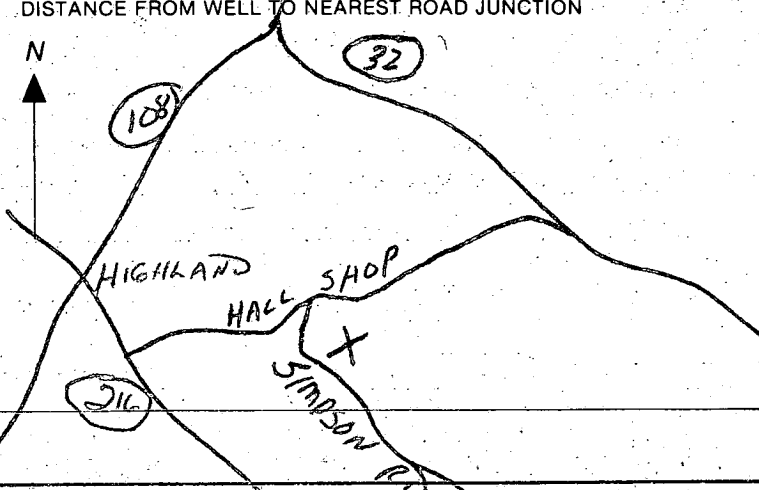B 1 2557 (THIS NUMBER IS TO BE PUNCHED IN COLS. 3-6 ON ALL CARDS)	SEQUENCE NO. (DP USE ONLY) 082488	STATE OF MARYLAND PERMIT TO DRILL WELL please print or type	STATE PERMIT NUMBER H0-88-0156 fill in this form completely
Date Received (APA) 082488		LOCATION OF WELL R-42436 40.10 8/24/88	
OWNER INFORMATION WINCHESTER HOMES INC 15 Last Name Owner First Name 6301 IVY LANE 36 Street or RFD GREEN BELT 70 State 72 Zip 76		B 3 HOWARD 8 COUNTY 21 ASHLEIGH GREENE 42 23 SUBDIVISION SECTION 44 46 LOT 48 50 HIGHLAND 52 NEAREST TOWN 71 MILES FROM TOWN (enter 0 if in town) 2 73 76 77 78	
DRILLER INFORMATION George F. Easterday 77 License No. 80 L. Franklin Easterday, Inc. Firm Name 9265 Brown Church Rd., Mt. Airy, Md. 21771 Address George F. Easterday 8/23/88 Signature Date		B 4 DIRECTION OF WELL FROM TOWN (CIRCLE BOX)  NEAR WHAT ROAD (SIMPSON RD) Wescott PL ON WHICH SIDE OF ROAD (CIRCLE APPROPRIATE BOX)  DISTANCE FROM ROAD 20 34 37 ENTER FT or MI. FT 38 39	
B 2 WELL INFORMATION APPROX. PUMPING RATE (GAL. PER MIN.) 5 8 12 AVERAGE DAILY QUANTITY NEEDED (GAL. PER DAY) 500 14 20		NOT TO BE FILLED IN BY DRILLER HEALTH DEPARTMENT APPROVAL HOWARD R-40708 COUNTY NAME COUNTY NO. STATE SIGNATURE INSERT S 41 DATE ISSUED: 090688 <i>Charles E. Ryan</i> 3/06/87 43 48 CO SIGNATURE EXP. DATE NORTH GRID 489000 50 55 EAST GRID 0819000 57 63	
USE FOR WATER (CIRCLE APPROPRIATE BOX) ☒ HOME (SINGLE OR DOUBLE HOUSEHOLD UNIT ONLY) ☐ FARMING (LIVESTOCK WATERING & AGRICULTURAL IRRIGATION) ☐ INDUSTRIAL, COMMERCIAL, STATE AND FEDERAL GOV. OTHER (REQUIRES APPROPRIATION PERMIT) ☐ PUBLIC OR PRIVATE WATER COMPANY (REQUIRES APPROPRIATION PERMIT AND STATE HEALTH DEPARTMENT APPROVAL) ☐ TEST, OBSERVATION, MONITORING (MAY REQUIRE APPROPRIATION PERMIT)		SHOW MAJOR FEATURES OF BOX & LOCATE WELL WITH AN X SOURCES OF DRILLING WATER 1. WELL 2. 3. WRITE THE BOX-NUMBER FROM THE MAP HERE 	
APPROXIMATE DEPTH OF WELL 200 24 28 FEET APPROXIMATE DIAMETER OF WELL 6 INCH. NEAREST		METHOD OF DRILLING (circle one) ☒ BORED (or Augered) ☐ JETTED Jetted & DRIVEN ☒ AIR-ROTARY 30 37 AIR-PERCussion ROTARY (Hydraulic Rotary) ☐ CABLE REVERSE-ROTARY DRIVE-POINT other _____	
REPLACEMENT OR DEEPEMED WELLS (CIRCLE APPROPRIATE BOX) ☒ THIS WELL WILL NOT REPLACE AN EXISTING WELL ☐ THIS WELL WILL REPLACE A WELL THAT WILL BE ABANDONED AND SEALED ☐ THIS WELL WILL REPLACE A WELL THAT WILL BE USED AS A STANDBY ☐ THIS WELL WILL DEEPEMED AN EXISTING WELL PERMIT NUMBER OF WELL TO BE REPLACED OR DEEPEMED (IF AVAILABLE) 41 _____ 52		DRAW A SKETCH BELOW SHOWING LOCATION OF WELL IN RELATION TO NEARBY TOWNS AND ROADS AND GIVE DISTANCE FROM WELL TO NEAREST ROAD JUNCTION	
Not to be filled in by driller (OEP USE ONLY)			
APPROP. PERMIT NUMBER _____ 54 G A P 63 FORCE ☒ WRITE INITIALS IN BOX PERMIT NO. H0-88-0156 67 68 70 71 72 73 74 75 76 77 78 79			
SPECIAL CONDITIONS			

0674		SEQUENCE NO. (DENV USE ONLY)	STATE OF MARYLAND WELL COMPLETION REPORT		THIS REPORT MUST BE SUBMITTED WITHIN 45 DAYS AFTER WELL IS COMPLETED.	
(THIS NUMBER IS TO BE PUNCHED IN COLS. 3-6 ON ALL CARDS)			FILL IN THIS FORM COMPLETELY PLEASE PRINT OR TYPE			COUNTY NUMBER
DATE Received		DATE WELL COMPLETED		Depth of Well		PERMIT NO. FROM "PERMIT TO DRILL WELL"
1 2 3 4 5 6 7 8 9 10 11 12 13		14 15 16 17 18 19 20 21 22 23 24 25 26		27 28 29 30 31 32 33 34 35 36 37		28 29 30 31 32 33 34 35 36 37
OWNER		last name		first name		TOWN
STREET OR RFD		SUBDIVISION		LOT		
WELL LOG		GROUTING RECORD		PUMPING TEST		
Not required for driven wells		WELL HAS BEEN GROUTED (Circle Appropriate Box)		HOURS PUMPED (nearest hour)		
STATE THE KIND OF FORMATIONS PENETRATED, THEIR COLOR, DEPTH, THICKNESS AND IF WATER BEARING		TYPE OF GROUTING MATERIAL		PUMPING RATE (gal. per min. to nearest gal.)		
DESCRIPTION (Use additional sheets if needed)		CEMENT		METHOD USED TO MEASURE PUMPING RATE		
FEET		BENTONITE CLAY		WATER LEVEL (distance from land surface)		
FROM TO		NO. OF BAGS NO. OF POUNDS		BEFORE PUMPING		
TOP SOIL 0 1		GALLONS OF WATER		WHEN PUMPING		
RED CLAY 1 3		DEPTH OF GROUT SEAL (to nearest foot)		TYPE OF PUMP USED (for test)		
RED MICA 3 75		from ft. to ft.		A air P piston T turbine		
GREEN MICA 75 150		(enter 0 if from surface)		C centrifugal R rotary O other (describe below)		
BLUE MICA 100 300		CASING RECORD		J jet S submersible		
		casing types insert appropriate code below				
		STEEL CONCRETE PLASTIC OTHER				
		MAIN Casing Nominal diameter Total depth				
		TYPE top (main) casing of main casing				
		(nearest inch) (nearest foot)				
		OTHER CASING (if used)				
		diameter depth (feet)				
		inch from to				
		SCREEN RECORD				
		screen type or open hole				
		insert appropriate code below				
		STEEL BRASS OPEN HOLE PLASTIC OTHER				
		DEPTH (nearest ft.)				
		SLOT SIZE 1 2 3				
		DIAMETER OF SCREEN				
		(NEAREST INCH)				
		GRAVEL PACK				
		IF WELL DRILLED WAS FLOWING WELL INSERT				
		F IN BOX 68				
		OEP USE ONLY (NOT TO BE FILLED IN BY DRILLER)				
		T (E.R.O.S.) WQ				
		70 72 74 75 76				
		TELESCOPE CASING LOG INDICATOR OTHER DATA				
		LOCATION OF WELL ON LOT				
		SHOW PERMANENT STRUCTURE SUCH AS BUILDING, SEPTIC TANKS, AND/OR LANDMARKS AND INDICATE NOT LESS THAN TWO DISTANCES (MEASUREMENTS TO WELL)				

8/28/91 AM

HOWARD COUNTY HEALTH DEPARTMENT
Bureau of Environmental Health
3525-H Ellicott Mills Drive
Ellicott City, MD 21043
461-9933

APPLICATION FOR PITLESS ADAPTER, WELL PUMP AND PRESSURE TANK INSTALLATION

New Installation X
Replacement _____
Name of Installer Van Sant Plumbing & Heating
License Number 1467
Certified Well Pump Installer _____ Well Driller _____ Registered Plumber X
Name of Property Owner Winchester Homes
Subdivision Ashleigh Green Lot # 1
Site Address 7000 Westcott Place
Receipt # 47358
Date 7/30/91
Telephone 829-0444
Telephone 670-1010
Well Tag # HD-88-0156

Pump
1. Type
a. Deep well jet _____
b. Shallow well jet _____
c. Submersible _____
2. Make _____
3. Model # _____
4. Capacity _____ GPM
5. Pump exceeds well capacity Yes _____ No _____
6. If Yes, is low pressure cutoff switch installed? Yes _____ No _____
7. What methods are used to protect the pump and electrical wiring from vibrations? Torque arrestors _____ Cable guards _____ Other _____
Motor
1. Horsepower _____
2. RPM _____
3. Voltage _____
a. 110 _____
b. 220 _____
Pitless Adapter
1. Make _____
2. Model # _____
3. Depth _____
Tank
1. Capacity _____
2. Pressure relief valve? _____
Piping
1. Type _____
2. Size _____
3. NSF and/or BOCA Code approved _____
4. Depth of supply line _____
Well data
1. Depth _____ ft.
2. Yield _____ GPM
3. Static water level _____ ft.
4. Will water supply be disinfected by installer? _____


I understand that it is my responsibility to notify the Howard County Health Department when the installation is ready for inspection (otherwise this permit is null and void).

All information given above is true to the best of my knowledge.

Signature of Applicant: [Signature]

Date: 01 11 91

Note: A sticker indicating approval/status of the installation will be placed on the well casing at the time of the inspection.

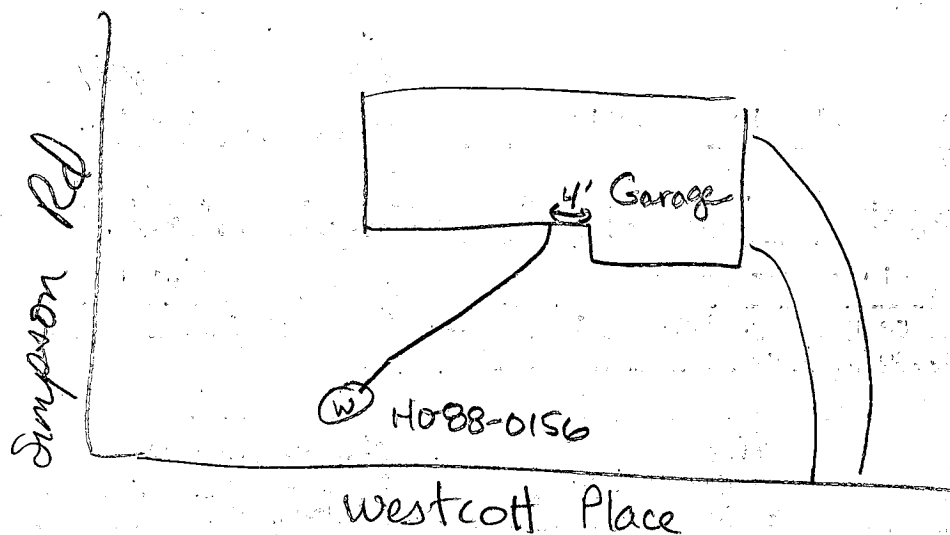

82891 Pitless adaptor at 48' inches below grade.
Well line at 48 inches below grade. House
connection OK. No pump tank installed yet,
Ground line in place but not connected. JEN

RECEIVED
HOWARD COUNTY
HEALTH DEPT.
91 JUL 29 AM 8:51

NOTE: No Portion of this lot lies within the 100 Year Flood Plain, Zone C, Map Panel 38 of 45, dated Dec. 4, 1986.

LOCATION OF HOUSE
7060 WESTCOTT PLACE
LOT 1



ASHLEIGH GREENE SUBDIVISION

SECTION 1

LOTS 1 THRU 27

5TH ELECTION DISTRICT
HOWARD COUNTY, MARYLAND

Wall Check: 11-27-89
Top of Wall El: 512.8
Final: 4-6-92

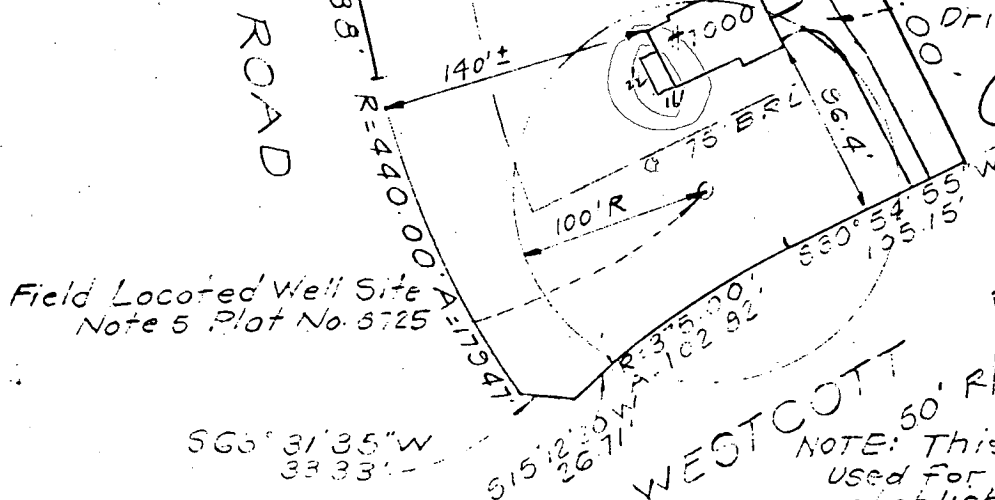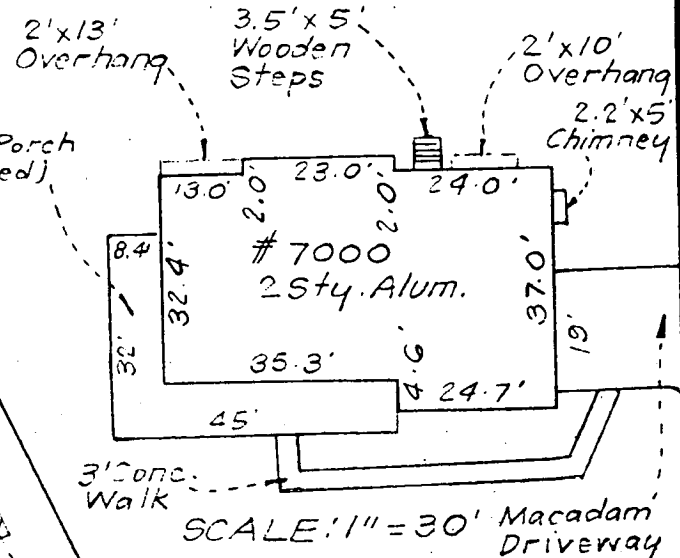

89-001

Serial No. 25456

SURVEYOR'S CERTIFICATE

I hereby certify that the position of all existing improvements on the above described property have been carefully established by a transit-tape survey and that unless otherwise shown, there are no encroachments.

Donald B. Sackett #6059

CLARK • FINEFROCK & SACKETT, INC.

ENGINEERS • PLANNERS • SURVEYORS
7135 MINSTREL WAY COLUMBIA, MD. 21045
(410) 381-7500-BALTO. • (301) 621-8100-WASH.

REFERENCE

Plat

No. 8726

DRAWN BY SNP

DATE 4-6-92

SCALE 1"=100'

CHECKED BY KWC

FILE NO.

1370-W

NOTE: No Portion of this lot lies within the 100 Year Flood Plain.

LOCATION OF HOUSE
7000 WEST COTT PLACE
LOT 1


ASHLEIGH GREENE
SURDIVISION

SECTION 1

LOTS 1 THRU 27

5TH ELECTION DISTRICT
HOWARD COUNTY, MARYLAND

Wall Check: 11-27-89
Top of Wall El: 512.8

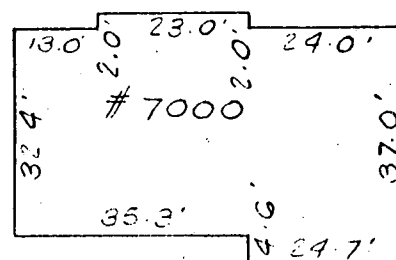

SCALE: 1" = 30'

Field Located Well Site
Note 5 Plot No. 8342

PLACE 8/1792
PLANS OK
BP 4505
R2K

89-001

Serial/No. 25456

SURVEYOR'S CERTIFICATE

I hereby certify that the position of all existing improvements on the above described property have been carefully established by a transit-tape survey and that unless otherwise shown, there are no encroachments.

CLARK • FINEFROCK & SACKETT, INC.

ENGINEERS • PLANNERS • SURVEYORS
7135 MINSTREL WAY COLUMBIA, MD. 21045
(301) 381-7500-BALTO. • (301) 621-8100-WASH.

REFERENCE	DRAWN BY <i>SNP</i>	CHECKED BY <i>KWC</i>
Plat <i>No. 8343</i>	DATE <i>11-29-89</i>	FILE NO. <i>1370-W</i>
	SCALE <i>1"=100'</i>	

WINGH.

NOTE: No Portion of this lot lies within the 100 Year Flood Plain.


LOCATION OF HOUSE
7000 WESTCOTT PLACE
LOT 1

ASHLEIGH GREENE
SUBDIVISION
SECTION 1
LOTS 1 THRU 27
5TH ELECTION DISTRICT
HOWARD COUNTY, MARYLAND

SEPTIC TANK
ELEV. 512.8

Wall Check: 11-27-89
Top of Wall El: 512.8

EXISTING
DECK

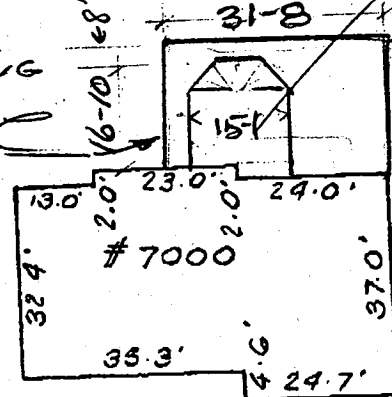

SCALE: 1" = 30'

EXISTING DECK

SOLARIUM 16-10X15-1
249

PERMITTED
DECK IS
8' TO
SEPTIC CLEANOUT
SOLARIUM TO
BE LOCATED ON
DECK
(800113550)
OK AS PROPOSED
COWELL

Field Located Well Site
Note 6 Plot No. 0342

89-001

Serial No. 25456

SURVEYOR'S CERTIFICATE

I hereby certify that the position of all existing improvements on the above described property have been carefully established by a transit-tape survey and that unless otherwise shown, there are no encroachments.

Ronald B. Sackett #6059

CLARK • FINEFROCK & SACKETT, INC. 8/13/98

ENGINEERS • PLANNERS • SURVEYORS
7135 MINSTREL WAY
COLUMBIA, MD. 21045
(301) 381-7500-BALTO. • (301) 621-8100-WASH.

REFERENCE	DRAWN BY	CHECKED BY
Plot No. 0343	SNP	KWC
	DATE 11-29-89	FILE NO. 1370-W
	SCALE 1"=100'	

BRUNING 40-22 60545-01