

8/30/91 P. 11/00

# PERMIT

## SEWAGE DISPOSAL SYSTEM

### DEPARTMENT OF HEALTH AND MENTAL HYGIENE

INDEXED

#### HOWARD COUNTY HEALTH DEPARTMENT

BUREAU OF ENVIRONMENTAL HEALTH

461-9933

05-409845

P 47410

A 40710

DISTRICT 5th

DATE 8-14-91

DATE SYSTEM APPROVED 8/30/91

INSPECTOR R. H.

VanSant Plumbing & Heating, Inc.

IS PERMITTED TO INSTALL ☒ ALTER

ADDRESS 3 North Main Street, Mt. Airy, Maryland 21771 PHONE 795-6566

SUBDIVISION Ashleigh Greene, Sec. 1 LOT 3 ROAD 6988 Westcott Place

PROPERTY OWNER Winchester Homes, Inc. Real Estate Development Group

ADDRESS

SEPTIC TANK CAPACITY 1250 GALLONS

NUMBER OF BEDROOMS 4

180 SQUARE FEET PER BEDROOM

LINEAR FEET OF TRENCH REQUIRED 144

"CONTRACTOR MUST REQUEST SITE INSPECTION BY HEALTH DEPARTMENT PRIOR TO ANY EXCAVATION."

TRENCHES - Trench to be 2 feet wide. Inlet 3 feet below original grade. Bottom maximum depth 8 feet below original grade. Effective area begins at 3 feet below original grade. 5 feet of stone below distribution pipe.

LOCATION - Place the distribution box 175 feet down the right lot line and 10 feet off the same lot line as seen when facing the lot from Westcott Place. Run trenches on contour toward the left lot line. Maintain a minimum of 100 feet from the well.

NOTE - No trench to exceed 100 feet in length. Provide 6" - 8" diameter cleanout and cap to grade or above on septic tank.

8-28-91 Ok to start excavation. Well is 137 ft from dist. box location. JEN

PLANS APPROVED BY Jane Nadeau

DATE 6/07/89

COVER NO WORK UNTIL INSPECTED AND APPROVED

NEITHER THE HOWARD COUNTY COUNCIL NOR THE HEALTH DEPARTMENT IS RESPONSIBLE FOR THE SUCCESSFUL OPERATION OF ANY SYSTEM

NOTE: CLEANOUT REQUIRED EVERY 70 FEET OF SEWER LINE AND/OR AT 90° SWEEPS IN LINES FROM HOUSE TO DRAIN FIELDS, 90° ELBOWS NOT ACCEPTABLE.

NOTE: ALL PARTS OF SEPTIC SYSTEMS (I.E. TANK, DISTRIBUTION BOX TRENCHES) TO BE 100 FEET FROM WELL (UNLESS OTHERWISE SPECIFICALLY AUTHORIZED)

NOTE: IF DEEP TRENCH(ES) ARE USED CALL FOR INSPECTION BEFORE AND AFTER PLACING GRAVEL IN TRENCH(ES)

NOTE: NO DRY WELL SHALL EXCEED 15 FOOT IN DIAMETER NO ABSORPTION TRENCH TO EXCEED 100 FEET IN LENGTH

NOTE: ALL PIPE FROM HOUSE TO SEPTIC TANK MUST BE CAST IRON OR SCHEDULE 35/40 PVC OR ABS

BLDG. PERMIT SIGNED

PERMIT VOID AFTER TWO YEARS

AND RETURNED 7/10/92

Serial #42086 deck

NOTE: INSTALL STAND PIPE ON SEPTIC TANK AND DRY WELL STAND PIPES MUST BE 6 INCHES IN DIAMETER CAST IRON. CONCRETE OR TERRA COTTA OR PVA OR ABS ACCEPTED. IF TOP OF SEPTIC TANK IS DEEPER THAN 3 FEET. MANHOLE TO GRADE REQUIRED.


NOTE: DISTRIBUTION BOXES MUST HAVE BAFFLES

\*INSTALLER IS RESPONSIBLE FOR OBTAINING FINAL APPROVAL ON THIS PERMIT

HD-260(6-90)

\*CALL 461-9933 FOR INSPECTION OF SEPTIC SYSTEM.

A 40710

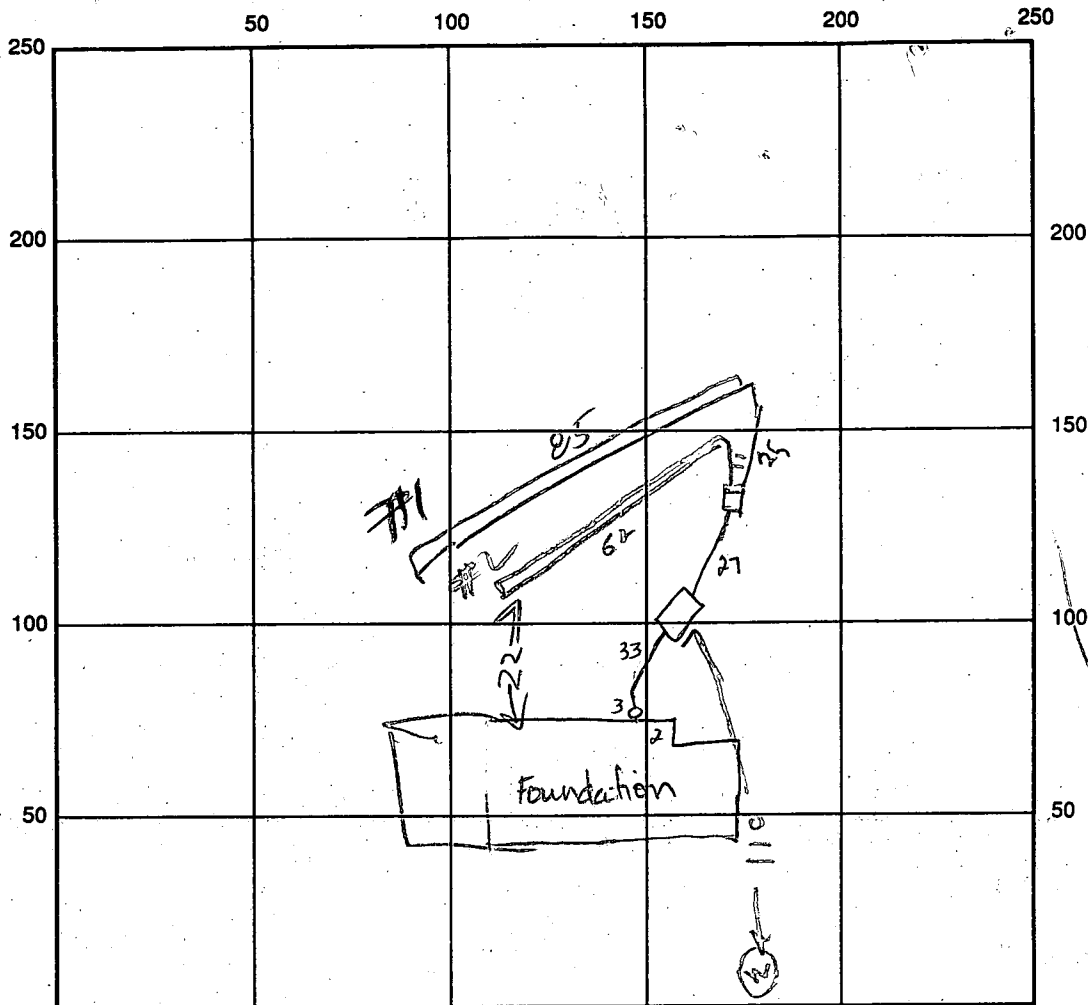

INDICATE NORTH - NAME ADJOINING ROADWAY AS BASE LINE

Westcott Place ST HOUSE SEWER

SEPTIC TANK LEVEL 1250 gal

CLEANOUTS OK OK

DISTRIBUTION BOX LEVEL

DRAIN FIELD/TITLE DEPTH 8 FT.

TRENCH WIDTH 2 FT.

INLET DEPTH 3 FT.

EFFECTIVE GRAVEL DEPTH 5 FT.

TOTAL LENGTH 85.62 FT. 147

NUMBER OF TRENCHES 2

ONE SIDEWALL/BOTTOM AREA 735 SQ. FT.

DRYWALL INSIDE DIAMETER

EFFECTIVE DEPTH BELOW INLET

ABSORBENT AREA

REMARKS: 8-29-91 OK to cover lines to tank and distribution box. DEN

8/30/91 TRENCHES DUG ADD STONE RHT

8/30/91 1306m TRENCH #1 OK RHT

8/30/91 3450m TRENCH #2 OK RHT

DATE SYSTEM APPROVED 8/30/91

INSPECTOR Raymond Hodger

# APPLICATION

PERCOLATION TESTING

A 40716

P \_\_\_\_\_

HOWARD COUNTY HEALTH DEPARTMENT  
BUREAU OF ENVIRONMENTAL HEALTH  
P.O. BOX 476 ELLICOTT CITY, MARYLAND 21043  
TELEPHONE: 461-9933

DISTRICT 5th

DATE 12/1/87

TO: THE COUNTY HEALTH OFFICER  
ELLICOTT CITY, MARYLAND

I, HEREBY, APPLY FOR THE NECESSARY TEST IN ORDER TO CONSTRUCT (OR RECONSTRUCT) A SEWAGE DISPOSAL SYSTEM.

PROPERTY OWNER Winchester Homes, Inc. Real Estate Development Group

ADDRESS 6301 Ivy Lane Greenbelt, MD 20770 PHONE 301-220-1117

PROSPECTIVE BUYER N/A

ADDRESS N/A PHONE \_\_\_\_\_

PROPERTY LOCATION:

SUBDIVISION Ashleigh Greene Section I LOT NO. 3

ROAD AND DESCRIPTION Intersection Hall Shop Road & Simpson Road  
6988 Westcott Place

TAX MAP 41 PARCEL # 139

SIZE OF LOT 3.0 AC TYPE BLDG Single Family  
(SINGLE FAMILY DWELLING OR COMMERCIAL)

THE SYSTEM INSTALLED UNDER THIS APPLICATION IS ACCEPTABLE ONLY UNTIL PUBLIC FACILITIES BECOME AVAILABLE. I FULLY UNDERSTAND THE

FEE CONNECTED WITH THE FILING OF THIS PERC TEST APPLICATION IS NON-REFUNDABLE UNDER ANY CIRCUMSTANCES. I ALSO AGREE TO COMPLY

WITH ALL M.O.S.H.A. REQUIREMENTS IN TESTING THIS LOT. Burley B. Handley  
(SIGNATURE OF APPLICANT)

APPROVED BY \_\_\_\_\_ FOR \_\_\_\_\_ DATE \_\_\_\_\_

REJECTED BY \_\_\_\_\_ FOR \_\_\_\_\_ DATE \_\_\_\_\_

HOLD PENDING FURTHER TESTS \_\_\_\_\_ DATE \_\_\_\_\_

REASONS FOR REJECTION OR HOLDING 2-17-88 Pending subdivision plat approval and

perc hole locations JEN

BLDG. PERMIT SIGNED  
AND RETURNED 8/1/89  
Serial # 27469  
SFD - 4 Bedroom

## THIS IS NOT A PERMIT


High 4  
Low 2

Westcott Place

SOIL PROFILE

0-5.0 Rd-br si Clay lm  
5.0-12.0 Brown micaceous sa si lm  
12.0 Bottom

Lot 4

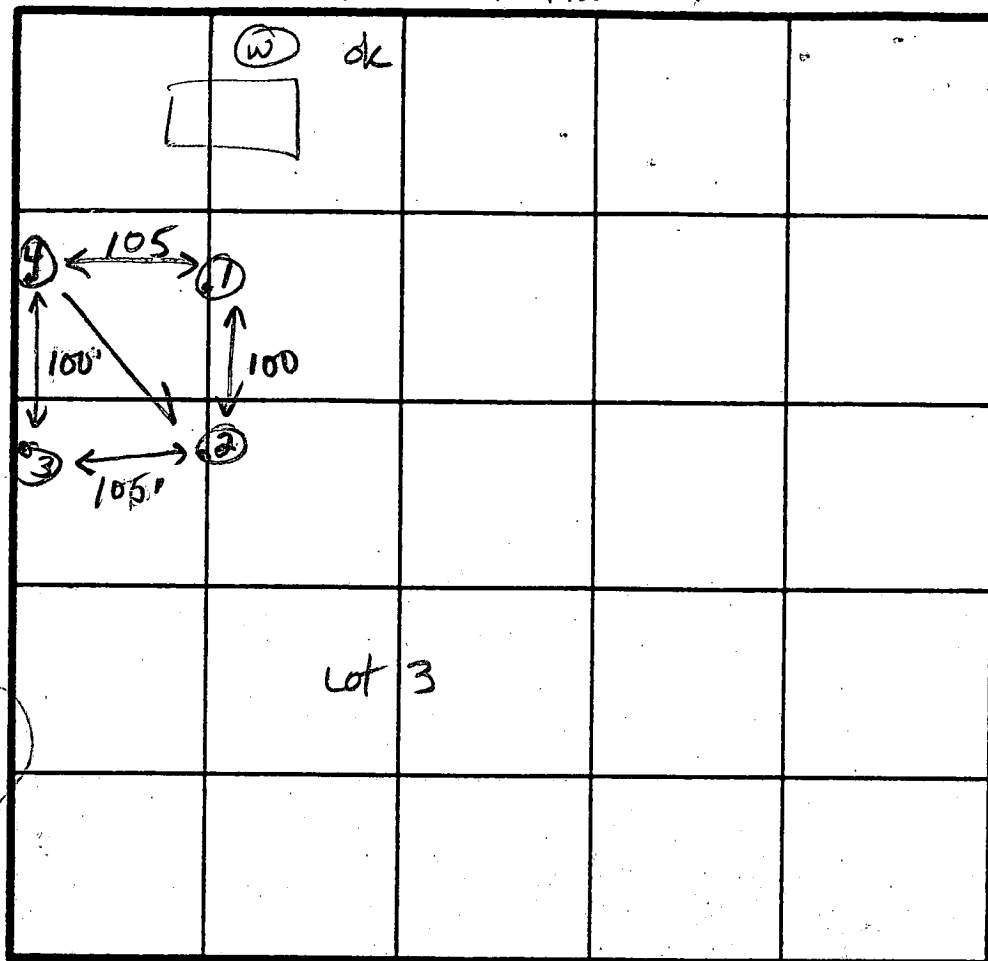

0-4 Br si clay  
4.0-11.5 Red sa si lm, trc mica  
11.5 Bottom

Lot 2

$\bar{X} = 5 \text{ min}$   
Inlet 3.5 ft  
Bottom 8.0 ft  
180 sq ft / bdrm

②

0-3.5 Red-br si cl loam  
3.5-12.0 Br mica sa si lm  
12.0 Bottom

③

0-3.5 Br si cl lm  
3.5-12 Red-br sa si loam, trc gvl  
45%  
12.0 Bottom

Hall Shop Road

INDICATE NORTH - NAME ADJOINING ROADWAY AS BASE LINE.

DATE	TEST NO.	DEPTH	PRE WET		TEST - 1" DROP		TIME
			START	STOP	START	STOP	
2-7-88	1	4.0 S	11:50	11:54	11:54	12:01	7 min
		12.0 D	Bottom (see profile)				
	2	3.0 S	11:49	11:51	11:51	11:53	2
		12.0 D	Bottom (see profile)				
	3	4.5 S	12:03	12:06	12:06	12:14	8
		12.0 D	Bottom (see profile)				
	4	4.5 S	11:59	12:02	12:02	12:05	3
		6.5 M	12:00	12:03	12:03	12:05	2
		11.5 D	Bottom (see profile)				

REMARKS All holes located as shown on plat.

TYPE OF SOIL 0-4 Rd-br si cl lm 4-12 Rd-br sa si lm

TESTED BY JE Nadeau

ALSO PRESENT Jack F. Skippy

~~Lot 4~~

610.80



12  
22  
98  
144  
72

WINCH.


NOTE: No Portion of this lot lies within the 100 Year Flood Plain, Zone C, Map Panel 38 of P45 dated Dec. 4, 1986.

LOCATION OF HOUSE  
6988 WESTCOTT PLACE  
LOT 3

ASHLEIGH GREENE  
SUBDIVISION  
SECTION 1

LOTS 1 THRU 27  
5TH ELECTION DISTRICT  
HOWARD COUNTY, MARYLAND

Wall Check: 2-23-90  
Top of Wall El: 516.4  
Final: 10-24-91

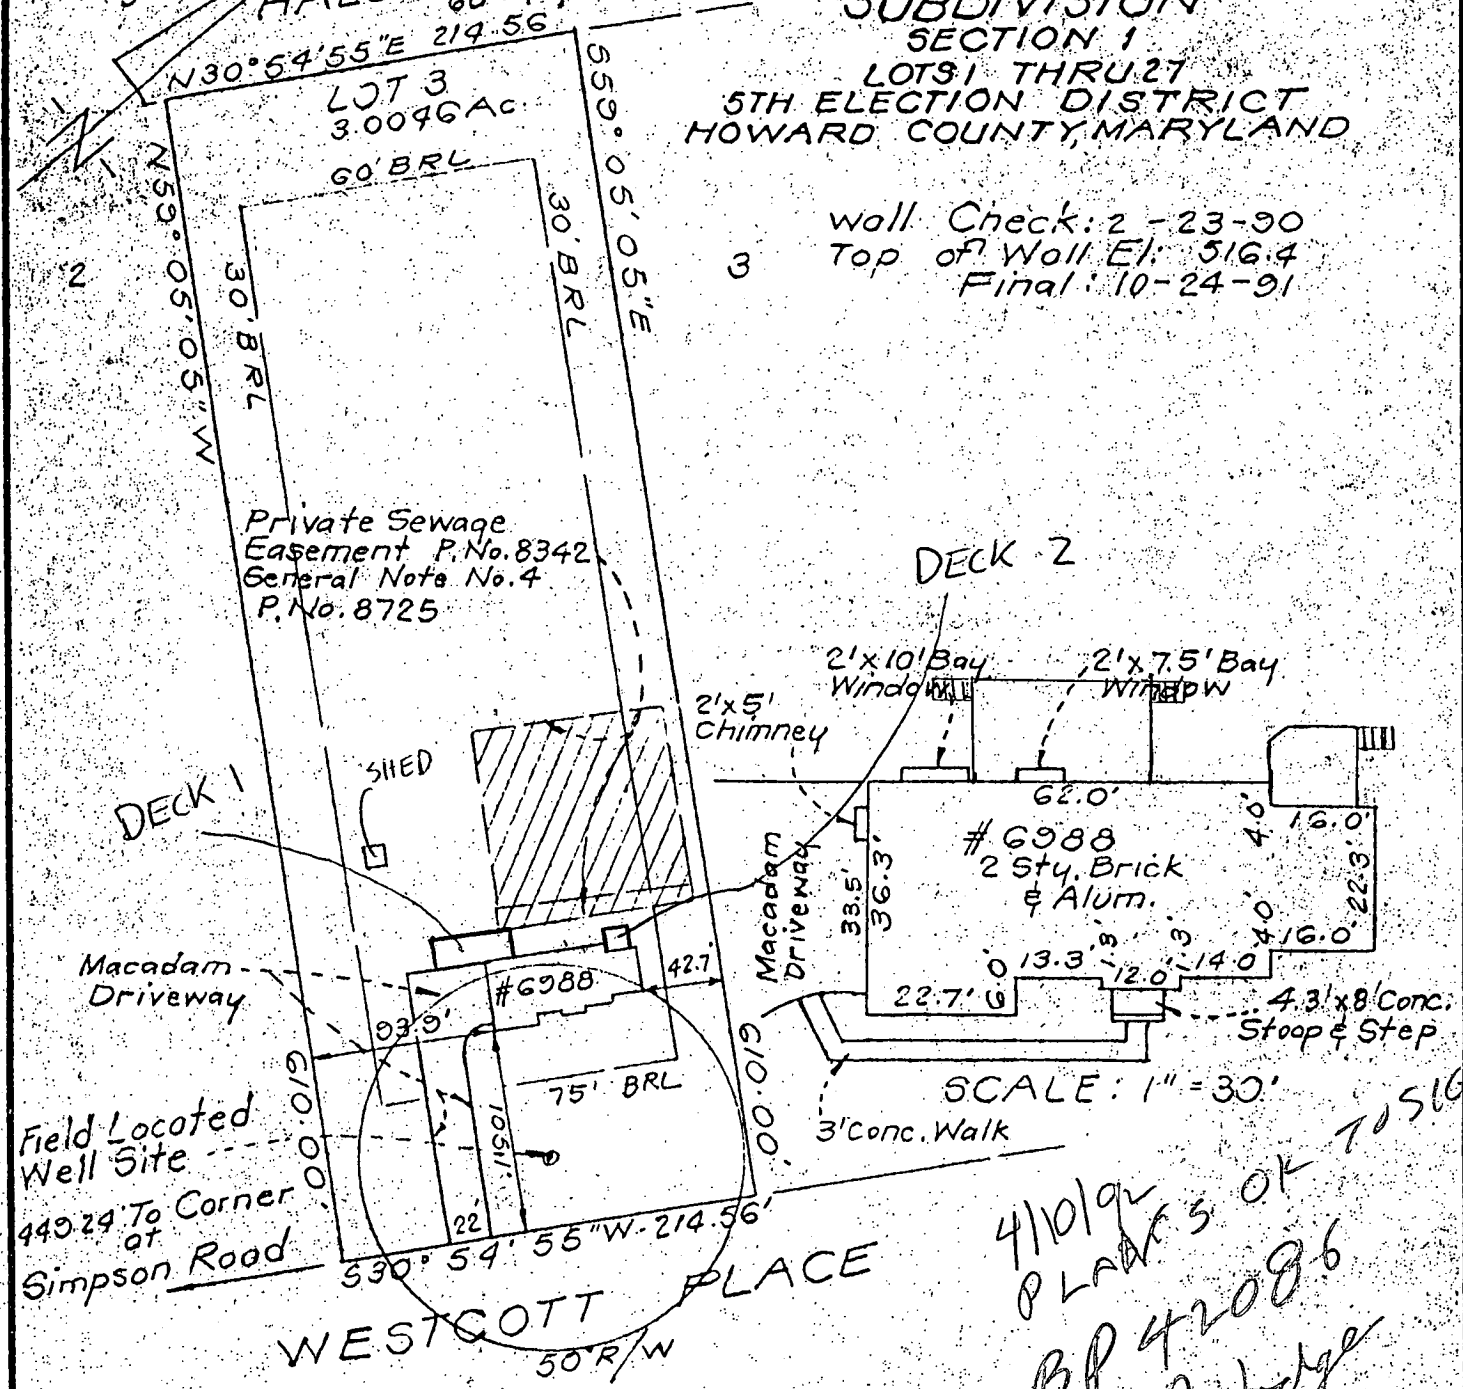

89-001

**SURVEYOR'S CERTIFICATE**

I hereby certify that the position of all existing improvements on the above described property have been carefully established by a transit-tape survey and that unless otherwise shown, there are no encroachments.

*Donald B. Schuch*  
6059  
6059

**CLARK • FINEFROCK & SACKETT, INC.**

ENGINEERS • PLANNERS • SURVEYORS  
7135 MINSTREL WAY COLUMBIA, MD. 21045  
(301) 381-7500-BALTO. • (301) 621-8100-WASH.

REFERENCE	DRAWN BY	CHECKED BY
Plat No. 8726	SNP	KWC
	DATE 2-23-90	FILE NO.
	SCALE 1"=100'	1803-W

BRUNING 40-22 60545-01

LOT 1  
3.0 Ac.

LOT 2  
3.0 Ac.

LOT 3  
3.0 Ac.

310.5  
27.8  
30.6  
43  
82.3  
23.3  
33.6  
16.4  
24.6  
20.6  
21.8  
11.7

30' BRL  
630'





30' BRL  
630'

30' BRL  
630'

30' BRL  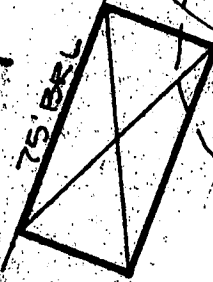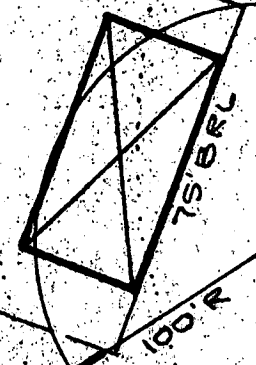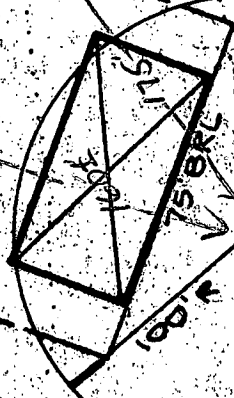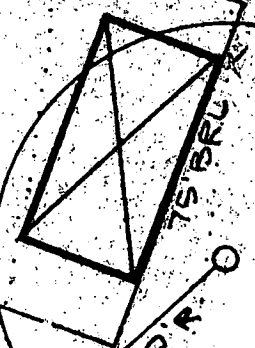
460'

WESTCOTT

100' B

old perc  
#8

8-30-88  
well #3

210'

400'

235'

100' B

75' BRL

100' B

75' BRL

100' B

75' BRL

100' B

75' BRL

100' B



75' BRL

100' B

75' BRL

100' B

75' BRL

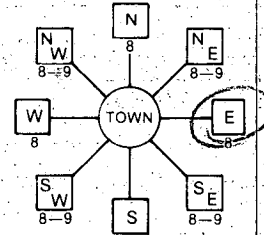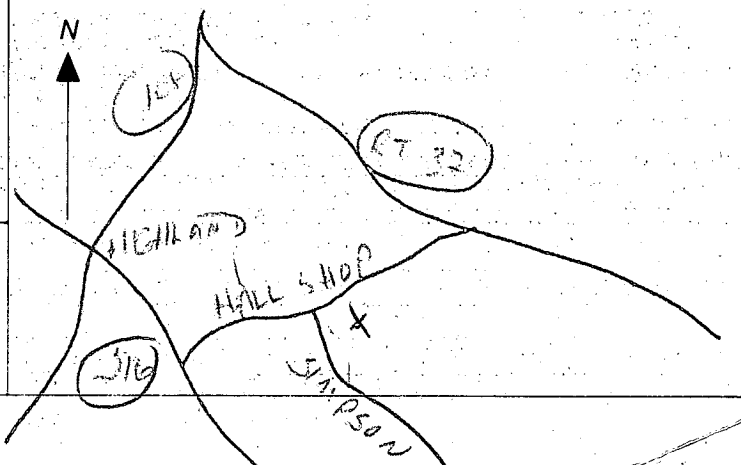B 1	2585	SEQUENCE NO. (DP USE ONLY)	STATE OF MARYLAND PERMIT TO DRILL WELL	STATE PERMIT NUMBER <b>HO-88-0158</b>
(THIS NUMBER IS TO BE PUNCHED IN COLS. 3-6 ON ALL CARDS)		please print or type		
Date Received (APA) <b>082488</b>		LOCATION OF WELL <b>R 42438</b> <b>40.10</b> <b>8/24/89</b>		
OWNER INFORMATION <b>WINCHESTER HOMES INC</b> 15 Last Name      Owner      First Name      34 <b>6301 IVY LANE</b> 36      Street or RFD      55 <b>GREENBELT</b> <b>MD 20770</b> 57      Town      70 State 72      Zip      76		8 COUNTY <b>H WARD</b> 21 23 SUBDIVISION <b>HAILEIGH GREENE</b> 42 SECTION <b>44</b> 46      LOT <b>3</b> 48      50 <b>HIGHLAND</b> 52 NEAREST TOWN      71		
DRILLER INFORMATION <b>George F. Easterday</b> Driller's Name      40      41 <b>L. Franklin Easterday, Inc.</b> Firm Name      77 License No. 80 <b>9265 Brown Church Rd., Mt. Airy, Md. 21771</b> Address <b>George F. Easterday</b> <b>8/23/88</b> Signature      Date		MILES FROM TOWN (enter 0 if in town) <b>2</b> 73      76      77      78 <b>MI</b>		
WELL INFORMATION APPROX. PUMPING RATE (GAL. PER MIN.) <b>5</b> 8      12 AVERAGE DAILY QUANTITY NEEDED (GAL. PER DAY) <b>500</b> 14      20		DIRECTION OF WELL FROM TOWN (CIRCLE BOX) 		
USE FOR WATER (CIRCLE APPROPRIATE BOX) <input checked="" type="radio"/> HOME (SINGLE OR DOUBLE HOUSEHOLD UNIT ONLY) <input type="radio"/> FARMING (LIVESTOCK WATERING & AGRICULTURAL IRRIGATION) <input type="radio"/> INDUSTRIAL, COMMERCIAL, STATE AND FEDERAL GOV. OTHER (REQUIRES APPROPRIATION PERMIT) <input type="radio"/> PUBLIC OR PRIVATE WATER COMPANY (REQUIRES APPROPRIATION PERMIT AND STATE HEALTH DEPARTMENT APPROVAL) <input type="radio"/> TEST, OBSERVATION, MONITORING (MAY REQUIRE APPROPRIATION PERMIT)		NOT TO BE FILLED IN BY DRILLER HEALTH DEPARTMENT APPROVAL <b>HOWARD</b> <b>A#40710</b> COUNTY NAME      COUNTY NO. STATE SIGNATURE      INSERT S      41 DATE ISSUED <b>090688</b> <b>Charles E. Ryan</b> <b>8/24/89</b> 43      48      CO SIGNATURE      EXP. DATE NORTH GRID <b>489000</b> 50      55      EAST GRID <b>0819000</b> 57      63		
APPROXIMATE DEPTH OF WELL <b>300</b> 24      28      FEET		SHOW MAJOR FEATURES OF BOX & LOCATE WELL WITH AN X SOURCES OF DRILLING WATER 1. <b>WELL</b> 2. 3. WRITE THE BOX NUMBER FROM THE MAP HERE E <b>810</b> 9 N <b>410</b> 9 000 000		
APPROXIMATE DIAMETER OF WELL <b>6</b> NEAREST INCH.		DRAW A SKETCH BELOW SHOWING LOCATION OF WELL IN RELATION TO NEARBY TOWNS AND ROADS AND GIVE DISTANCE FROM WELL TO NEAREST ROAD JUNCTION 		
METHOD OF DRILLING (circle one) BORED (or Augered)      JETTED      Jetted & DRIVEN 30. <b>AIR-ROTARY</b> AIR-PERCussion      ROTARY (Hydraulic Rotary) 37. <b>CABLE</b> REVERSE-ROTARY      DRIVE-POINT other _____				
REPLACEMENT OR DEEPEMED WELLS (CIRCLE APPROPRIATE BOX) <input checked="" type="radio"/> THIS WELL WILL NOT REPLACE AN EXISTING WELL <input type="radio"/> THIS WELL WILL REPLACE A WELL THAT WILL BE ABANDONED AND SEALED 39. <input type="radio"/> THIS WELL WILL REPLACE A WELL THAT WILL BE USED AS A STANDBY <input type="radio"/> THIS WELL WILL DEEPEMED AN EXISTING WELL PERMIT NUMBER OF WELL TO BE REPLACED OR DEEPEMED (IF AVAILABLE)      41      52				
Not to be filled in by driller (OEP USE ONLY) APPROP. PERMIT NUMBER      54      GAP      63 FORCE <input checked="" type="checkbox"/> WRITE INITIALS IN BOX      PERMIT NO. <b>HO-88-0158</b> 67      68      70      71      72      73      74      75      76      77      78      79				
SPECIAL CONDITIONS				



