

11-17/90 11/100
11/17/90 ASAP
11/18/90
(9/21/90 A.M. - A.S.A.P.)

{ NEEDS HOUSE CONNECTION }
ONLY
11/18/90 (2) P.C.O.
C.B.D.
9-21-90 Final ok
JEN
P 46371
A 40713

PERMIT

SEWAGE DISPOSAL SYSTEM

MARYLAND STATE DEPARTMENT OF HEALTH

DISTRICT 5th

HOWARD COUNTY
BUREAU OF ENVIRONMENTAL HEALTH
461-9933

05-409888
INDEXED

DATE 12/27/89

DATE SYSTEM APPROVED 9-21-90

INSPECTOR JEN

Frall Septic Service, Inc.

IS PERMITTED TO INSTALL ☒ ALTER ☐

ADDRESS P. O. Box 659, Mt. Airy, Maryland 21771 PHONE 795-5674

SUBDIVISION Ashleigh Greene ROAD 6970 Wescott Place LOT 6

PROPERTY OWNER Winchester Homes, Inc. Chip & Lori Yarns

ADDRESS

IF GARBAGE GRINDER IS USED INCREASE SEPTIC TANK CAPACITY BY 50% AND ABSORPTION AREA BY 22%.

GARBAGE GRINDER? YES ☒ NO ☒

SEPTIC TANK CAPACITY 2000 GALLONS NUMBER OF BEDROOMS 5

TRENCHES - 180 sq. ft. per bedroom. Trench to be 2 feet wide. Inlet 5 feet below original grade. Bottom maximum depth 9 feet below original grade. Effective area begins at 5 feet below original grade. 4 feet of stone below distribution pipe.

LOCATION - Start the first trench 170 feet from the front lot line and 10 feet from the left lot line as seen when facing the lot from Wescott Place. Run 3-92 ft. trenches on contour toward the right lot line.

NOTE - No trench to exceed 100 feet in length. Provide 6" - 8" diameter cleanout and cap to grade or above on septic tank. SKICW

PLANS APPROVED BY Sid Abel

DATE 5/10/89

COVER NO WORK UNTIL INSPECTED AND APPROVED

NEITHER THE HOWARD COUNTY COUNCIL NOR THE HEALTH DEPARTMENT IS RESPONSIBLE FOR THE SUCCESSFUL OPERATION OF ANY SYSTEM

NOTE: CLEANOUT REQUIRED EVERY 70 FEET OF SEWER LINE AND/OR AT 90° SWEEPS IN LINES FROM HOUSE TO DRAIN FIELDS

NOTE: ALL PARTS OF SEPTIC SYSTEMS (I.E. TANK, DISTRIBUTION BOX, TRENCHES) TO BE 100 FEET FROM WELL (UNLESS OTHERWISE SPECIFICALLY AUTHORIZED)

NOTE: IF DEEP TRENCHES ARE USED CALL FOR INSPECTION BEFORE AND AFTER PLACING GRAVEL IN TRENCHES

NOTE: NO DRY WELL SHALL EXCEED 15 FOOT IN DIAMETER NO ABSORPTION TRENCH TO EXCEED 100 FEET IN LENGTH

NOTE: ALL PIPE FROM HOUSE TO SEPTIC TANK MUST BE CAST IRON OR SCHEDULE 40 PVC OR ABS

PERMIT VOID AFTER TWO YEARS


NOTE: INSTALL STAND PIPE ON SEPTIC TANK AND DRY WELL. STAND PIPES MUST BE 6 INCHES IN DIAMETER. CAST IRON, CONCRETE OR TERRA COTTA OR PVC OR ABS ACCEPTED. IF TOP OF SEPTIC TANK IS DEEPER THAN 3 FEET, MANHOLE TO GRADE REQUIRED

NOTE: DISTRIBUTION BOXES MUST HAVE BAFFLES

Add on Deck
BLDG. PERMIT SIGNED
AND RETURNED 7-10-96
5# B00100919

*INSTALLER IS RESPONSIBLE FOR OBTAINING FINAL APROVAL ON THIS PERMIT

*CALL 461-9933 FOR INSPECTION OF SEPTIC SYSTEMS.

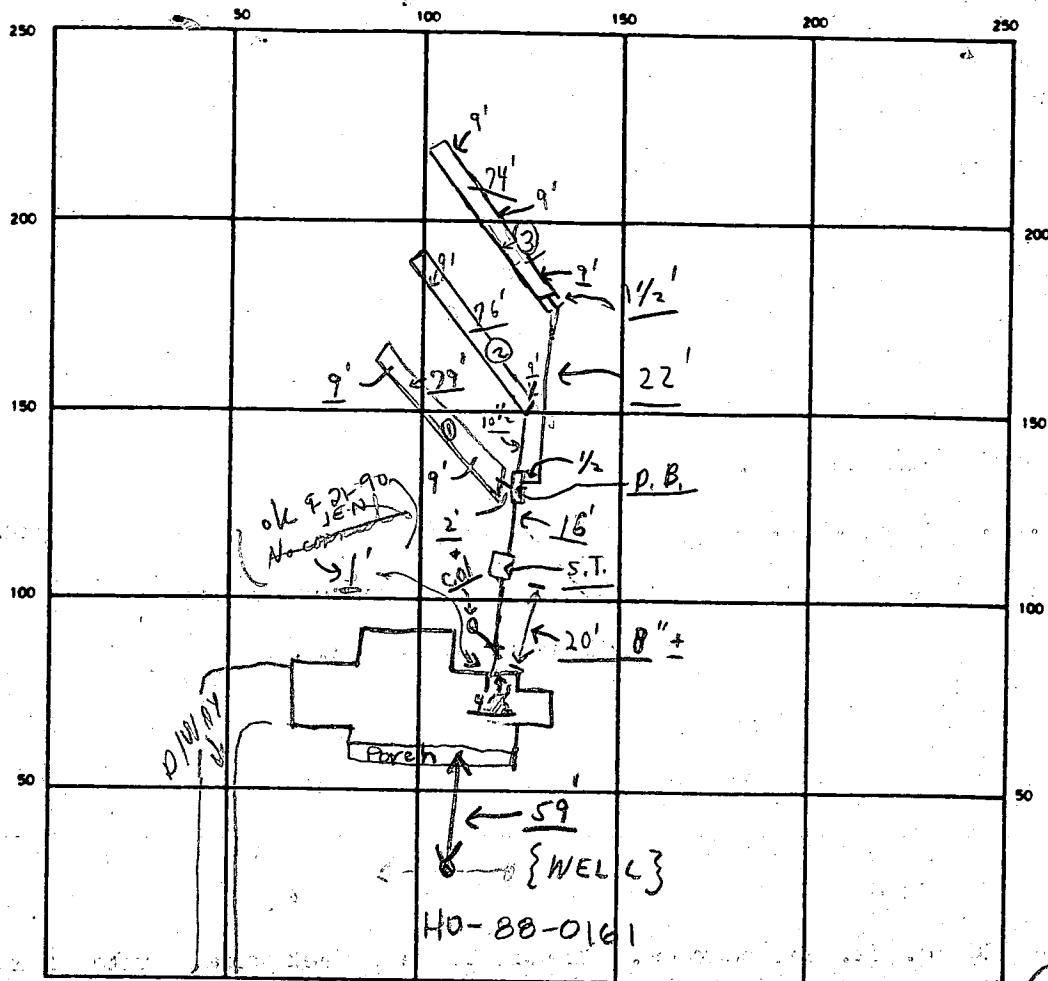

INDICATE NORTH - NAME ADJOINING ROADWAY AS BASE LINE

WESCOTT PLACE

C.O. / S.T.

SEPTIC TANK LEVEL OK

CLEANOUTS OK / OK

DISTRIBUTION BOX LEVEL OK (Baffle is in)

DRAIN FIELD/TILE FIELD DEPTH 9 FT. TRENCH WIDTH 2 FT. INLET DEPTH 5 FT.

EFFECTIVE GRAVEL DEPTH 4 + 3 FT. TOTAL LENGTH 22.9 FT.

NUMBER OF TRENCHES 3 ONE SIDEWALL/BOTTOM AREA 916 SQ FT.

DRYWELL INSIDE DIAMETER FT. EFFECTIVE DEPTH BELOW INLET FT.

ABSORBENT AREA 916 SQ. FT.

REMARKS 1/17/90 ① Partial ok to stone # ① Trench only; C.B.D.
1/17 Late P.M. → ok to cover # ① Trench; partial → HOLD FOR A CALL
1/18/90 → ② Trench ok for stone; partial; 1/18/90 ok to cover # ② Trench
1/19/90 A.M. → ③ Trench - ok for stone; partial; 1/19/90 ok to cover
all work - partial
9-21-90 House connection ok
Note 1/17/18 NO W.P.I INSPECTION C.B.D. → HOLD - Needs house connection only.
partial 1/19 W.P.I. - 9" 1/2 1/90 Pitless adapter + line only ok - partial. C.B.D.
 DATE SYSTEM APPROVED 9" 1/2 1/90 INSPECTOR JEN Nadeau

APPLICATION

PERCOLATION TESTING

HOWARD COUNTY HEALTH DEPARTMENT
BUREAU OF ENVIRONMENTAL HEALTH
P.O. BOX 476 ELLICOTT CITY, MARYLAND 21043
TELEPHONE: 461-9933

A 40713
P 45371

DISTRICT 5th

DATE 12/1/87

TO: THE COUNTY HEALTH OFFICER
ELLICOTT CITY, MARYLAND

I, HEREBY, APPLY FOR THE NECESSARY TEST IN ORDER TO CONSTRUCT (OR RECONSTRUCT) A SEWAGE DISPOSAL SYSTEM.

PROPERTY OWNER Winchester Homes, Inc. Real Estate Development Group

ADDRESS 6301 Ivy Lane Greenbelt, MD 20770 PHONE 301-220-1117

PROSPECTIVE BUYER N/A

ADDRESS N/A PHONE _____

PROPERTY LOCATION:

SUBDIVISION Ashleigh Greene Section I LOT NO 6

ROAD AND DESCRIPTION Intersection Hall Shop Road & Simpson Road

6970 Westcott Place

TAX MAP 41 PARCEL # 139

SIZE OF LOT 3.0 AC TYPE BLDG Single Family
(SINGLE FAMILY DWELLING OR COMMERCIAL)

THE SYSTEM INSTALLED UNDER THIS APPLICATION IS ACCEPTABLE ONLY UNTIL PUBLIC FACILITIES BECOME AVAILABLE. I FULLY UNDERSTAND THE FEE CONNECTED WITH THE FILING OF THIS PERC TEST APPLICATION IS NON-REFUNDABLE UNDER ANY CIRCUMSTANCES. I ALSO AGREE TO COMPLY WITH ALL M.O.S.H.A. REQUIREMENTS IN TESTING THIS LOT.

Bruce G. Hamilton
(SIGNATURE OF APPLICANT)

APPROVED BY Ed Abel FOR Dep. Engineer DATE 5-10-89

REJECTED BY _____ FOR _____ DATE _____

HOLD PENDING FURTHER TESTS _____ DATE _____

REASONS FOR REJECTION OR HOLDING 2-17-88 Pending subdivision plat approval and
perc hole locations DEN

BLDG. PERMIT SIGNED
AND RETURNED 5-10-89

BP 25459

84

THIS IS NOT A PERMIT

High 4

Low 2

Westcott Place

SOIL PROFILE

0-4.5 Rd-br si cl lm
 4.5-11.0 Rd-br sa si lm, fr. broken rock at 11'
 11.0 Bottom

Lot 7

Lot 6

Lot 4

0-4.5 Rd-br si cl lm
 4.5-12.0 Br sa si lm
 12.0 Bottom

Lot 5

X = 5 min
 Inlet 5.0 ft
 Bottom 8.0 ft
 180 sq ft/bedrm

INDICATE NORTH - NAME ADJOINING ROADWAY AS BASE LINE.

Hail Shop Road

DATE	TEST NO.	DEPTH	PRE-WET		TEST - 1" DROP		TIME
			START	STOP	START	STOP	
2-17-88	1	5.5 S	1:28	1:30	1:30	1:34	4
		11.0 D	Bottom (see profile)				
	2	6.5 S	1:32	1:34	1:34	1:36	2
		12.5 D	Bottom (see profile)				
	see Lot 5 3	5.5 S	1:09	1:10	1:10	1:16	4
		12.0 D	Bottom				
	see Lot 5 4	4.5 S	1:07	1:09	1/4 inch	slow	Failed
		5.0 S	1:22	1:24	1:24	1:28	4 min
		7.5 M	1:07	1:09	1:09	1:11	2 min
		12.0 D	Bottom				

REMARKS

0-5' Rd-br si cl lm 5-12 Rd-br sa si lm, fr. rock 410%

TYPE OF SOIL

All holes located as shown on plat.

TESTED BY

JB Naden

ALSO PRESENT

Rocky, Skippy

cessary. Percolation test holes shown
located as shown. The lots shown
minimum ownership width and lot areas
land State Department of Health


ion is tied into Maryland State



File System Area	Resulting min. Lot Area
1955A	3.4615 Ac.
0271A	3.0726 Ac.
2175A	3.3177 Ac.

BERT BRANSON
198/396
312/310
P-131


SHOP ROAD
(PROPOSED 60' R/W)
816.36

N 30° 53' 26" E

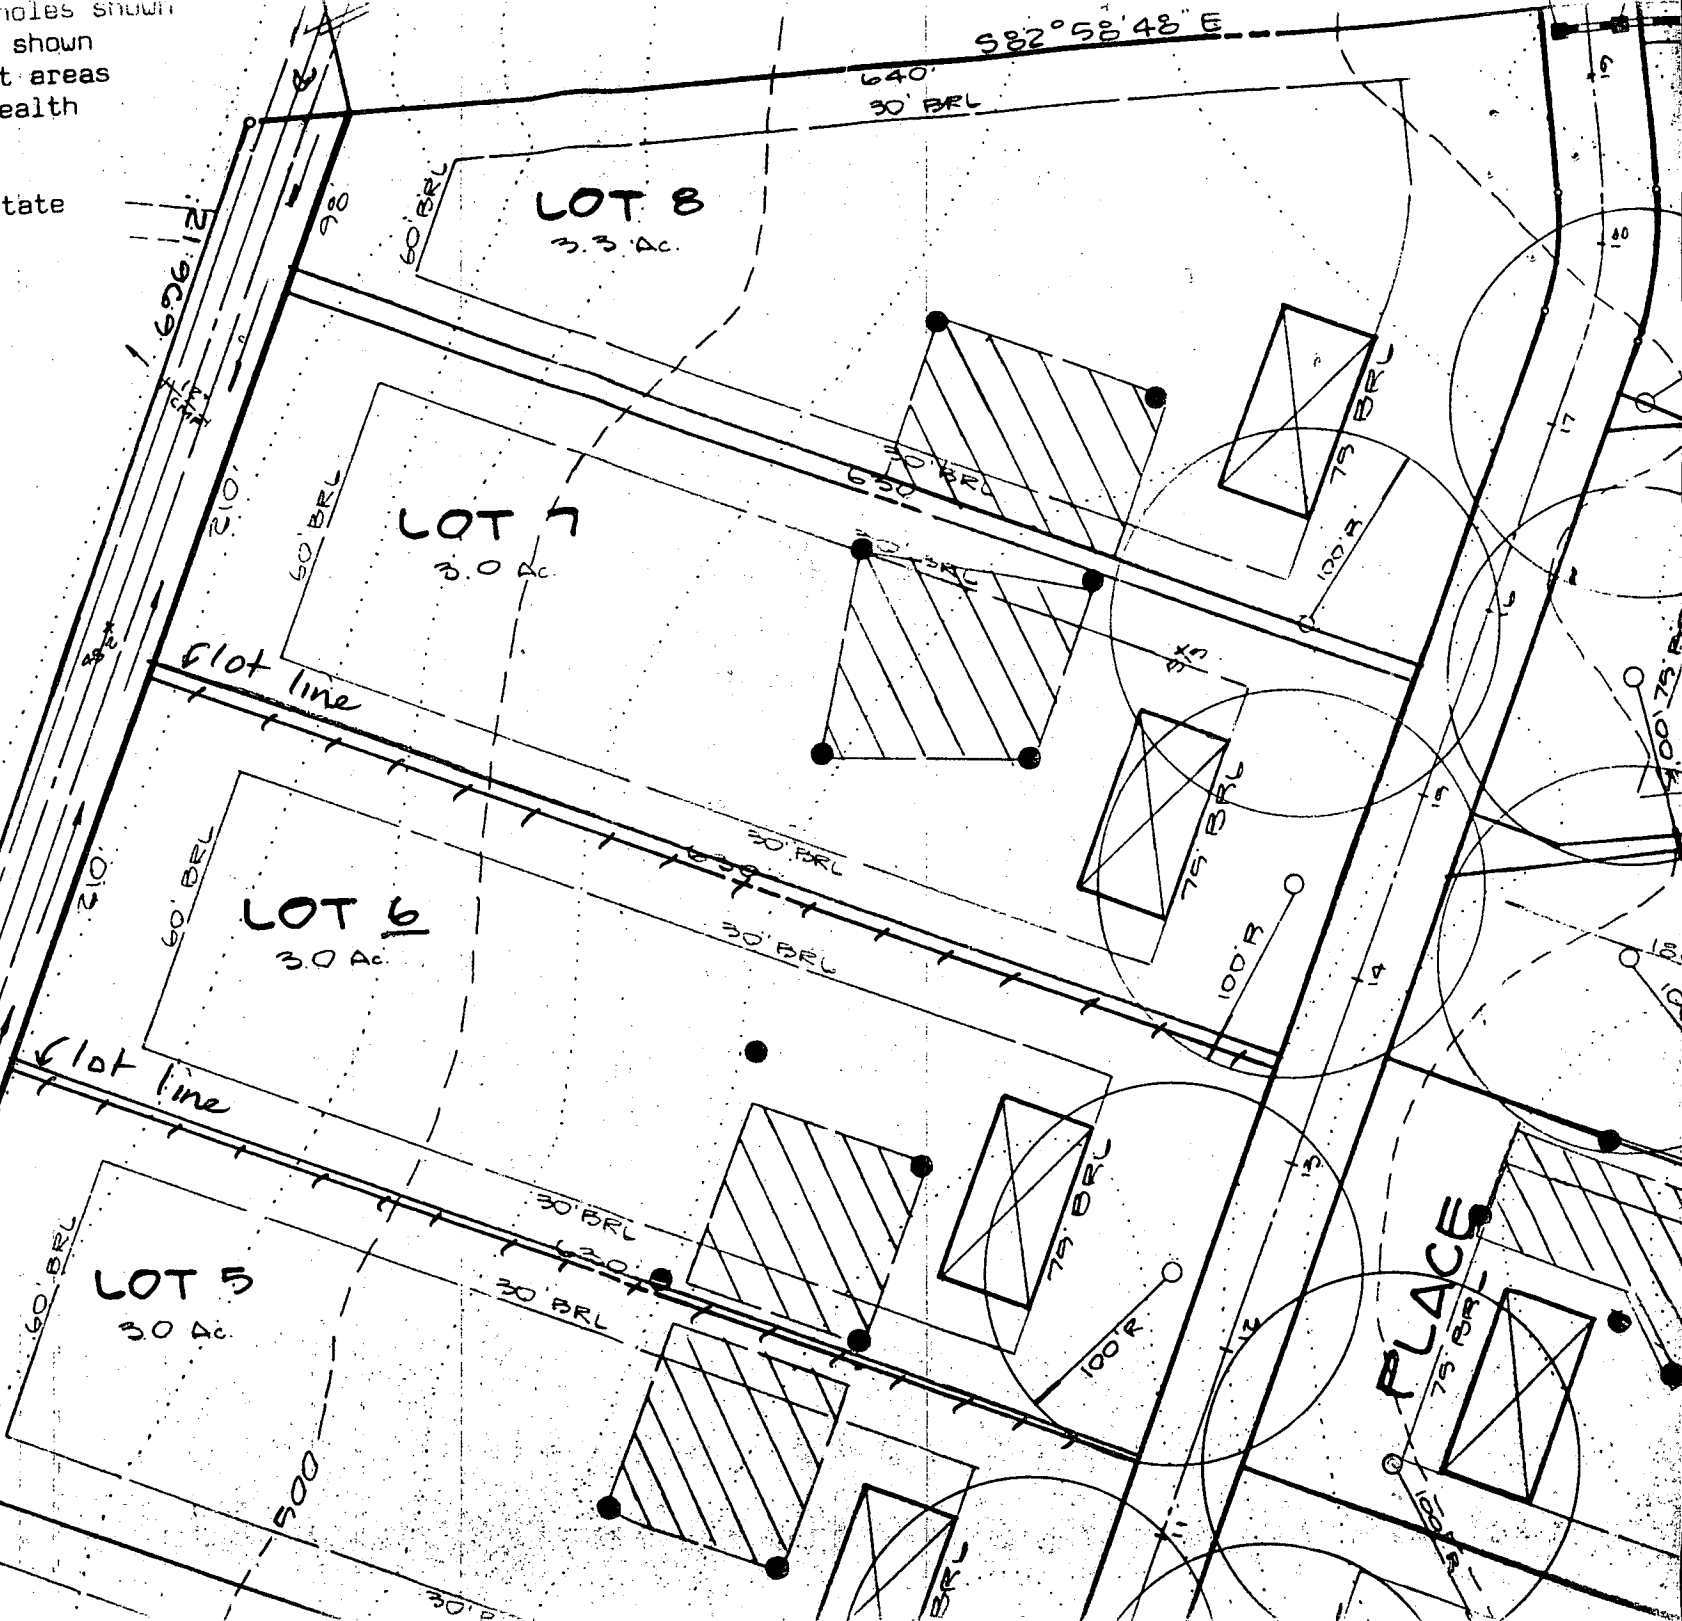


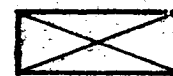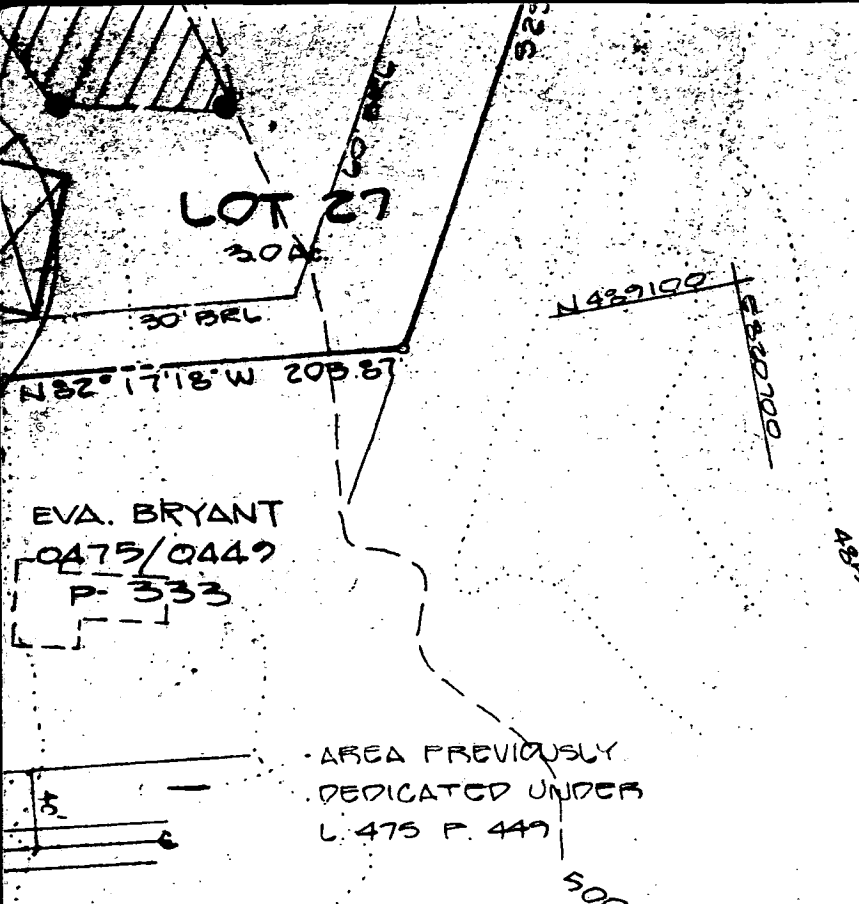

PROPOSED HOUSE

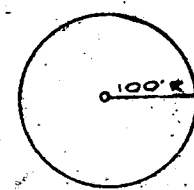

PROPOSED WELL & SETBACK

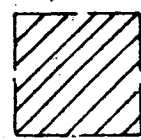

PROPOSED SEPTIC AREA 10,000 sq

EVA. BRYANT
QA75/Q449
P-333

AREA PREVIOUSLY
DEDICATED UNDER
L. 475 P. 449

PLAN

SCALE: 1" = 100'

Approved plat. Road alignment and septic areas include several changes made after final record plat was signed. Use for septic specifications.

APPROVED FOR PRIVATE WATER & SEWAGE DISPOSAL SYSTEMS - HOWARD COUNTY DEPARTMENT OF ENVIRONMENTAL HEALTH

COUNTY HEALTH OFFICER

DATE

PRELIMINARY PLAN
SECTION ONE

ASHLEIGH GREENE SUBDIVISION

5th ELECTION DISTRICT
HOWARD COUNTY, MARYLAND
TAX MAP 41 PARCEL 70 139


JENadeau 3-21-89

Ashleigh
Greene
See 1

S-88-57
P-88-54
WP-88-126

DATE
Feb, 1988
DRAWN
S.M.B.
CHECKED
MLS
SCALE
1" = 100'

1	2	
2	2	
3	3	
4	3	
5	2	
6	2	
7	2	
8	2	
9	2	
10	2	
11	2	
12	2	
13	3	
14	2	
15	4	
16	3	
17	2	
18	2	
19	2	
20	2	
21	2	
22	2	
23 (see 24)	3	
24 (see 25)	3	
25 (see 26)	4	
26 (see 27)	2	
27 (see 28)	2	

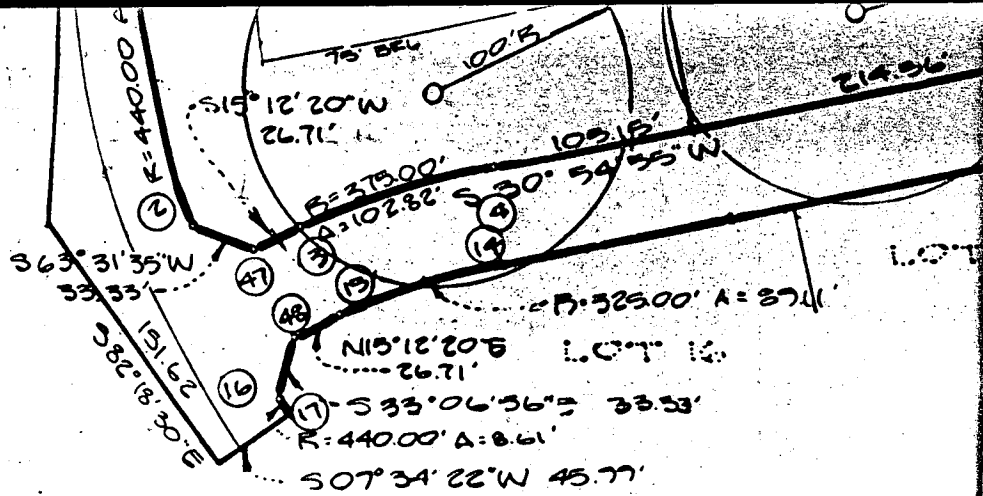

NOTE: FOR FLAG OR PIPE STEM LOTS, REFUSE CO
 SNOW REMOVAL AND ROAD MAINTENANCE TO BE
 AT THE JUNCTION OF FLAG OR PIPE STEM AND T
 R/W AND NOT ONTO THE FLAG OR PIPE STEM O

APPROVED: For private water and private
 sewerage Howard County Health Department.

Joyce M. Boyd M.D. 12-16-88
 HOWARD COUNTY HEALTH OFFICER DATE

APPROVED: Howard County Office of Planning
 and Zoning.
Joyce R. Riddle 12/28/88
 A/DIRECTOR DATE LRS

APPROVED: For storm drainage systems
 & public roads. Howard County Department of Public
 Works.

James J. Van 12/23/88
 DIRECTOR DATE

OWNERS
 AND IN CON
 ABUSH THE
 AND ASSIGN
 AND SERVICE
 (2) THE RIGH
 AND OPEN
 AND OPTION
 ROADS AND
 QUIRE DEC
 REPAIR AND
 OR OVER
 WITNESS
 MARILYN

E
 CORRECT,
 THE

RECORDED AMONG THE LAND RECORDS OF
 HOWARD COUNTY, MARYLAND ON 12-30-88
 AS PLAT NUMBER 8343

Sheet 2 of 4

SECTION 1
 LOTS 1 TRU 27

ASHLEIGH GREENE SUBDIVISION

5th ELECTION DISTRICT

HOWARD COUNTY, MARYLAND

SCALE: 1"=100' ZONE: R APRIL, 1988
 TAX MAP: 41

OWNER


WINCHESTER HOMES
 6301 IVY LANE S. 174
 GREENBELT, MD. 20770
 (301) 222-1117






DEVELOPMENT
 CONSULTANTS
 GROUP, INC.

17904 GEORGIA AVENUE
 OLNEY, MARYLAND 20832
 (301) 924-4570

F-88-248

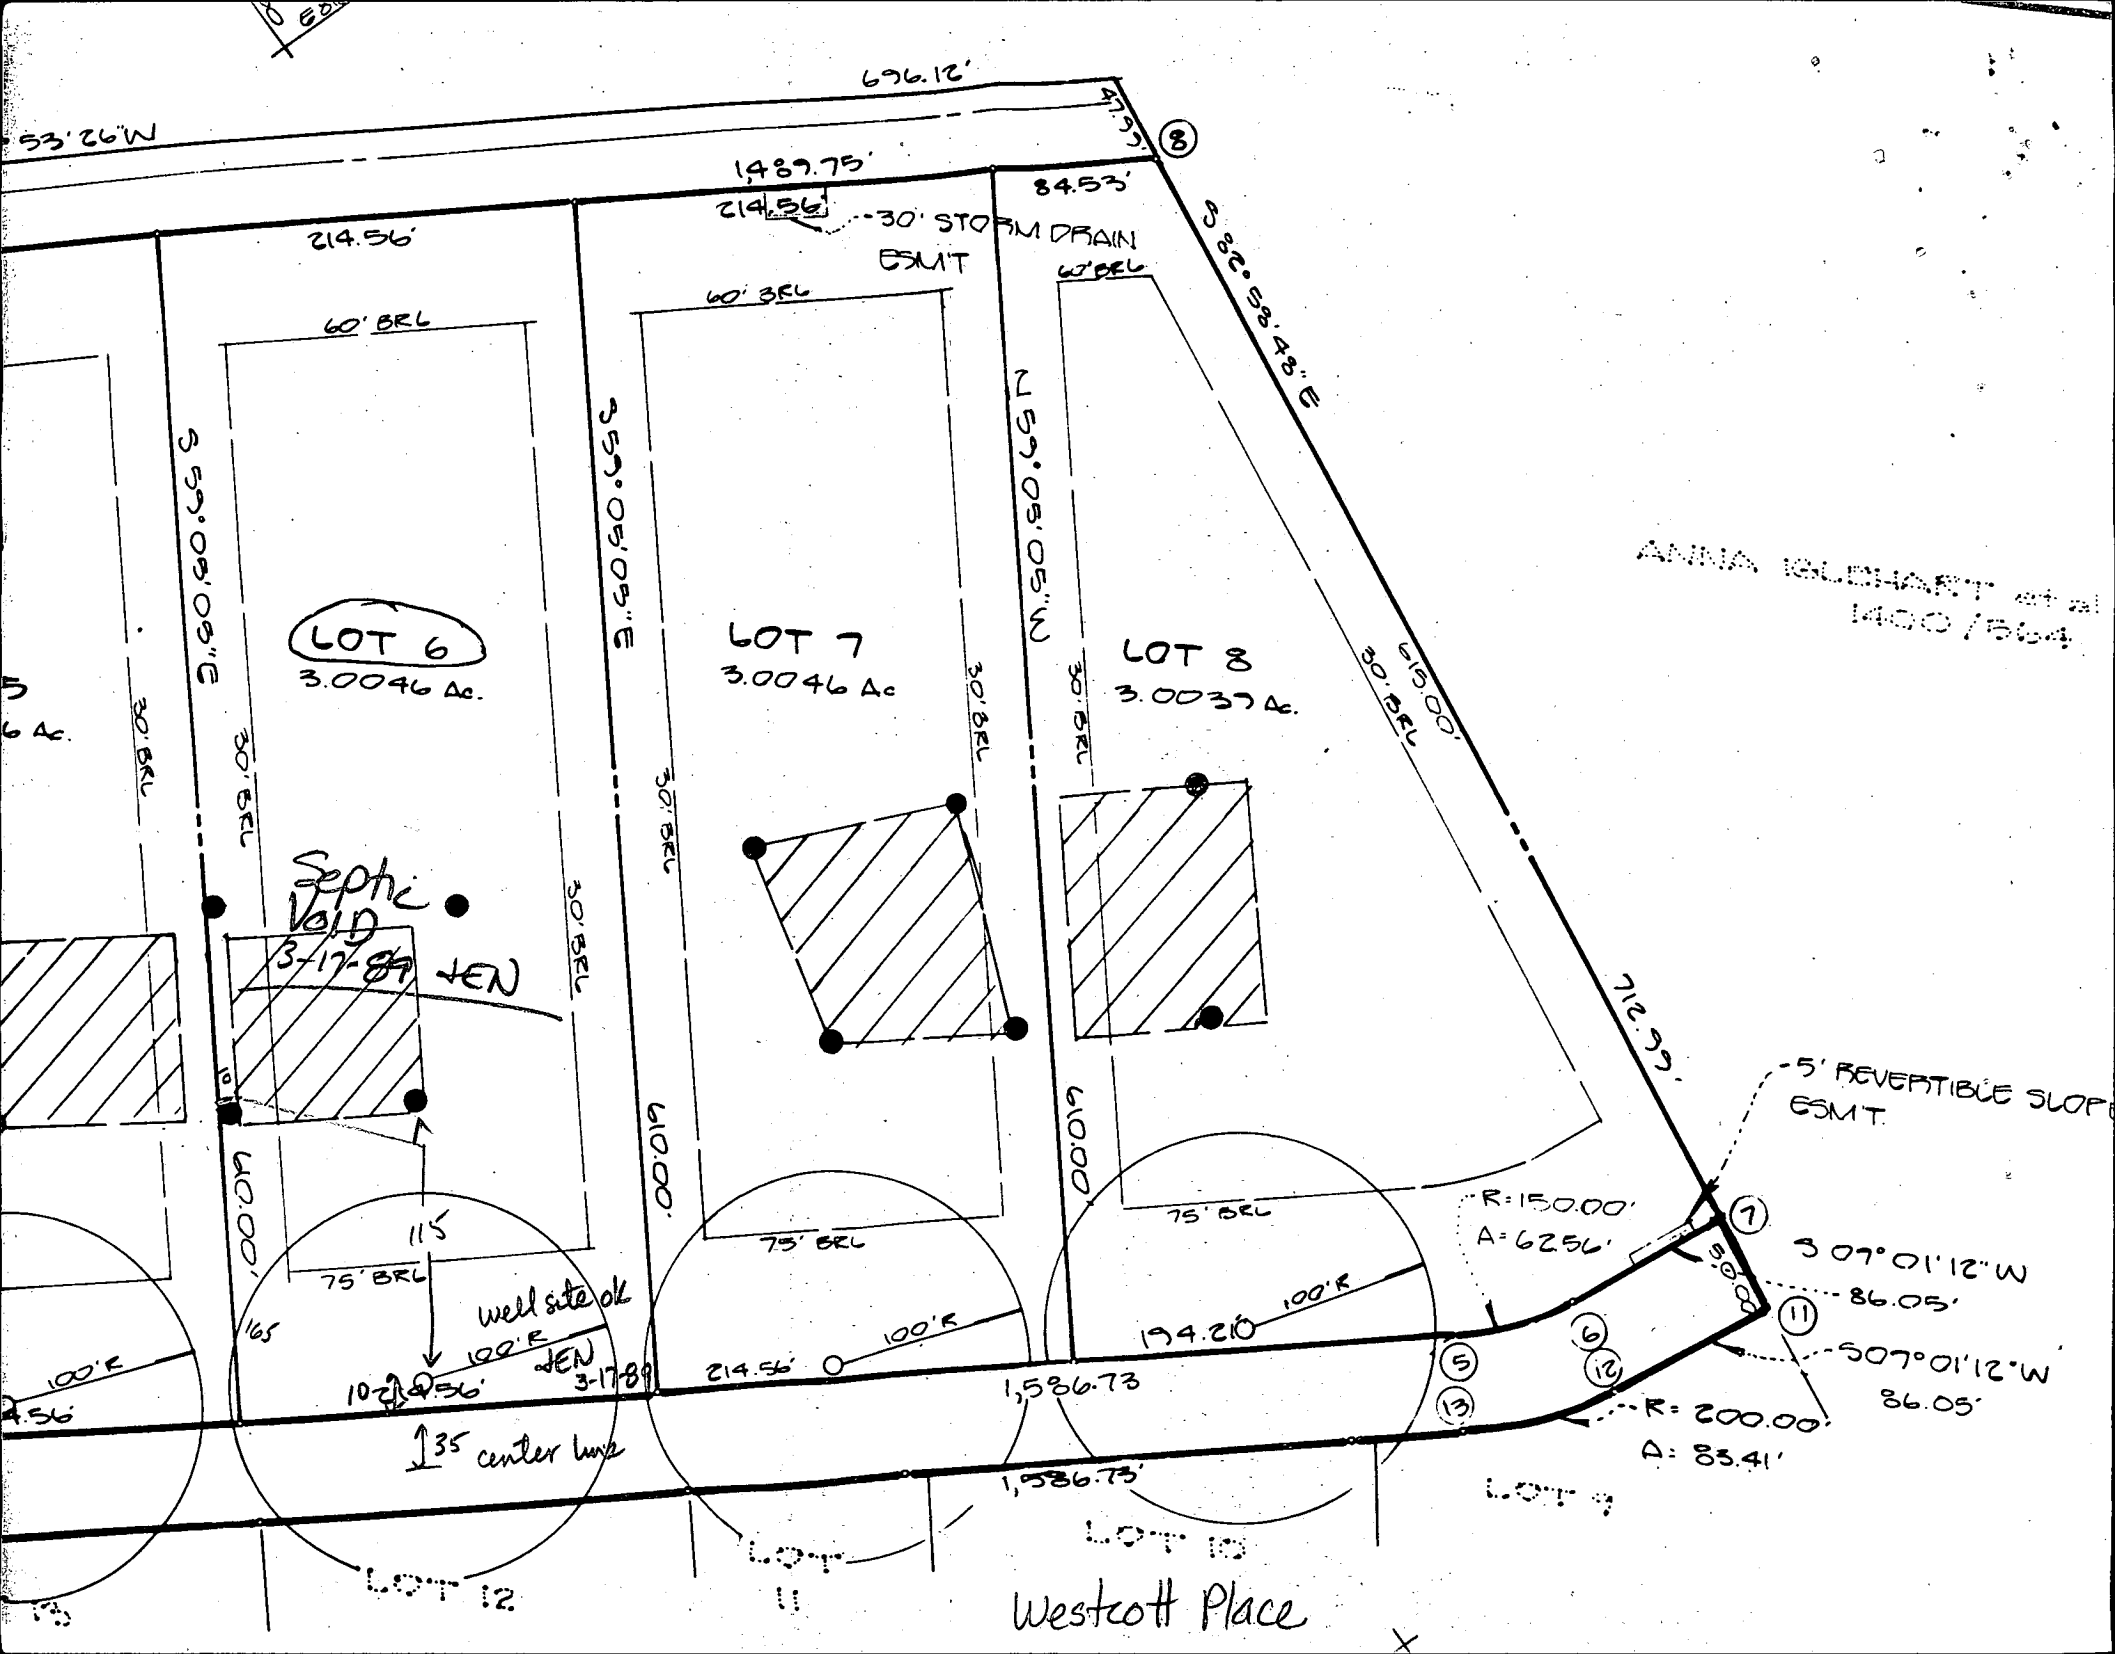

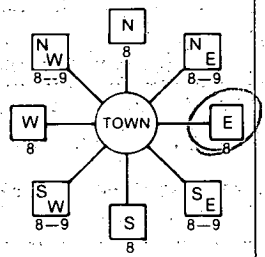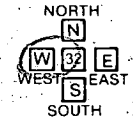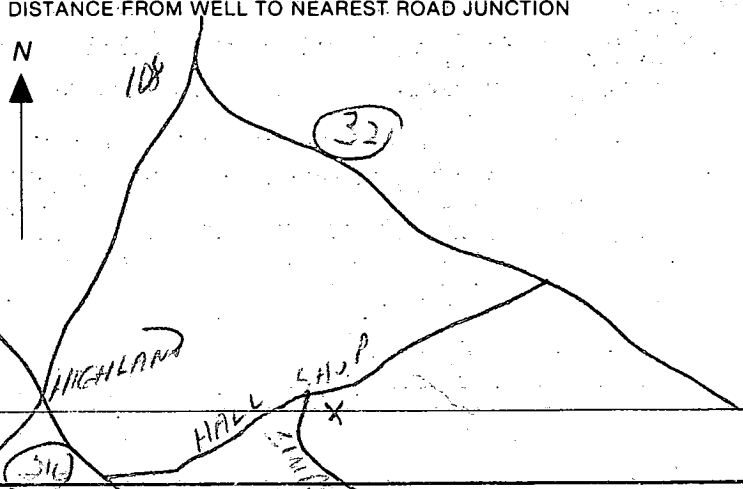B 1 2582 (THIS NUMBER IS TO BE PUNCHED IN COLS. 3-6 ON ALL CARDS)	SEQUENCE NO. (DP USE ONLY)	STATE OF MARYLAND PERMIT TO DRILL WELL please print or type	STATE PERMIT NUMBER H0-88-0161 fill in this form completely
Date Received (APA) 082588 OWNER INFORMATION WINCHESTER HOMES INC 15 Last Name Owner First Name 6301 IVV LANE 36 Street or RFD GREENBELT MD 20770 57 Town 70 State 72 Zip 76		B 3 LOCATION OF WELL R-42441 HOWARD 40.10 8 COUNTY 21 ASALEIGH GREENE 23 SUBDIVISION 42 SECTION 6 LOT 6 44 46 48 50 HIGHLAND 52 NEAREST TOWN 71 MILES FROM TOWN (enter 0 if in town) 2 M 1 73 76 77 78	
DRILLER INFORMATION George F. Easterday Driller's Name L. Franklin Easterday, Inc. 77 License No. 80 Firm Name 9265 Brown Church Rd., Mt. Airy, Md. 21771 Address George F. Easterday 8/23/88 Signature Date		B 4 DIRECTION OF WELL FROM TOWN (CIRCLE BOX)  NEAR WHAT ROAD WESCOTT PLACE 11 30 ON WHICH SIDE OF ROAD (CIRCLE APPROPRIATE BOX)  DISTANCE FROM ROAD 50 34 37 ENTER FT or MI FT 38 39	
B 2 WELL INFORMATION APPROX. PUMPING RATE (GAL. PER MIN.) 5 8 12 AVERAGE DAILY QUANTITY NEEDED (GAL. PER DAY) 500 14 20		NOT TO BE FILLED IN BY DRILLER HEALTH DEPARTMENT APPROVAL HOWARD A# 40713 COUNTY NAME COUNTY NO. STATE SIGNATURE Charles Bryan 3/6/89 DATE ISSUED CO'S SIGNATURE EXP. DATE NORTH GRID 489000 EAST GRID 0819000 50 55 57 63	
USE FOR WATER (CIRCLE APPROPRIATE BOX) ☒ HOME (SINGLE OR DOUBLE HOUSEHOLD UNIT ONLY) ☐ FARMING (LIVESTOCK WATERING & AGRICULTURAL IRRIGATION) ☐ INDUSTRIAL, COMMERCIAL, STATE AND FEDERAL GOV. OTHER (REQUIRES APPROPRIATION PERMIT) ☐ PUBLIC OR PRIVATE WATER COMPANY (REQUIRES APPROPRIATION PERMIT AND STATE HEALTH DEPARTMENT APPROVAL) ☐ TEST, OBSERVATION, MONITORING (MAY REQUIRE APPROPRIATION PERMIT)		SHOW MAJOR FEATURES OF BOX & LOCATE WELL WITH AN X SOURCES OF DRILLING WATER 1. WELL 2. 3. WRITE THE BOX NUMBER FROM THE MAP HERE  DRAW A SKETCH BELOW SHOWING LOCATION OF WELL IN RELATION TO NEARBY TOWNS AND ROADS AND GIVE DISTANCE FROM WELL TO NEAREST ROAD JUNCTION	
APPROXIMATE DEPTH OF WELL 200 FEET 24 28 APPROXIMATE DIAMETER OF WELL 6 INCH NEAREST INCH		METHOD OF DRILLING (circle one) BORED (or Augered) ☒ JETTED ☐ Jetted & DRIVEN ☐ AIR-ROTARY ☐ AIR-PERCussion ☐ ROTARY (Hydraulic Rotary) ☐ CABLE ☐ REVERSE-ROTARY ☐ DRIVE-POINT ☐ other _____	
REPLACEMENT OR DEEPENED WELLS (CIRCLE APPROPRIATE BOX) ☒ THIS WELL WILL NOT REPLACE AN EXISTING WELL ☐ THIS WELL WILL REPLACE A WELL THAT WILL BE ABANDONED AND SEALED ☐ THIS WELL WILL REPLACE A WELL THAT WILL BE USED AS A STANDBY ☐ THIS WELL WILL DEEPEN AN EXISTING WELL PERMIT NUMBER OF WELL TO BE REPLACED OR DEEPENED (IF AVAILABLE) _____		4-5-89 GROUT 7 BAGS GROUT 40' CASING COMPLETE 34' OPEN NOT OBS'D 2' CASING A.G. MR 4/5/89 000 TAG OK	
Not to be filled in by driller (OEP USE ONLY) APPROP. PERMIT NUMBER _____ GAP _____ 54 63 FORCE ☒ WRITE INITIALS IN BOX PERMIT NO. H0-88-0161 67 68 70 71 72 73 74 75 76 77 78 79 SPECIAL CONDITIONS			

C1 0679	SEQUENCE NO. (DENV USE ONLY)	STATE OF MARYLAND WELL COMPLETION REPORT FILL IN THIS FORM COMPLETELY PLEASE PRINT OR TYPE	THIS REPORT MUST BE SUBMITTED WITHIN 45 DAYS AFTER WELL IS COMPLETED.
(THIS NUMBER IS TO BE PUNCHED IN COLS. 3-6 ON ALL CARDS)		COUNTY NUMBER	8 = 40713
DATE Received	DATE WELL COMPLETED	Depth of Well	PERMIT NO.
8 13	15 20	22 26 (TO NEAREST FOOT)	FROM "PERMIT TO DRILL WELL"
	040599	400	10-08-0161

OWNER	WINCHESTER HOMES, INC.		
STREET OR RFD	last name WESCOTT PLACE	first name	TOWN HIGHLAND
SUBDIVISION	ASHLEIGH GREENE SECTION -1	LOT	6

WELL LOG Not required for driven wells		
STATE THE KIND OF FORMATIONS PENETRATED, THEIR COLOR, DEPTH, THICKNESS AND IF WATER BEARING		
DESCRIPTION (Use additional sheets if needed)	FEET FROM TO	Check if water bearing
Topsoil	0 3	
Dark shale	3 7	
Soft brown mica	7 36	
Grey mica	36 62	
Brown mica	62 64	
Grey mica	64 100	
Brown mica	100 107	
Grey mica	107 400	

GROUTING RECORD	
WELL HAS BEEN GROUTED (Circle Appropriate Box)	
TYPE OF GROUTING MATERIAL	
CEMENT CM	BENTONITE CLAY BC
NO. OF BAGS 7	NO. OF POUNDS 100
GALLONS OF WATER 25	
DEPTH OF GROUT SEAL (to nearest foot)	
from 48 TOP 52 ft. to 54 BOTTOM 58 ft.	
(enter 0 if from surface)	
CASING RECORD	
casing types insert appropriate code below	ST CO STEEL CONCRETE PL OT PLASTIC OTHER
MAIN Casing Nominal diameter Total depth Casing top (main) casing of main casing TYPE (nearest inch) (nearest foot)	
ST	1 40
60 61	63 64 66 70

C3	PUMPING TEST	
	HOURS PUMPED (nearest hour) 3	
	PUMPING RATE (gal. per min. to nearest gal.) 4	
	METHOD USED TO MEASURE PUMPING RATE Bucket	
	WATER LEVEL (distance from land surface)	
	BEFORE PUMPING 17 20	
	WHEN PUMPING 22 25	
	TYPE OF PUMP USED (for test)	
A air	P piston	T turbine
C centrifugal	R rotary	O other (describe below)
J jet	S submersible	

OTHER CASING (if used)	
diameter inch	depth (feet) from to

SCREEN RECORD	
screen type or open hole insert appropriate code below	ST BR HO STEEL BRASS OPEN HOLE PL OT PLASTIC OTHER

C2	DEPTH (nearest ft.)
1 2	8 9 11 15 17 21
1 2	38 400
1 2	23 24 26 30 32 36
1 2	38 39 41 45 47 51
SLOT SIZE 1 2 3	
DIAMETER OF SCREEN 56 60 (NEAREST INCH)	

PUMP INSTALLED	
DRILLER WILL INSTALL PUMP YES NO	
IF DRILLER INSTALLS PUMP, THIS SECTION MUST BE COMPLETED FOR ALL WELLS EXCEPT HOME USE	
TYPE OF PUMP INSTALLED PLACE (A,C,J,P,R,S,T,O) IN BOX-SEE ABOVE:	
CAPACITY: GALLONS PER MINUTE (to nearest gallon) 31 35	
PUMP HORSE POWER 37 41	
PUMP COLUMN LENGTH (nearest ft.) 43 47	
CASING HEIGHT (circle appropriate box and enter casing height)	
4 above	LAND SURFACE
2 below	(nearest foot) 20 51

CIRCLE APPROPRIATE LETTER	
A	A WELL WAS ABANDONED AND SEALED WHEN THIS WELL WAS COMPLETED
E	ELECTRIC LOG OBTAINED
P	TEST WELL CONVERTED TO PRODUCTION WELL

I HEREBY CERTIFY THAT THIS WELL HAS BEEN CONSTRUCTED IN ACCORDANCE WITH COMAR 10.17.13 "WELL CONSTRUCTION" AND IN CONFORMANCE WITH ALL CONDITIONS STATED IN THE ABOVE CAPTIONED PERMIT, AND THAT THE INFORMATION PRESENTED HEREIN IS ACCURATE AND COMPLETE TO THE BEST OF MY KNOWLEDGE.	
---	--

DRILLERS IDENT. NO. 440
DRILLERS SIGNATURE
(MUST MATCH SIGNATURE ON APPLICATION)
SITE SUPERVISOR (sign of driller or journeyman responsible for sitework if different from permittee)


GRAVEL PACK	
IF WELL DRILLED WAS FLOWING WELL INSERT F IN BOX 68	
OEP USE ONLY (NOT TO BE FILLED IN BY DRILLER)	
T	(E.R.O.S.)
70	72
TELESCOPE CASING	LOG INDICATOR
OTHER DATA	

LOCATION OF WELL ON LOT	
SHOW PERMANENT STRUCTURE SUCH AS BUILDING, SEPTIC TANKS, AND/OR LANDMARKS AND INDICATE NOT LESS THAN TWO DISTANCES (MEASUREMENTS TO WELL)	
70 32	
26	


COUNTY

BASEMENT DOES NOT
SEWER BY GRAVITY

BASEMENT DOES NOT
SEWER BY GRAVITY

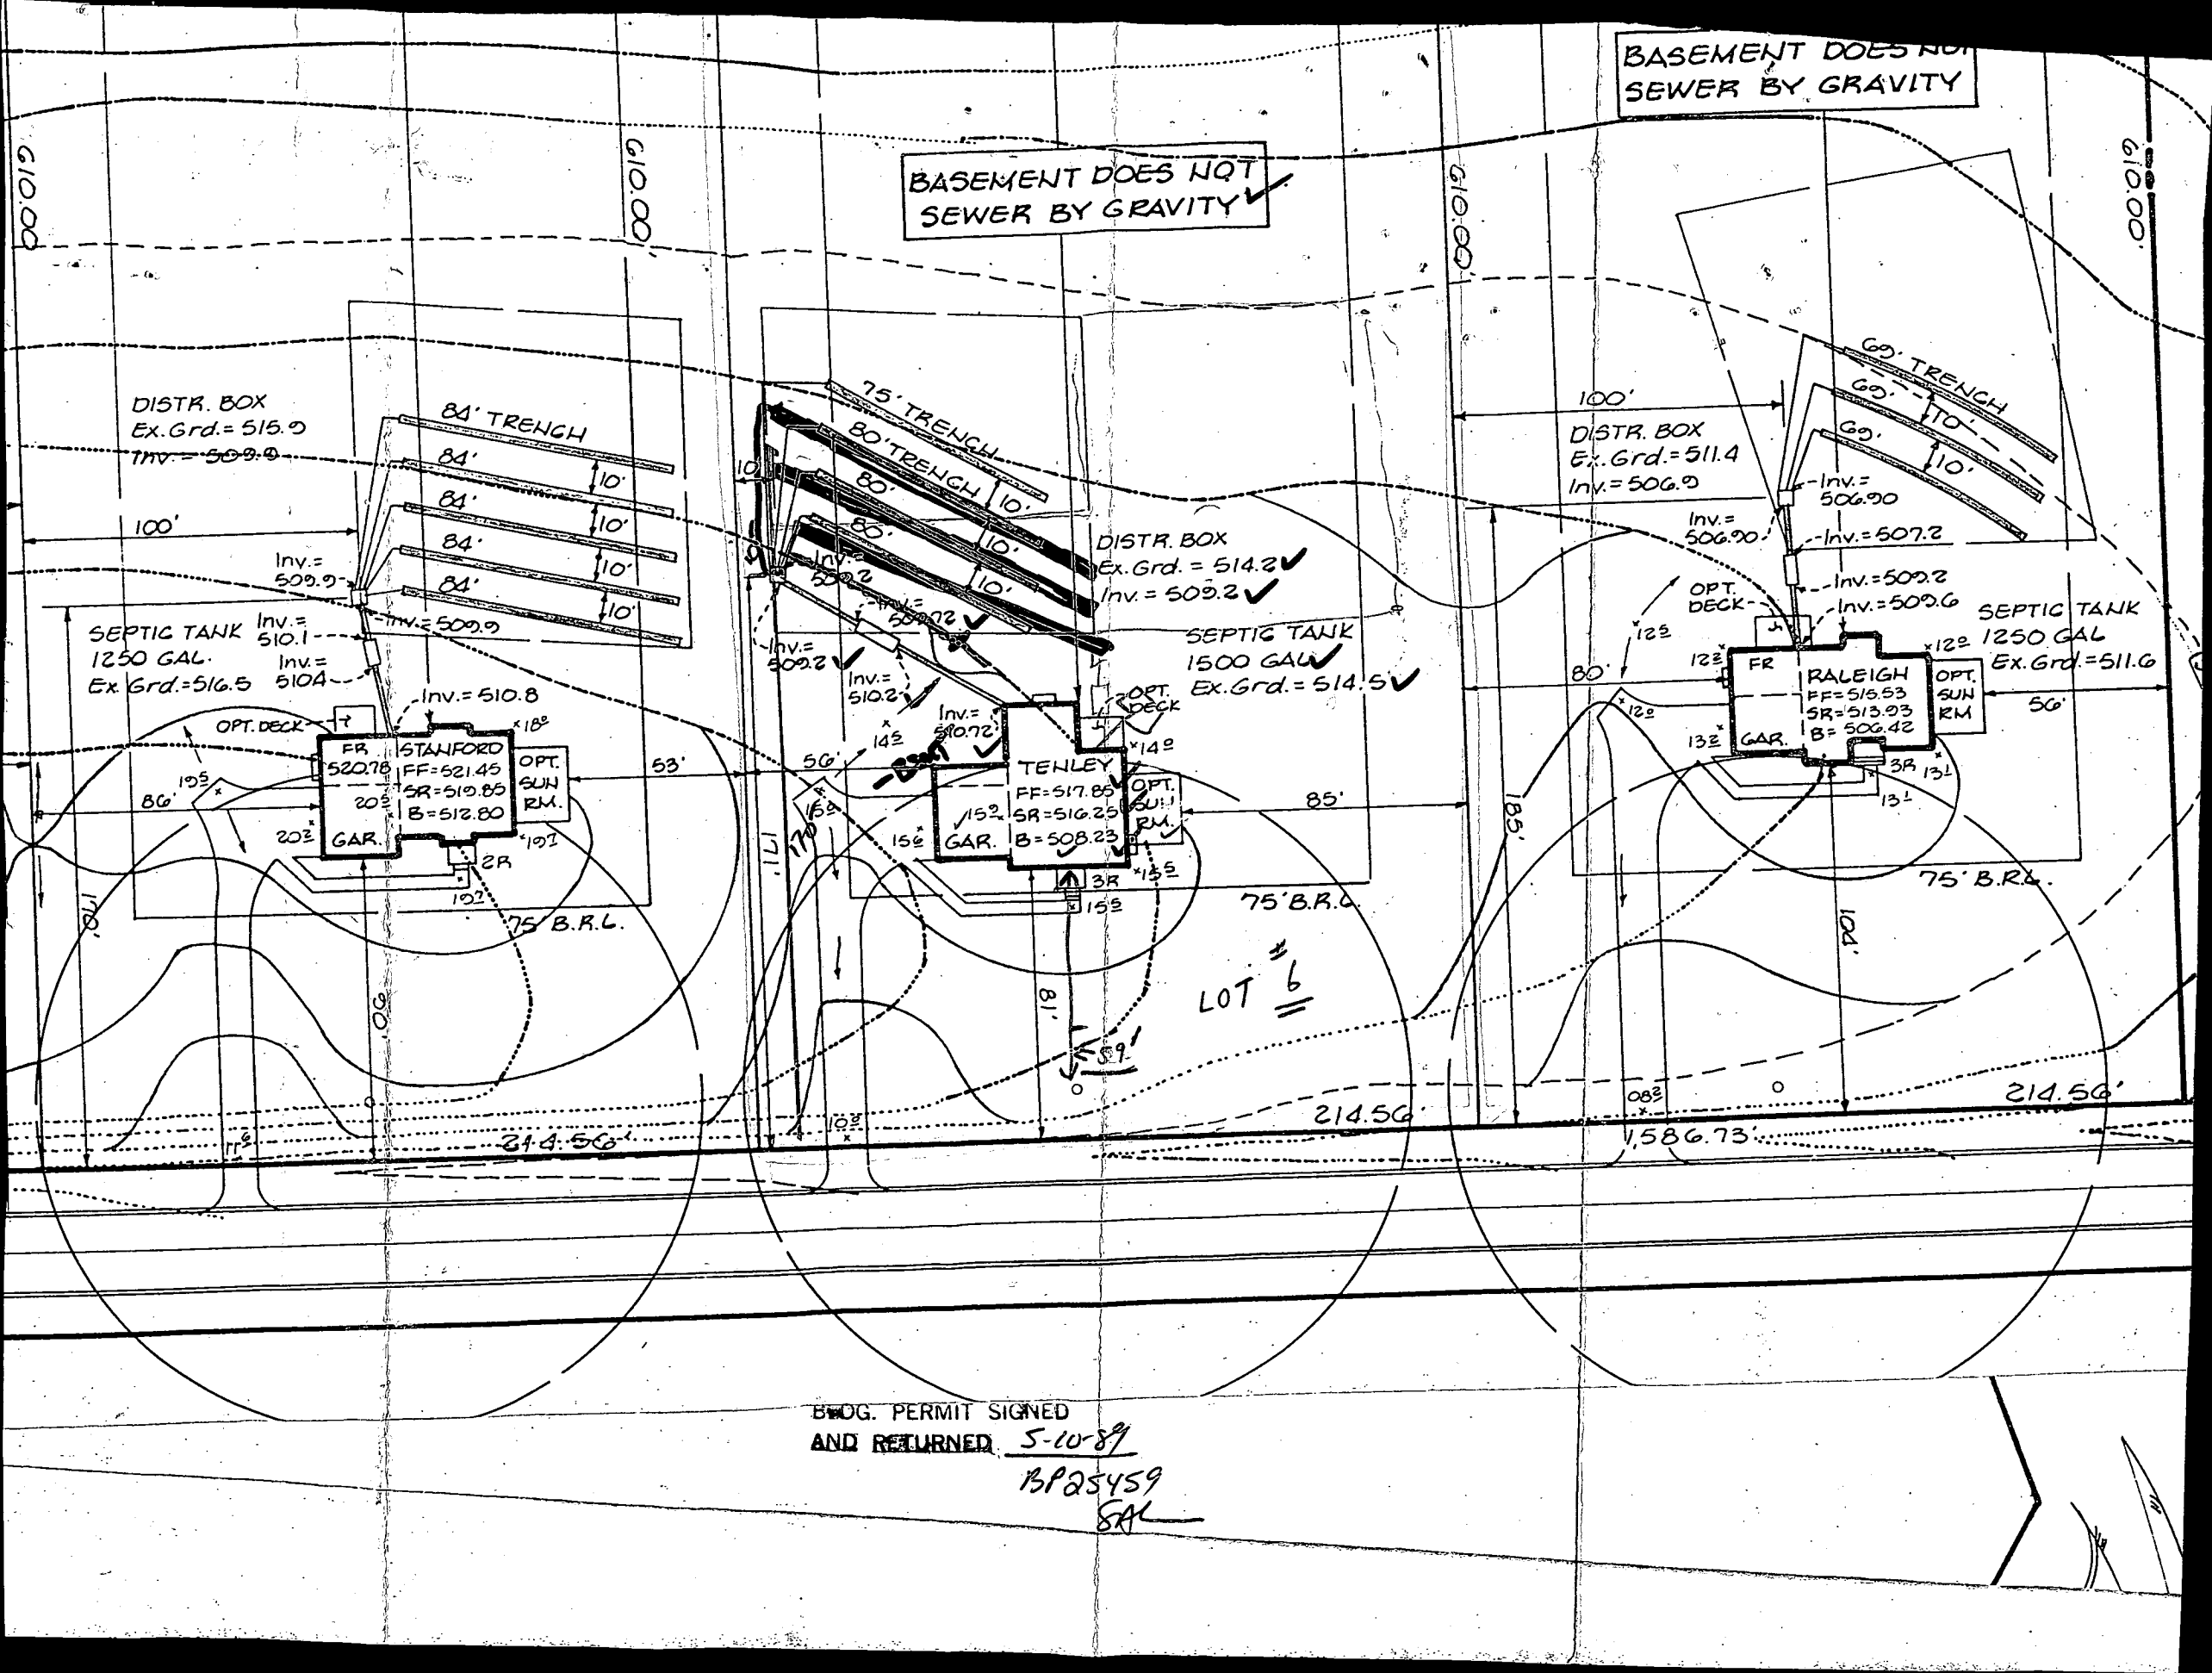

BWDG. PERMIT SIGNED
AND RETURNED 5-10-89
BP25459
GAL

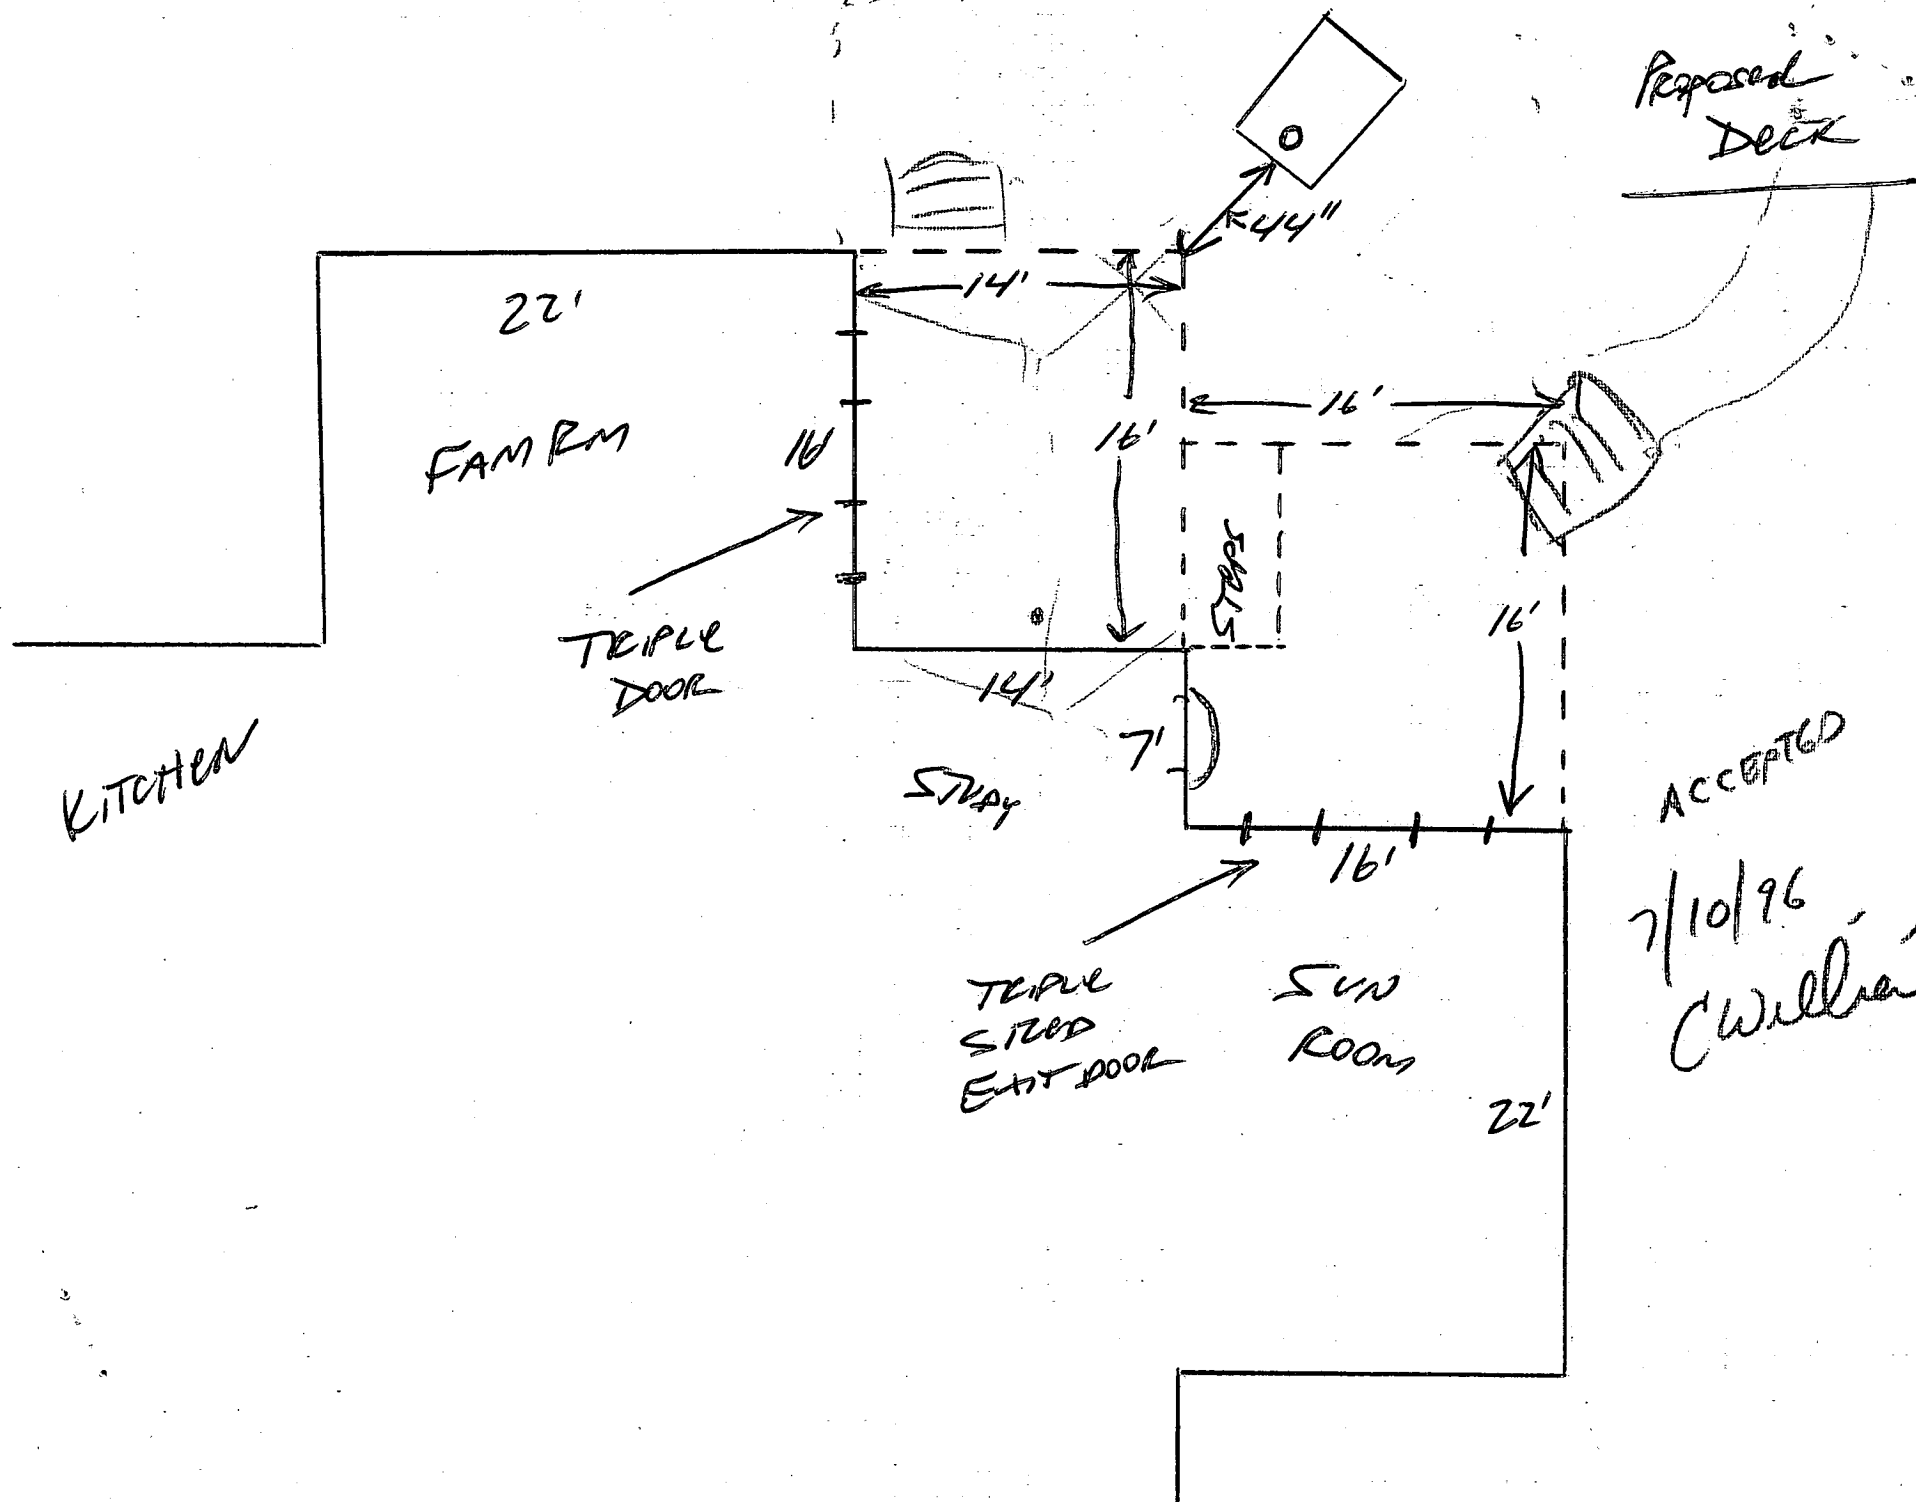

ACCEPTED
7/10/96
C. Williams