

# PERMIT

## SEWAGE DISPOSAL SYSTEM

### DEPARTMENT OF HEALTH AND MENTAL HYGIENE

05-40934

#### HOWARD COUNTY HEALTH DEPARTMENT

BUREAU OF ENVIRONMENTAL HEALTH

461-9933

INDEXED

P 46588

A 40717

DISTRICT 5th

DATE 11/9/90

DATE SYSTEM APPROVED 11/15/90

INSPECTOR M. Ripkin

Fogle's Septic Clean

IS PERMITTED TO INSTALL ☒ ALTER ☐

ADDRESS 6430 Woodbine Road, Woodbine, Maryland 21797 PHONE 795-5670

SUBDIVISION Ashleigh Greene LOT 10 ROAD 6965 Westcott Place

PROPERTY OWNER Winchester Homes

Bernard Rafferty

ADDRESS

SEPTIC TANK CAPACITY 1250 GALLONS

NUMBER OF BEDROOMS 4

210 SQUARE FEET PER BEDROOM

**BUILDING PERMIT SIGNED**

**AND RETURNED 5-13-02**

BDO B5900-IG POOL

LINEAR FEET OF TRENCH REQUIRED 210 280

TRENCHES - 210 sq. ft. per bedroom. Trench to be 3.0 feet wide. Inlet 3.0 feet below original grade. Bottom maximum depth 5.0 feet below original grade. Effective area begins at 3.0 feet below original grade. 2.0 feet of stone below distribution pipe.

LOCATION - Place the distribution box 140 feet off the front lot line and 55 feet off the left lot line as seen when facing the lot from Westcott Place. Run trenches on contour toward the right lot line. Maintain a minimum of 100 feet from all wells.

NOTE - No trench to exceed 100 feet in length. Provide 6" - 8" diameter cleanout and cap to grade or above on septic tank.

280' linear ft.

PLANS APPROVED BY Ms. Jane E. Nadeau cm DATE 05/23/89

COVER NO WORK UNTIL INSPECTED AND APPROVED

NEITHER THE HOWARD COUNTY COUNCIL NOR THE HEALTH DEPARTMENT IS RESPONSIBLE FOR THE SUCCESSFUL OPERATION OF ANY SYSTEM

NOTE: CLEANOUT REQUIRED EVERY 70 FEET OF SEWER LINE AND/OR AT 90° SWEEPS IN LINES FROM HOUSE TO DRAIN FIELDS, 90° ELBOWS NOT ACCEPTABLE.

NOTE: ALL PARTS OF SEPTIC SYSTEMS (I.E. TANK, DISTRIBUTION BOX TRENCHES) TO BE 100 FEET FROM WELL (UNLESS OTHERWISE SPECIFICALLY AUTHORIZED)

NOTE: IF DEEP TRENCH(ES) ARE USED CALL FOR INSPECTION BEFORE AND AFTER PLACING GRAVEL IN TRENCH(ES)

NOTE: NO DRY WELL SHALL EXCEED 15 FOOT IN DIAMETER NO ABSORPTION TRENCH TO EXCEED 100 FEET IN LENGTH

NOTE: ALL PIPE FROM HOUSE TO SEPTIC TANK MUST BE CAST IRON OR SCHEDULE 35/40 PVC OR ABS

PERMIT VOID AFTER TWO YEARS

NOTE: INSTALL STAND PIPE ON SEPTIC TANK AND DRY WELL STAND PIPES MUST BE 6 INCHES IN DIAMETER CAST IRON, CONCRETE OR TERRA COTTA OR PVA OR ABS ACCEPTED. IF TOP OF SEPTIC TANK IS DEEPER THAN 3 FEET. MANHOLE TO GRADE REQUIRED.

NOTE: DISTRIBUTION BOXES MUST HAVE BAFFLES

**\*INSTALLER IS RESPONSIBLE FOR OBTAINING FINAL APPROVAL ON THIS PERMIT**

**OLD PERMIT SIGNED**


**AND RETURNED**

8-14-98

Serial # B1113572

1-Story Addition

A 40717

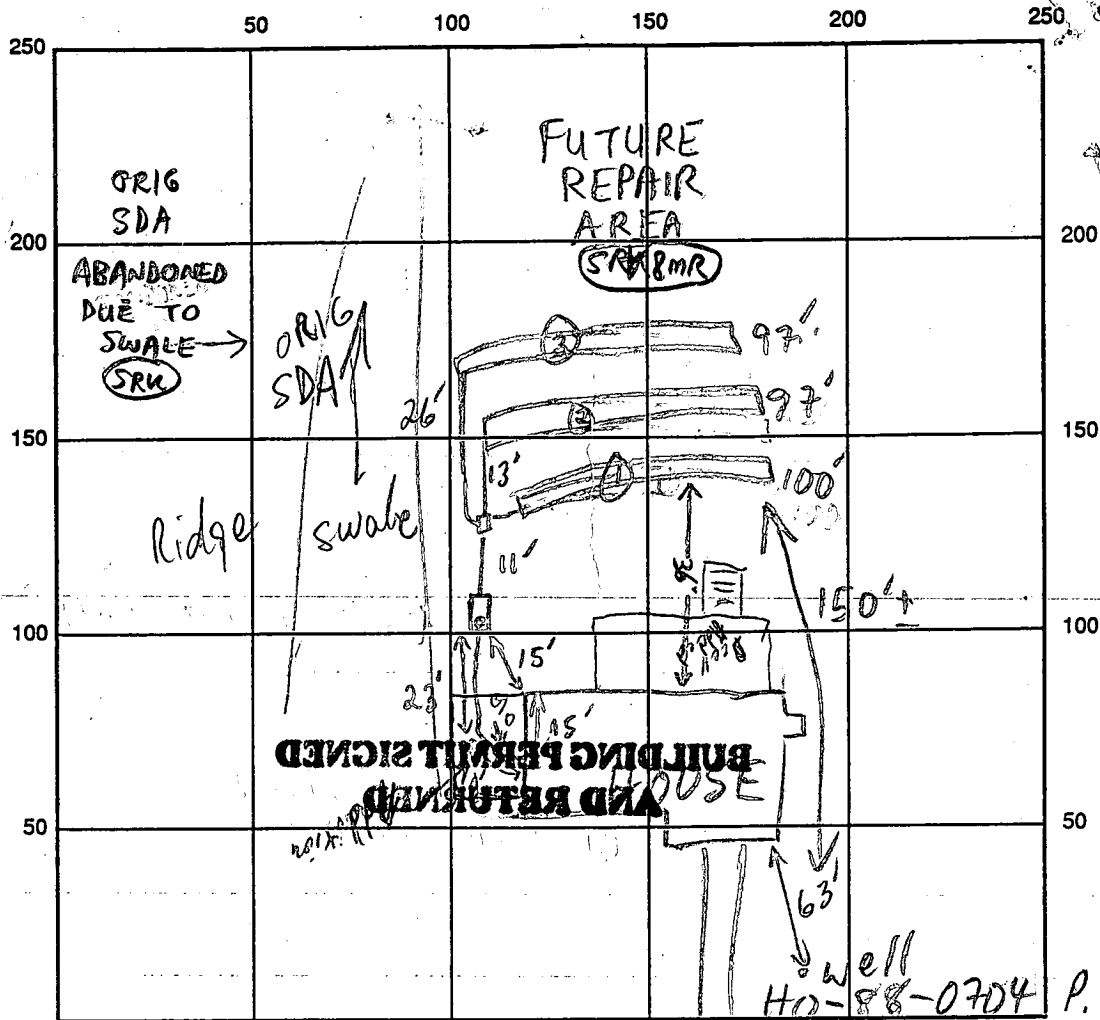

WESTCOTT PLACE

SEPTIC TANK LEVEL 1250 GAL - OK

CLEANOUTS OK

P.A. OK  
@ 3-4' B.G.  
MR 4/14/90

DISTRIBUTION BOX LEVEL OK - BAFFLE IN

DRAIN FIELD/TITLE DEPTH 5 FT.

TRENCH WIDTH 3 FT.

INLET DEPTH 1 1/2 2 3 FT.

EFFECTIVE GRAVEL DEPTH 1 1/2 2 3 FT.

TOTAL LENGTH 0 100 2 97 3 97 FT.

NUMBER OF TRENCHES 3

ONE SIDEWALL/BOTTOM AREA 0 300 2 291 3 291 SQ. FT.

DRYWALL INSIDE DIAMETER      FT.

EFFECTIVE DEPTH BELOW INLET      FT.

ABSORBENT AREA 882 SQ. FT.

REMARKS: 11/14/90 SPECS INCORRECT: 280' LINEAR TRENCH REQ'D;  
TRENCHES SUPPOSED BE RUN TO LEFT BUT CONTOURS SEEM TO  
BE SHIFTED ABOUT 50'±, AND TRENCHES WOULD GO THRU SWALE;  
DIRECTION OF TRENCHES TO RUN TO RIGHT SIDE OF LOT. MR  
11/15/90 OK TO COVER ALL: ~1.5-3' FILL OVER SDA MR  
NEW

DATE SYSTEM APPROVED 11/15/90

INSPECTOR M. Rifkin

# APPLICATION

PERCOLATION TESTING

A 40717

P \_\_\_\_\_

HOWARD COUNTY HEALTH DEPARTMENT  
BUREAU OF ENVIRONMENTAL HEALTH  
P.O. BOX 476 ELLICOTT CITY, MARYLAND 21043  
TELEPHONE: 461-9933

DISTRICT 5th

DATE 12/1/87

TO: THE COUNTY HEALTH OFFICER  
ELLICOTT CITY, MARYLAND

I, HEREBY, APPLY FOR THE NECESSARY TEST IN ORDER TO CONSTRUCT (OR RECONSTRUCT) A SEWAGE DISPOSAL SYSTEM.

PROPERTY OWNER Winchester Homes, Inc. Real Estate Development Group

ADDRESS 6301 Ivy Lane Greenbelt, MD 20770 PHONE 474-4411  
301-220-1117

PROSPECTIVE BUYER N/A

ADDRESS N/A PHONE \_\_\_\_\_

PROPERTY LOCATION:

SUBDIVISION Ashleigh Greene Section I LOT NO. 10

ROAD AND DESCRIPTION (6965 Westcott Place)  
Intersection Hall Shop Road & Simpson Road

TAX MAP 41 PARCEL # 139

SIZE OF LOT 3.0 AC

BLDG. PERMIT SIGNED

AND RETURNED 9/18/89

Serial # 28118

TYPE BLDG Single Family

(SINGLE FAMILY DWELLING OR COMMERCIAL)

THE SYSTEM INSTALLED UNDER THIS APPLICATION IS ACCEPTABLE ONLY UNTIL PUBLIC FACILITIES BECOME AVAILABLE. I FULLY UNDERSTAND THE FEE CONNECTED WITH THE FILING OF THIS PERC TEST APPLICATION IS NON-REFUNDABLE UNDER ANY CIRCUMSTANCES. I ALSO AGREE TO COMPLY WITH ALL M.O.S.H.A. REQUIREMENTS IN TESTING THIS LOT.

Burley G. Chandler  
(SIGNATURE OF APPLICANT)

APPROVED BY \_\_\_\_\_ FOR \_\_\_\_\_ DATE \_\_\_\_\_

REJECTED BY \_\_\_\_\_ FOR \_\_\_\_\_ DATE \_\_\_\_\_

HOLD PENDING FURTHER TESTS \_\_\_\_\_ DATE \_\_\_\_\_

REASONS FOR REJECTION OR HOLDING 2-18-88 Pending perc hole locations and

subdivision plat approval, keep septic field as high as  
possible (75'w x 135'l) JEN. SHALLOW SYSTEM ONLY

HD-216

## THIS IS NOT A PERMIT

High 5

Low 2

## SOIL PROFILE

①  
0-4.0 Br sil  
lm  
4.0-11.0 Br mica  
sa sil, some  
saprolite  
< 40%,  
decomposed  
rock frag  
< 20%  
11.0 Bottom


⑤

0-4.0 Br sil  
lm  
4.0-11.5 Br mica  
sa sil, < 40%  
saprolite  
11.5 Bottom

④

0-3.5 Br sil  
3.5-11.0 Br sa  
sil, < 30%  
mica  
11.0 Bottom

Lot 9

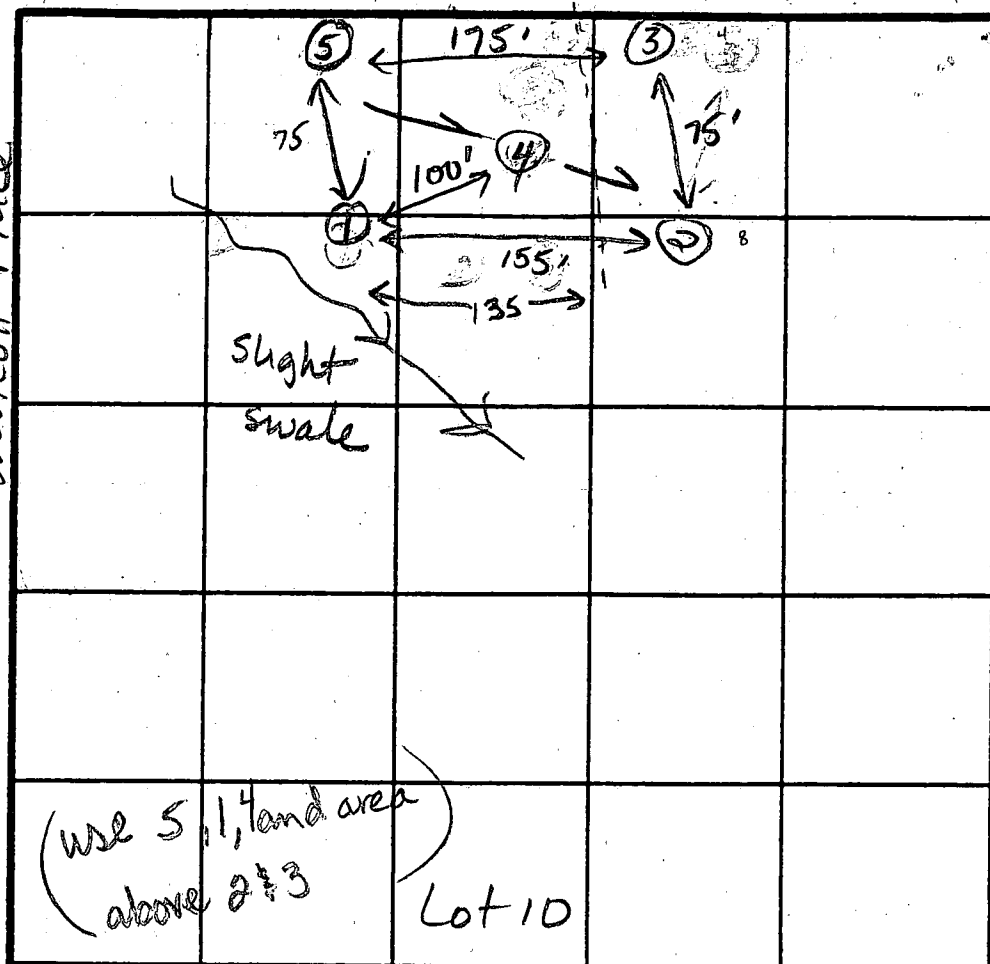

INDICATE NORTH - NAME ADJOINING ROADWAY AS BASE LINE.

Lot 11

DATE	TEST NO.	DEPTH	PRE-WET		TEST - 1" DROP		TIME
			START	STOP	START	STOP	
2-18-88	✓ 5	3.0 S	12:51	12:56	12:56	12:59	3
		6.0 M	12:51	12:55	12:55	1:01	6
		11.5 D	Bottom (see profile)				
	✓ 1	3.0 S	12:51	1:09	1:09	1:19	10
		11.0 D	Bottom (see profile)				
	✓ 4	11.0 V	(see profile)				ok
	3	4.0 S	1:08	1:12	1:12	1:23	11
		12.5 D	Bottom (see profile)				No
	2	3.0 S	1:09	1:13	1:13	1:17	4
✓		11.0 D	Bottom (see profile)				No

②

0-3.0 Br sil  
lm  
3-8.0 Br sa sil  
lm, < 5%  
saprolite  
8-11.0 Tan-white  
sa sil, 50%  
saprolite  
11.0 Bottom

③

0-2.0 Br sil  
lm  
2-4.0 Tan-white  
cl silt  
4-12.5 Br sa  
sil, < 30%  
saprolite

12.5 Bottom

X = 10 min

Inlet = 3.0

Bottom = 5.0

170 gft/bm

SHALLOW

REMARKS

All holes move from plat location. Keep area high 135' x 75'.

TYPE OF SOIL

0-4' Br sil lm, 4-12 Br sa sil, &lt; 40% saprolite (some tan sa sil w/ 50% saprolite)

TESTED BY

JE. Nadeau

ALSO PRESENT

Porky, Skippy

# APPLICATION

PERCOLATION TESTING

A 40717

P \_\_\_\_\_

HOWARD COUNTY HEALTH DEPARTMENT  
BUREAU OF ENVIRONMENTAL HEALTH  
P.O. BOX 476 ELLICOTT CITY, MARYLAND 21043  
TELEPHONE: 461-9933

DISTRICT 5th

DATE 12/1/87

TO: THE COUNTY HEALTH OFFICER  
ELLICOTT CITY, MARYLAND

I, HEREBY, APPLY FOR THE NECESSARY TEST IN ORDER TO CONSTRUCT (OR RECONSTRUCT) A SEWAGE DISPOSAL SYSTEM.

PROPERTY OWNER Winchester Homes, Inc. Real Estate Development Group

ADDRESS 6301 Ivy Lane Greenbelt, MD 20770 PHONE 301-220-1117

PROSPECTIVE BUYER N/A

ADDRESS N/A PHONE \_\_\_\_\_

PROPERTY LOCATION:

SUBDIVISION Ashleigh Greene Section I LOT NO. 10

ROAD AND DESCRIPTION Intersection Hall Shop Road & Simpson Road

TAX MAP 41 PARCEL # 139

SIZE OF LOT 3.0 AC TYPE BLDG Single Family  
(SINGLE FAMILY DWELLING OR COMMERCIAL)

THE SYSTEM INSTALLED UNDER THIS APPLICATION IS ACCEPTABLE ONLY UNTIL PUBLIC FACILITIES BECOME AVAILABLE. I FULLY UNDERSTAND THE FEE CONNECTED WITH THE FILING OF THIS PERC TEST APPLICATION IS NON-REFUNDABLE UNDER ANY CIRCUMSTANCES. I ALSO AGREE TO COMPLY WITH ALL M.O.S.H.A. REQUIREMENTS IN TESTING THIS LOT.

Bruce G. Stauder  
(SIGNATURE OF APPLICANT)

APPROVED BY \_\_\_\_\_ FOR \_\_\_\_\_ DATE \_\_\_\_\_

REJECTED BY \_\_\_\_\_ FOR \_\_\_\_\_ DATE \_\_\_\_\_


HOLD PENDING FURTHER TESTS \_\_\_\_\_ DATE \_\_\_\_\_

REASONS FOR REJECTION OR HOLDING \_\_\_\_\_

HD-216

## THIS IS NOT A PERMIT

1.5-3' ①  
 SOIL PROFILE  
 org clay  
 loam  
 10% frags  
 2-2 1/2' brn  
 Sandy  
 silt loam  
 hi mica  
 20%  
 decomposed  
 rx frags  
 10.5-12'

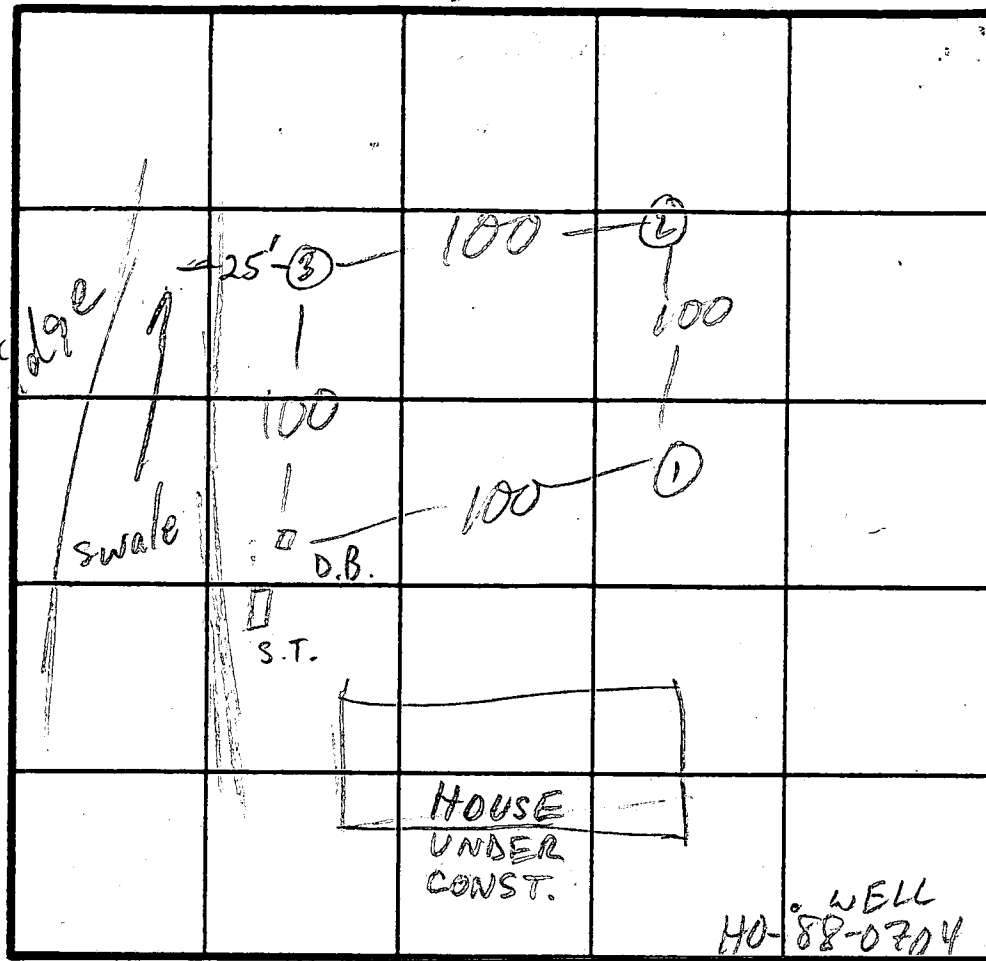


WESTCOTT PL. INDICATE NORTH - NAME ADJOINING ROADWAY AS BASE LINE.


DATE	TEST NO.	DEPTH	PRE-WET		TEST - 1" DROP		TIME
			START	STOP	START	STOP	
11/14/90	1 S	3	1:48	1:52	1:52	1:57	5
	1 V	10 1/2'	1.5'	FILL	see profile		
	2 S	11'	3'	FILL	more org SEE PROFILE		
	3 S	3'	2:34	2:41	2:41	2:59	18
	3 V	12'	2.5'	FILL	more org PROFILE		

REMARKS 1.5'-3' FILL ON TOP OF SDA; PERC DEPTHS FROM ORIG. GRADE



TYPE OF SOIL M. Riffin

TESTED BY M. Riffin ALSO PRESENT Fogle's men

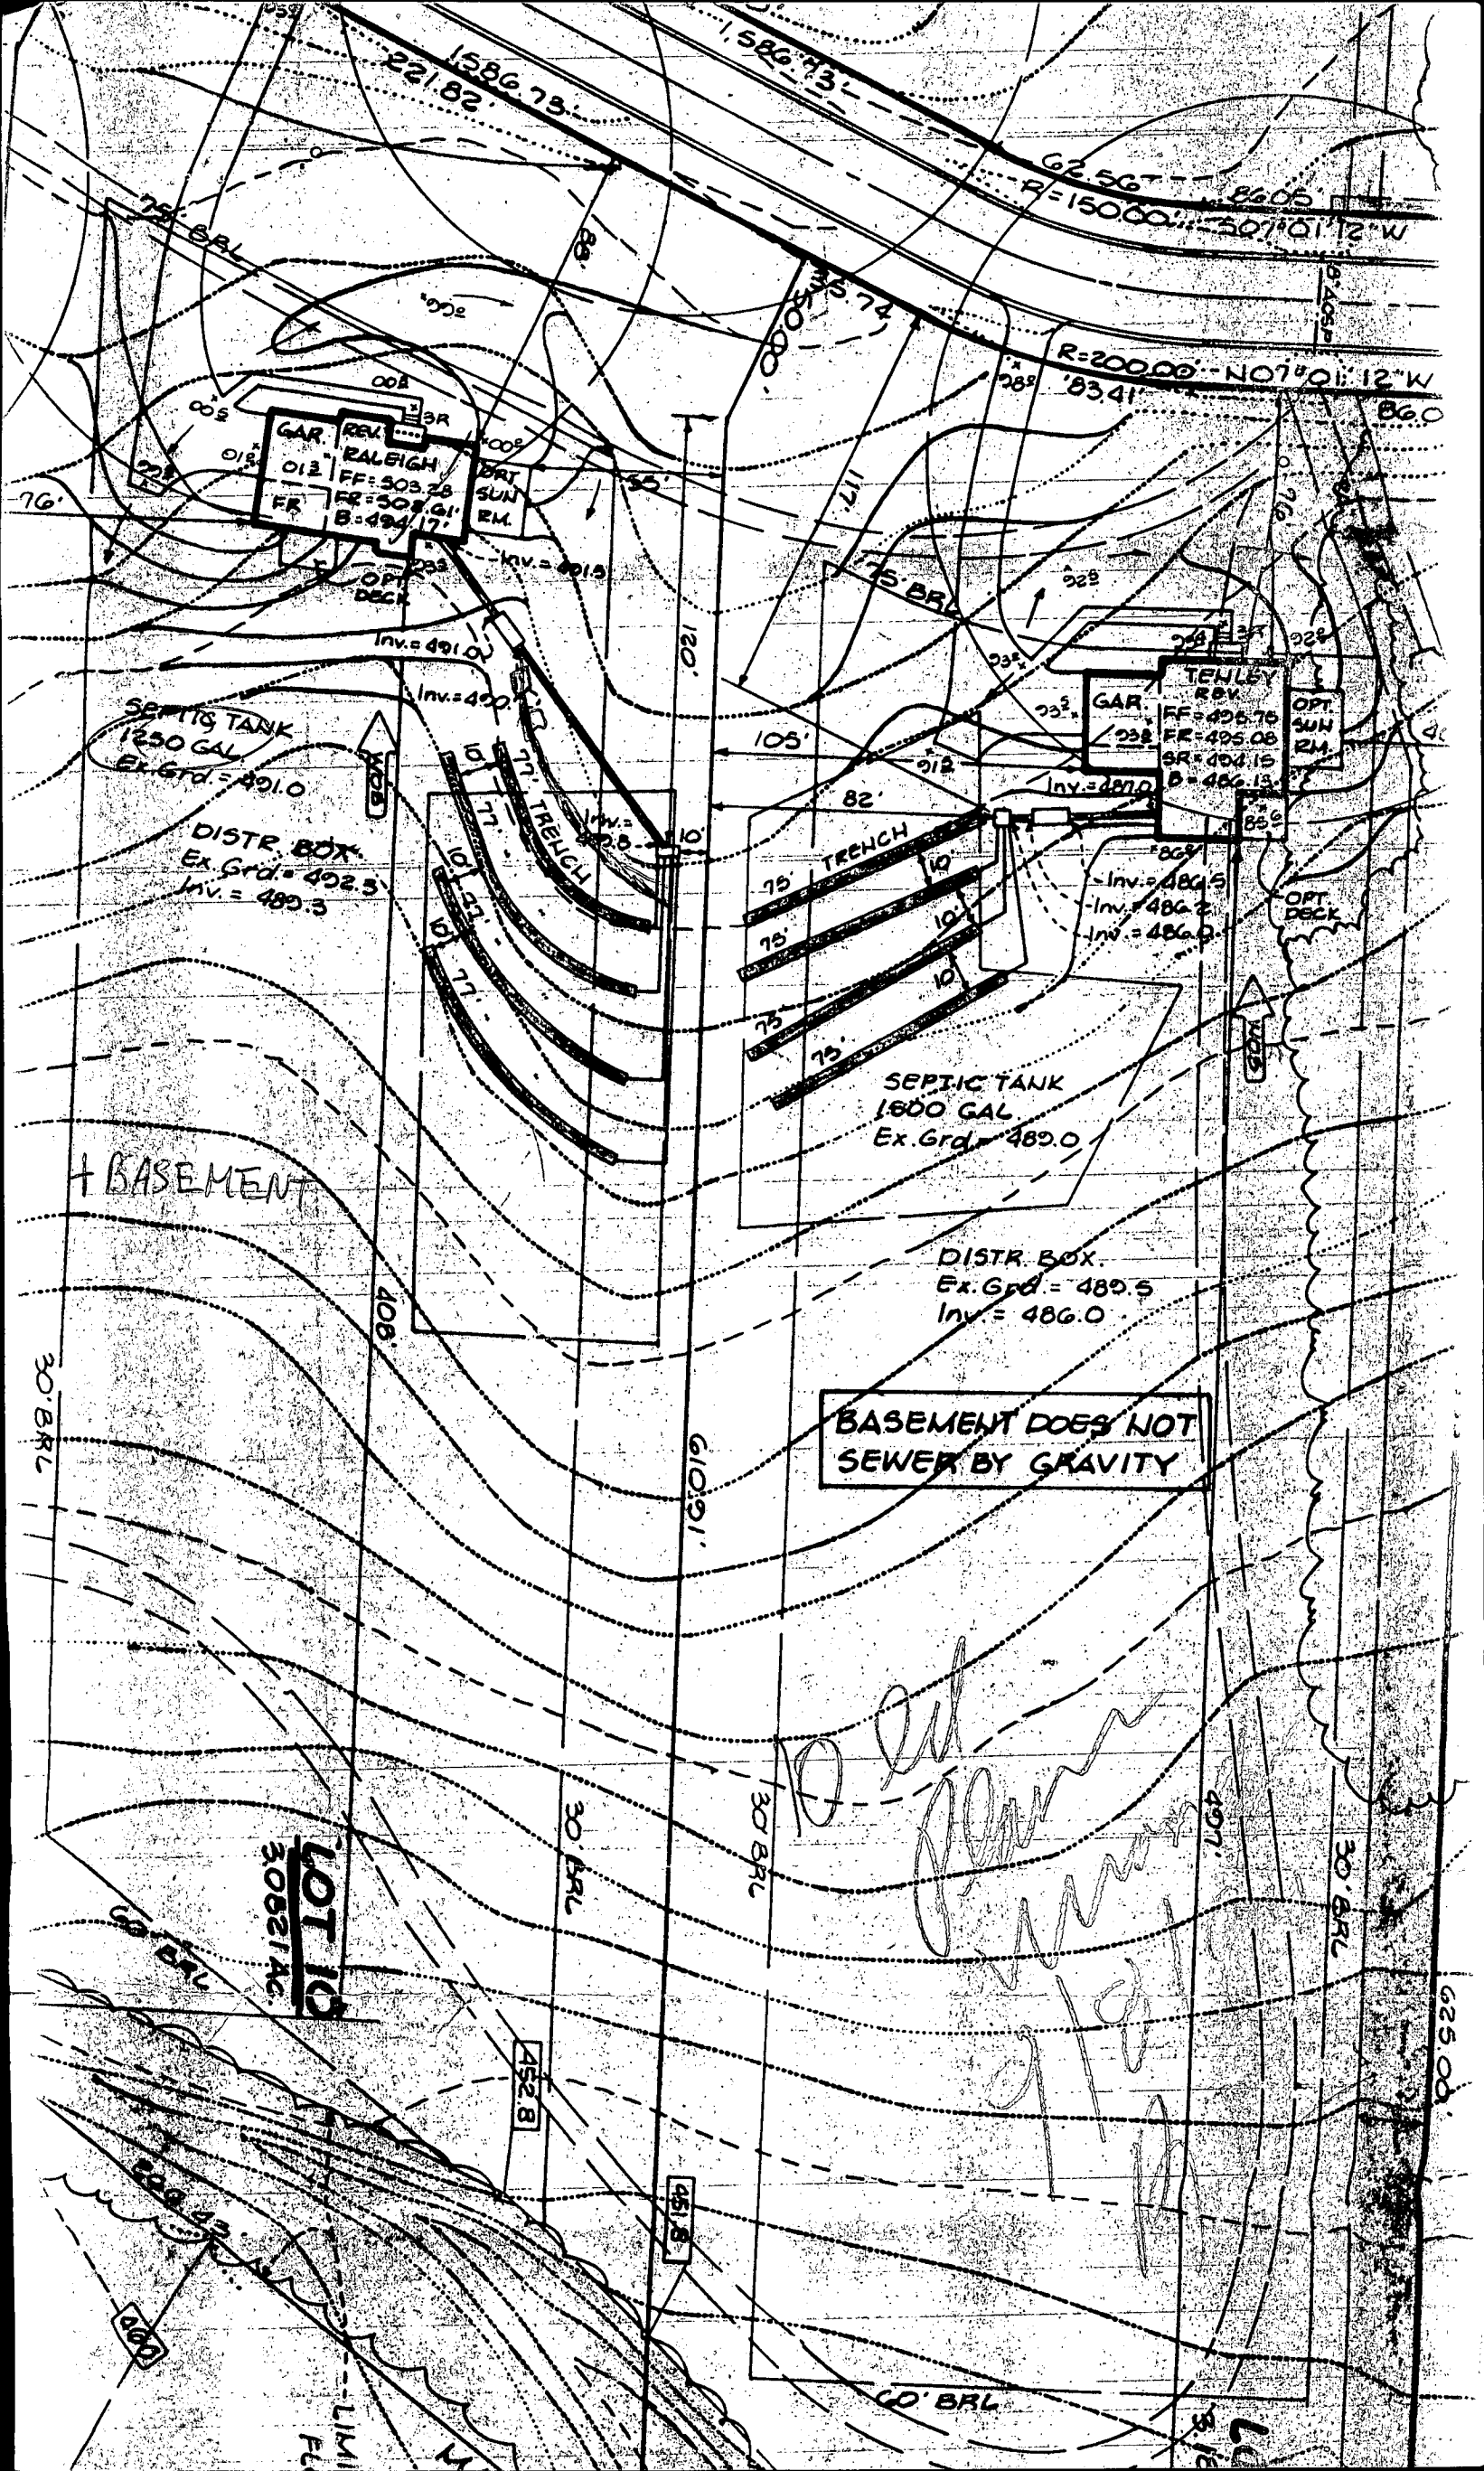

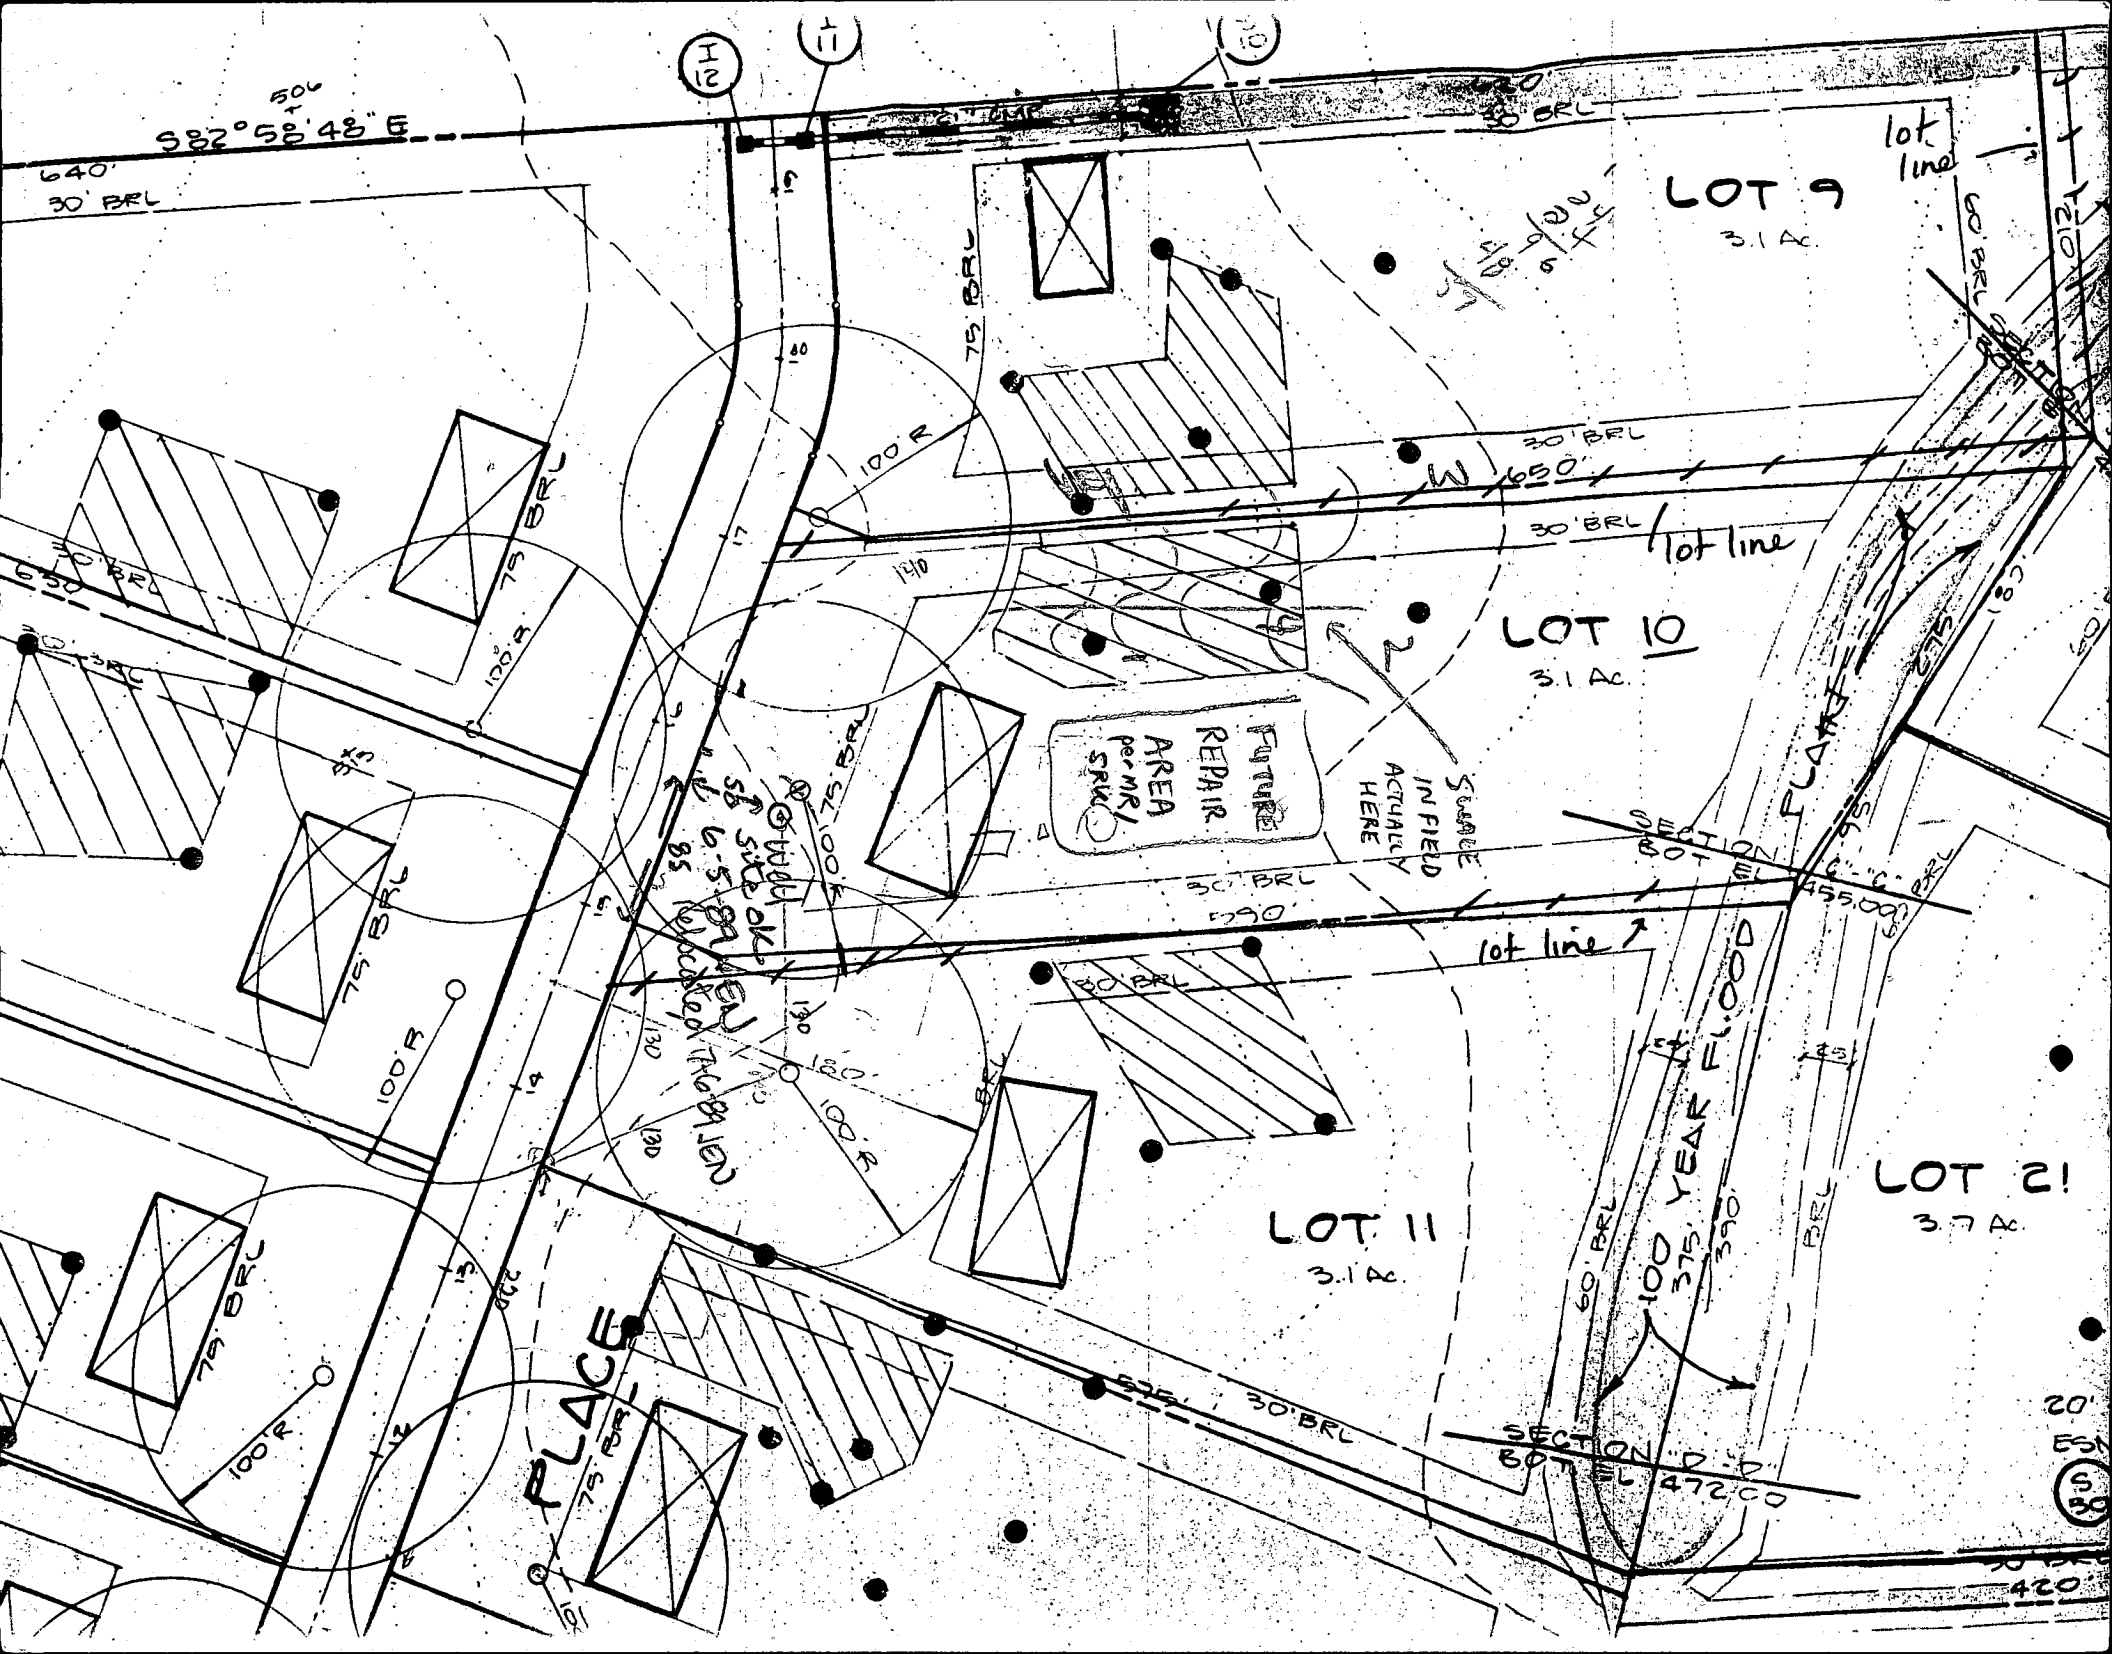

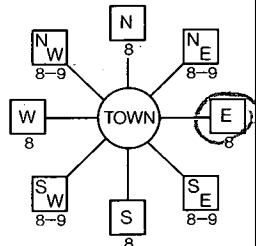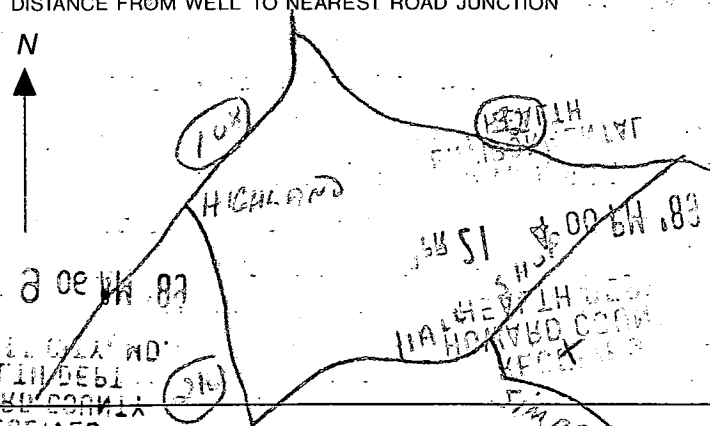

B 1 9136 (THIS NUMBER IS TO BE PUNCHED IN COLS: 3-6 ON ALL CARDS)	SEQUENCE NO. (DP USE ONLY)	STATE OF MARYLAND <b>PERMIT TO DRILL WELL</b> please print or type	STATE PERMIT NUMBER HD-88-0704 <small>fill in this form completely</small>
Date Received (APA) 040689 OWNER INFORMATION WINDHESTER HOMES 6305 IVY LANE S 700 ARFENREIT MD 20770 Town State Zip		B 3 LOCATION OF WELL R 44020 40.00 4/26/89 8 COUNTY ASHLEIGH GREENE 23 SUBDIVISION SECTION 1 LOT 10 44 46 48 50 HIGHLAND 52 NEAREST TOWN MILES FROM TOWN (enter 0 if in town) 2 MI 73 76 77 78	
DRILLER INFORMATION George F. Easterday Driller's Name L. Franklin Easterday, Inc. Firm Name 9205 Brown Church Rd., Mt. Airy, Md. 21771 Address Signature George F. Easterday Date 4/18/89		B 4 DIRECTION OF WELL FROM TOWN (CIRCLE BOX)  WE TOTT PLACE 11 NEAR WHAT ROAD 30 ON WHICH SIDE OF ROAD (CIRCLE APPROPRIATE BOX) NORTH N WEST W EAST E SOUTH S 34 50 37 DISTANCE FROM ROAD ENTER FT OR MI FT	
B 2 WELL INFORMATION APPROX. PUMPING RATE (GAL. PER MIN.) 5 AVERAGE DAILY QUANTITY NEEDED (GAL. PER DAY) 500 14 20		NOT TO BE FILLED IN BY DRILLER HEALTH DEPARTMENT APPROVAL Howard A 40717 COUNTY NAME COUNTY NO. STATE SIGNATURE DATE ISSUED INSERT S 060789 Anne E. Nadeau 12-7-89 43 48/CO SIGNATURE EXP. DATE NORTH GRID 490000 EAST GRID 0819000 50 55 57 63	
USE FOR WATER (CIRCLE APPROPRIATE BOX) <input checked="" type="checkbox"/> HOME (SINGLE OR DOUBLE HOUSEHOLD UNIT ONLY) <input type="checkbox"/> FARMING (LIVESTOCK WATERING & AGRICULTURAL IRRIGATION) <input type="checkbox"/> INDUSTRIAL, COMMERCIAL, STATE AND FEDERAL GOV. OTHER (REQUIRES APPROPRIATION PERMIT) <input type="checkbox"/> PUBLIC OR PRIVATE WATER COMPANY (REQUIRES APPROPRIATION PERMIT AND STATE HEALTH DEPARTMENT APPROVAL) <input type="checkbox"/> TEST, OBSERVATION, MONITORING (MAY REQUIRE APPROPRIATION PERMIT)		SHOW MAJOR FEATURES OF BOX & LOCATE WELL WITH AN X SOURCES OF DRILLING WATER 1. WELL 2. 3. WRITE THE BOX NUMBER FROM THE MAP HERE E 810 N 410 000 000	
APPROXIMATE DEPTH OF WELL 200 FEET 24 28 APPROXIMATE DIAMETER OF WELL 6 INCH NEAREST INCH		7-12-89 3:30 82ft casing # unable to observe JED	
METHOD OF DRILLING (circle one) BORED (or Augered) JETTED Jetted & DRIVEN 30 AIR-ROTARY AIR-PERCussion ROTARY (Hydraulic: Rotary) 37 CABLE REVERSE-ROTARY DRIVE-POINT other		DRAW A SKETCH BELOW SHOWING LOCATION OF WELL IN RELATION TO NEARBY TOWNS AND ROADS AND GIVE DISTANCE FROM WELL TO NEAREST ROAD JUNCTION 	
REPLACEMENT OR DEEPEMED WELLS (CIRCLE APPROPRIATE BOX) <input checked="" type="checkbox"/> THIS WELL WILL NOT REPLACE AN EXISTING WELL <input type="checkbox"/> THIS WELL WILL REPLACE A WELL THAT WILL BE ABANDONED AND SEALED <input type="checkbox"/> THIS WELL WILL REPLACE A WELL THAT WILL BE USED AS A STANDBY <input type="checkbox"/> THIS WELL WILL DEEPEMED AN EXISTING WELL PERMIT NUMBER OF WELL TO BE REPLACED OR DEEPEMED (IF AVAILABLE) 41 52		Not to be filled in by driller (OEP USE ONLY) APPROP. PERMIT NUMBER 54 GAP 63 FORCE IN WRITE INITIALS IN BOX PERMIT No. HD-88-0704 67 68 70 71 72 73 74 75 76 77 78 79	
SPECIAL CONDITIONS			

C1 0029  
SEQUENCE NO. (DENV USE ONLY)  
1-2 3 6  
(THIS NUMBER IS TO BE PUNCHED  
IN COLS. 3-6 ON ALL CARDS)

STATE OF MARYLAND  
WELL COMPLETION REPORT  
FILL IN THIS FORM COMPLETELY  
PLEASE PRINT OR TYPE

THIS REPORT MUST BE SUBMITTED WITHIN  
45 DAYS AFTER WELL IS COMPLETED.

COUNTY  
NUMBER A 40717

ST/CO USE ONLY  
DATE RECEIVED

DATE WELL COMPLETED

Depth of Well

PERMIT NO.  
FROM "PERMIT TO DRILL WELL"

8 13

15 20

22 26  
(TO NEAREST FOOT)

28 29 30 31 32 33 34 35 36 37

OWNER Winchester Homes  
STREET OR RFD last name first name TOWN Highland  
SUBDIVISION Ashland Green SECTION 1 LOT 10

WELL LOG

Not required for driven wells

STATE THE KIND OF FORMATIONS  
PENETRATED, THEIR COLOR, DEPTH,  
THICKNESS AND IF WATER BEARING

DESCRIPTION (Use  
additional sheets if needed)

FEET  
FROM TO

Check  
if water  
bearing

Top Soil 0 2  
Br mica 2 20  
Sand Stone 20 91  
Br mica 92 96  
Fray mica 96 100

GROUTING RECORD

WELL HAS BEEN GROUTED  
(Circle Appropriate Box)

yes no  
Y N  
44 44

TYPE OF GROUTING MATERIAL

CEMENT CM BENTONITE CLAY BC

NO. OF BAGS NO. OF POUNDS

GALLONS OF WATER

DEPTH OF GROUT SEAL (to nearest foot)

from 48 52 ft. to 54 58 ft.  
(enter 0 if from surface)

CASING RECORD  
casing types insert appropriate code below  
ST CO  
STEEL CONCRETE  
PL OT  
PLASTIC OTHER

MAIN CASING TYPE Nominal diameter top (main) casing (nearest inch) Total depth of main casing (nearest foot)  
SF 6 87

OTHER CASING (if used) diameter inch depth (feet) from to

SCREEN RECORD  
screen type or open hole insert appropriate code below  
ST BR HO  
STEEL BRASS OPEN HOLE  
PL OT  
PLASTIC OTHER

DEPTH (nearest ft.)  
H O 85 400

SLOT SIZE 1 2 3  
DIAMETER OF SCREEN (NEAREST INCH)  
from to

GRAVEL PACK IF WELL DRILLED WAS FLOWING WELL INSERT F IN BOX 68

OEP USE ONLY (NOT TO BE FILLED IN BY DRILLER)  
T (E.R.O.S.) W Q  
70 72 74 75 76  
TELESCOPE CASING LOG INDICATOR OTHER DATA

C 3

PUMPING TEST

HOURS PUMPED (nearest hour)

PUMPING RATE (gal. per min. to nearest gal.)

METHOD USED TO MEASURE PUMPING RATE

WATER LEVEL (distance from land surface)

BEFORE PUMPING

WHEN PUMPING

TYPE OF PUMP USED (for test)

A air P piston T turbine  
C centrifugal R rotary O other (describe below)  
J jet S submersible

PUMP INSTALLED

DRILLER WILL INSTALL PUMP YES NO

IF DRILLER INSTALLS PUMP, THIS SECTION MUST BE COMPLETED FOR ALL WELLS EXCEPT HOME USE

TYPE OF PUMP INSTALLED PLACE (A,C,J,P,R,S,T,O) IN BOX - SEE ABOVE:

CAPACITY: GALLONS PER MINUTE (to nearest gallon)

PUMP HORSE POWER

PUMP COLUMN LENGTH (nearest ft.)

CASING HEIGHT (circle appropriate box and enter casing height)

LAND SURFACE (nearest foot)

LOCATION OF WELL ON LOT  
SHOW PERMANENT STRUCTURE SUCH AS BUILDING, SEPTIC TANKS, AND/OR LANDMARKS AND INDICATE NOT LESS THAN TWO DISTANCES (MEASUREMENTS TO WELL)

CIRCLE APPROPRIATE LETTER  
A A WELL WAS ABANDONED AND SEALED WHEN THIS WELL WAS COMPLETED  
E ELECTRIC LOG OBTAINED  
P TEST WELL CONVERTED TO PRODUCTION WELL

I HEREBY CERTIFY THAT THIS WELL HAS BEEN CONSTRUCTED IN ACCORDANCE WITH COMAR 26.04.04 "WELL CONSTRUCTION" AND IN CONFORMANCE WITH ALL CONDITIONS STATED IN THE ABOVE CAPTIONED PERMIT, AND THAT THE INFORMATION PRESENTED HEREIN IS ACCURATE AND COMPLETE TO THE BEST OF MY KNOWLEDGE.

DRILLERS IDENT. NO. 46  
DRILLERS SIGNATURE (MUST MATCH SIGNATURE ON APPLICATION)  
SITE SUPERVISOR (sign. of driller or journeyman responsible for sitework if different from permittee)

COUNTY

APPLICATION

HOWARD COUNTY

SERIAL NUMBER

## PERMIT APPLICATION

DEPARTMENT OF INSPECTIONS, LICENSES & PERMIT  
3430 COURT HOUSE DRIVE, ELLICOTT CITY, MARYLAND 21043

B00113572

BUILDING ADDRESS (HOUSE NO., STREET, TOWN OR AREA)

6965 Westcott Pl. 37208  
Clarksville MD 21029GRADING/SEDIMENT CONTROL ☐ YES ☐ NO

SDP #

DESCRIPTION OF WORK AUTHORIZED

1 story 22x14 addition  
over unfinished basement  
w/ full bath Backyard

LOT NO.	PARCEL NO.	SEC.	AREA	BLOCK NO.	LIBER	FOLIO
SUB DIVISION						
ZONE		ZONE MAP		ELEC. DIST.		CENSUS TR.

OWNER NAME AND ADDRESS

PHONE NO.

Bernard Rafferty  
Same

301 851 0792

OCCUPANT'S NAME AND ADDRESS

PHONE NO.

Same

ARCHITECT OR ENGINEER'S NAME AND ADDRESS

PHONE NO.

CONTRACTOR'S NAME AND ADDRESS

PHONE NO.

Lundberg Home Improvements  
10749 Cordage Walk  
Columbia MD 21044

EXISTING USE

PROPOSED USE

SFD

1 story addition  
over basement

EST. CONSTRUCTION COST

LICENSE NUMBER

PERMIT FEE

\$11,000.00

44207

42

W/S CODE

FOR OFFICE USE ONLY

DISTANCE IN FEET FROM R/W LINE TO FRONT BUILDING LINE

SIDE YARD

(DISTANCE IN FEET FROM SIDE BLDG. LINE TO SIDE PROPERTY LINE)

TO SIDE BUILDING LINE

DISTANCE IN FEET, REAR YD. REQUIRING SET

BACK (CORNER LOT ONLY)

SDP #

Check payable to: DIRECTOR OF FINANCE OF HOWARD COUNTY

## CAUTION

To begin construction before a permit placard has been issued  
and displayed on the job is a violation of the law.Use and occupancy permit must be applied for two weeks  
before it will be issued.

IMPORTANT: PLEASE SHOW ZIP CODES AND AREA CODES WHEREVER REQUIRED.

LP-69-591

69412

SIZE OF BLDG.	FRONT	DEPTH	HEIGHT

TYPE OF BLDG.	AREA	VOLUME	ROOF
B. ROOMS			
ROOMS			
BATHS			
FIREPLACES			

FOOTINGS	FOUNDATION	S. WALLS

UTILITIES	WATER/WELL	SEWER/SEPTIC	GAS	ELECTRICITY	TYPE OF HEAT	AC

I have carefully examined and read this application and know the same is true and correct,  
and that is doing this work, all provisions of Howard County Ordinances and the State  
Laws of Maryland will be complied with, whether specified or not; and I will notify the  
Department of Inspections, and Permit twenty-four hours in advance when I am ready for  
the inspections called for elsewhere in the application and that no work will be covered up  
until such inspections have been completed with

TITLE	SIGNATURE	DATE
Pres	[Signature]	8-13-98

FUNCTION	DATE	SIGNATURE APPROVAL
ZONING/PLANNING		
SHA		
SEDIMENT/GRADING		
BUILDING OFFICIAL	8/13/98	[Signature]
WATER & SEWER		
HEALTH DEPT.	8-14-98	A. McMillen
FIRE PROTECTION	8-22	
STORM WATER MGM.		

APPROVED

DATE

Distribution of Copies:  
White - Building Official  
Green - Planning & ZoningYellow - Engineering  
Pink - Health Dept.  
Gold - S.H.A.6965 Westcott Pl  
Clarksville

Rafferty



SRK - Pls. call owners  
w/insp results - MR

WINCH.

NOTE: This Lot lies in Zone C, as shown on Flood Insurance Rate Map for Howard Co., Md., Map Panel 38 of 45, dated Dec. 4, 1986.

LOCATION OF HOUSE  
6965 WESTCOTT PLACE  
LOT 10


ASHLEIGH GREENE  
SUBDIVISION

SECTION 1

LOTS 1 THRU 27

5TH ELECTION DISTRICT

HOWARD COUNTY, MARYLAND

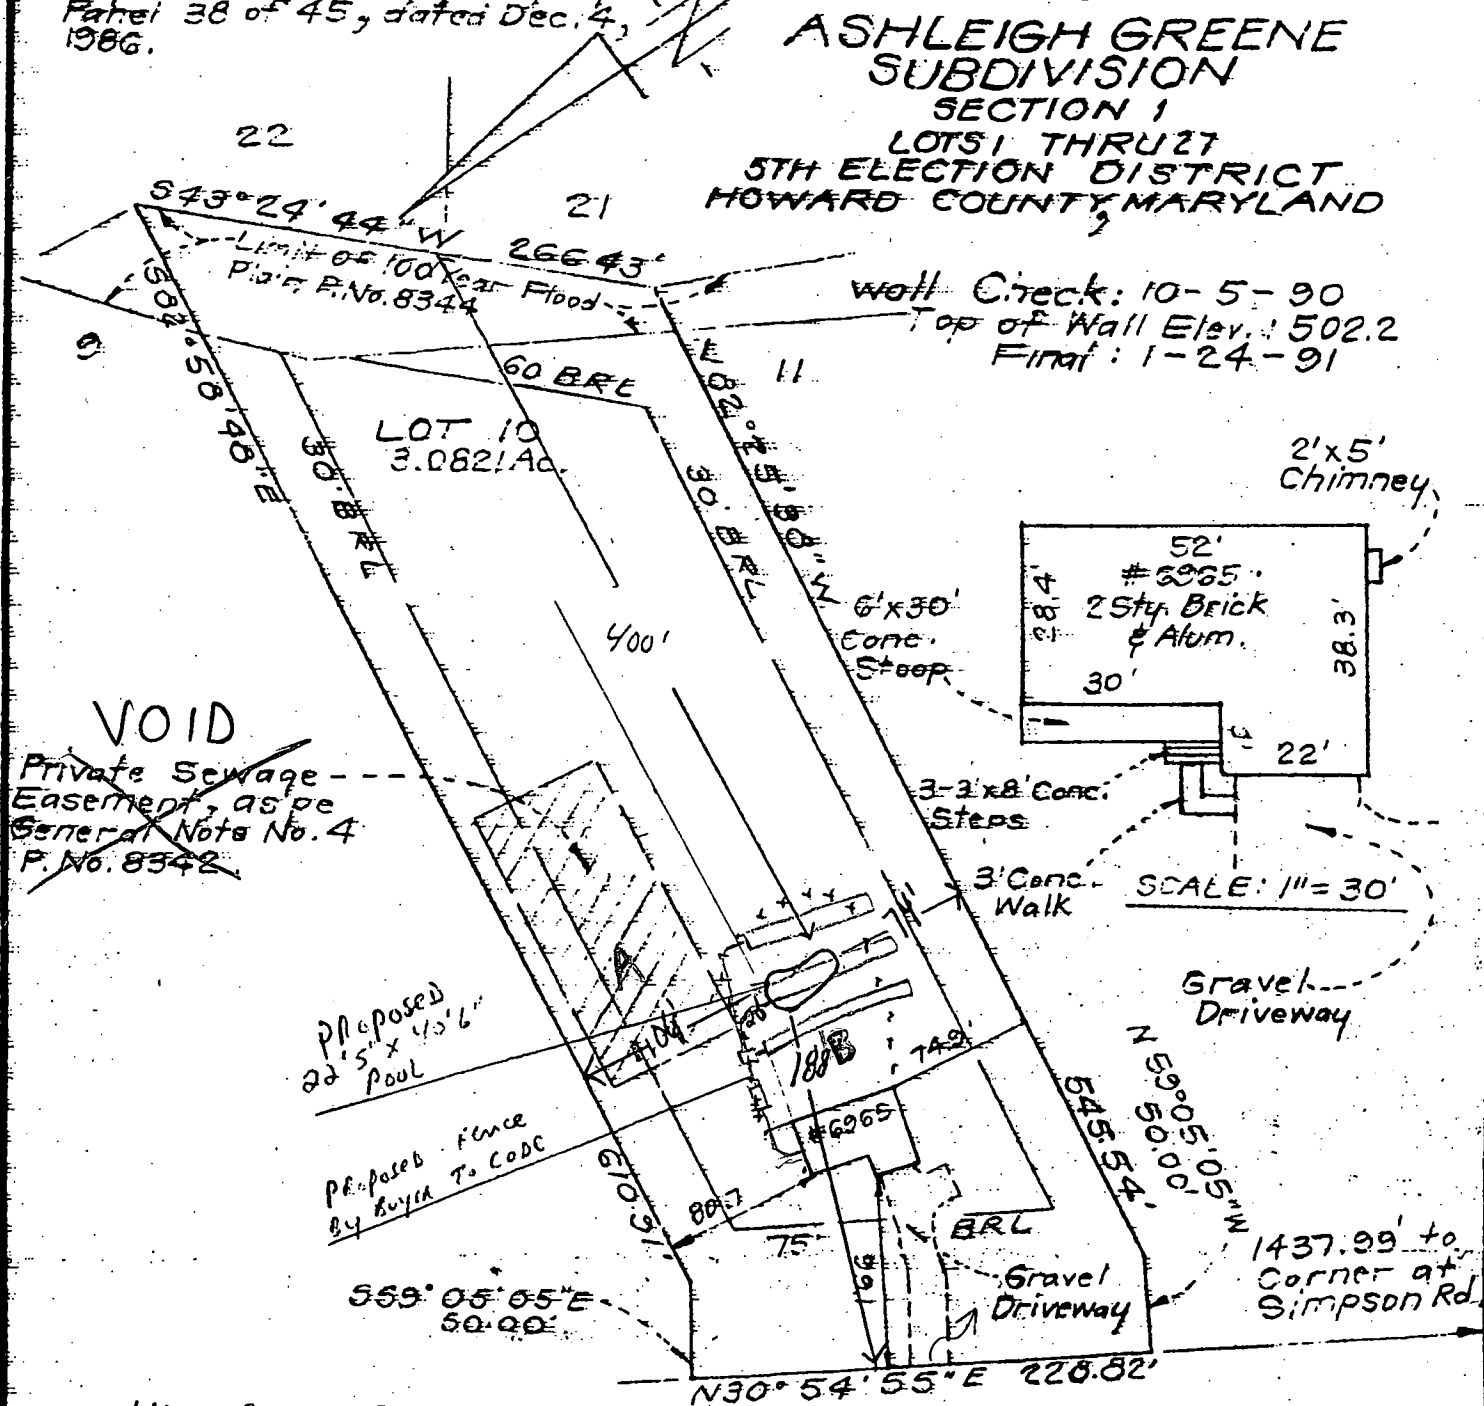

410-974-1563  
Pool Contractor

WESTCOTT PLACE  
50 R/W

82-001

**SURVEYOR'S CERTIFICATE**

I hereby certify that the position of all existing improvements on the above described property have been carefully established by a true and correct survey and that unless otherwise shown, there are no encroachments.

*[Signature]*

**CLARK • FINEFROCK & SACKETT, INC.**

ENGINEERS • PLANNERS • SURVEYORS  
7135 MINSTREL WAY COLUMBIA, MD. 21045  
(301) 581-7500-BALTO. • (301) 621-6100-WASH.

REFERENCE	DRAWN BY KWC	CHECKED BY J.K.
Plot No. 8344	DATE 1-24-91	FILE NO. 2324-W
	SCALE 1" = 100'	