

10/2/95
C/O am

PERMIT

SEWAGE DISPOSAL SYSTEM

DEPARTMENT OF HEALTH AND MENTAL HYGIENE

P 50890

A 40785

DISTRICT _____

DATE 9/21/95

HOWARD COUNTY HEALTH DEPARTMENT

BUREAU OF ENVIRONMENTAL HEALTH

313-2640

DATE SYSTEM APPROVED 7/16/96

INSPECTOR AK

INDEXED

Scott & Bonnie Myers IS PERMITTED TO INSTALL X ALTER _____

ADDRESS 4409 Bender Court PHONE (301) 604-7695

SUBDIVISION The Warfields LOT 21 ROAD 14813 Sapling Way

PROPERTY OWNER Scott Myers

ADDRESS 14813 Sapling Way

SEPTIC TANK CAPACITY 1250 GALLONS *Maintain 100' minimum distance between well and any part of septic system.*

NUMBER OF BEDROOMS 4

180 SQUARE FEET PER BEDROOM

LINEAR FEET OF TRENCH REQUIRED 240

180
720

240
3720
6

TRENCHES - Trench to be 3 feet wide. Inlet 3 feet below original grade. Bottom maximum depth 4.5 feet below original grade. Effective area begins at 3.0 feet below original grade. 1.5 feet of stone below distribution pipe.

LOCATION - To be determined when repair is conducted.

NOTES No trench to exceed 100 feet in length. Provide 6" - 8" diameter cleanout and cap to grade or above on septic tank. OK 9/22/95 AK

9/26/95 Place distribution box in center of SDA and run trenches on contour in both directions (170' from front lot line and 70' off that same lot line.) AM

PLANS APPROVED BY Amy McMillen/ Donna K. Soe DATE 7/27/95

COVER NO WORK UNTIL INSPECTED AND APPROVED

NEITHER THE HOWARD COUNTY COUNCIL NOR THE HEALTH DEPARTMENT IS RESPONSIBLE FOR THE SUCCESSFUL OPERATION OF ANY SYSTEM

NOTE: CLEANOUT REQUIRED EVERY 70 FEET OF SEWER LINE AND/OR AT 90° SWEEPS IN LINES FROM HOUSE TO DRAIN FIELDS, 90° ELBOWS NOT ACCEPTABLE.

NOTE: ALL PARTS OF SEPTIC SYSTEMS (I.E. TANK, DISTRIBUTION BOX TRENCHES) TO BE 100 FEET FROM WELL (UNLESS OTHERWISE SPECIFICALLY AUTHORIZED)

NOTE: IF DEEP TRENCH(ES) ARE USED CALL FOR INSPECTION BEFORE AND AFTER PLACING GRAVEL IN TRENCHES

NOTE: NO DRY WELL SHALL EXCEED 15 FOOT IN DIAMETER NO ABSORPTION TRENCH TO EXCEED 100 FEET IN LENGTH

NOTE: ALL PIPE FROM HOUSE TO SEPTIC TANK MUST BE CAST IRON OR SCHEDULE 35/40 PVC OR ABS

PERMIT VOID AFTER TWO YEARS

NOTE: INSTALL STAND PIPE ON SEPTIC TANK AND DRY WELL STAND PIPES MUST BE 6 INCHES IN DIAMETER CAST IRON. CONCRETE OR TERRA COTTA OR PVA OR ABS ACCEPTED. IF TOP OF SEPTIC TANK IS DEEPER THAN 3 FEET. MANHOLE TO GRADE REQUIRED.


NOTE: DISTRIBUTION BOXES MUST HAVE BAFFLES

*INSTALLER IS RESPONSIBLE FOR OBTAINING FINAL APPROVAL ON THIS PERMIT

BUILDING PERMIT SIGNED
AND RETURNED 11-7-02

800 137-248 - FINISH BASEMENT
7/22/04 800 149-048 - SHED W/DECK

A 40785

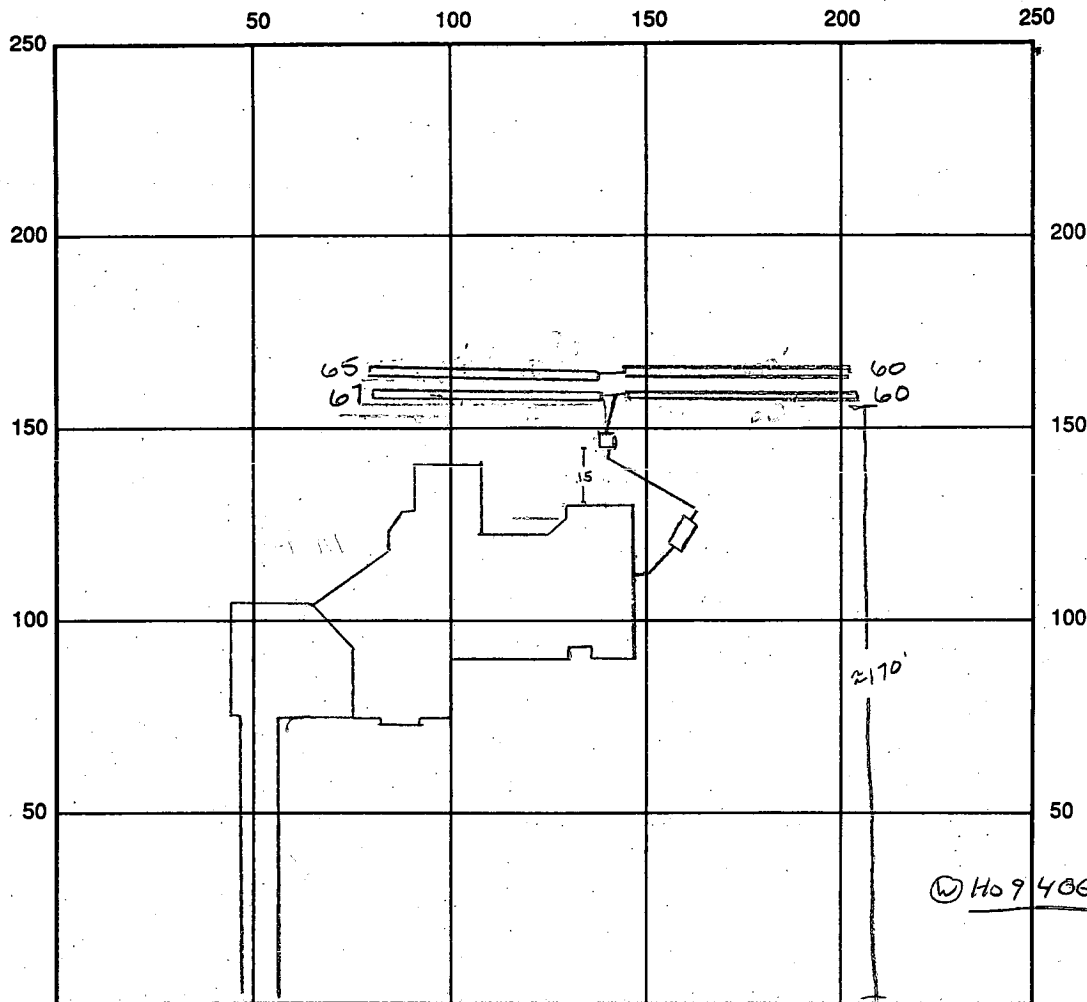

INDICATE NORTH - NAME ADJOINING ROADWAY AS BASE LINE

Sapling Way

SEPTIC TANK LEVEL OK (250 gal) CLEANOUTS OK

DISTRIBUTION BOX LEVEL OK baffle is in

DRAIN FIELD/TITLE DEPTH 4.5-5.0 FT. TRENCH WIDTH 3' FT. INLET DEPTH 3' FT.

EFFECTIVE GRAVEL DEPTH 1.5-2.0' FT. TOTAL LENGTH 65 @ 60 FT. 252 total

NUMBER OF TRENCHES 4 ONE SIDEWALL/BOTTOM AREA 756 SQ. FT.

DRYWALL INSIDE DIAMETER FT. EFFECTIVE DEPTH BELOW INLET FT.

ABSORBENT AREA SQ. FT.

REMARKS: 9/26/95 Trenches dug too long - cover last 40' on left side of lot then
OK to cover trenches - Call for insp when
house connection is made Area

DATE SYSTEM APPROVED 7/16/96 INSPECTOR Andy M. Mellen

APPLICATION

PERCOLATION TESTING

HOWARD COUNTY HEALTH DEPARTMENT
BUREAU OF ENVIRONMENTAL HEALTH
P.O. BOX 476 ELLICOTT CITY, MARYLAND 21043
TELEPHONE: 461-9933

A 40785

P _____

DISTRICT 5th

DATE 12/1/87

TO: THE COUNTY HEALTH OFFICER
ELLICOTT CITY, MARYLAND

I, HEREBY, APPLY FOR THE NECESSARY TEST IN ORDER TO CONSTRUCT (OR RECONSTRUCT) A SEWAGE DISPOSAL SYSTEM.

PROPERTY OWNER Kennard Warfield Jr.

ADDRESS 14663 Triadelphia Rd PHONE 442-2337

PROSPECTIVE BUYER N/A

ADDRESS _____ PHONE _____

PROPERTY LOCATION:

SUBDIVISION ~~Sapling Range~~ THE WARTFIELDS LOT NO. 26 Lot 21 Preliminary

ROAD AND DESCRIPTION 14600 Triadelphia Rd just west of Howard Rd

Sapling Way

TAX MAP 27 PARCEL # 56

SIZE OF LOT 3 acres TYPE BLDG. SFD - 4 Brms

(SINGLE FAMILY DWELLING OR COMMERCIAL)

THE SYSTEM INSTALLED UNDER THIS APPLICATION IS ACCEPTABLE ONLY UNTIL PUBLIC FACILITIES BECOME AVAILABLE. I FULLY UNDERSTAND THE

FEE CONNECTED WITH THE FILING OF THIS PERC TEST APPLICATION IS NON-REFUNDABLE UNDER ANY CIRCUMSTANCES. I ALSO AGREE TO COMPLY

WITH ALL M.O.S.H.A. REQUIREMENTS IN TESTING THIS LOT.

Myard Reil
(SIGNATURE OF APPLICANT)

APPROVED BY _____ FOR _____ DATE _____

REJECTED BY _____ FOR _____ DATE _____


HOLD PENDING FURTHER TESTS _____ DATE _____

REASONS FOR REJECTION OR HOLDING 2-1-88 PERC SATISFACTORY - Held For Subdivision Plat. 8. Also

THIS IS NOT A PERMIT

SOIL PROFILE

6" 0'	AP
2.5-3.0'	Yell. Br. Silty CL. Loam 10-15% FRAGS
	FIN Silt Loam 25-35% Micaceous FRAGS.

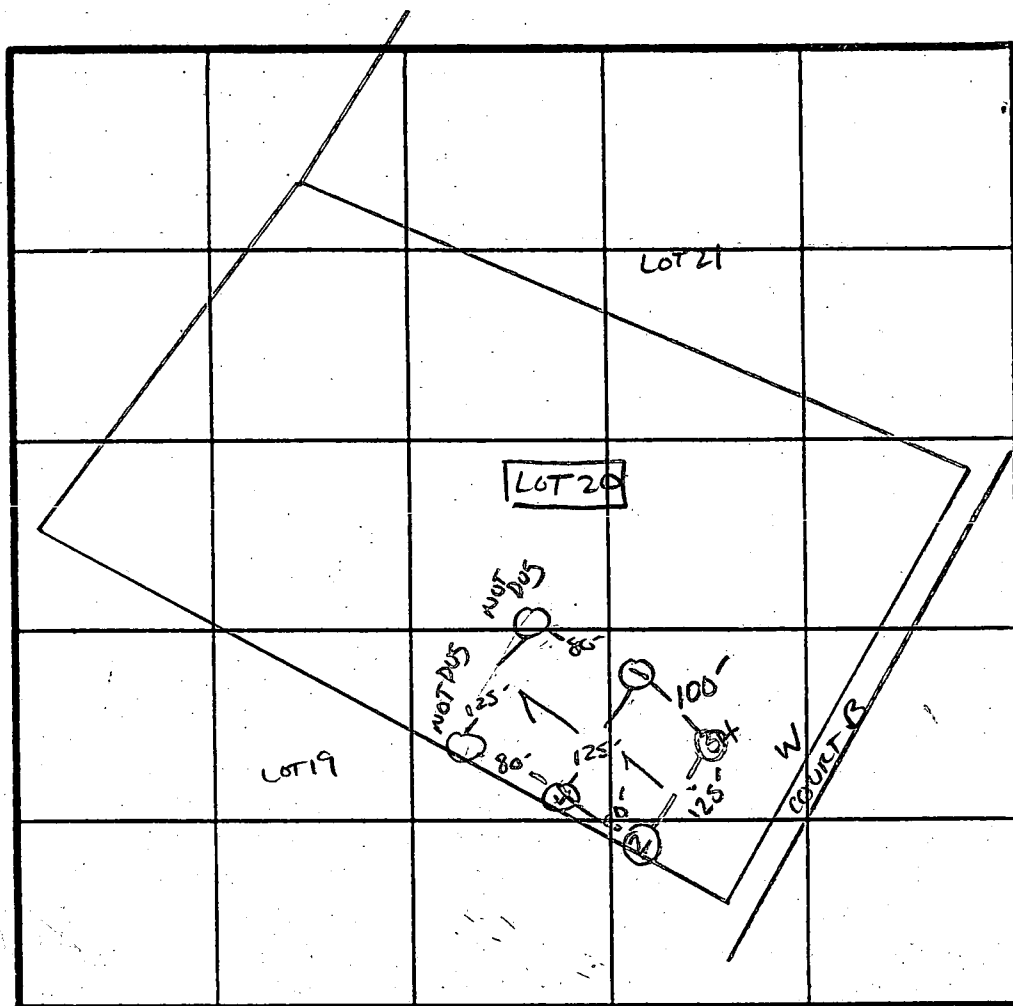

$\bar{x}$ PERC 5 MIN
 180 ϕ 131
 INLET 3.0'
 BOTTOM 4.5'

INDICATE NORTH - NAME ADJOINING ROADWAY AS BASE LINE

↓ TO TRIADOLPHIA REL.

DATE	TEST NO.	DEPTH	PRE-WET		TEST - 1" DROP		TIME
			START	STOP	START	STOP	
2/1/88	1 S V	3.0' 9.0'	11:03 HARD BUT	11:08 DM - UN	11:08 FORM below	11:14 2.5"	6 min
	2 S M	3.5 6.5	10:53 10:52	10:56 10:55	10:56 10:55	11:03 10:59	7 min 4 min
	2 V	12'	UNIFORM soil below 3.0"				
	3 V	9.0'	UNIFORM below 3.0" HARD AT 9.0"				
	4 S V	3.5' 9.5'	10:56 UNIFORM	10:57 soil below	10:57 3.5"	11:00 ROCKY AT 8.5"	3 min OK

NO ROCK OUTCROPS WITHIN EASEMENT

REMARKS Holes DIFF THAN PLAT. SHALLOW SIST ONLY. 2.5-4.5'

TYPE OF SOIL Glenoia

TESTED BY Sid Abel ALSO PRESENT MARK R. KETTERMAN & CO.

EH-12-1079

APPLICATION

PERCOLATION TESTING

PGG DUE

A 50883

P _____

HOWARD COUNTY HEALTH DEPARTMENT
BUREAU OF ENVIRONMENTAL HEALTH
3525-H ELLICOTT MILLS DRIVE/ELLICOTT CITY, MARYLAND 21043
TELEPHONE: 313-2640

*PREVIOUS OIC
PROPOSAL IS
TO ADJUST
EXISTING
SEWATIC EASEMENT*

DISTRICT _____

DATE 9-20-95

TO: THE COUNTY HEALTH OFFICER
ELLICOTT CITY, MARYLAND

I HEREBY APPLY FOR THE NECESSARY TEST PRIOR TO APPLICATION FOR PERMIT TO CONSTRUCT (OR RECONSTRUCT) A SEWAGE DISPOSAL SYSTEM.

PROPERTY OWNER SCOTT & BONNIE MYERS

ADDRESS 4409 BENDER CT PHONE 301-604-7695

AGENT OR PROSPECTIVE BUYER _____

ADDRESS _____ PHONE _____

PROPERTY LOCATION:

SUBDIVISION WARFIELDS LOT NO. 21

ROAD AND DESCRIPTION SAPPLING CT GLENELEG MD

TAX MAP _____ PARCEL # _____

SIZE OF LOT 3.46 TYPE BLDG. SINGLE FAMILY
(SINGLE FAMILY DWELLING OR COMMERCIAL)

THE SYSTEM INSTALLED UNDER THIS APPLICATION IS ACCEPTABLE ONLY UNTIL PUBLIC FACILITIES BECOME AVAILABLE. I FULLY UNDERSTAND THE FEE CONNECTED WITH THE FILING OF THIS PERC TEST APPLICATION IS NON-REFUNDABLE UNDER ANY CIRCUMSTANCES. I ALSO AGREE TO COMPLY WITH ALL M.O.S.H.A. REQUIREMENTS IN TESTING THIS LOT.

Scott & Bonnie Myers
(SIGNATURE OF APPLICANT)

APPROVED BY _____ FOR _____ DATE _____

DISAPPROVED BY _____ FOR _____ DATE _____

HOLD PENDING FURTHER TESTS _____

REASONS FOR REJECTION OR HOLDING _____

PERCOLATION TEST PLAT/PRELIMINARY PLAT - TITLE OR I.D. # _____ DATE _____

SITE DEVELOPMENT PLAN/FINAL PLAT - TITLE OR I.D. # _____ DATE _____

THIS IS NOT A PERMIT

58883

COUNTY #

SAPLING WAY

CENTER LINE OF ROAD

SOIL PROFILE

0' MED BROWN CLAY LOAM


3' PINKISH BROWN SILT LOAM

7' LIGHT TAN SANDY SILT LOAM

SOIL PROFILE

0' RED BROWN CLAY LOAM

3' BROWN SILT LOAM

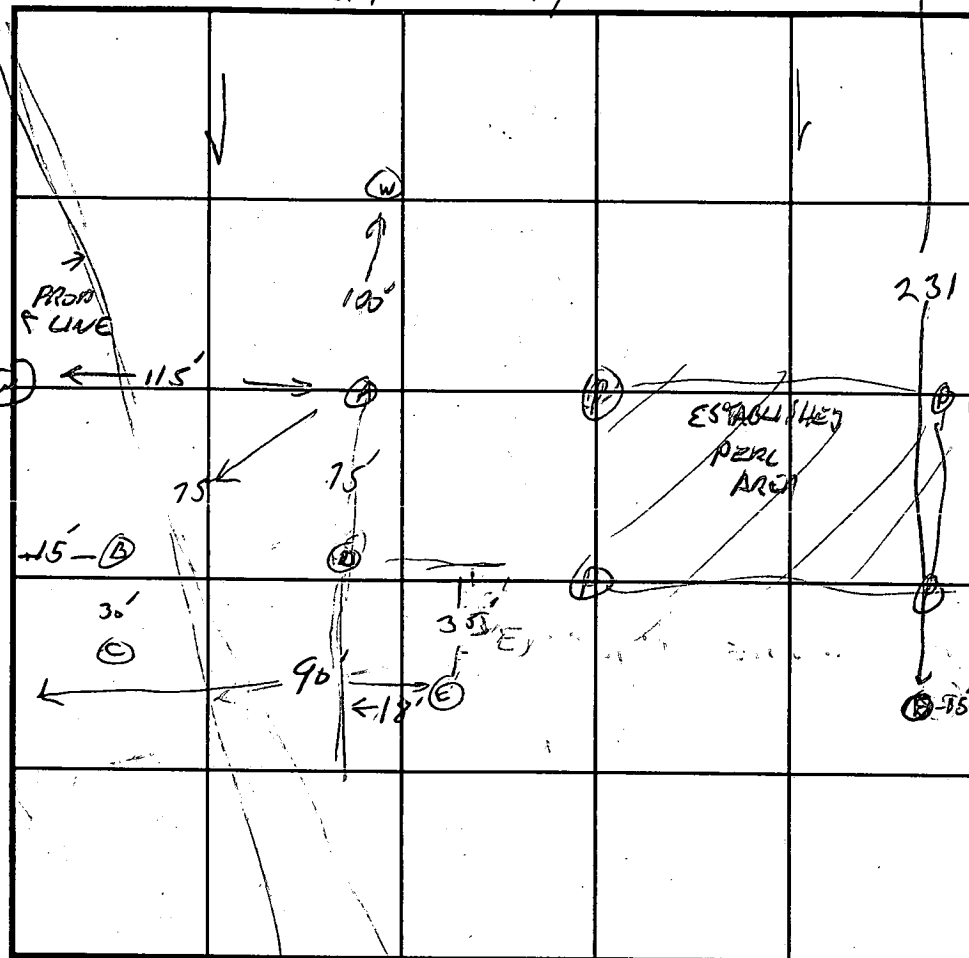

RED BROWN CLAY LOAM

3' MIXED LAYERS BROWN TAN GRAY GREY

SSC

15' LARGE ROCKS 6-2'

DATE	TEST NO.	DEPTH	PRE-WET		TEST - 1" DROP		TIME
			START	STOP	START	STOP	
9-21-95	OK TO 10 A	3' 6"	2:34	2:40	2:40	2:50	10 min
	FAIL B ROCK AT 3'						
	FAIL C ROCK AT 5'						
	OK TO 9						
	OK TO 9 1/2"	4' WILL PERM SHALDER	3:50	3:52	3:52	3:55	3 min

REMARKS

TYPE OF SOIL

TESTED BY

ALSO PRESENT

TRENCH DESIGN DATA: AVERAGE PERCOLATION TIME

TRENCH WIDTH

INLET DEPTH

MAXIMUM BOTTOM DEPTH

SQ. FT./BEDROOM

2 27 3 231

C1 2799 1 2 3 4 5 6 (THIS NUMBER IS TO BE PUNCHED IN COLS. 3-6 ON ALL CARDS)	SEQUENCE NO. (MDE USE ONLY)	STATE OF MARYLAND WELL COMPLETION REPORT FILL IN THIS FORM COMPLETELY PLEASE PRINT OR TYPE	THIS REPORT MUST BE SUBMITTED WITHIN 45 DAYS AFTER WELL IS COMPLETED. COUNTY NUMBER A40785																														
ST/CO USE ONLY DATE Received	DATE WELL COMPLETED 080995	Depth of Well 265 (TO NEAREST FOOT)	PERMIT NO. FROM "PERMIT TO DRILL WELL" H0-94-0642																														
OWNER <u>Kennard Warfield</u> STREET OR RFD <u>Sapling Way</u> TOWN <u>Glencig</u> SUBDIVISION <u>The Warfields</u> SECTION _____ LOT <u>21</u>																																	
WELL LOG Not required for driven wells STATE THE KIND OF FORMATIONS PENETRATED, THEIR COLOR, DEPTH, THICKNESS AND IF WATER BEARING <table border="1" style="width:100%; border-collapse: collapse; font-size: 8px;"> <thead> <tr> <th rowspan="2">DESCRIPTION (Use additional sheets if needed)</th> <th colspan="2">FEET</th> <th rowspan="2">check if water bearing</th> </tr> <tr> <th>FROM</th> <th>TO</th> </tr> </thead> <tbody> <tr> <td>Top Soil</td> <td>0</td> <td>2</td> <td></td> </tr> <tr> <td>Sandy</td> <td>2</td> <td>26</td> <td></td> </tr> <tr> <td>Sand Stone</td> <td>26</td> <td>35</td> <td>✓</td> </tr> <tr> <td>MICKA</td> <td>35</td> <td>80</td> <td></td> </tr> <tr> <td>Sand Stone</td> <td>80</td> <td>85</td> <td>✓</td> </tr> <tr> <td>MICKA</td> <td>85</td> <td>265</td> <td></td> </tr> </tbody> </table>		DESCRIPTION (Use additional sheets if needed)	FEET		check if water bearing	FROM	TO	Top Soil	0	2		Sandy	2	26		Sand Stone	26	35	✓	MICKA	35	80		Sand Stone	80	85	✓	MICKA	85	265		GROUTING RECORD yes no WELL HAS BEEN GROUTED (Circle Appropriate Box) (Y) (N) TYPE OF GROUTING MATERIAL (Circle one) CEMENT (CM) / BENTONITE CLAY (BC) NO. OF BAGS <u>16</u> NO. OF POUNDS <u>1000</u> GALLONS OF WATER <u>60</u> DEPTH OF GROUT SEAL (to nearest foot) from <u>0</u> ft. to <u>30</u> ft. (enter 0 if from surface) CASING RECORD casing types insert appropriate code below ST STEEL CO CONCRETE PL PLASTIC OT OTHER MAIN CASING TYPE Nominal diameter top of casing (nearest inch) Total depth of main casing (nearest foot) PL 60 61 6 63 64 32 66 70 OTHER CASING (if used) diameter inch depth (feet) from to SCREEN RECORD screen type or open hole insert appropriate code below ST STEEL BR BRASS BRONZE HO OPEN HOLE PL PLASTIC OT OTHER	
DESCRIPTION (Use additional sheets if needed)	FEET		check if water bearing																														
	FROM	TO																															
Top Soil	0	2																															
Sandy	2	26																															
Sand Stone	26	35	✓																														
MICKA	35	80																															
Sand Stone	80	85	✓																														
MICKA	85	265																															
NUMBER OF UNSUCCESSFUL WELLS: <u>0</u> WELL HYDROFRACTURED yes no (Y) (N) CIRCLE APPROPRIATE LETTER A A WELL WAS ABANDONED AND SEALED WHEN THIS WELL WAS COMPLETED E ELECTRIC-LOG OBTAINED P TEST WELL CONVERTED TO PRODUCTION WELL I HEREBY CERTIFY THAT THIS WELL HAS BEEN CONSTRUCTED IN ACCORDANCE WITH COMAR 26.04.04 "WELL CONSTRUCTION" AND IN CONFORMANCE WITH ALL CONDITIONS STATED IN THE ABOVE CAPTIONED PERMIT, AND THAT THE INFORMATION PRESENTED HEREIN IS ACCURATE AND COMPLETE TO THE BEST OF MY KNOWLEDGE. TYPE: MWD/MSD/MGD DRILLERS LIC. NO. <u>116</u> <u>Ralph Mayne</u> DRILLERS SIGNATURE (MUST MATCH SIGNATURE ON APPLICATION) LIC. NO. <u>117</u> <u>Ralph Mayne</u> SITE SUPERVISOR (sign. of driller or journeyman responsible for sitework if different from permittee)		C2 DEPTH (nearest ft.) H030265 SLOT SIZE 1 2 3 DIAMETER OF SCREEN <u>56</u> <u>60</u> (NEAREST INCH) GRAVEL PACK IF WELL DRILLED WAS FLOWING WELL INSERT F IN BOX 68 <u>68</u> MDE USE ONLY (NOT TO BE FILLED IN BY DRILLER) T (E.R.O.S.) W Q TELESCOPE CASING LOG INDICATOR OTHER DATA																															
PUMPING TEST HOURS PUMPED (nearest hour) <u>3</u> PUMPING RATE (gal. per min.) <u>6</u> METHOD USED TO MEASURE PUMPING RATE <u>Bucket</u> WATER LEVEL (distance from land surface) BEFORE PUMPING <u>35</u> ft. WHEN PUMPING <u>60</u> ft. TYPE OF PUMP USED (for test) A air P piston T turbine C centrifugal R rotary O other (describe below) J jet (S) submersible		PUMP INSTALLED DRILLER WILL INSTALL PUMP (YES or NO) (NO) IF DRILLER INSTALLS PUMP, THIS SECTION MUST BE COMPLETED FOR ALL WELLS. TYPE OF PUMP INSTALLED PLACE (A,C,J,P,R,S,T,O) IN BOX 29 CAPACITY: GALLONS PER MINUTE (to nearest gallon) <u>31</u> <u>35</u> PUMP HORSE POWER <u>37</u> <u>41</u> PUMP COLUMN LENGTH (nearest ft.) <u>43</u> <u>47</u> CASING HEIGHT (circle appropriate box and enter casing height) (+) above (-) below LAND SURFACE <u>2</u> (nearest foot) LOCATION OF WELL ON LOT SHOW PERMANENT STRUCTURE SUCH AS BUILDING, SEPTIC TANKS, AND/OR LANDMARKS AND INDICATE NOT LESS THAN TWO DISTANCES (MEASUREMENTS TO WELL) 																															

REVISION TO SEWAGE DISPOSAL AREA


By copy of this plan
the Health Department
accepts this modification
to the sewage disposal
easement.

Amy McMillen

11/29/95

2-120' RUNS

1"=100'

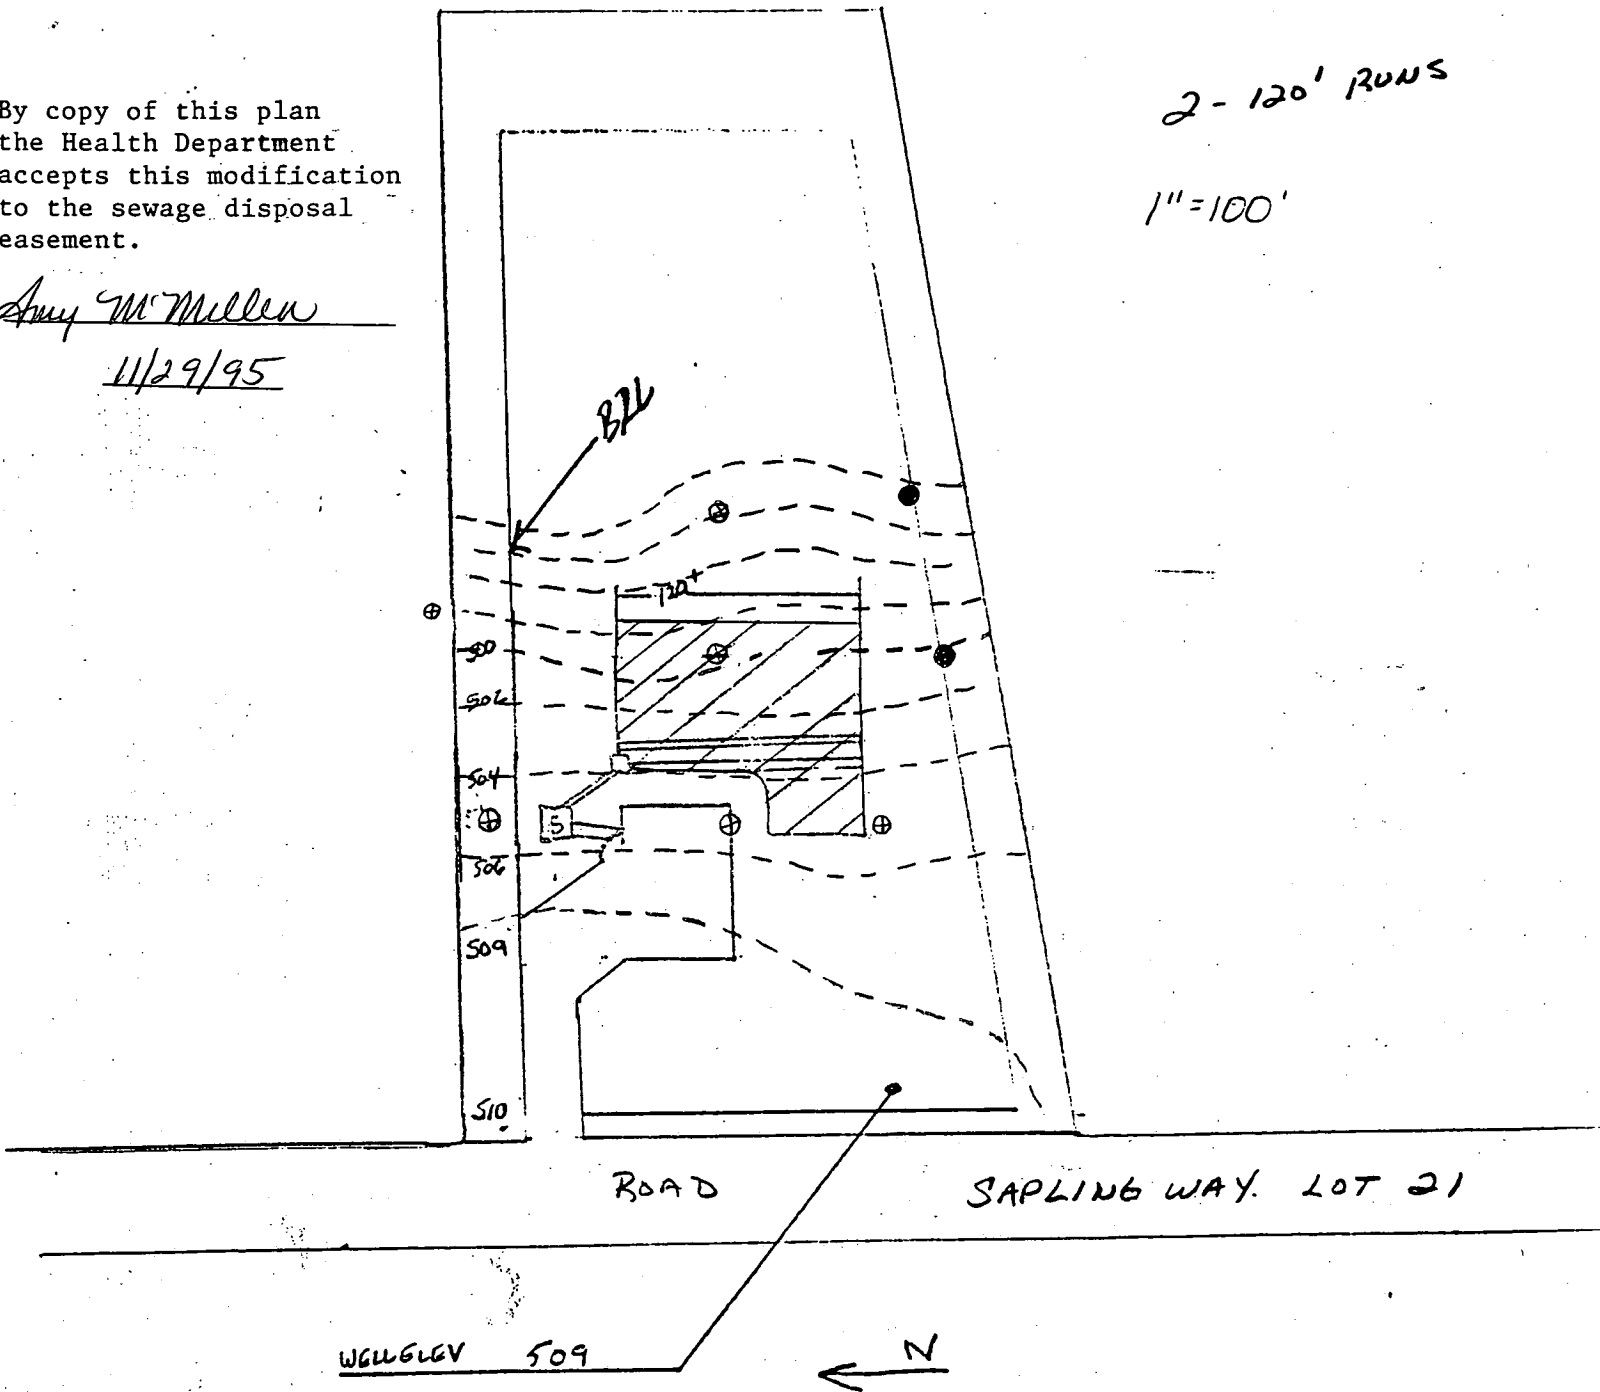

I certify that the above measurements are actual and correct for this property

Scott Meyers

- failed percolation tests
- ⊕ passed percolation tests

Approved Septic System Plan
Howard County Health Department

2 - 120' RUNS

Amy M. Miller 11/29/95
Signature Date

INV ELEV INTO
TRACH 502

INV ELEV INTO
DIST BOX 502.5

INV ELEV out of
SEPTIC TANK 502.9

INV ELEV INTO SEPTIC
TANK 503.2

INV ELEV out of
HOUSE 503.5

EXISTING ELEV AT TRACH.


504.5

EXISTING ELEV at DIST BOX

504.5

EXISTING ELEV AT SEPTIC
TANK 505

BE ELEV 505
FFELEV 509

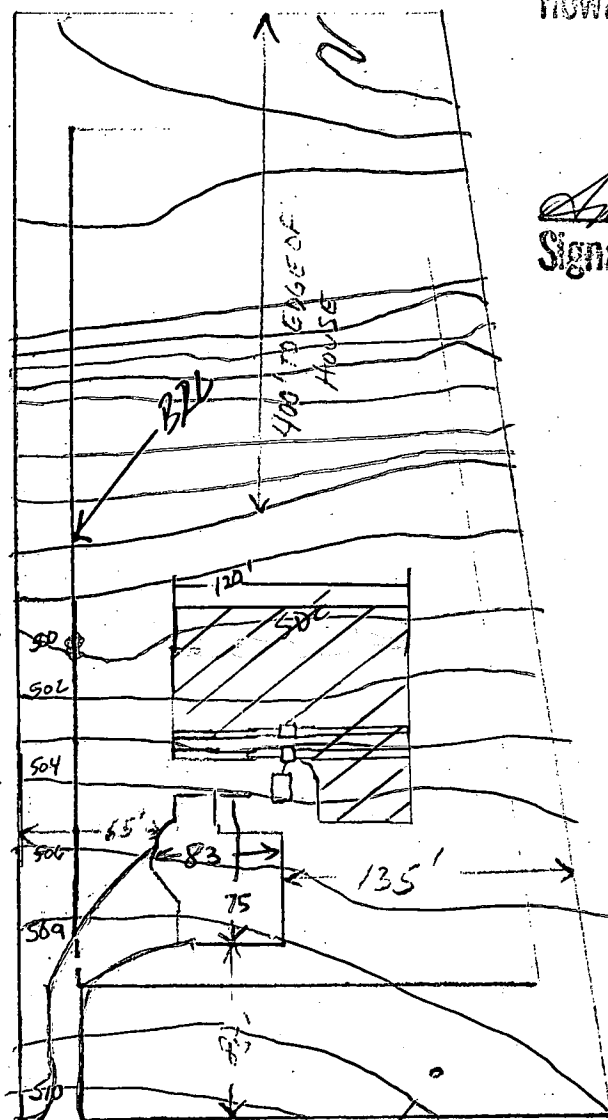

ROAD

SAPLING WAY LOT 21

WELL ELEV 509



I certify that the above measurements are actual and correct for this property

Scott Meyers

LOT 21
F89-231
~~WCD LOT 21~~
SAPLING WAY

SEE SHEET 71
L=311.53' R=42'

E 794500
N 513250

5 OF 9

LOT 20
4.086 AC±

SAPLING WAY
N27°43'42"V 305.96'
N27°43'42"V 305.96'
215.30'

LOT 21
3.360 AC±

LOT 22
4.002 AC±

LOT 23
3.013 AC±

MATCH LINE
S60°32'02"E 18.13'
L=317.78'
L=289.15'
N60°32'02"W 18.13'
L=21.03'

20' DRAIN. & UTIL. EASEMENT.


S27°22'05"E 399.76'
615.09'


N63°52'31"E 366.86'
B.R.L.

N61°12'13"E 569.26'
B.R.L.

S29°31'E 215.33'

N68°42'E

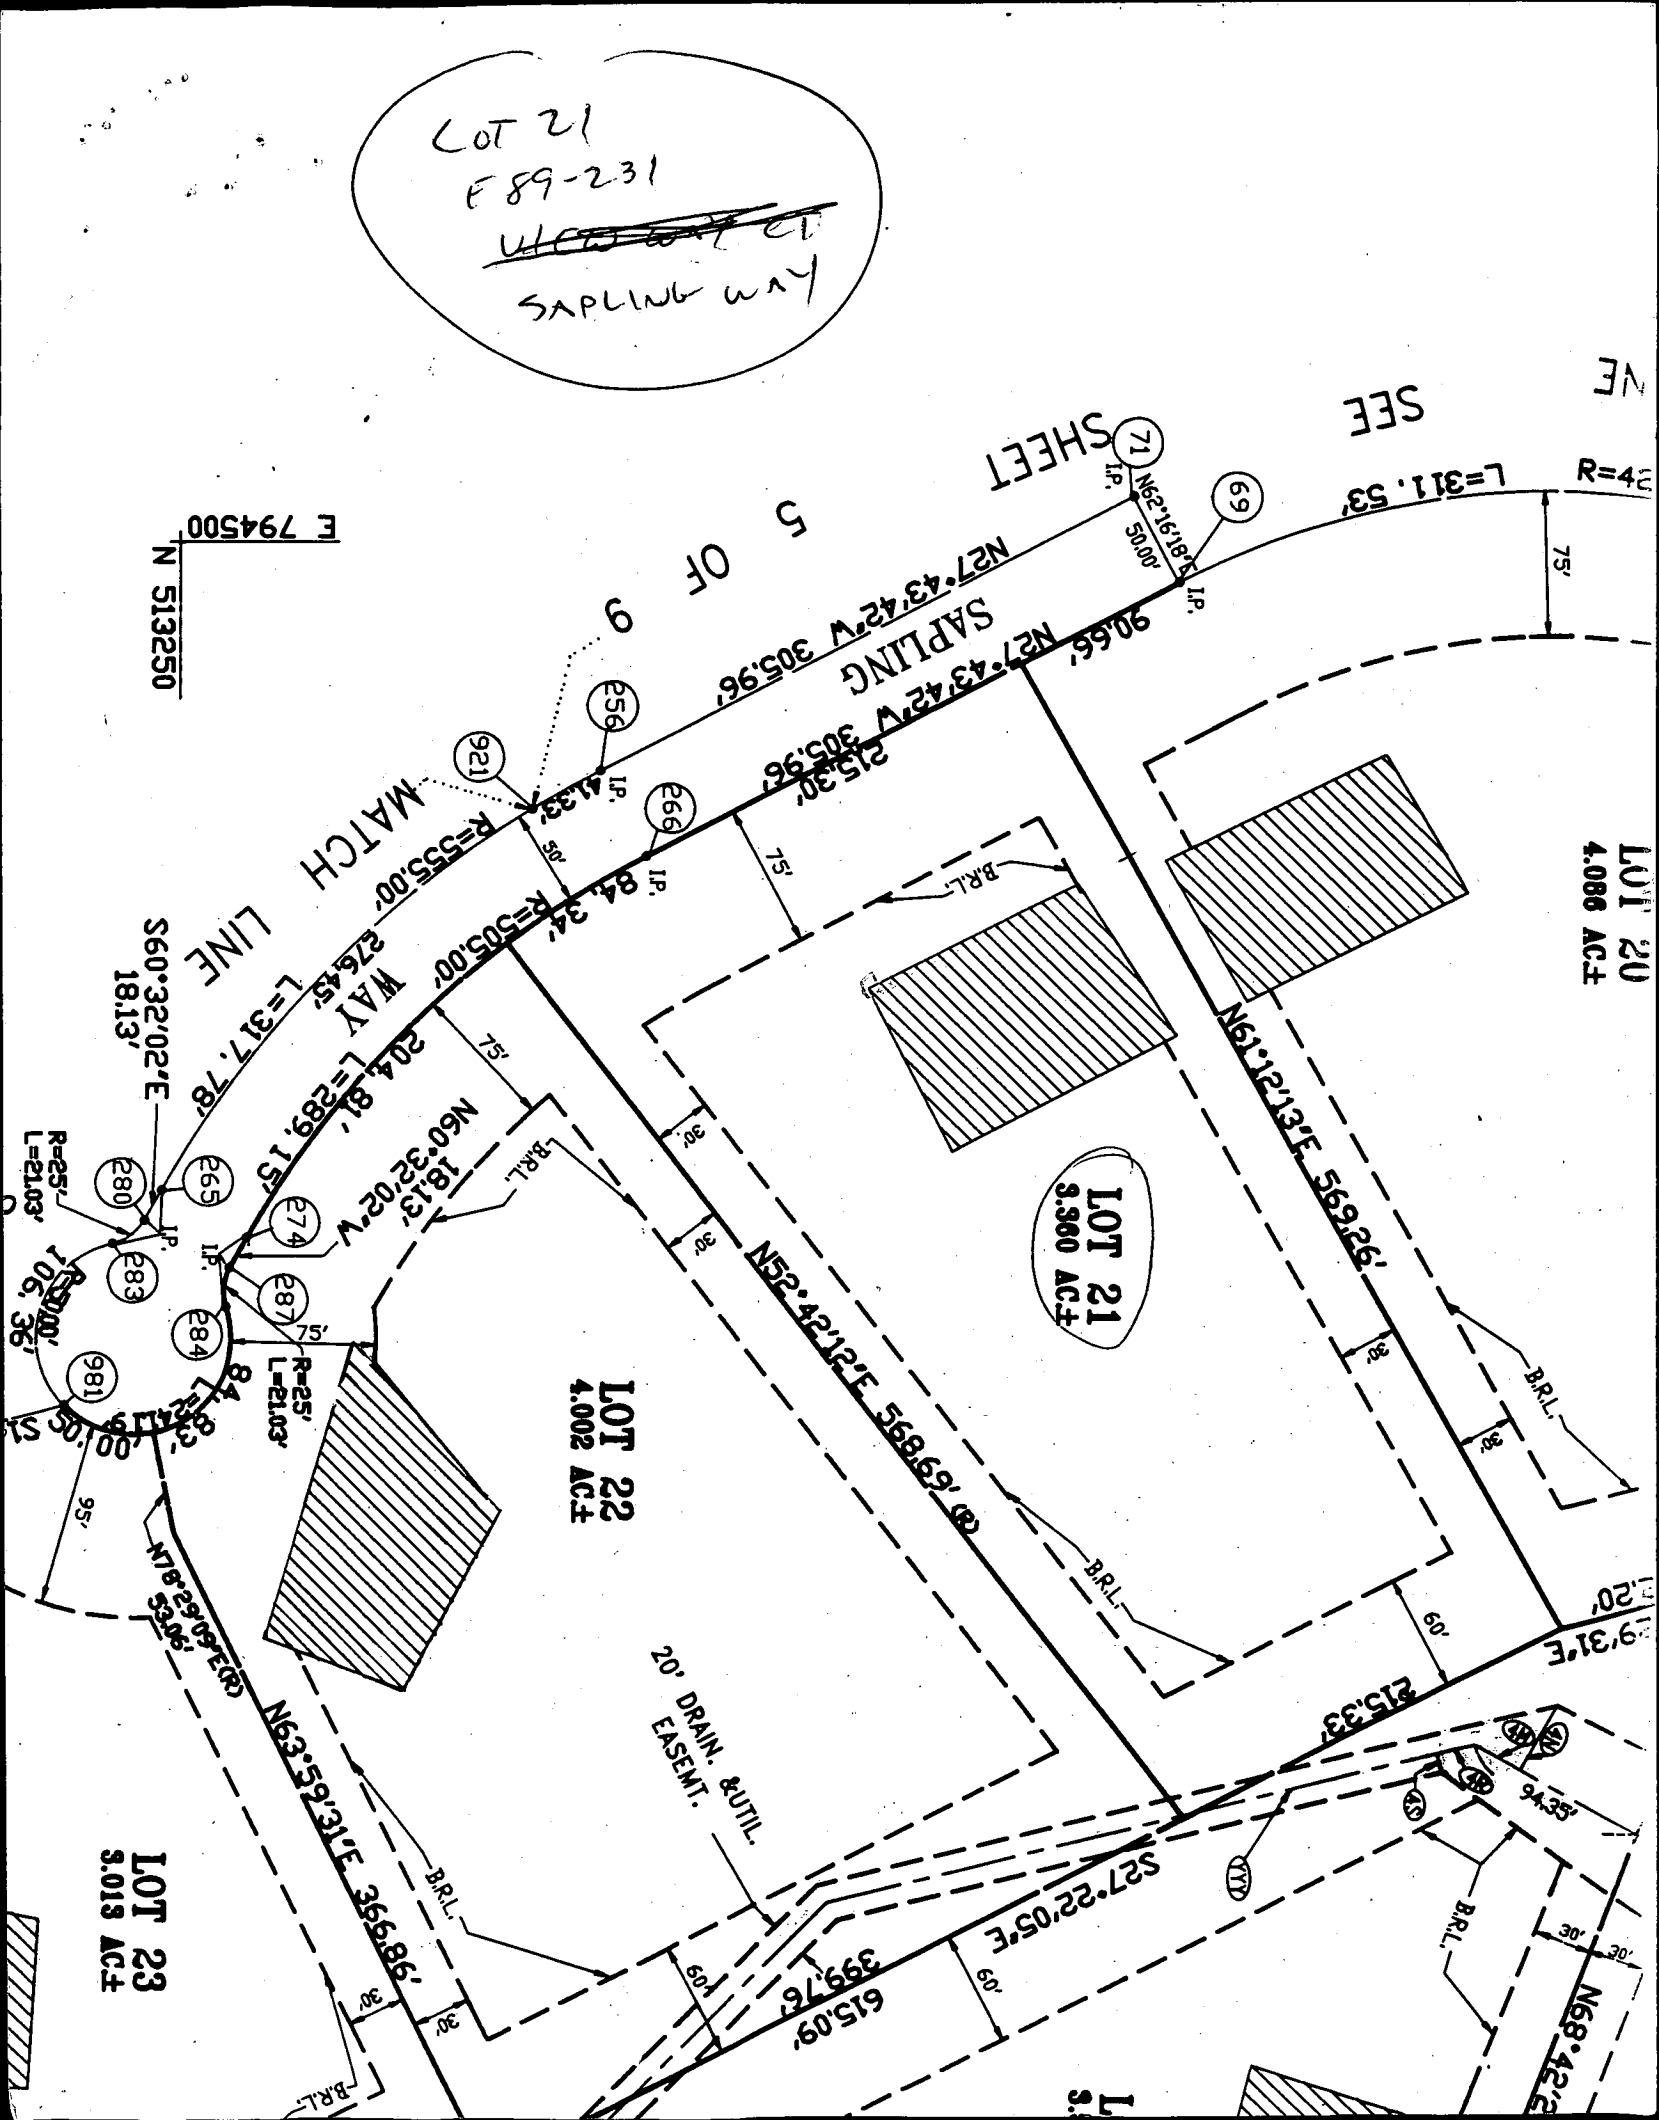

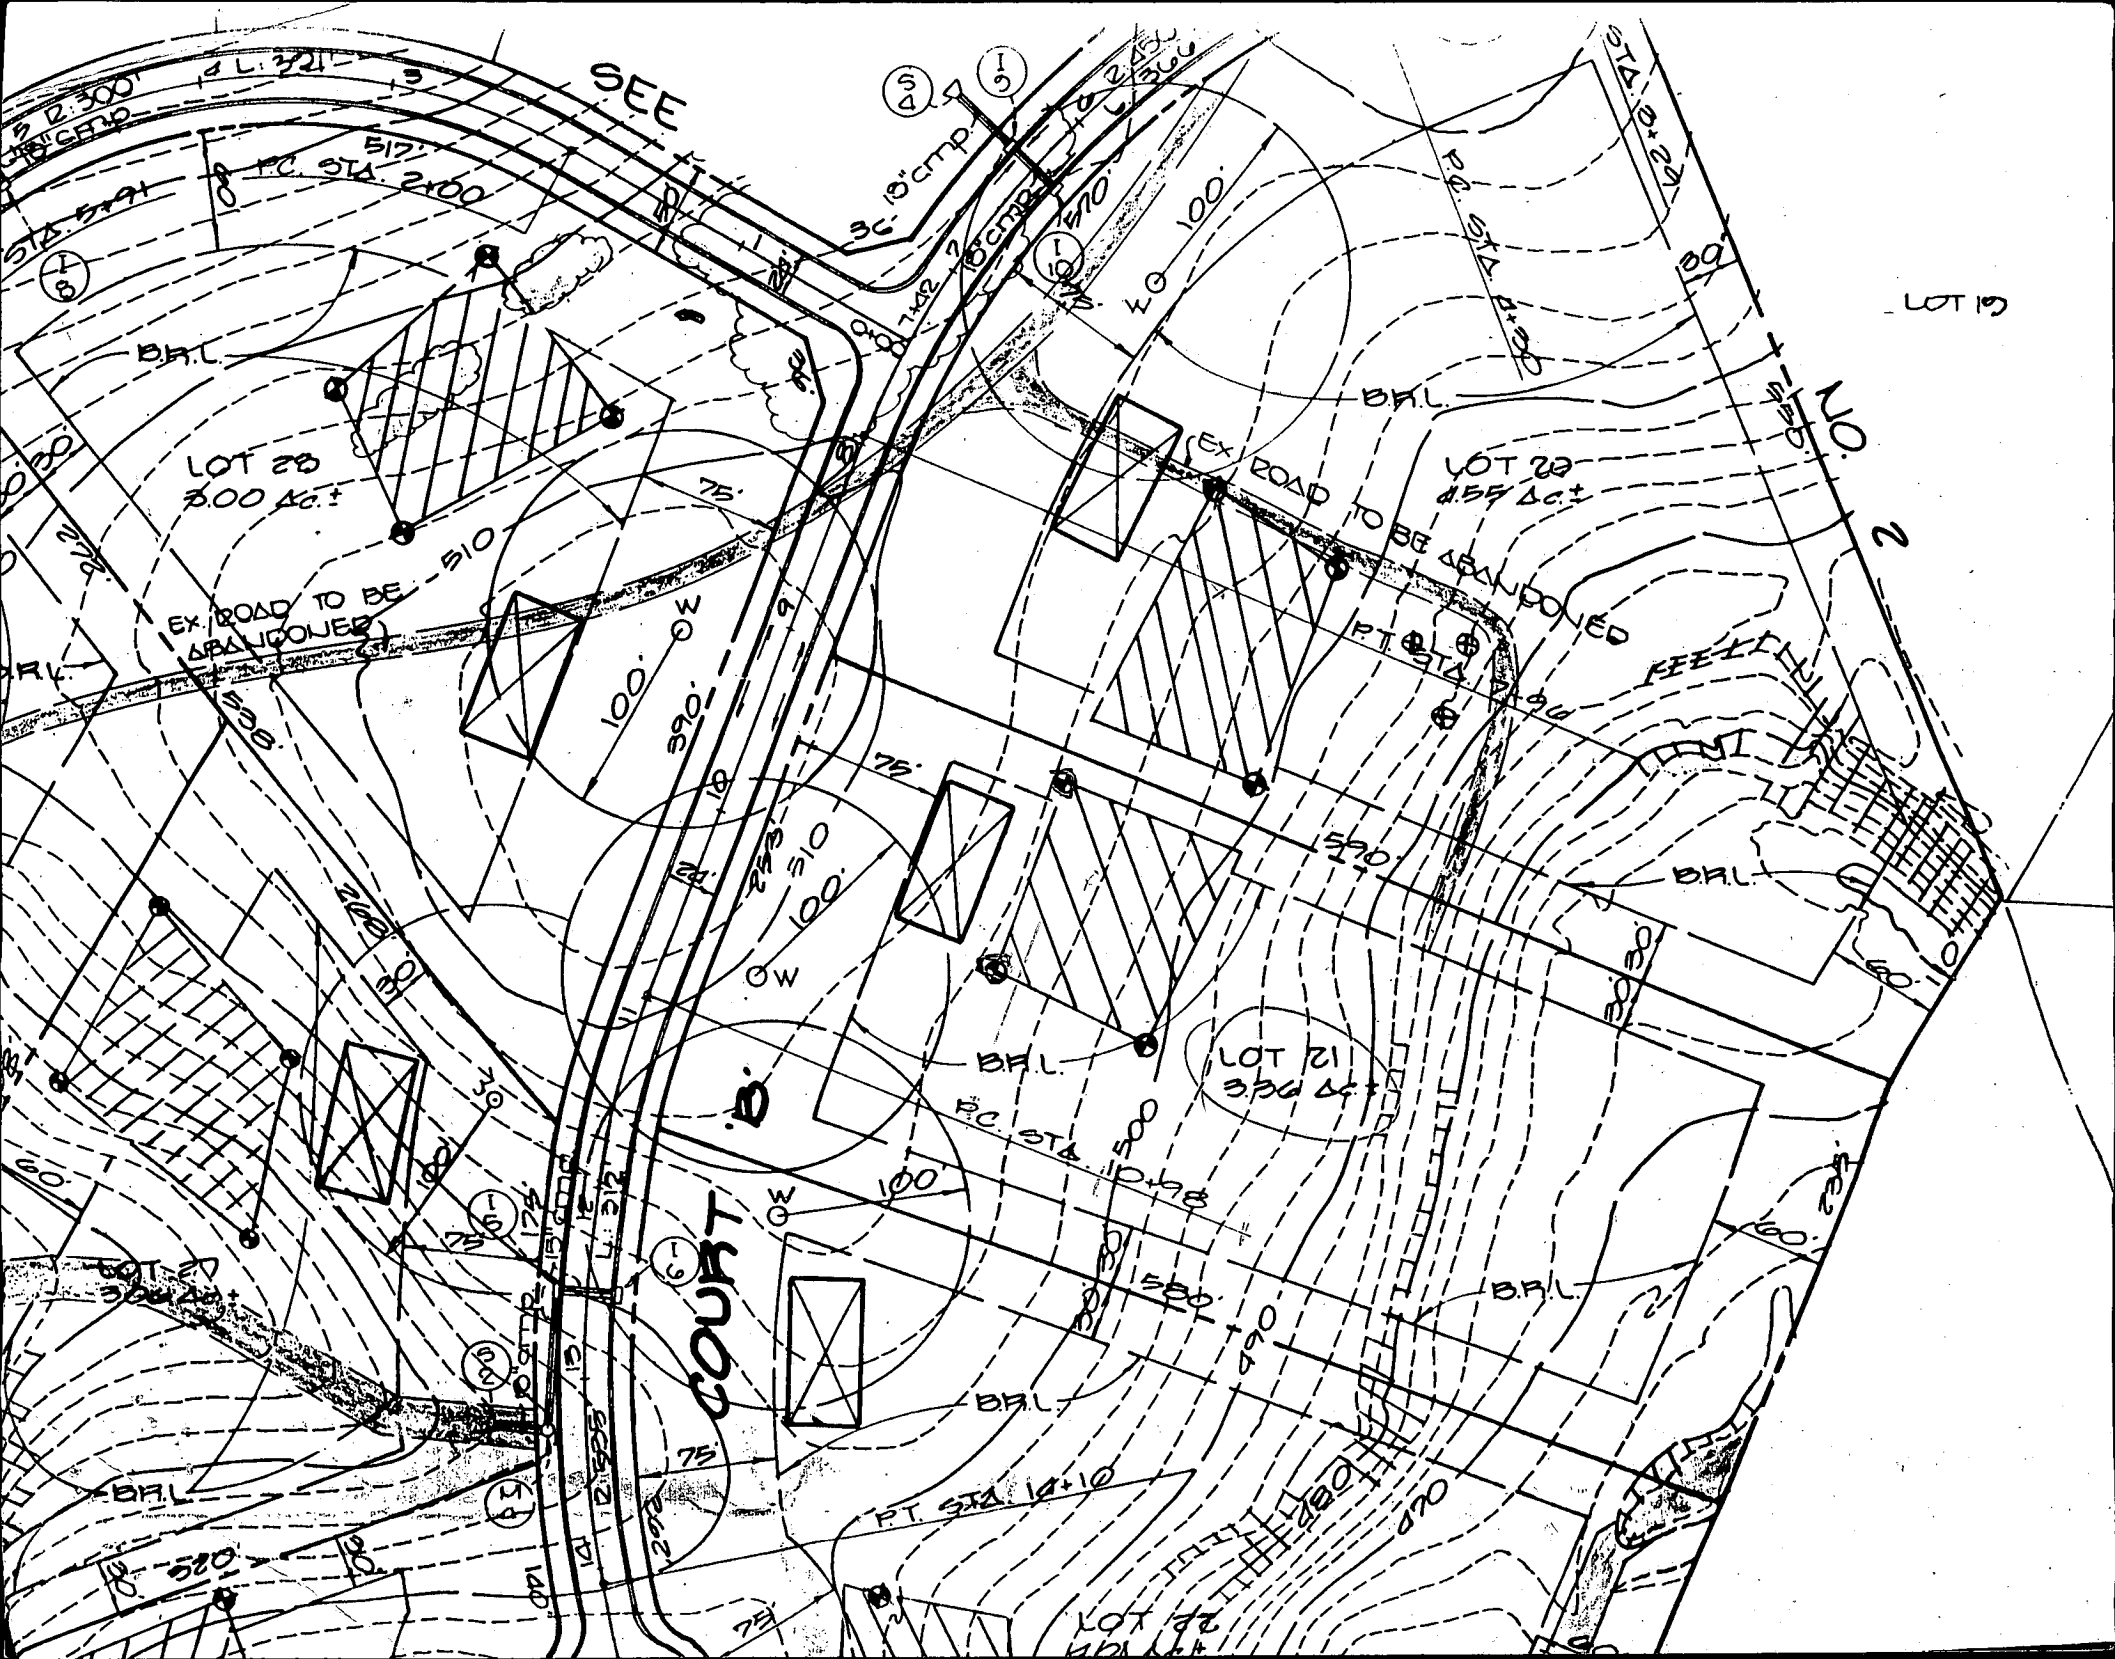

DEPARTMENT OF INSPECTIONS, LICENSES AND PERMITS 3430 COURT HOUSE DRIVE ELLICOTT CITY, MD 21043 PERMITS (410)313-2455 INSPECTIONS (410)313-1810 AUTOMATED INFORMATION (410) 313-3800	HOWARD COUNTY PERMIT APPLICATION	PERMIT NUMBER B00139248
---	-------------------------------------	----------------------------

Building Address <u>14813 SApLING WAY</u> <u>GLENEL MD 21737</u>	Property Owner's Name <u>SCOTT MYERS</u>
Suite/Apt. #: _____ SDP/WP/Petition #: _____	Address <u>14813 SApLING WAY</u>
Census Tract <u>65101</u> Subdivision <u>The Wainfield</u>	City <u>GLENEL</u> State <u>MD</u> Zip Code <u>21737</u>
Section _____ Area _____ Lot <u>21</u>	Home Phone <u>301-854-5158</u> Work Phone <u>301-</u>
Tax Map <u>37</u> Parcel <u>56</u> Grid <u>5</u>	Applicant's Name & Mailing Address, (if other than stated hereon):
Zoning <u>RC</u> Map Coordinates <u>27</u> Lot size <u>1301</u>	Phone <u>301-854-5158</u> Fax <u>301-481-2811</u>
Existing Use <u>STORAGE</u> <u>Single Family Home</u>	Contractor Company <u>OWLER</u>
Proposed Use <u>STORAGE / LIVING</u>	Contact Person <u>SCOTT MYERS</u>
Estimated Construction Cost \$ <u>100,000</u>	Address <u>14813 SApLING WAY</u>
Description of Work <u>FINISH 3/4 BASEMENT</u>	City <u>GLENEL</u> State <u>MD</u> Zip Code <u>21737</u>
<u>FIREPLACE INSERT / Bathroom, 2 bedrooms</u>	License No. _____
<u>3 BWS</u>	Phone _____ Fax _____
Occupant or Tenant <u>SCOTT MYERS</u>	Engineer or Architect Company <u>N/A</u>
Contact Name _____	Contact Person _____
Address _____	Address _____
City _____ State _____ Zip Code _____	City _____ State _____ Zip Code _____
Phone _____ Fax _____	Phone _____ Fax _____

BUILDING DESCRIPTION - COMMERCIAL		BUILDING DESCRIPTION - RESIDENTIAL	
Building Characteristics	Utilities	Building Characteristics	Utilities
Height: _____	Water Supply: _____ Public _____ Private _____	SF Dwelling ☒ SF Townhouse ☐	Water Supply: _____ Public _____ Private ☒
No. of stories: _____	Sewage Disposal: _____ Public _____ Private _____	1st floor: <u>73</u> <u>83</u>	Sewage Disposal: _____ Public ☒ Private ☒
Gross area, sq. ft. per floor: _____	Electric Yes ☐ No ☐	2nd floor: <u>73</u> <u>83</u>	Electric Yes ☐ No ☐
Use group: _____	Gas Yes ☐ No ☐	Basement: <u>73</u> <u>83</u>	Gas Yes ☐ No ☐
Construction type: _____ Reinforced Concrete _____ Structural Steel _____ Masonry _____ Wood Frame _____	Heating System: _____ Electric ☐ Oil ☐ Natural Gas ☐ Propane Gas ☐	Finished Basement ☒ Unfinished Basement ☐ Crawl space ☐ Slab on Grade ☒ No. of Bedrooms: _____	Heating System: _____ Electric ☐ Oil ☐ Natural Gas ☐ Propane Gas ☐
State Certified Modular _____	Sprinkler system: N/A ☐ Full _____ Partial _____ Other Suppression _____ # of Heads _____	Multi-family dwellings: No. of efficiency units: _____ No. of 1-BR units: _____ No. of 2 BR units: _____ No. of 3 BR units: _____	Sprinkler system: N/A ☐ NFPA #13D _____ NFPA #13R _____ Other: _____
		Other Structure: _____ Dimensions: _____ Footings: _____ Roof: _____	
		State Certified Modular _____ Manufactured Home _____	

THE UNDERSIGNED HEREBY CERTIFIES AND AGREES AS FOLLOWS: (1) THAT HE/SHE IS AUTHORIZED TO MAKE THIS APPLICATION; (2) THAT THE INFORMATION IS CORRECT; (3) THAT HE/SHE WILL COMPLY WITH ALL REGULATIONS OF HOWARD COUNTY WHICH ARE APPLICABLE THERETO; (4) THAT HE/SHE WILL PERFORM NO WORK ON THE ABOVE REFERENCED PROPERTY NOT SPECIFICALLY DESCRIBED IN THIS APPLICATION; (5) THAT HE/SHE GRANTS COUNTY OFFICIALS THE RIGHT TO ENTER ONTO THIS PROPERTY FOR THE PURPOSE OF INSPECTING THE WORK PERMITTED AND POSTING NOTICES.

<u>Scott Myers</u> Applicant's Signature	<u>SCOTT MYERS</u> Print Name
---	----------------------------------

Title/Company	Date
---------------	------

Checks payable to: **DIRECTOR OF FINANCE OF HOWARD COUNTY**
** PLEASE WRITE NEATLY AND LEGIBLY **

AGENCY	DATE	SIGNATURE APPROVAL	DPZ SETBACK INFORMATION	PROPERTY ID#
Land Development, DPZ			Front: _____	17474
State Highways			Rear: _____	Filing fee \$ _____
Building Official			Side: _____	Permit fee \$ _____
Dev. Engineering, DPZ			Side St: _____	Excise tax \$ _____
Health	<u>11/7/02</u>	<u>Kacie Noonan</u>	All minimum setbacks met? YES ☐ NO ☐	Add'l per. fee \$ _____
Fire Protection			Is Entrance Permit required? YES ☐ NO ☐	TOTAL FEES \$ _____
Is Sediment Control approval required prior to issuance? YES ☐ NO ☐			Historic District? YES ☐ NO ☐	Sub-total paid \$ _____
CONTINGENCY CONSTRUCTION START: ☐			Lot Coverage for New Town Zone _____	Balance due \$ _____
ONE STOP SHOP: ☐			SDP/Red-line approval date _____	Check # <u>11</u>
				Validation # _____
				Accepted by _____

92°22'05"E 215.33'

EASEMENT

60' DRL

30' DRL

30' DRL

LOT 21

3.360 AC±
PLAT # 9586


APPROVED

WALK-THRU BUILDING PERMIT

BP# BU149643 A# 40785

APP. SAN KJR DATE: 7/29/04

DESC. OF WORK: Shed

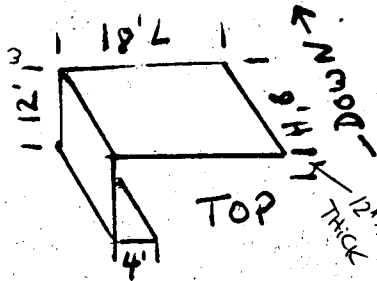

EXISTING PRIVATE SEWERAGE
DISPOSAL EASEMENT

TRENCHES

DISTRIBUTION BOX

TRENCHES

SEPTIC TANK

FF 515.00
DE 505.00

18' L x 12' W

x 8' H x

12" THICK

3000 PSI W #4

REBAR

FOOTINGS =

12'6" x 19' x 32"

12'6" x 19' x 32"

3600 PSI

SAPRY RAIL

50' R/W

N 27°43'42" W 215.30'

R=505.00'

L=84.34'