

Final
2:00pm

#349930

PERMIT

SEWAGE DISPOSAL SYSTEM

DEPARTMENT OF HEALTH AND MENTAL HYGIENE

HOWARD COUNTY HEALTH DEPARTMENT

BUREAU OF ENVIRONMENTAL HEALTH

~~XXXX-9933~~ 313-2640

INDEXED

P 49604

A 4086388

DISTRICT 4th

DATE 9/10/93

DATE SYSTEM APPROVED 9/16/93

INSPECTOR M. Rifkin

Fogle's Septic Clean Inc.

IS PERMITTED TO INSTALL X ALTER

ADDRESS 580 Obrecht Road, Sykesville, Maryland 21784 PHONE 795-5670

SUBDIVISION Foxmoor LOT 9 ROAD 17706 Quail Covey Court

PROPERTY OWNER Bill and Cathy Cappa

ADDRESS _____

SEPTIC TANK CAPACITY 1500 ~~1250~~ GALLONS TOP SEAMED TANK REQUIRED

NUMBER OF BEDROOMS 5

210 SQUARE FEET PER BEDROOM

LINEAR FEET OF TRENCH REQUIRED 280

TRENCHES - Trench to be 3 feet wide. Inlet 2 feet below original grade. Bottom maximum depth 4 feet below original grade. Effective area begins at 2 feet below original grade. 2 feet of stone below distribution pipe.

LOCATION - Place the distribution box 195 feet down the right lot line and 45 feet off that lot line. Trenches to follow contour toward right lot line only. (Right lot line as viewed from Quail Covey Court).

NOTES - No trench to exceed 100 feet in length. Provide 6" - 8" diameter cleanout and cap to grade or above on septic tank. OK MR 9/15/93

PLANS APPROVED BY Sid Abel

DATE 6/23/92

COVER NO WORK UNTIL INSPECTED AND APPROVED

NEITHER THE HOWARD COUNTY COUNCIL NOR THE HEALTH DEPARTMENT IS RESPONSIBLE FOR THE SUCCESSFUL OPERATION OF ANY SYSTEM

NOTE: CLEANOUT REQUIRED EVERY 70 FEET OF SEWER LINE AND/OR AT 90° SWEEPS IN LINES FROM HOUSE TO DRAIN FIELDS, 90° ELBOWS NOT ACCEPTABLE.

NOTE: ALL PARTS OF SEPTIC SYSTEMS (I.E. TANK, DISTRIBUTION BOX TRENCHES) TO BE 100 FEET FROM WELL (UNLESS OTHERWISE SPECIFICALLY AUTHORIZED)

NOTE: IF DEEP TRENCH(ES) ARE USED CALL FOR INSPECTION BEFORE AND AFTER PLACING GRAVEL IN TRENCH(ES)

NOTE: NO DRY WELL SHALL EXCEED 15 FOOT IN DIAMETER NO ABSORPTION TRENCH TO EXCEED 100 FEET IN LENGTH

NOTE: ALL PIPE FROM HOUSE TO SEPTIC TANK MUST BE CAST IRON OR SCHEDULE 35/40 PVC OR ABS


PERMIT VOID AFTER TWO YEARS

NOTE: INSTALL STAND PIPE ON SEPTIC TANK AND DRY WELL STAND PIPES MUST BE 6 INCHES IN DIAMETER CAST IRON. CONCRETE OR TERRA COTTA OR PVA OR ABS ACCEPTED. IF TOP OF SEPTIC TANK IS DEEPER THAN 3 FEET. MANHOLE TO GRADE REQUIRED.

NOTE: DISTRIBUTION BOXES MUST HAVE BAFFLES

***INSTALLER IS RESPONSIBLE FOR OBTAINING FINAL APPROVAL ON THIS PERMIT**

A
40863

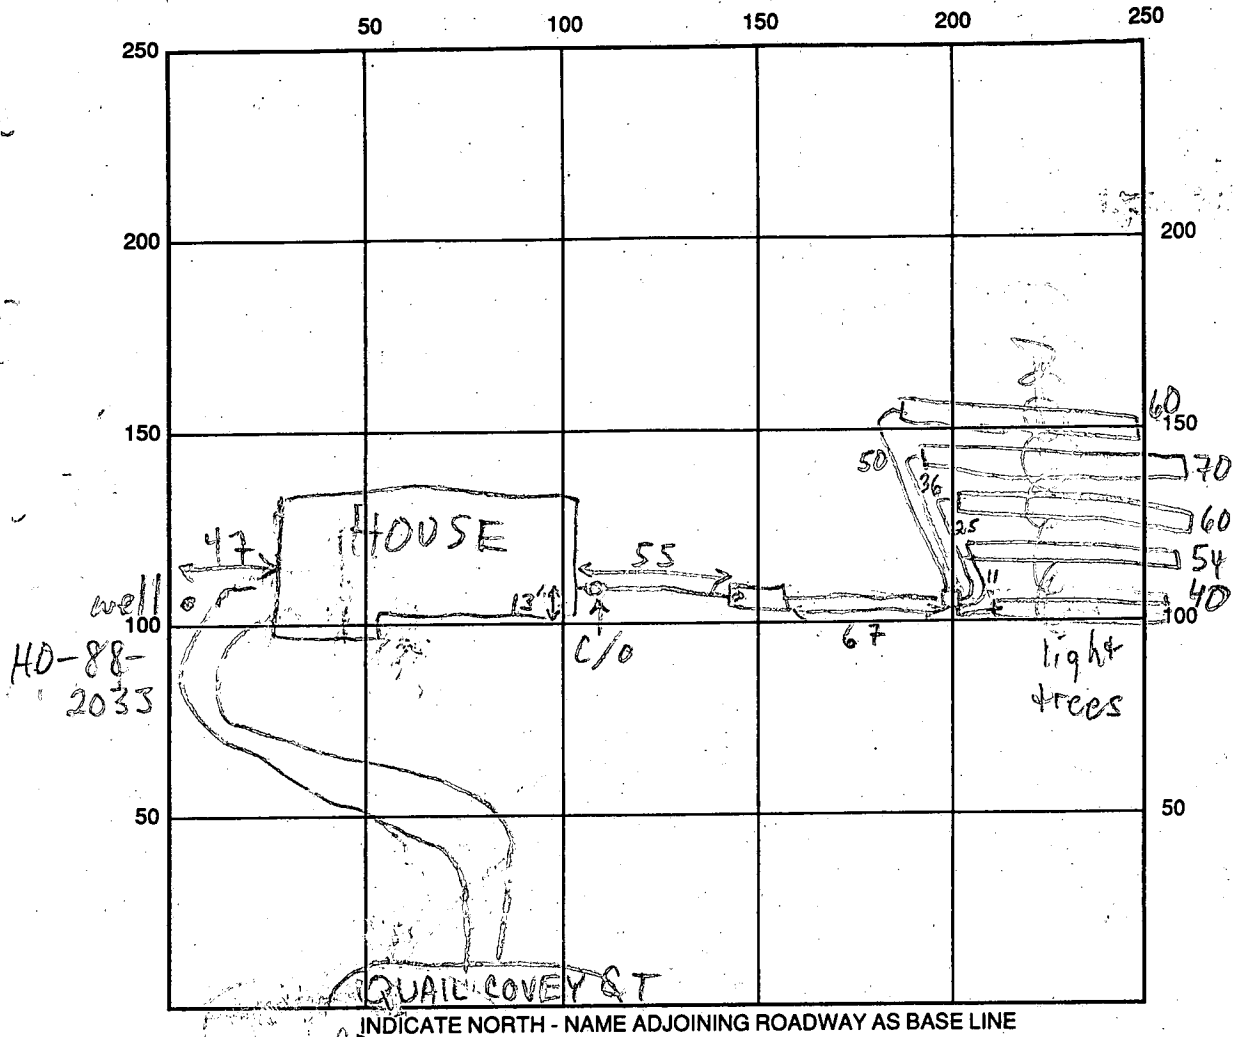

SEPTIC TANK LEVEL 1500 GAL - TOP SEAM - OK CLEANOUTS INLINE & S.T. - OK

DISTRIBUTION BOX LEVEL OK - RAFFLE 1W

DRAIN FIELD/TITLE DEPTH 4 FT. TRENCH WIDTH 3 FT. INLET DEPTH 2 FT.

EFFECTIVE GRAVEL DEPTH 2 FT. TOTAL LENGTH 040 054 060 070 060

NUMBER OF TRENCHES 5 ONE SIDEWALL/BOTTOM AREA 0120 0162 0180 0180 SQ. FT. 0210

DRYWALL INSIDE DIAMETER — FT. EFFECTIVE DEPTH BELOW INLET — FT.

ABSORBENT AREA 852 SQ. FT.

REMARKS: 9/16/93 OK TO COVER MR

5' DIA. AT 2' AP. RAFFLE
LINE & CLEANOUT - 1.6' DIA. 2.5' DIA. 1.5' DIA.

DATE SYSTEM APPROVED 9/16/93 INSPECTOR M. Riffin

APPLICATION

PERCOLATION TESTING

40863

A ~~40875~~

P _____

HOWARD COUNTY HEALTH DEPARTMENT
BUREAU OF ENVIRONMENTAL HEALTH
P.O. BOX 476 ELLICOTT CITY, MARYLAND 21043
TELEPHONE 461-9933

DISTRICT Fourth

DATE 12-15-87

TO: THE COUNTY HEALTH OFFICER
ELLICOTT CITY, MARYLAND

I HEREBY APPLY FOR THE NECESSARY TEST IN ORDER TO CONSTRUCT (OR RECONSTRUCT) A SEWAGE DISPOSAL SYSTEM.

PROPERTY OWNER Long Meadow Venturers Bill & Cathy Cappa

ADDRESS 7050 Oakland Mills Road Suite 100 PHONE 461-2898
301-290-9494

PROSPECTIVE BUYER Columbia, MD 21046

ADDRESS Attention: Mr. Earl Armiger PHONE _____

PROPERTY LOCATION:

SUBDIVISION Foxmoor LOT NO. LOT 9 Preliminary 22 (10/22 old)

ROAD AND DESCRIPTION End of Timberleigh Way (17706 Quail Covey Ct)

TAX MAP 12 PARCEL # 16

SIZE OF LOT 3.0 Acres TYPE BLDG Single Family
(SINGLE FAMILY DWELLING OR COMMERCIAL)

BLDG. PERMIT SIGNED
AND RETURNED 8/16/88
Serial # 50057-SFD-4Bomo

THE SYSTEM INSTALLED UNDER THIS APPLICATION IS ACCEPTABLE ONLY UNTIL PUBLIC FACILITIES BECOME AVAILABLE. I FULLY UNDERSTAND THE

FEE CONNECTED WITH THE FILING OF THIS PERC TEST APPLICATION IS NON-REFUNDABLE UNDER ANY CIRCUMSTANCES. I ALSO AGREE TO COMPLY

WITH ALL M.O.S.H.A. REQUIREMENTS IN TESTING THIS LOT. Jeffrey E. Frank
(SIGNATURE OF APPLICANT)

APPROVED BY Sid Abel FOR Standard Trust DATE 2-21-89

REJECTED BY _____ FOR _____ DATE _____

HOLD PENDING FURTHER TESTS _____ DATE _____


REASONS FOR REJECTION OR HOLDING 3-8-88 Perc Satisfactory. Hold for DEAT SAG

Shallow Syst. Top Section Septic Tank; Perce Tank in High hole of Rose Field. (SA) 6-8-88 Perc holes to add Area or Subdivide Further. SAG

THIS IS NOT A PERMIT

SOIL PROFILE

1 AP
Yell Br clay Lm. 20-25% Frag
4" Yell Br to brown silt Lm. 35-45% Frag
50%~ Hole 2 at 11"

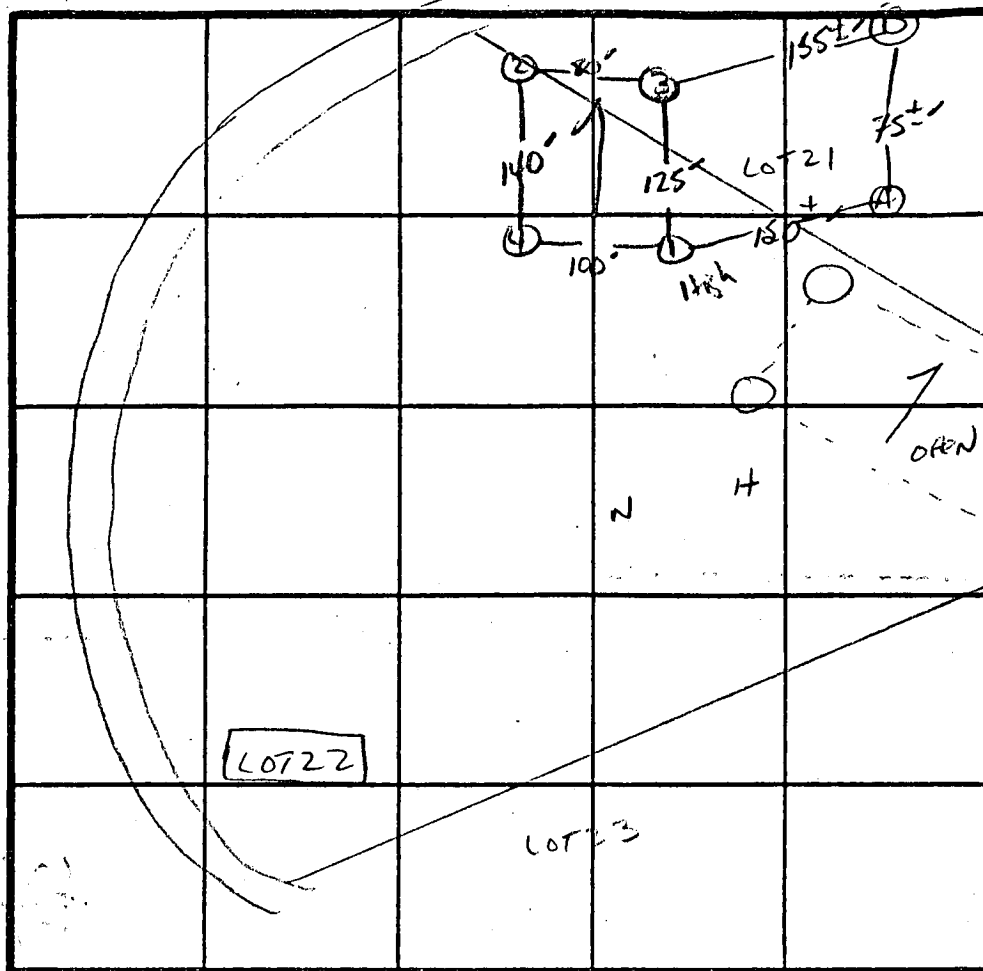

X Perc 7 min
180 #/BR
Inlet 3'
Bottom 8' 5.0'
3' wide.

X = LOT 10

XX = LOT 9
XX

INDICATE NORTH - NAME ADJOINING ROADWAY AS BASE LINE.

FLORENCE

DATE	TEST NO.	DEPTH	PRE-WET		TEST - 1" DROP		TIME
			START	STOP	START	STOP	
3/4/68	XX 1 S	4.5'	3:06	3:07	3:07	3:11	4 min
	XX 1 M	8.0'	2:59	3:02	3:02	3:09	7 min
	XX 1 V	11'	HAND BOTTOM				
	XX 2 S	5'	2:35	2:37	2:37	2:41	4 min
	XX 2 M	8'	2:37	2:43	2:43	2:55	12 min
	XX 2 V	12'	See photo file				
	XX 3 S	4.5'	2:44	2:46	2:46	2:51	5 min
	XX 3 M	8.5'	2:44	2:49	2:49	2:55	6 min
	XX 3 V	11.5'	Same as # 2				
	XX 4 S	4'	3:12	3:14	3:14	3:19	5 min
	XX 4 M	7.5'	3:13	3:15	3:15	3:19	4 min
	XX 4 V	11'	HAND BOTTOM - MASSIVE AT 10"				
6/4/68	X A S (12')	4'	2:00	2:02	2:02	2:06	4 min
	X A M	8'	2:02	2:03	2:03	2:06	3 min
	X 6 V	12'	uniform soil below 3.0'				

REMARKS: Water table 7' below ground - Shallow SPT. only

TYPE OF SOIL: M4 A-4

TESTED BY: S. Abel

ALSO PRESENT: Kenny - Dave

APPLICATION

PERCOLATION TESTING

A 40863

P _____

HOWARD COUNTY HEALTH DEPARTMENT
BUREAU OF ENVIRONMENTAL HEALTH
P.O. BOX 476 ELLICOTT CITY, MARYLAND 21043
TELEPHONE: 461-9933

DISTRICT Fourth

DATE 12-15-87

TO: THE COUNTY HEALTH OFFICER
ELLICOTT CITY, MARYLAND

I HEREBY APPLY FOR THE NECESSARY TEST IN ORDER TO CONSTRUCT (OR RECONSTRUCT) A SEWAGE DISPOSAL SYSTEM.

PROPERTY OWNER Long Meadow Venturers

ADDRESS 7050 Oakland Mills Road Suite 100 PHONE 301-290-9494

PROSPECTIVE BUYER Columbia, MD 21046

ADDRESS Attention: Mr. Earl Armiger PHONE _____

PROPERTY LOCATION:

SUBDIVISION Foxmoor LOT NO. 10 Perc area 2 AT CORNER

ROAD AND DESCRIPTION End of Timberleigh Way

TAX MAP 12 PARCEL # 16

SIZE OF LOT 3.0 Acres TYPE BLDG Single Family
(SINGLE FAMILY DWELLING OR COMMERCIAL)

THE SYSTEM INSTALLED UNDER THIS APPLICATION IS ACCEPTABLE ONLY UNTIL PUBLIC FACILITIES BECOME AVAILABLE. I FULLY UNDERSTAND THE FEE CONNECTED WITH THE FILING OF THIS PERC TEST APPLICATION IS NON-REFUNDABLE UNDER ANY CIRCUMSTANCES. I ALSO AGREE TO COMPLY WITH ALL M.O.S.H.A. REQUIREMENTS IN TESTING THIS LOT.

Jeffrey E. Frank, Agent
(SIGNATURE OF APPLICANT)

APPROVED BY _____ FOR _____ DATE _____

REJECTED BY _____ FOR _____ DATE _____

HOLD PENDING FURTHER TESTS _____ DATE _____


REASONS FOR REJECTION OR HOLDING 3-1-88 SHALLOW DEPTH TO FRACTURED ROCK; RAPID PERC TIMES EXCEPT HOLE 4; CLAYS TO 4' FT. INSUFFICIENT AREA AROUND GOOD HOLE TO ESTABLISH PERC AREA OF 10K GPH. 5. APR 3-9-88 REMAINS UNSATISFACTORY
S. Bull

HD-216

THIS IS NOT A PERMIT

④
SOIL PROFILE

AD
4-11 Bn C. 100% 15-25% Silt
4-11 Bn Silt Lm. 35-45% Silt

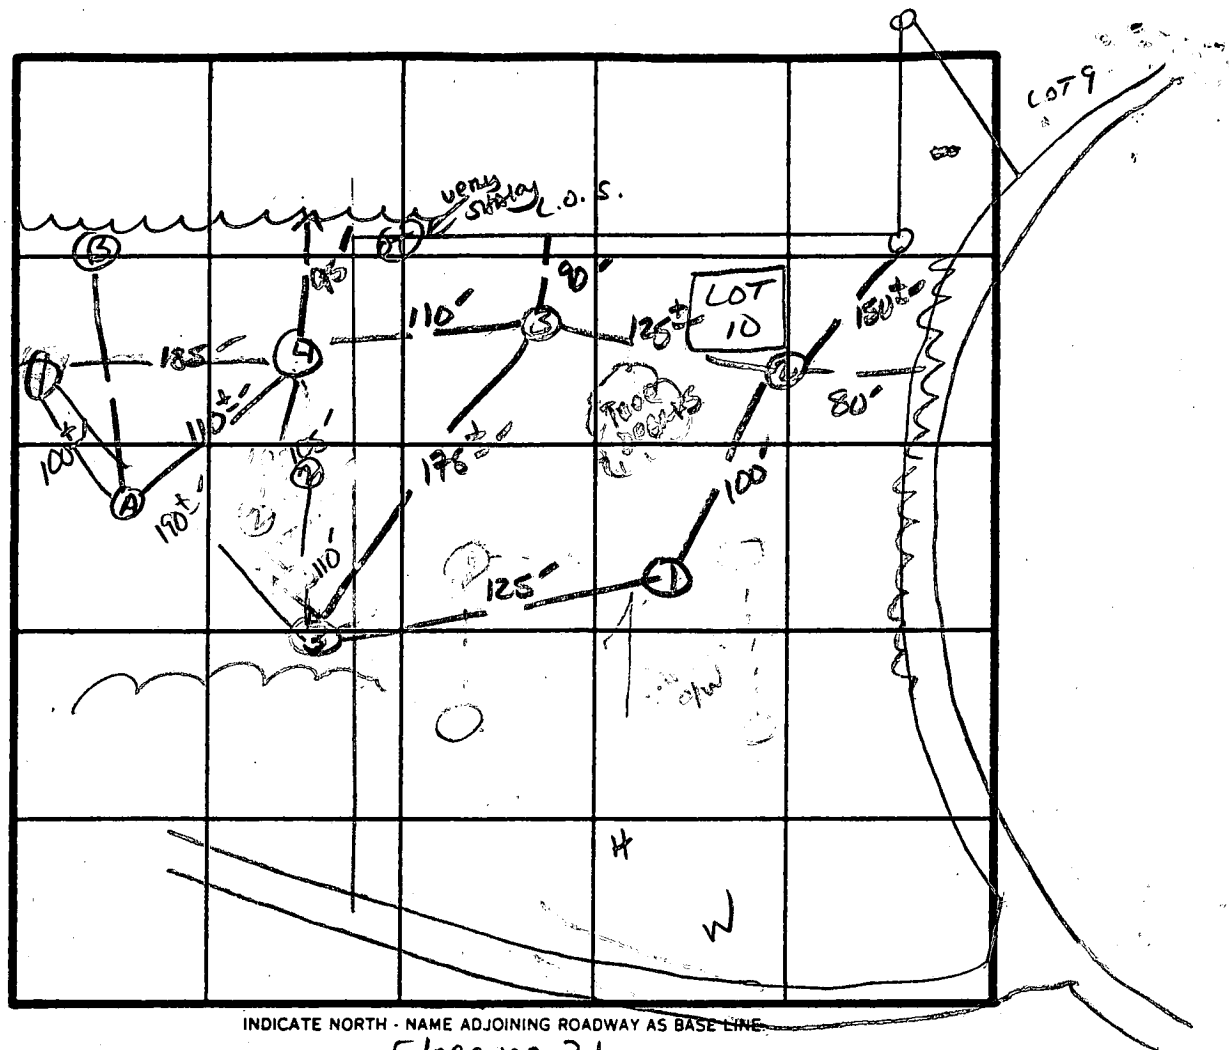

INDICATE NORTH - NAME ADJOINING ROADWAY AS BASE LINE

Florence Rd.

DATE	TEST NO.	DEPTH	PRE-WET		TEST - 1" DROP		TIME
			START	STOP	START	STOP	
3/1/68	1M	4.5" CANNOT DIS	3:18:10 POT HOLE	3:20:25 3.0"	3:30:25 STRUCTURED	3:30:45 MASSIVE AT	20 sec. 5.0"
	2M	7.5" CLAY	2:37:55 4-4.5"	2:39:05 MASSIVE SHALE	2:38:05 4-7.5"	2:38:15 10 sec.	
	3M	7.5"	3:43	3:44	3:44	3:47:10	3 min 10 sec.
		LESS SHALE	NO MASSIVE / STRUCTURE		40-50% FRAGS		
	4M	8"	3:51:30	3:55	3:55	4:02	7 min
			3:49:40	3:53:30	3:53:30	3:59:40	6 min 10 sec.
	4V	12"	↑ only good hole		↑		
3/9/68	AV	STRUCTURED SHALE AT 6"					

REMARKS

NOT RE PLAT

TYPE OF SOIL

MT Mm

TESTED BY

S. Abel

APPROVED SEPTIC ALGA IS BASED ON
TEST LOCATION #4 THIS SHEET PLUS

PASSED TESTS ON ADJACENT LOTS - PRINCIPALLY
#2 & #3 FROM LOT 11 - A40874

ALSO PRESENT


D. H. P. KINS

PAUL B.

Lot 11
Foxmoon
A40874

SOIL PROFILE

AP
4" Yellow BA CLAY Lm 20-25% SHARP FRAGS
4" Yellow BA TO BR. Silt Lm 25-35% FRAGS

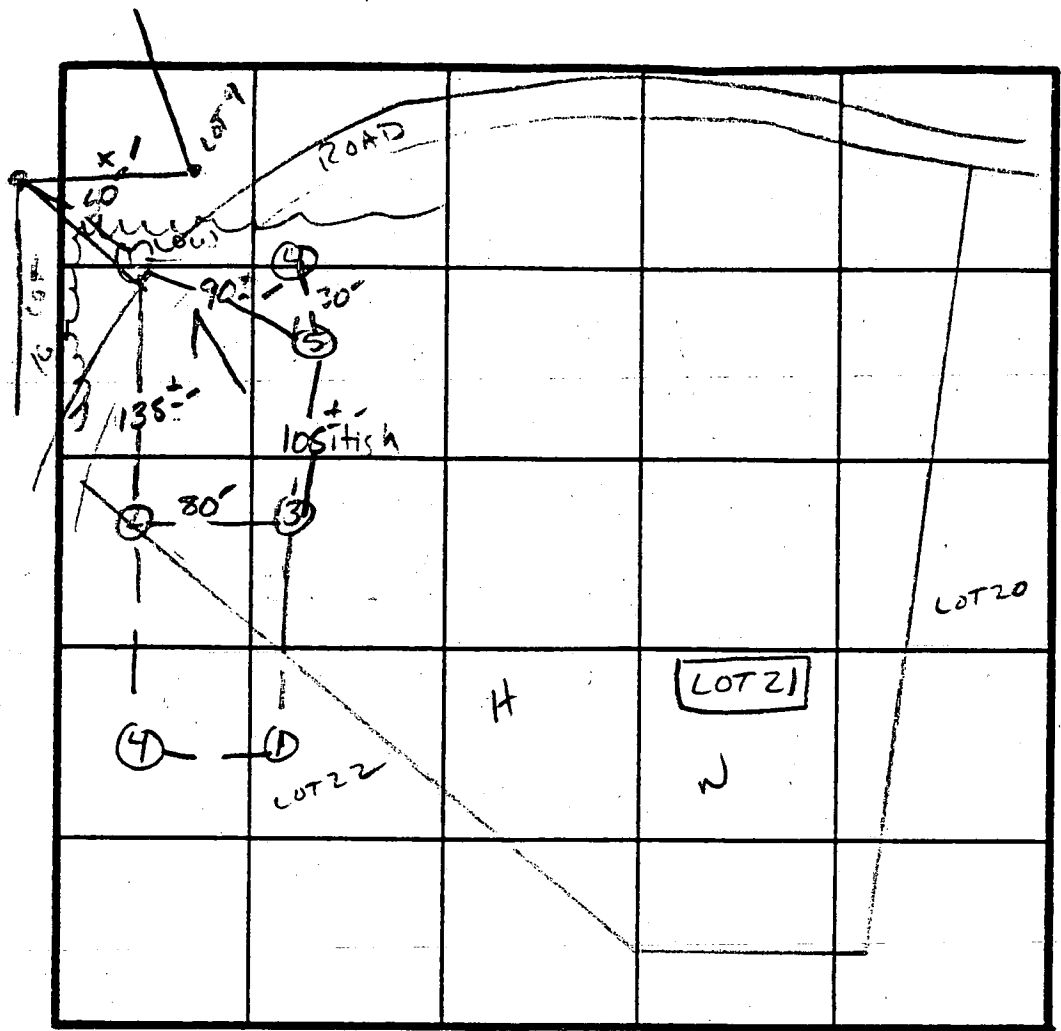

X PERC 9min
196 #1 BR
210
Inlet 3.5
Bottom 6.5
3' wide

INDICATE NORTH - NAME ADJOINING ROADWAY AS BASE LINE.

FLORENCE Rd.

DATE	TEST NO.	DEPTH	PRE-WET		TEST - 1" DROP		TIME
			START	STOP	START	STOP	
3/8/88	1 S	4.5'	2:30	2:35	2:35	2:49	14 MIN
	1 M	9.5'	2:31	2:35	2:35	2:45	10 MIN
	1 V	13'	UNIFORM below 4'				
	2 S	5'	2:35	2:37	2:37	2:41	4 MIN
	2 M	8'	2:37	2:43	2:43	2:55	12 MIN
	2 V	12'	SIMILAR TO #1 MORE COARSE FRAGS AT 11-12' 40-50%				
	3 S	4.5'	2:44	2:46	2:46	2:51	5 MIN
	3 M	8.5'	2:44	2:49	2:49	2:55	6 MIN
	3 V	11.5'	See Profile				
	4 V	5' UNIFORM AT 6.5'					
	5 S	4'	2:48	2:52	2:52	2:59	7 MIN
	5 M	8.5'	2:53	2:59	2:59	3:07	8 MIN
	5 V	11'	SAME AS #2				


② ③
AP
4" Yellow BA
CLAY Lm
20-25%
FRAGS
4" Yellow BA
TO BROWN
Silt Lm
25-35%
FRAGS
50% - 100%
A-11"

#2 + 3
TESTED FOR LOT 11
ALSO REPRESENTATIVE
OF APPROX 5600 AC
ON LOT 9.

REMARKS Holes DIFF THAN PLAT - Shallow syst only

TYPE OF SOIL mt Any MASH

TESTED BY J. Perl ALSO PRESENT Kenny Lane

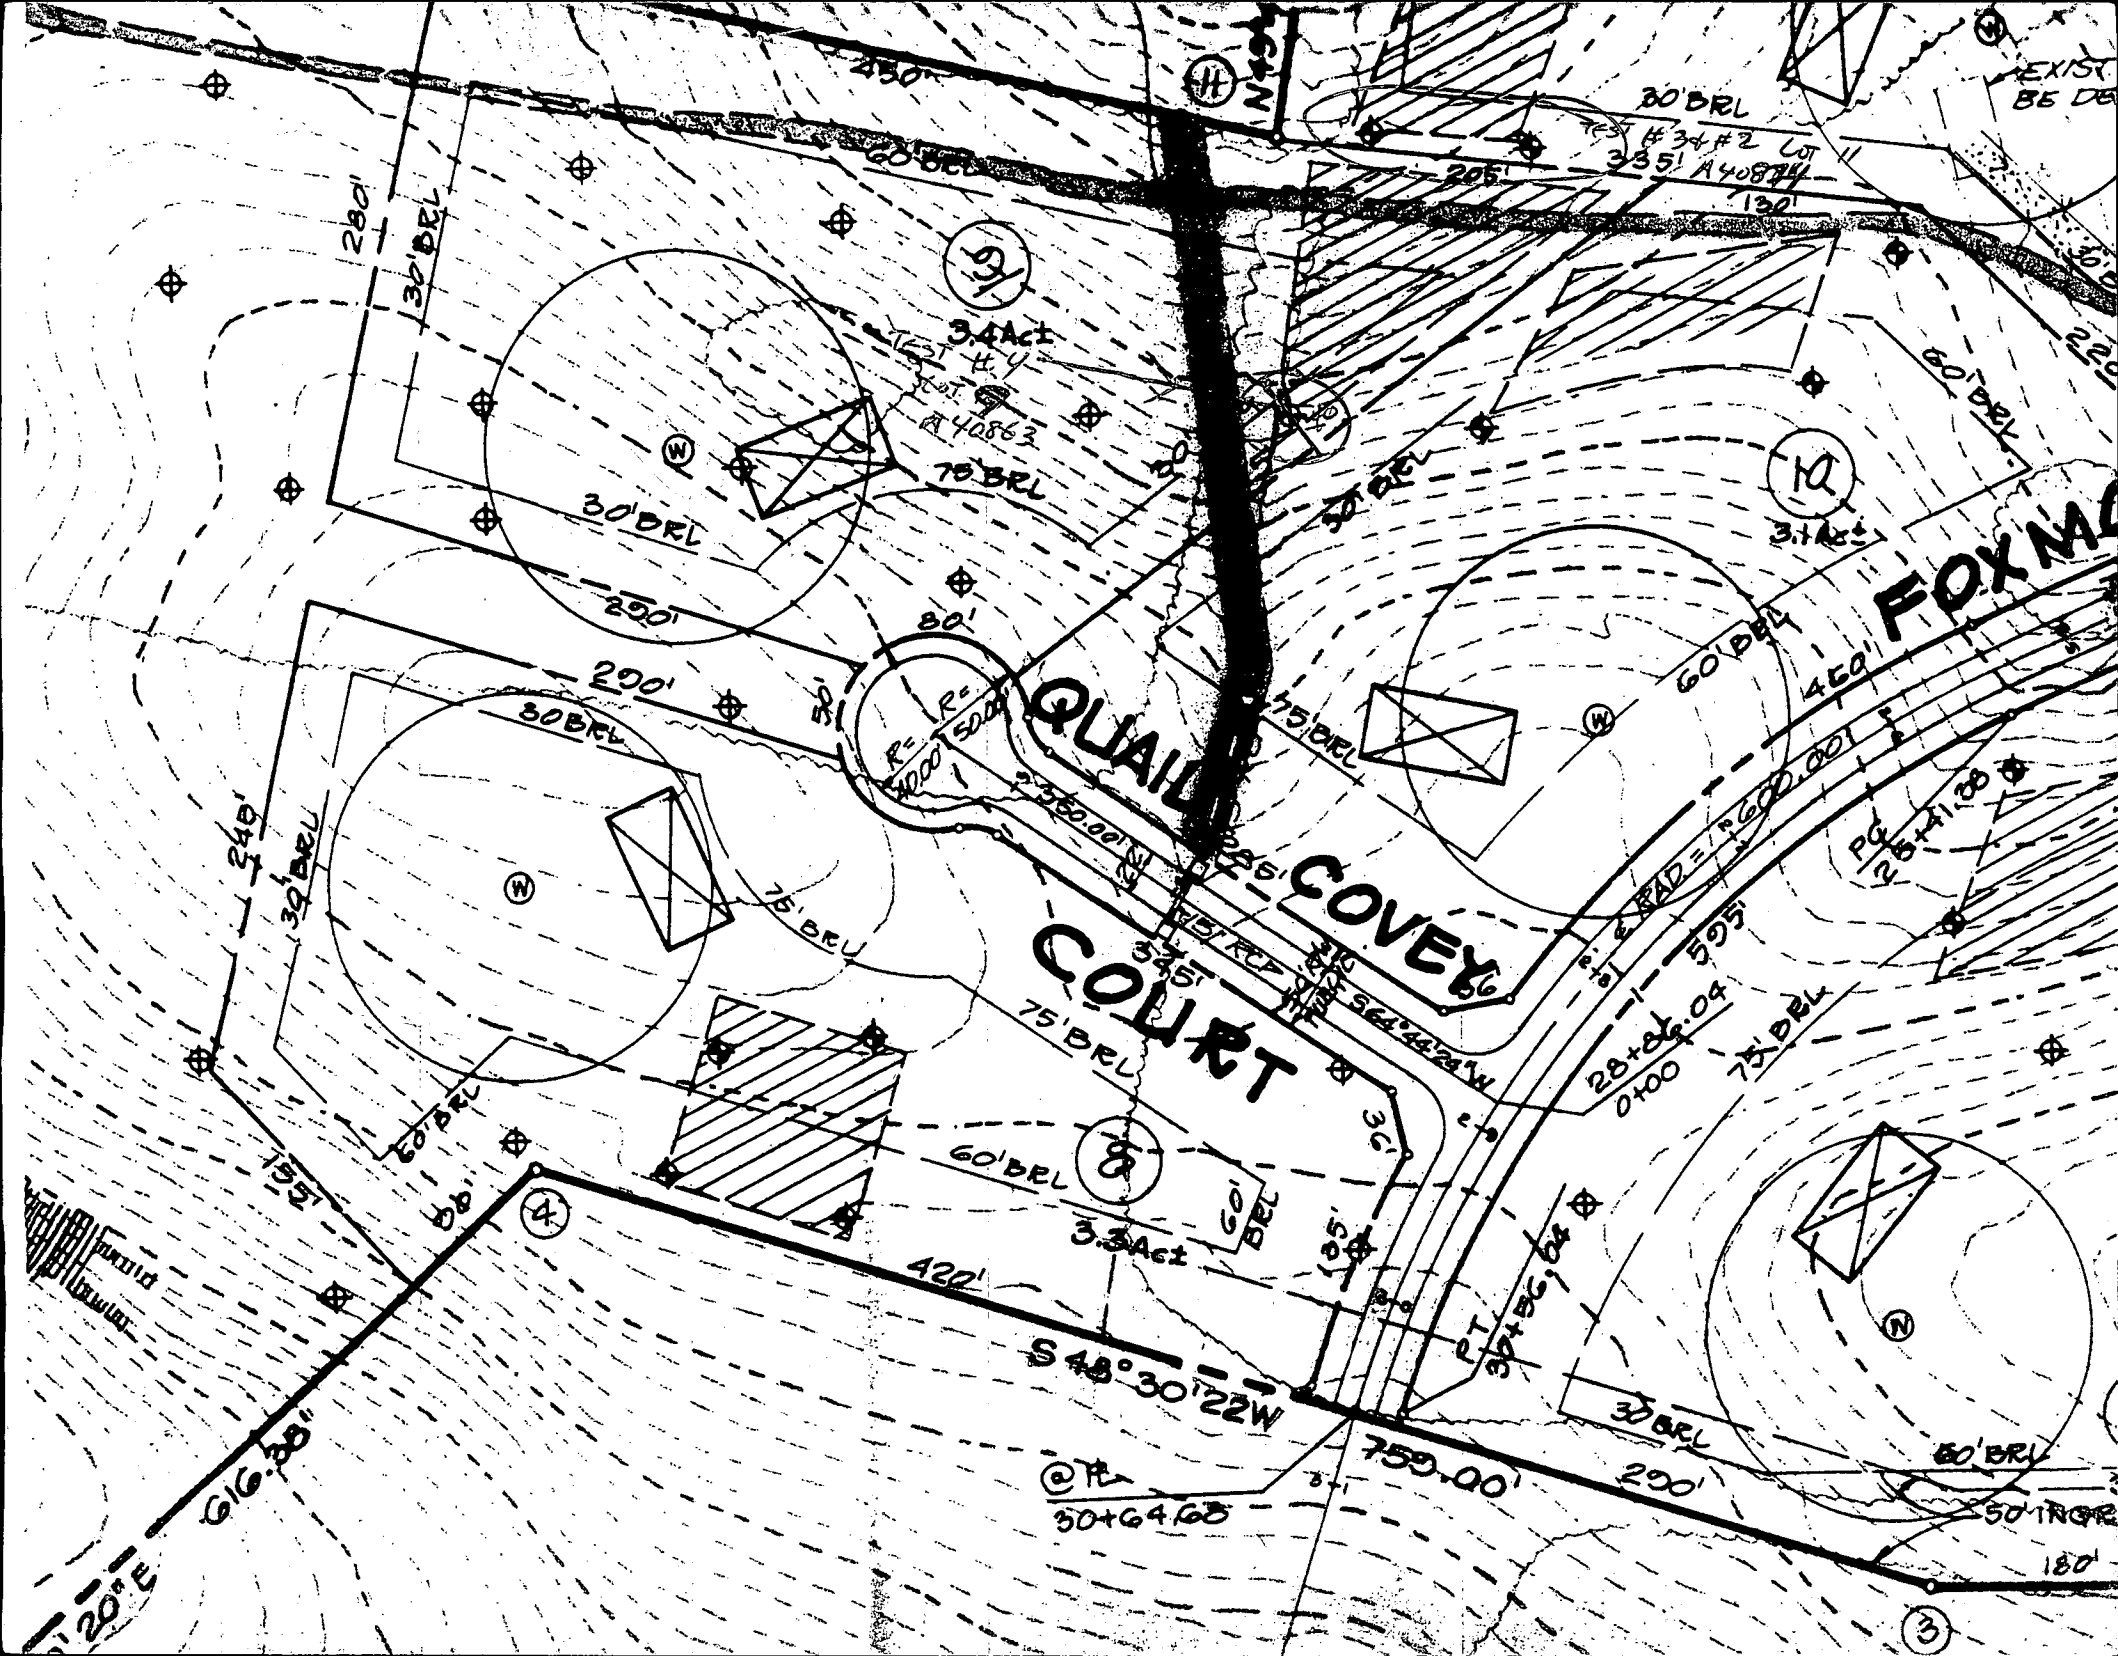

C1 5110 SEQUENCE NO. (DENV USE ONLY)
1 2 3 4 5 6
(THIS NUMBER IS TO BE PUNCHED
IN COLS. 3-6 ON ALL CARDS)

STATE OF MARYLAND
WELL COMPLETION REPORT
FILL IN THIS FORM COMPLETELY
PLEASE PRINT OR TYPE

THIS REPORT MUST BE SUBMITTED WITHIN
45 DAYS AFTER WELL IS COMPLETED.

COUNTY NUMBER A 40863

ST/CO USE ONLY
DATE Received

DATE WELL COMPLETED

Depth of Well

PERMIT NO.
FROM "PERMIT TO DRILL WELL"

8 13

15 20

22 26
(TO NEAREST FOOT)

28 29 30 31 32 33 34 35 36 37

OWNER Chesapeake Holding Co
STREET OR RD last name Quail Covey Ct first name TOWN Florence
SUBDIVISION Fox Moor SECTION LOT 9

WELL LOG

Not required for driven wells

STATE THE KIND OF FORMATIONS
PENETRATED, THEIR COLOR, DEPTH,
THICKNESS AND IF WATER BEARING

DESCRIPTION (Use additional sheets if needed) FEET FROM TO Check if water bearing

TOP soil	0	2	
Clay	2	5	
Shale	5	15	
brown slate	15	35	
blue slate	35	75	
brown slate	75	83	✓
blue & brown slate mixed	83	110	
Quartz blue & brown slate mixed	110	120	✓
blue slate	120	130	
Quartz	130	135	✓
blue slate	135	160	

GROUTING RECORD

WELL HAS BEEN GROUTED
(Circle Appropriate Box)

TYPE OF GROUTING MATERIAL

CEMENT ☒ CM BENTONITE CLAY ☒ BC

NO. OF BAGS 10 NO. OF POUNDS 1000

GALLONS OF WATER 50

DEPTH OF GROUT SEAL (to nearest foot)

from 0 ft. to 34 ft.
(enter 0 if from surface)

CASING RECORD

casing types insert appropriate code below
☒ ST ☒ CO
STEEL CONCRETE
☒ PL ☒ OT
PLASTIC OTHER

MAIN CASING TYPE Nominal diameter top (main) casing (nearest inch) Total depth of main casing (nearest foot)
☒ ST 6 40
60 61 63 64 66 70

OTHER CASING (if used) diameter inch depth (feet) from to
☐ ☐

screen type or open hole
insert appropriate code below
☒ ST ☒ BR ☒ HO
STEEL BRASS OPEN HOLE
☒ PL ☒ OT
PLASTIC OTHER

C2 DEPTH (nearest ft.)
1 H 0 38 160
8 9 11 15 17 21
2 ☐ ☐ ☐ ☐ ☐ ☐
23 24 26 30 32 36
3 ☐ ☐ ☐ ☐ ☐ ☐
38 39 41 45 47 51

SLOT SIZE 1 2 3
DIAMETER OF SCREEN (NEAREST INCH)
☐ ☐ ☐ ☐
56 60

GRAVEL PACK IF WELL DRILLED WAS FLOWING WELL INSERT F IN BOX 68 ☐

OEP USE ONLY (NOT TO BE FILLED IN BY DRILLER)
T (E.R.O.S.) W Q
70 ☐ 72 ☐ 74 75 76
TELESCOPE LOG OTHER DATA
CASING INDICATOR

C3

PUMPING TEST

HOURS PUMPED (nearest hour) 3

PUMPING RATE (gal. per min. to nearest gal.) 12

METHOD USED TO MEASURE PUMPING RATE Bucket

WATER LEVEL (distance from land surface)

BEFORE PUMPING 68

WHEN PUMPING 69

TYPE OF PUMP USED (for test)

☒ A air ☒ P piston ☐ T turbine
☒ C centrifugal ☒ R rotary ☐ O other (describe below)
☒ J jet ☒ S submersible

PUMP INSTALLED

DRILLER WILL INSTALL PUMP YES ☒ NO

IF DRILLER INSTALLS PUMP, THIS SECTION MUST BE COMPLETED FOR ALL WELLS EXCEPT HOME USE

TYPE OF PUMP INSTALLED

PLACE (A,C,J,P,R,S,T,O)

IN BOX - SEE ABOVE: ☐

CAPACITY: GALLONS PER MINUTE (to nearest gallon) ☐

PUMP HORSE POWER ☐

PUMP COLUMN LENGTH (nearest ft.) ☐

CASING HEIGHT (circle appropriate box and enter casing height)

☒ above ☐ below

LAND SURFACE 2 (nearest foot)

LOCATION OF WELL ON LOT

SHOW PERMANENT STRUCTURE SUCH AS BUILDING, SEPTIC TANKS, AND/OR LANDMARKS AND INDICATE NOT LESS THAN TWO DISTANCES (MEASUREMENTS TO WELL)

50' well
20'
Quail Covey CT.


CIRCLE APPROPRIATE LETTER
A A WELL WAS ABANDONED AND SEALED WHEN THIS WELL WAS COMPLETED
E ELECTRIC LOG OBTAINED
P TEST WELL CONVERTED TO PRODUCTION WELL

I HEREBY CERTIFY THAT THIS WELL HAS BEEN CONSTRUCTED IN ACCORDANCE WITH COMAR 26.04.04 "WELL CONSTRUCTION" AND IN CONFORMANCE WITH ALL CONDITIONS STATED IN THE ABOVE CAPTIONED PERMIT, AND THAT THE INFORMATION PRESENTED HEREIN IS ACCURATE AND COMPLETE TO THE BEST OF MY KNOWLEDGE.

DRILLERS IDENT. NO. 40
DRILLERS SIGNATURE George F. Heston
(MUST MATCH SIGNATURE ON APPLICATION)
SITE SUPERVISOR (sign. of driller or journeyman responsible for sitework if different from permittee)

COUNTY

B 1 5355 (THIS NUMBER IS TO BE PUNCHED IN COLS. 3-6 ON ALL CARDS)	SEQUENCE NO. (DP USE ONLY) STATE OF MARYLAND APPLICATION FOR PERMIT TO DRILL WELL please print or type	STATE PERMIT NUMBER 10-88-2033 70 fill in this form completely 79
Date Received (APA) 04/19/92 OWNER INFORMATION Chappapeake Holding 15 Last Name 34 36 1596 55 57 Baltimore 76	B 3 LOCATION OF WELL R-42803 Howard 8 COUNTY 21 23 SUBDIVISION 42 SECTION 44 46 LOT 9 48 50 52 NEAREST TOWN 71 73 76 77 78	
DRILLER INFORMATION Driller's Name George F. Easterday L. Franklin Easterday, Inc. Firm Name 9265 Brown Church Rd. MT. Airy, Md. 21771 Address Signature <i>George F. Easterday</i> Date 1/8/92	B 4 DIRECTION OF WELL FROM TOWN (CIRCLE BOX) NEAR WHAT ROAD Qual Covey Ct ON WHICH SIDE OF ROAD (CIRCLE APPROPRIATE BOX) NORTH WEST SOUTH EAST DISTANCE FROM ROAD 34 90 37 ENTER FT OR MI AT	
B 2 WELL INFORMATION APPROX. PUMPING RATE (GAL. PER MIN.) 5 AVERAGE DAILY QUANTITY NEEDED (GAL. PER DAY) 500	NOT TO BE FILLED IN BY DRILLER HEALTH DEPARTMENT APPROVAL COUNTY NAME Howard COUNTY NO. A 40863 STATE SIGNATURE David M. ... DATE ISSUED 7-24-92 NORTH GRID 532000 EAST GRID 0762000	
USE FOR WATER (CIRCLE APPROPRIATE BOX) ☒ HOME (SINGLE OR DOUBLE HOUSEHOLD UNIT ONLY) ☐ FARMING (LIVESTOCK WATERING & AGRICULTURAL IRRIGATION) ☐ INDUSTRIAL, COMMERCIAL, STATE AND FEDERAL GOV. OTHER (REQUIRES APPROPRIATION PERMIT) ☐ PUBLIC OR PRIVATE WATER COMPANY (REQUIRES APPROPRIATION PERMIT AND STATE HEALTH DEPARTMENT APPROVAL) ☐ TEST, OBSERVATION, MONITORING (MAY REQUIRE APPROPRIATION PERMIT)	SHOW MAJOR FEATURES OF BOX & LOCATE WELL WITH AN X SOURCES OF DRILLING WATER 1. well 2. 3. WRITE THE BOX NUMBER FROM THE MAP HERE E 7682 N 5302	
APPROXIMATE DEPTH OF WELL 200 FEET APPROXIMATE DIAMETER OF WELL 6 INCH.	4/14/92 GROUT AM 10 BAGS GROUT OK 40' CASING NOT OBS'D 34' OPEN 22' CASING A.G. LOC OK 4/14/92 TAG OK MR	
METHOD OF DRILLING (circle one) BORED (or Augered) ☒ JETTED ☐ Jetted & DRIVEN AIR-ROTARY ☒ AIR-PERCussion. ☐ ROTARY (Hydraulic Rotary) CABLE ☐ REVERSE-ROTARY ☐ Drive-POINT	DRAW A SKETCH BELOW SHOWING LOCATION OF WELL IN RELATION TO NEARBY TOWNS AND ROADS AND GIVE DISTANCE FROM WELL TO NEAREST ROAD JUNCTION 	
REPLACEMENT OR DEEPEMED WELLS (CIRCLE APPROPRIATE BOX) ☒ THIS WELL WILL NOT REPLACE AN EXISTING WELL ☐ THIS WELL WILL REPLACE A WELL THAT WILL BE ABANDONED AND SEALED ☐ THIS WELL WILL REPLACE A WELL THAT WILL BE USED AS A STANDBY ☐ THIS WELL WILL DEEPEMED AN EXISTING WELL PERMIT NUMBER OF WELL TO BE REPLACED OR DEEPEMED (IF AVAILABLE) 41 52	Not to be filled in by driller (OEP USE ONLY) APPROP. PERMIT NUMBER 10-88-2033 FORCE RP WRITE INITIALS IN BOX PERMIT No. 10-88-2033 SPECIAL CONDITIONS Well must be a minimum of 150' From nearest sewage disposal area	

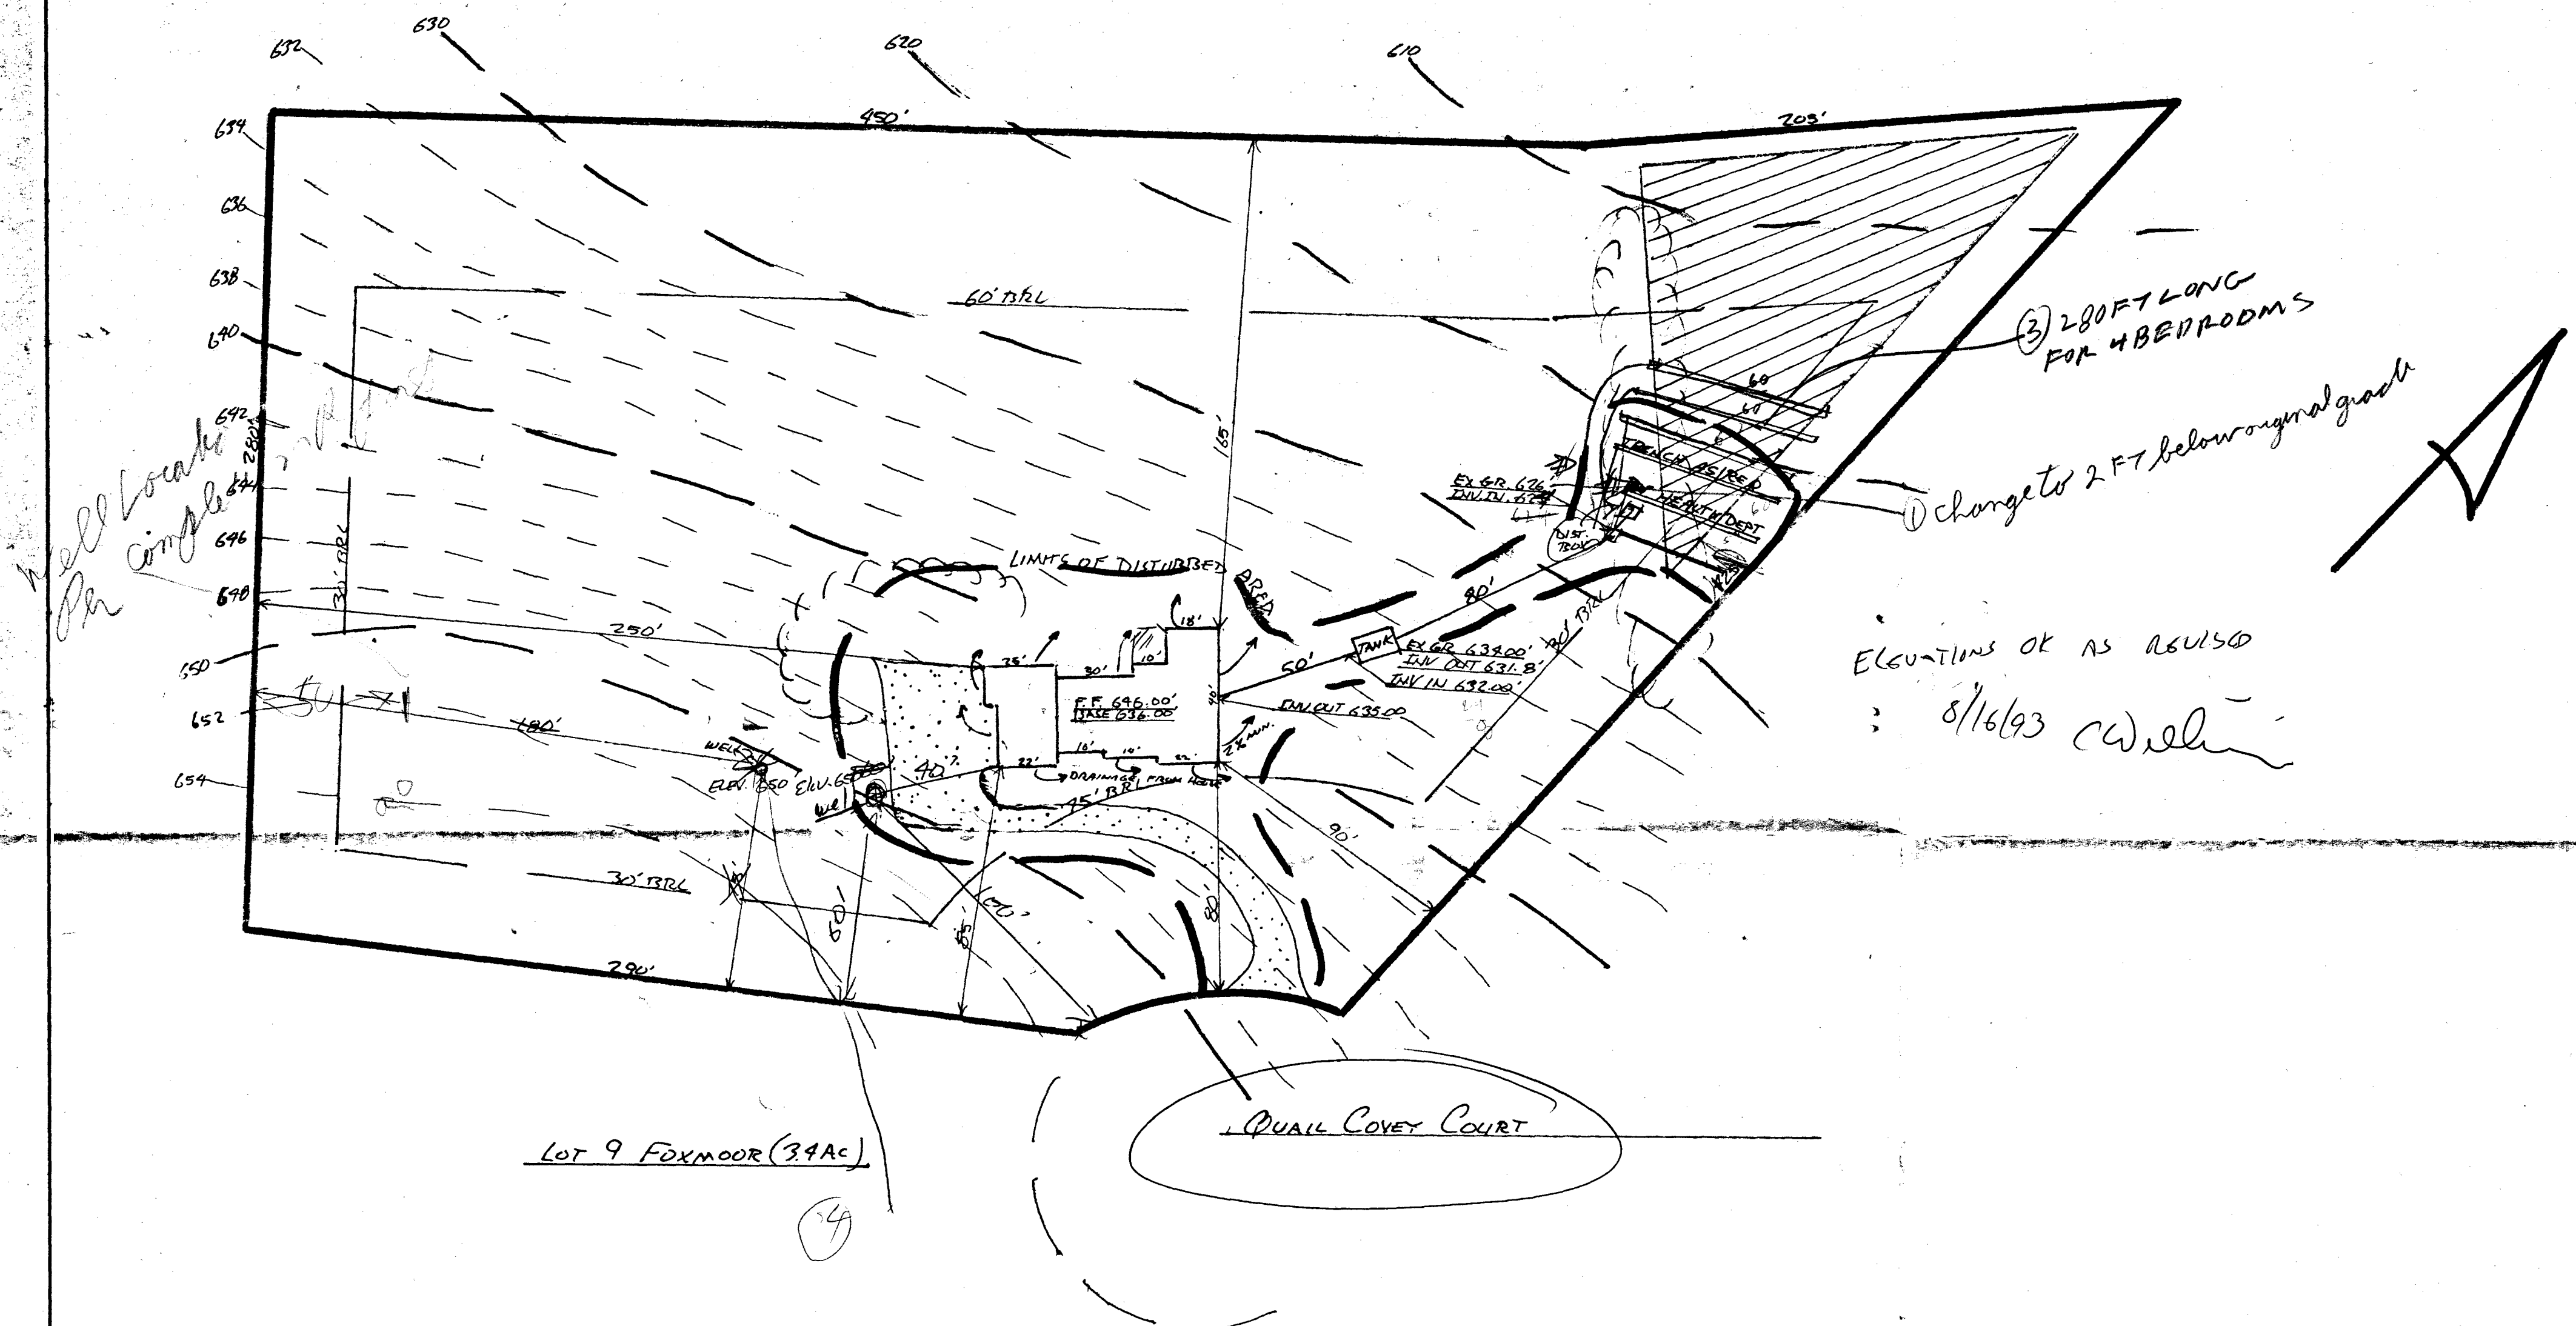

LOT 9 FOXMOOR (39A-C)

QUAIL COVEY COURT

ELEVATIONS OK AS REVISED
8/16/93 CW

② Name of person who prepared plan

All these measurements are true to the best of my knowledge.
8.16.93

LOT 9 FOXMOOR		DRAWN BY	
SCALE 1" = 40'	APPROVED BY	REVISED	
DATE	FRED DICKSON 442-5965		
DRAWING NUMBER			