

PERMIT

SEWAGE DISPOSAL SYSTEM

DEPARTMENT OF HEALTH AND MENTAL HYGIENE

HOWARD COUNTY HEALTH DEPARTMENT

BUREAU OF ENVIRONMENTAL HEALTH

~~461-9933~~

313-2640

INDEXED

05-413737

P 50733

A 41347

DISTRICT 5th

DATE 6-12-95

DATE SYSTEM APPROVED 6/14/95

INSPECTOR C.B.S.

Fogle's Septic Clean, Inc.

IS PERMITTED TO INSTALL ☒ ALTER

ADDRESS 558 Obrecht Road, Sykesville, Maryland 21784 PHONE 795-5674

SUBDIVISION Ashleigh Greene-Sec. II LOT 33 ROAD 11895 Simpson Road

PROPERTY OWNER Charles S. Jennings

ADDRESS

SEPTIC TANK CAPACITY 1250 GALLONS

NUMBER OF BEDROOMS 4

180 SQUARE FEET PER BEDROOM

LINEAR FEET OF TRENCH REQUIRED 180

TRENCHES - Trench to be 2 feet wide. Inlet 4 feet below original grade. Bottom maximum depth 8 feet below original grade. Effective area begins at 4 feet below original grade. 4 feet of stone below distribution pipe.

LOCATION - Place the distribution box 220 feet down the right lot line (259.25') and 90 feet off the same lot line as seen when facing the lot from Wollingford Court. Run trenches along contour toward the right (259.25') and left (333.47') lot lines. MAINTAIN A MINIMUM OF 100 FEET TO ALL WELLS.

NOTES - No trench to exceed 100 feet in length. Provide 6" - 8' diameter cleanout and cap to grade or above on septic tank. OK 2/29/95 DKS

PLANS APPROVED BY Jane Nadeau DATE 3/28/94

COVER NO WORK UNTIL INSPECTED AND APPROVED

NEITHER THE HOWARD COUNTY COUNCIL NOR THE HEALTH DEPARTMENT IS RESPONSIBLE FOR THE SUCCESSFUL OPERATION OF ANY SYSTEM

NOTE: CLEANOUT REQUIRED EVERY 70 FEET OF SEWER LINE AND/OR AT 90° SWEEPS IN LINES FROM HOUSE TO DRAIN FIELDS, 90° ELBOWS NOT ACCEPTABLE.

NOTE: ALL PARTS OF SEPTIC SYSTEMS (I.E. TANK, DISTRIBUTION BOX TRENCHES) TO BE 100 FEET FROM WELL (UNLESS OTHERWISE SPECIFICALLY AUTHORIZED)

NOTE: IF DEEP TRENCH(ES) ARE USED CALL FOR INSPECTION BEFORE AND AFTER PLACING GRAVEL IN TRENCH(ES)

NOTE: NO DRY WELL SHALL EXCEED 15 FOOT IN DIAMETER NO ABSORPTION TRENCH TO EXCEED 100 FEET IN LENGTH

NOTE: ALL PIPE FROM HOUSE TO SEPTIC TANK MUST BE CAST IRON OR SCHEDULE 35/40 PVC OR ABS

PERMIT VOID AFTER TWO YEARS

NOTE: INSTALL STAND PIPE ON SEPTIC TANK AND DRY WELL STAND PIPES MUST BE 6 INCHES IN DIAMETER CAST IRON, CONCRETE OR TERRA COTTA OR PVA OR ABS ACCEPTED. IF TOP OF SEPTIC TANK IS DEEPER THAN 3 FEET. MANHOLE TO GRADE REQUIRED

NOTE: DISTRIBUTION BOXES MUST HAVE BAFFLES

*INSTALLER IS RESPONSIBLE FOR OBTAINING FINAL APPROVAL ON THIS PERMIT

HD-260(6-90)


*CALL 461-9933 FOR INSPECTION OF SEPTIC SYSTEM.

PERMIT SIGNATURE
RETURNED 8-28-99

Sealed 8/12/99
Interior alterations
new garage

A 41347

← "WOLLINGFORD COURT" →

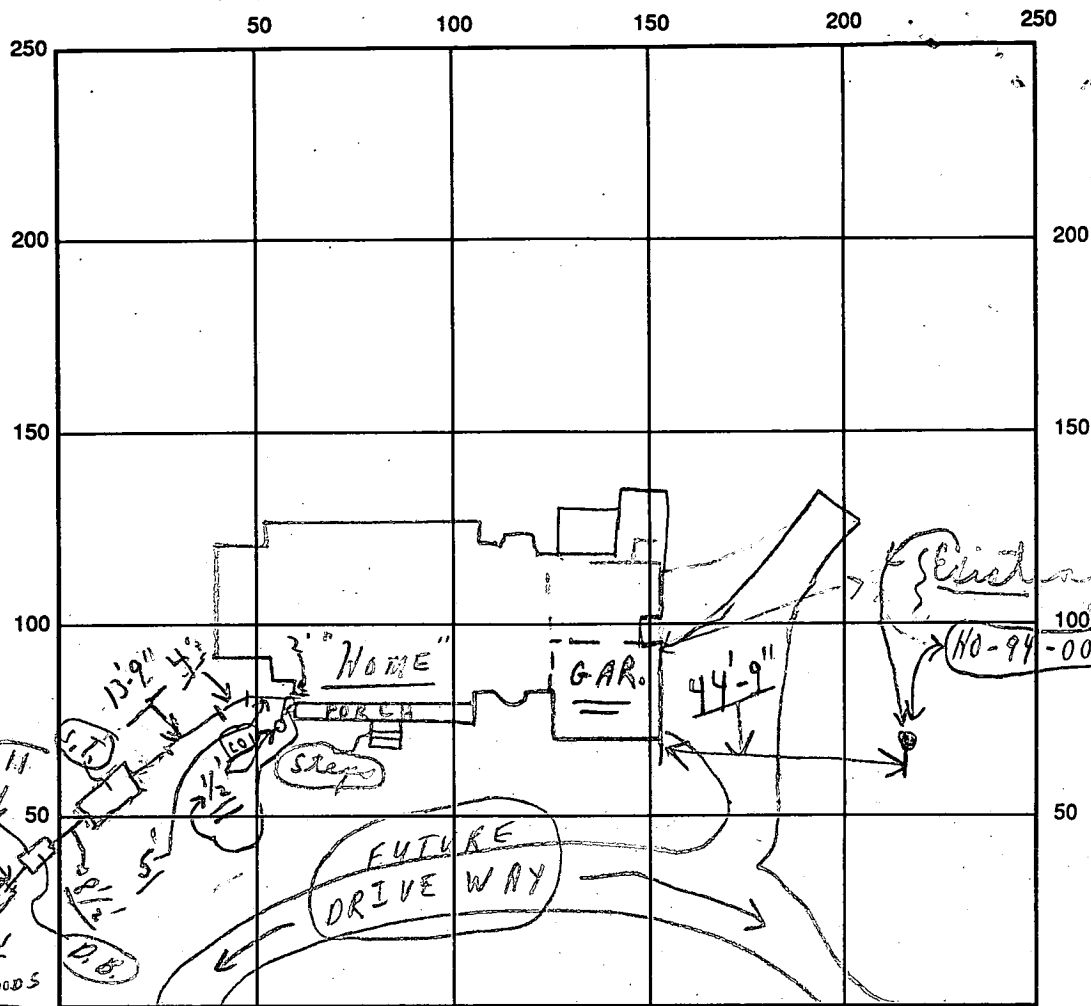

INDICATE NORTH - NAME ADJOINING ROADWAY AS BASE LINE

← MEADOW WOOD WAY →

SEPTIC TANK LEVEL OK CLEANOUTS OK S.T. C.O.

DISTRIBUTION BOX LEVEL OK (Baffle in)

DRAIN FIELD/TITLE DEPTH 8 ^① + average FT. TRENCH WIDTH 2 FT. INLET DEPTH 4 FT.

EFFECTIVE GRAVEL DEPTH 4 ^③ + FT. { TOTAL LENGTH ① 92'; ② 92' } = (184) FT.

NUMBER OF TRENCHES 2 ONE SIDEWALL/BOTTOM AREA 736 ⁺ SQ. FT.

DRYWALL INSIDE DIAMETER — FT. EFFECTIVE DEPTH BELOW INLET — FT.

ABSORBENT AREA 736 ⁺ SQ. FT.

REMARKS: (Early) 6/13/95 (P.M.) ok to cover to 4' of new S.T. - only from home; partial; chd 6/13/95 Late P.M. Trench #1 ok for stone; etc; ok to cover from house to Dist. Box partial
 6/14/95 #1 Trench ok to cover - see ends of #2, only chd
 6/14/95 Final; ok to cover - last trench; chd
 Early 6/13/95 W.P.I. - final - chd

DATE SYSTEM APPROVED 6/14/95 INSPECTOR Charles Bryan Strecker

APPLICATION

PERCOLATION TESTING

A 41347

P _____

HOWARD COUNTY HEALTH DEPARTMENT
BUREAU OF ENVIRONMENTAL HEALTH

P.O. BOX 476 ELLICOTT CITY, MARYLAND 21043
TELEPHONE: 461-9933

DISTRICT 5th

DATE 2/2/88

TO: THE COUNTY HEALTH OFFICER
ELLICOTT CITY, MARYLAND

I, HEREBY, APPLY FOR THE NECESSARY TEST IN ORDER TO CONSTRUCT (OR RECONSTRUCT) A SEWAGE DISPOSAL SYSTEM.

PROPERTY OWNER Charles S. Jennings
Winchester Homes, Inc. Real Estate Development Group

ADDRESS 6301 Ivy Lane, Suite 714 PHONE 710-6732
Greenbelt, Maryland 20770 301-220-1111

PROSPECTIVE BUYER _____

ADDRESS _____ PHONE _____

PROPERTY LOCATION:

Prelim Lot-X/33

SUBDIVISION Ashleigh Greene Section II LOT NO. 79

ROAD AND DESCRIPTION Intersections Browns Bridge Road/Hall Shop Road,
Hall Shop Road/Simpson Road (11895 Simpson Road)

TAX MAP 41 PARCEL # 174

BLDG. PERMIT SIGNED
AND RETURNED 1/26/85
Serial # 57897-
SF SFD-4Bim

SIZE OF LOT 3.0 AC. TYPE BLDG _____
(SINGLE FAMILY DWELLING OR COMMERCIAL)

THE SYSTEM INSTALLED UNDER THIS APPLICATION IS ACCEPTABLE ONLY UNTIL PUBLIC FACILITIES BECOME AVAILABLE. I FULLY UNDERSTAND THE

FEE CONNECTED WITH THE FILING OF THIS PERC TEST APPLICATION IS NON-REFUNDABLE UNDER ANY CIRCUMSTANCES. I ALSO AGREE TO COMPLY

WITH ALL M.O.S.H.A. REQUIREMENTS IN TESTING THIS LOT. B. B. Hauler
(SIGNATURE OF APPLICANT)

APPROVED BY _____ FOR _____ DATE _____

REJECTED BY _____ FOR _____ DATE _____

HOLD PENDING FURTHER TESTS _____ DATE _____

REASONS FOR REJECTION OR HOLDING 4-22-88 For perc hole locations and subdivision plat
approval. JEN

HD-216

THIS IS NOT A PERMIT

High 4
3
Low 2

A4/347


Lot 80

③

SOIL PROFILE

0-3.5 Rd si cl loam
3.5-12.5 Rd mica sa si lm, some saprolite < 40%
12.5 Bottom

Westcott Place

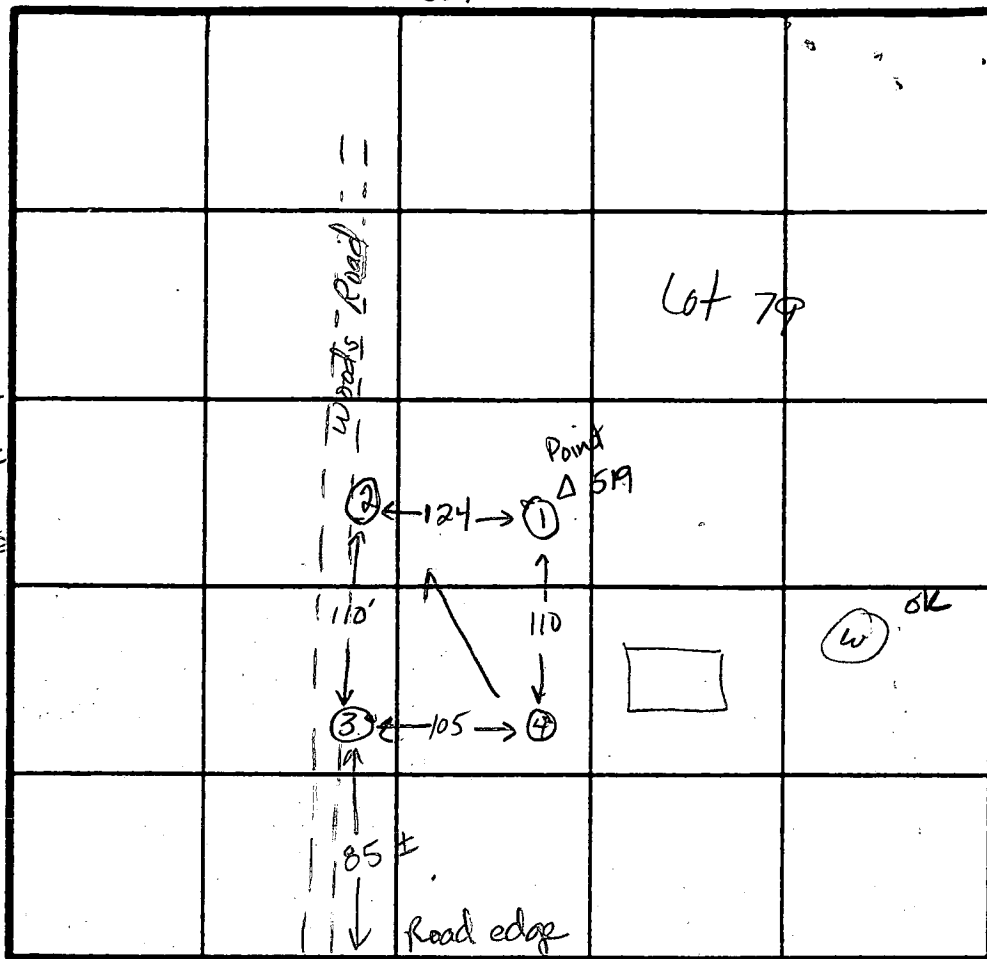

②

0-4.0 Rd si cl loam
4-12.5 Rd mica sa si loam, < 10% saprolite
12.5 Bottom

$\bar{x} = 6 \text{ min}$
Inlet = 4.0 ft
Bottom = 8.0 ft
180 sq ft/bdrm

④

0-4.0 Rd-br si cl loam
4.0-12.5 Rd-yellow micaceous sa si loam, < 30% saprolite
10.5 Bottom

①

0-3.5 Rd si cl loam
3.5-13.5 Rd mica sa si loam, < 10% saprolite
13.5 Bottom

INDICATE NORTH - NAME ADJOINING ROADWAY AS BASE LINE.

Simpson Road

DATE	TEST NO.	DEPTH	PRE-WET		TEST - 1" DROP		TIME
			START	STOP	START	STOP	
4/22/00	3	4.0 S	11:32	11:34	11:34	11:36	2 min
		12.5 D	Bottom				ok
	4	3.5 S	11:37	12:00	2:11	slow	F
		4.5 S	2:02	2:06	2:06	2:16	10 min
		7.0 M	11:36	11:38	11:38	11:41	3 min
		12.5 D	Bottom				
	2	4.0 S	11:25	11:27	11:27	11:31	4 min
		12.5 D	Bottom				ok
	1	4.0 S	11:50	11:52	11:52	11:54	2 min
		13.5 D	Bottom				ok

REMARKS

All holes located as shown on plat.

TYPE OF SOIL

0-4 Rd-br si cl lm, 4-13 Rd mica sa si lm, < 30% saprolite

TESTED BY

JE Nadeau

ALSO PRESENT

Burleigh Hamill

PLAT 5887

* HOWARD COUNTY, MD.
LOT 34

Ashleigh Greene
Sec 2, Area 1
Lots 28-34


F-93-61

Signed 12-15-92

1. Boundary da
coordinates
System and
following tra

2.  10,000 squa
of the Envir
of any natur
available. Th
upon connec
Officer shall
ments into
modified sew
here comply
required by

3. This d
4. BRL denotes
5. For flag or
road mainte
stem and th
pipe stem d
6. No clearing,
or stream b
7. T

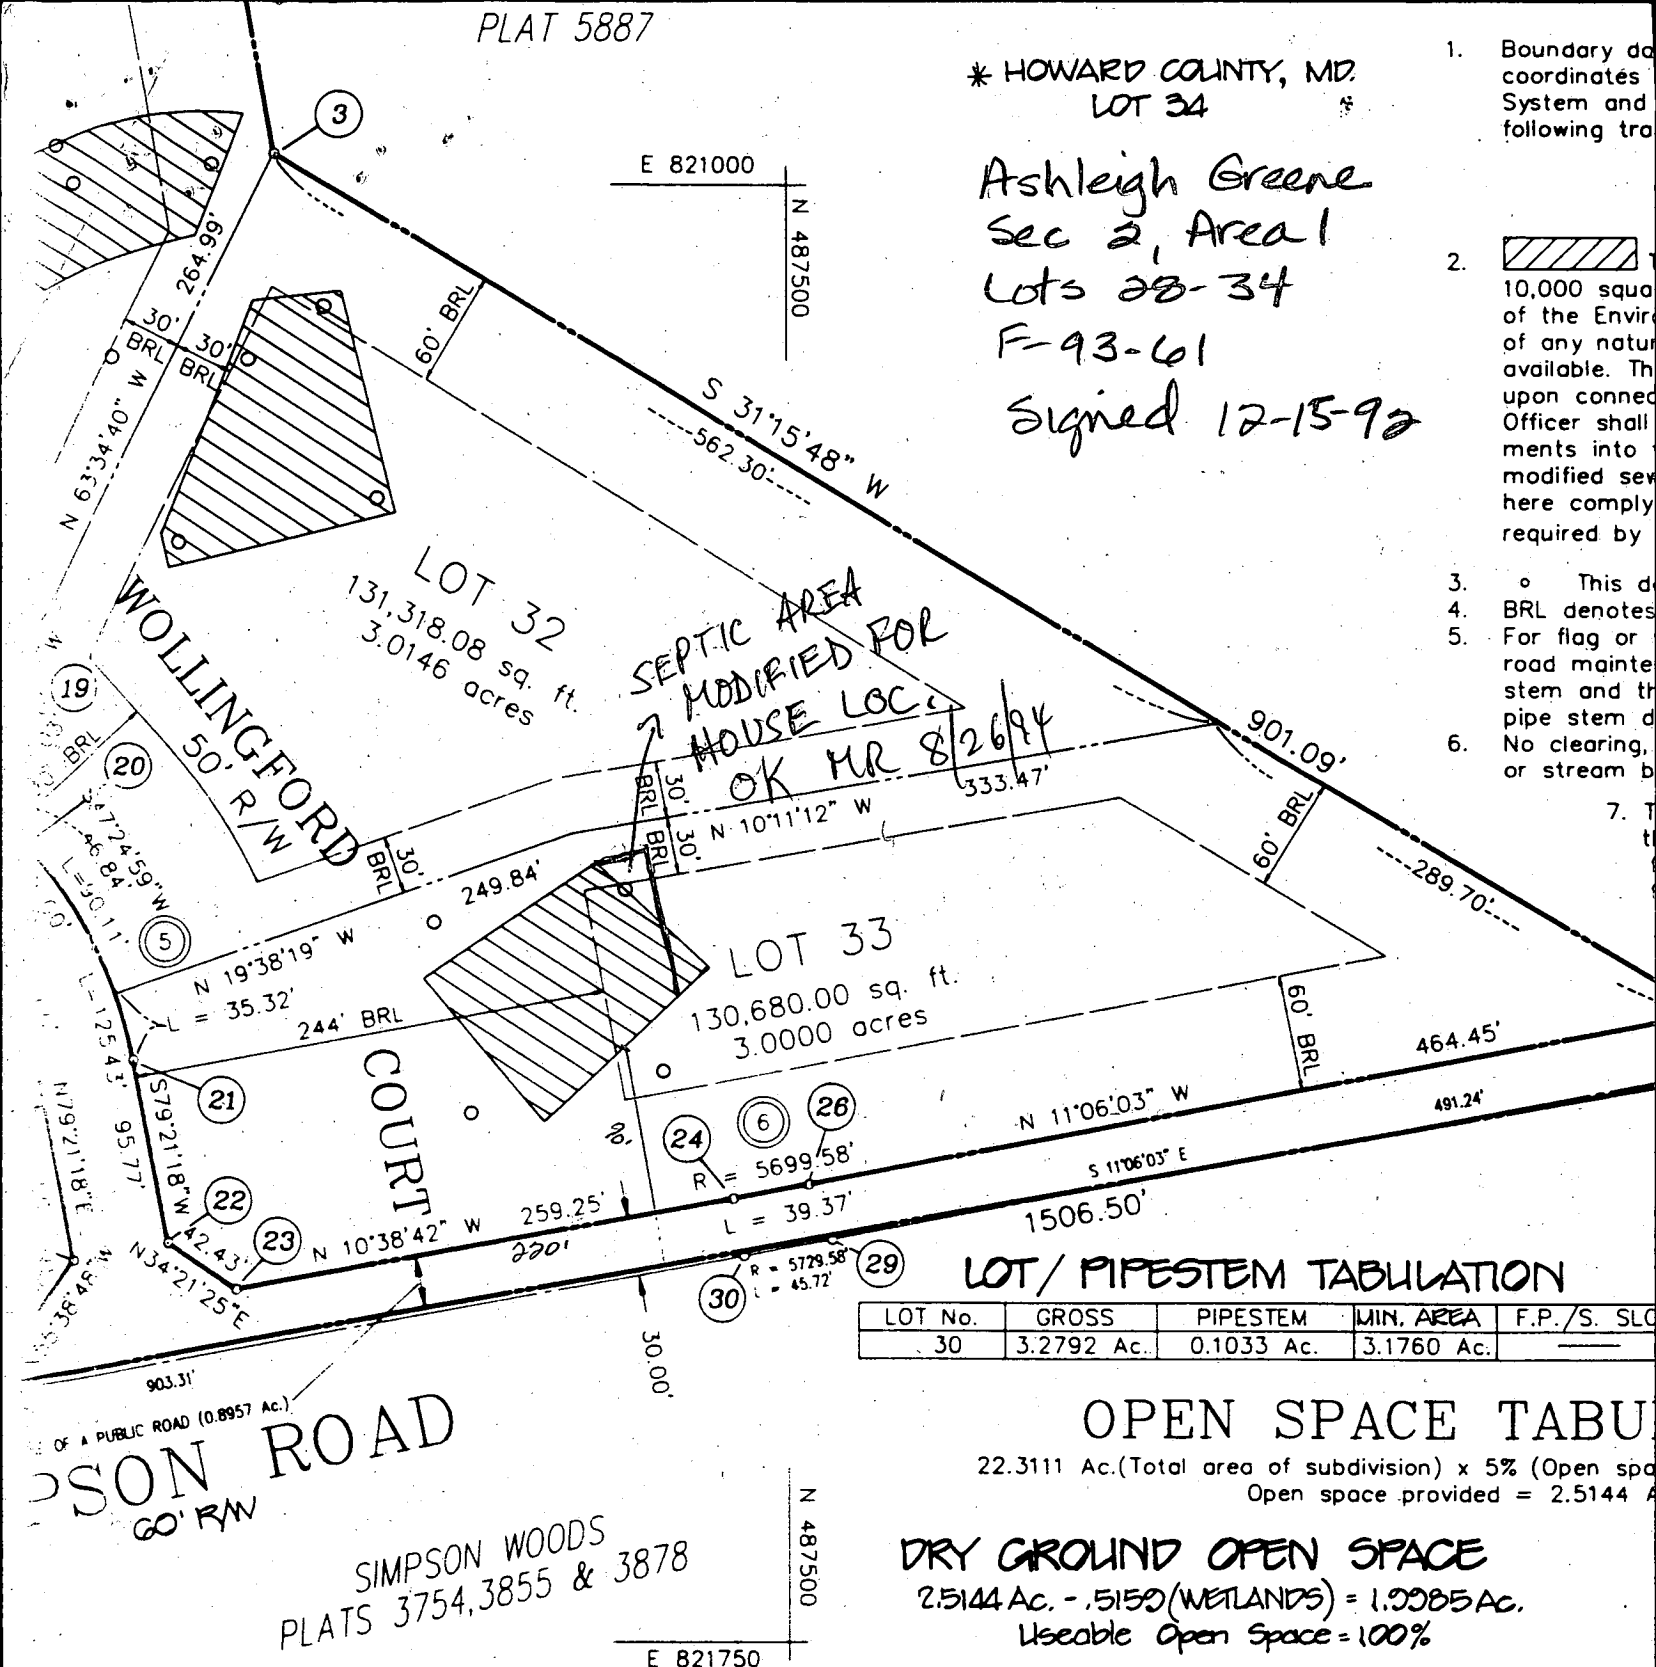

OWNER'S DEDICATION

I, Peter Byrnes, President of Winchester Homes, Inc., a Delaware Corporation, General and Managing Partner of Berwin Joint Venture, a Maryland General Partnership, along with Howard County, Maryland, a Body Corporate and Politic of the State of Maryland, owners of the property shown hereon, hereby adopt this plan of subdivision, and in consideration of the approval of this final plat by the Department of Planning and Zoning, establish minimum building restriction lines and grant unto Howard County, Maryland, its successors and assigns; (1) the right to lay, construct and maintain sewers, drains, water pipes and other municipal utilities and services, in and under all roads and street right-of-ways and the specific easements shown hereon; (2) the right to require dedication for public use the beds of streets and/or roads, and floodplains and open space where applicable and for good and other valuable consideration, hereby grant the right and option to Howard County to acquire the fee simple title to the beds of the streets and/or roads and floodplains, storm drainage facilities and open space where applicable; and (3) the right to require dedication of waterways and drainage easements for the specific purpose of their construction.

ASH


Ho

LOT 33
ASHLEIGH GREENE, SEC 2, AREA 1

WOLLINGFORD COURT
HOWARD COUNTY, MD
3.0000 ACRES

VERIFY INFO - BY MILDENBERG,
 MOCHI & ASSOC., INC. ENGINEER
 ELLICOTT CITY, MD 21043

SEPTIC SYSTEM AS PER
 HOWARD COUNTY DESIGN

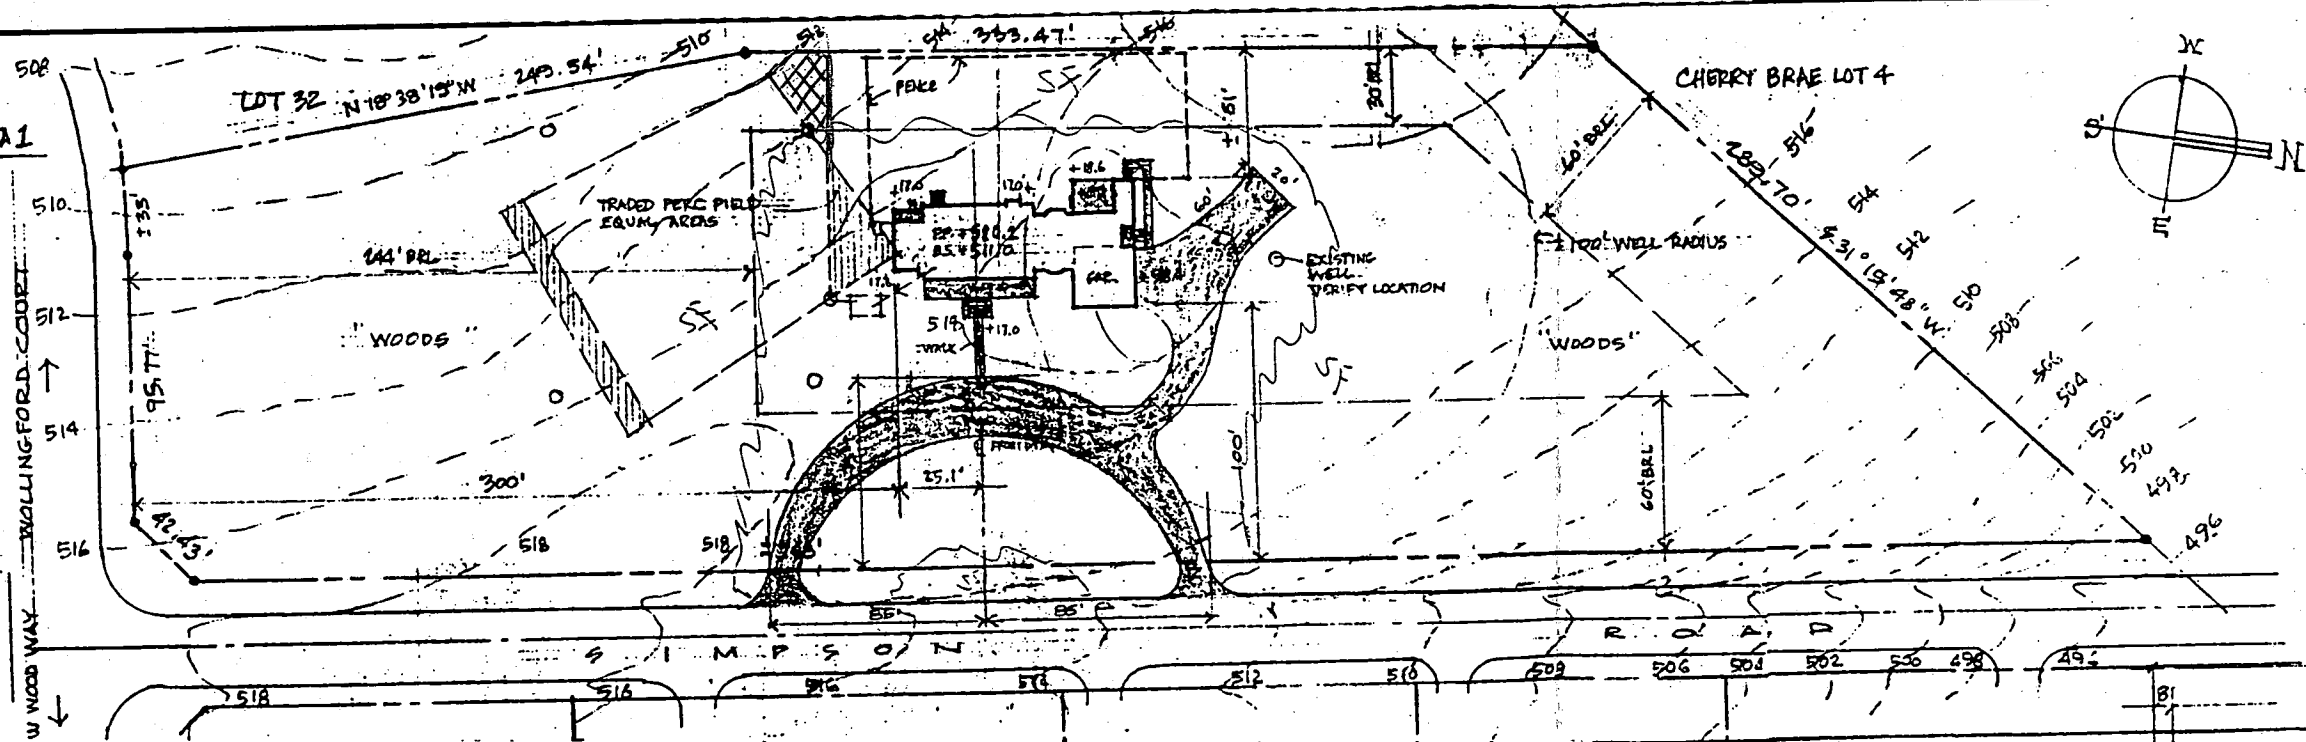

11/20/95 BP 57897

ACCEPTABLE MODIFICATION TO SEWAGE DISPOSAL
 EASEMENT, PER MARK RIFKIN 8/26/94

ALM

LOT 33
ASHLEIGH GREENE, SEC. 2, AREA 1
WOLLINGFORD COURT
HOWARD COUNTY, MD
3.0000 ACRES

VERIFY INFO - BY MILDENBERG,
MOCHT & ASSOC., INC. ENGINEER,
ELICOTT CITY, MD 21043


SEPTIC SYSTEM AS PER
HOWARD COUNTY DESIGN

"BY COPY OF THIS PLAN, THE
HEALTH DEPT. ACCEPTS THE
MODIFICATION OF THE SEWAGE
DISPOSAL EASEMENT."

Approved Septic System Plan
Howard County Health Department

Signature *Ann M. Miller* 1/26/95
Date

MEADOW WOOD WAY WOLLINGFORD COURT

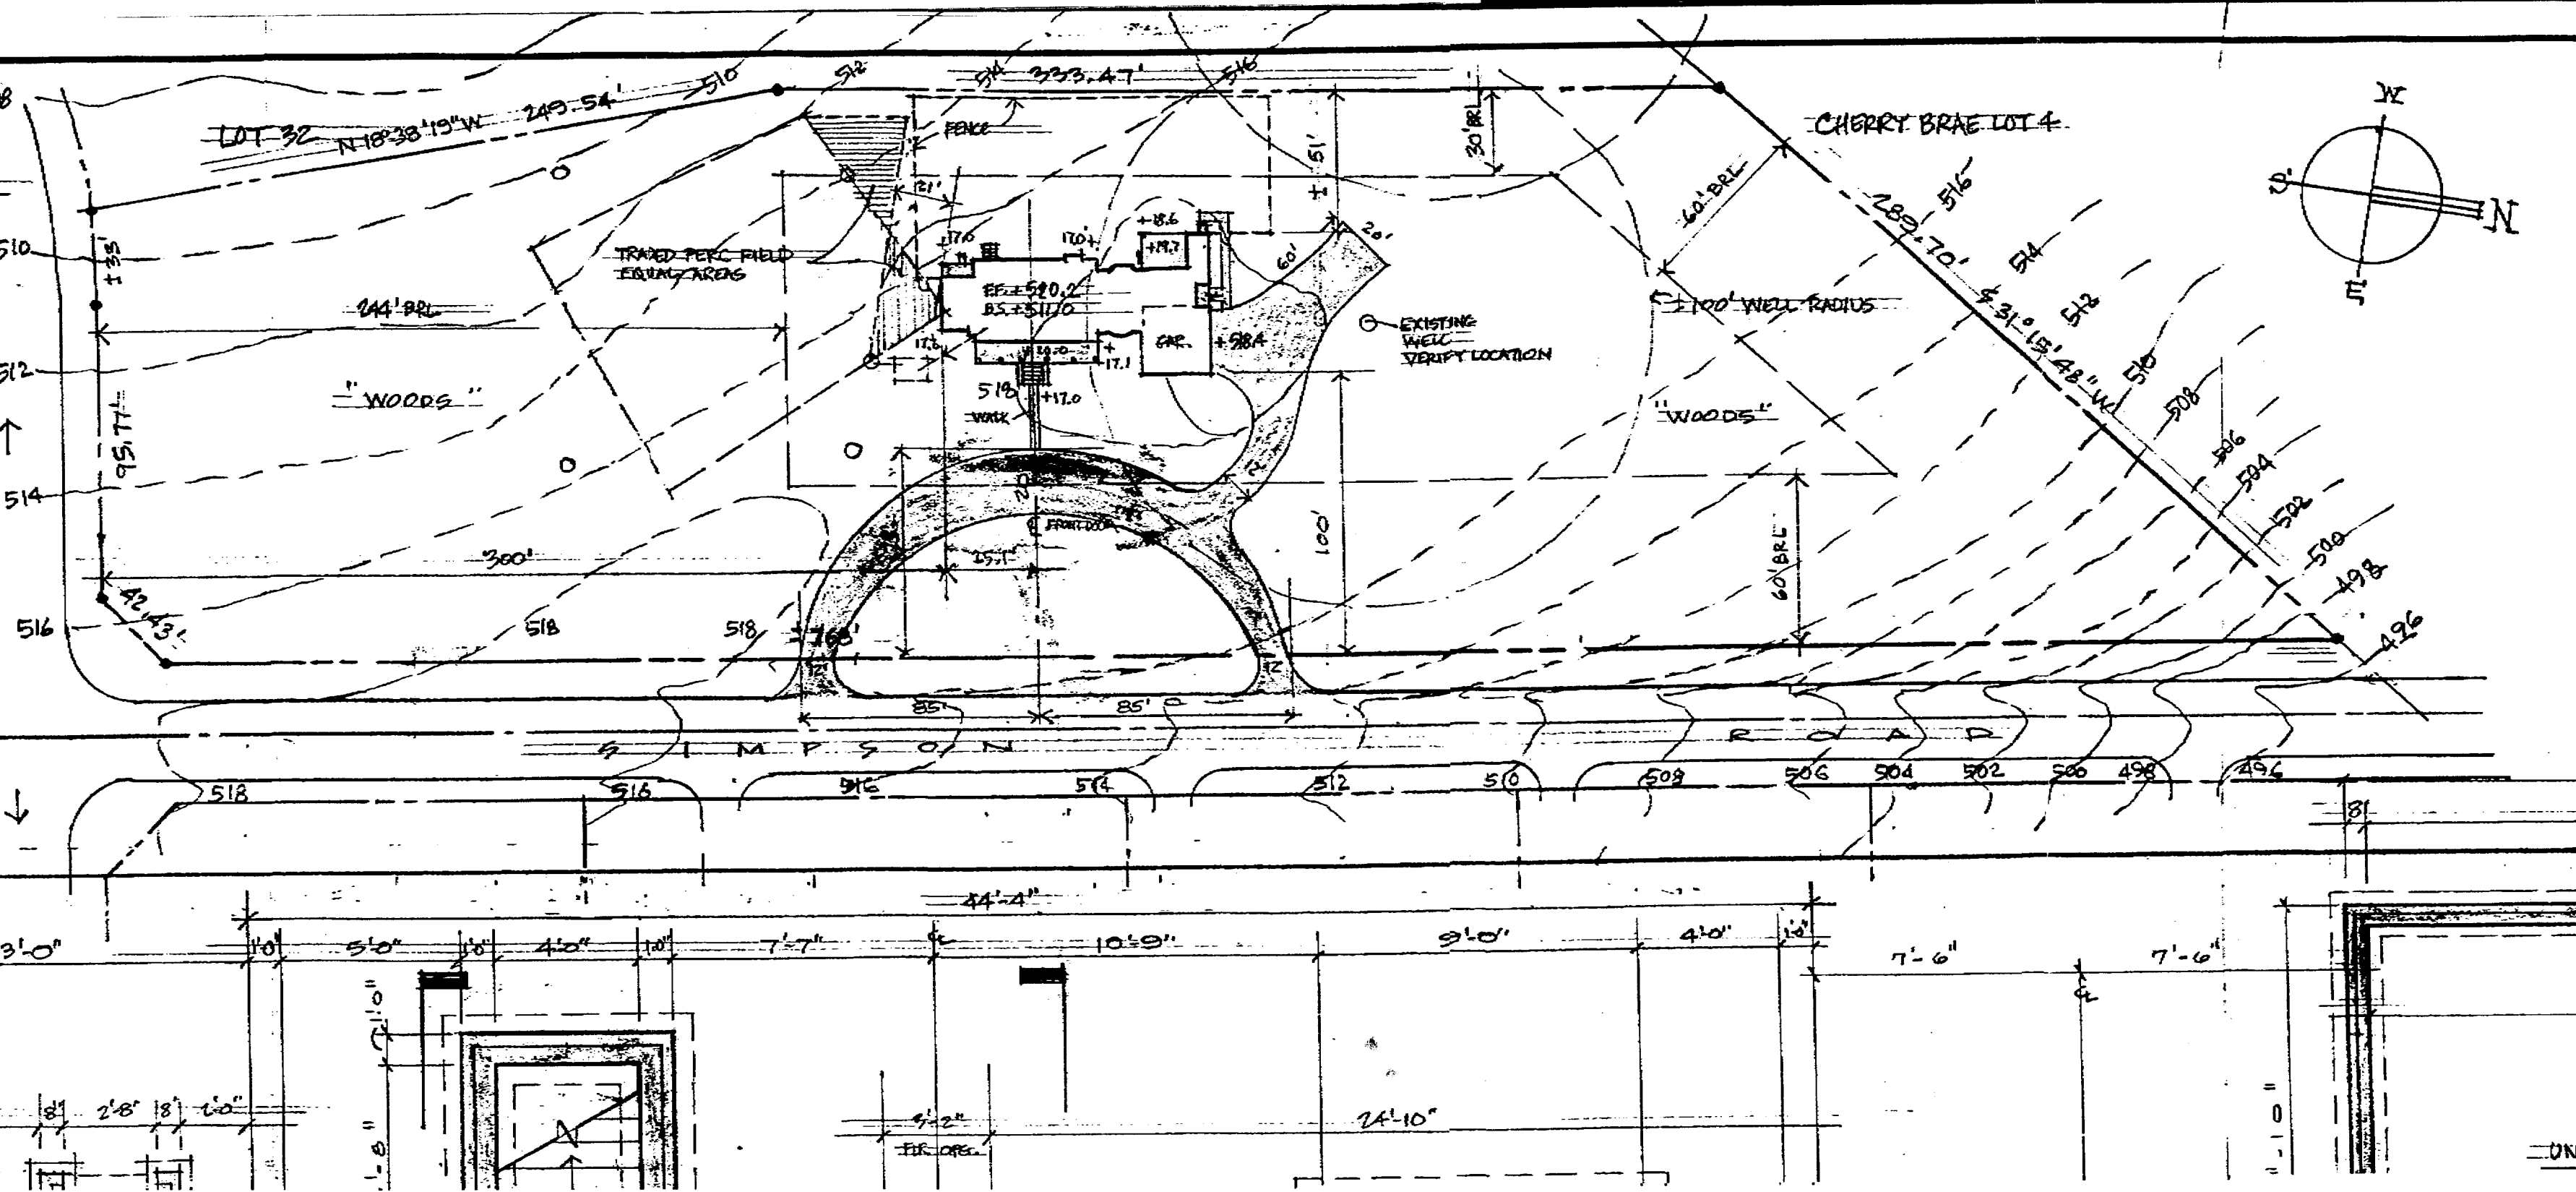


JENNINGS RESIDENCE : PERMIT 57897
SITE PLAN
SCALE: 1" = 50'

ELEVATIONS:


BASEMENT SLAB:	+511.0
FIRST FLOOR:	+520.2
INVERT OUT-OF-HOUSE:	+514.5
INVERT INTO SEPTIC TANK:	+514.0
INVERT OUT OF SEPTIC TANK:	+513.7
INVERT INTO DISTRIBUTION BOX:	+513.5
EXIST. GRADE AT SEPTIC TANK:	+517.2
EXIST. GRADE AT DISTRIBUTION BOX:	+517.1
EXIST. GRADE AT TRENCH(S):	+513.0
EXIST. GRADE AT EXIST. WELL:	+517.0

NOTE: BASEMENT SEWER EJECTION PUMP WILL BE
REQUIRED FOR BASEMENT PLUMBING, IF ANY.
LENGTH OF TRENCHES TO BE DETERMINED
AT TIME OF SEPTIC PERMIT ISSUANCE.

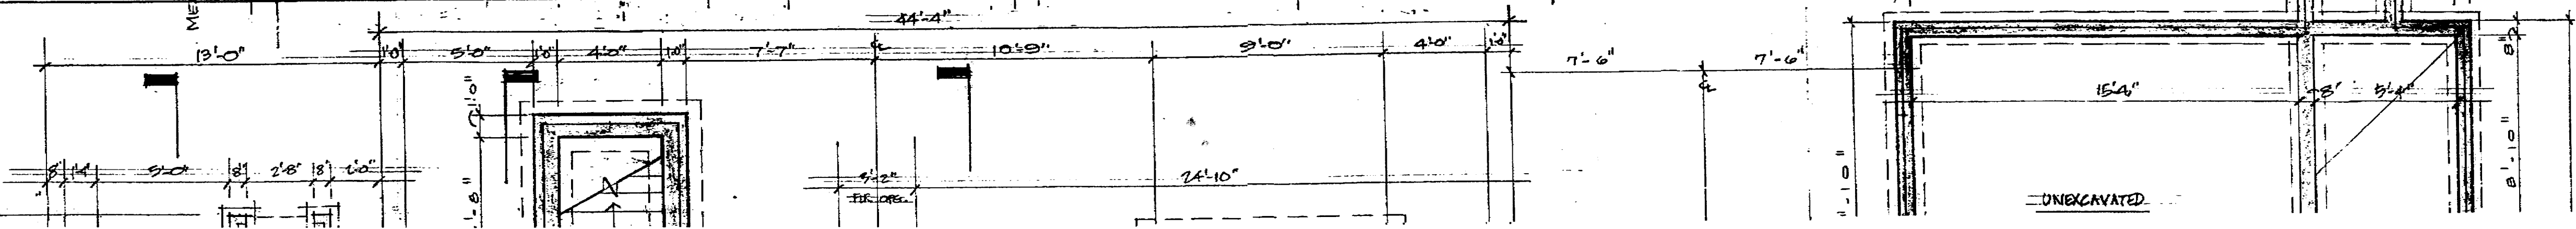

UNEXCAVATED

MARYLAND STATE GRID N

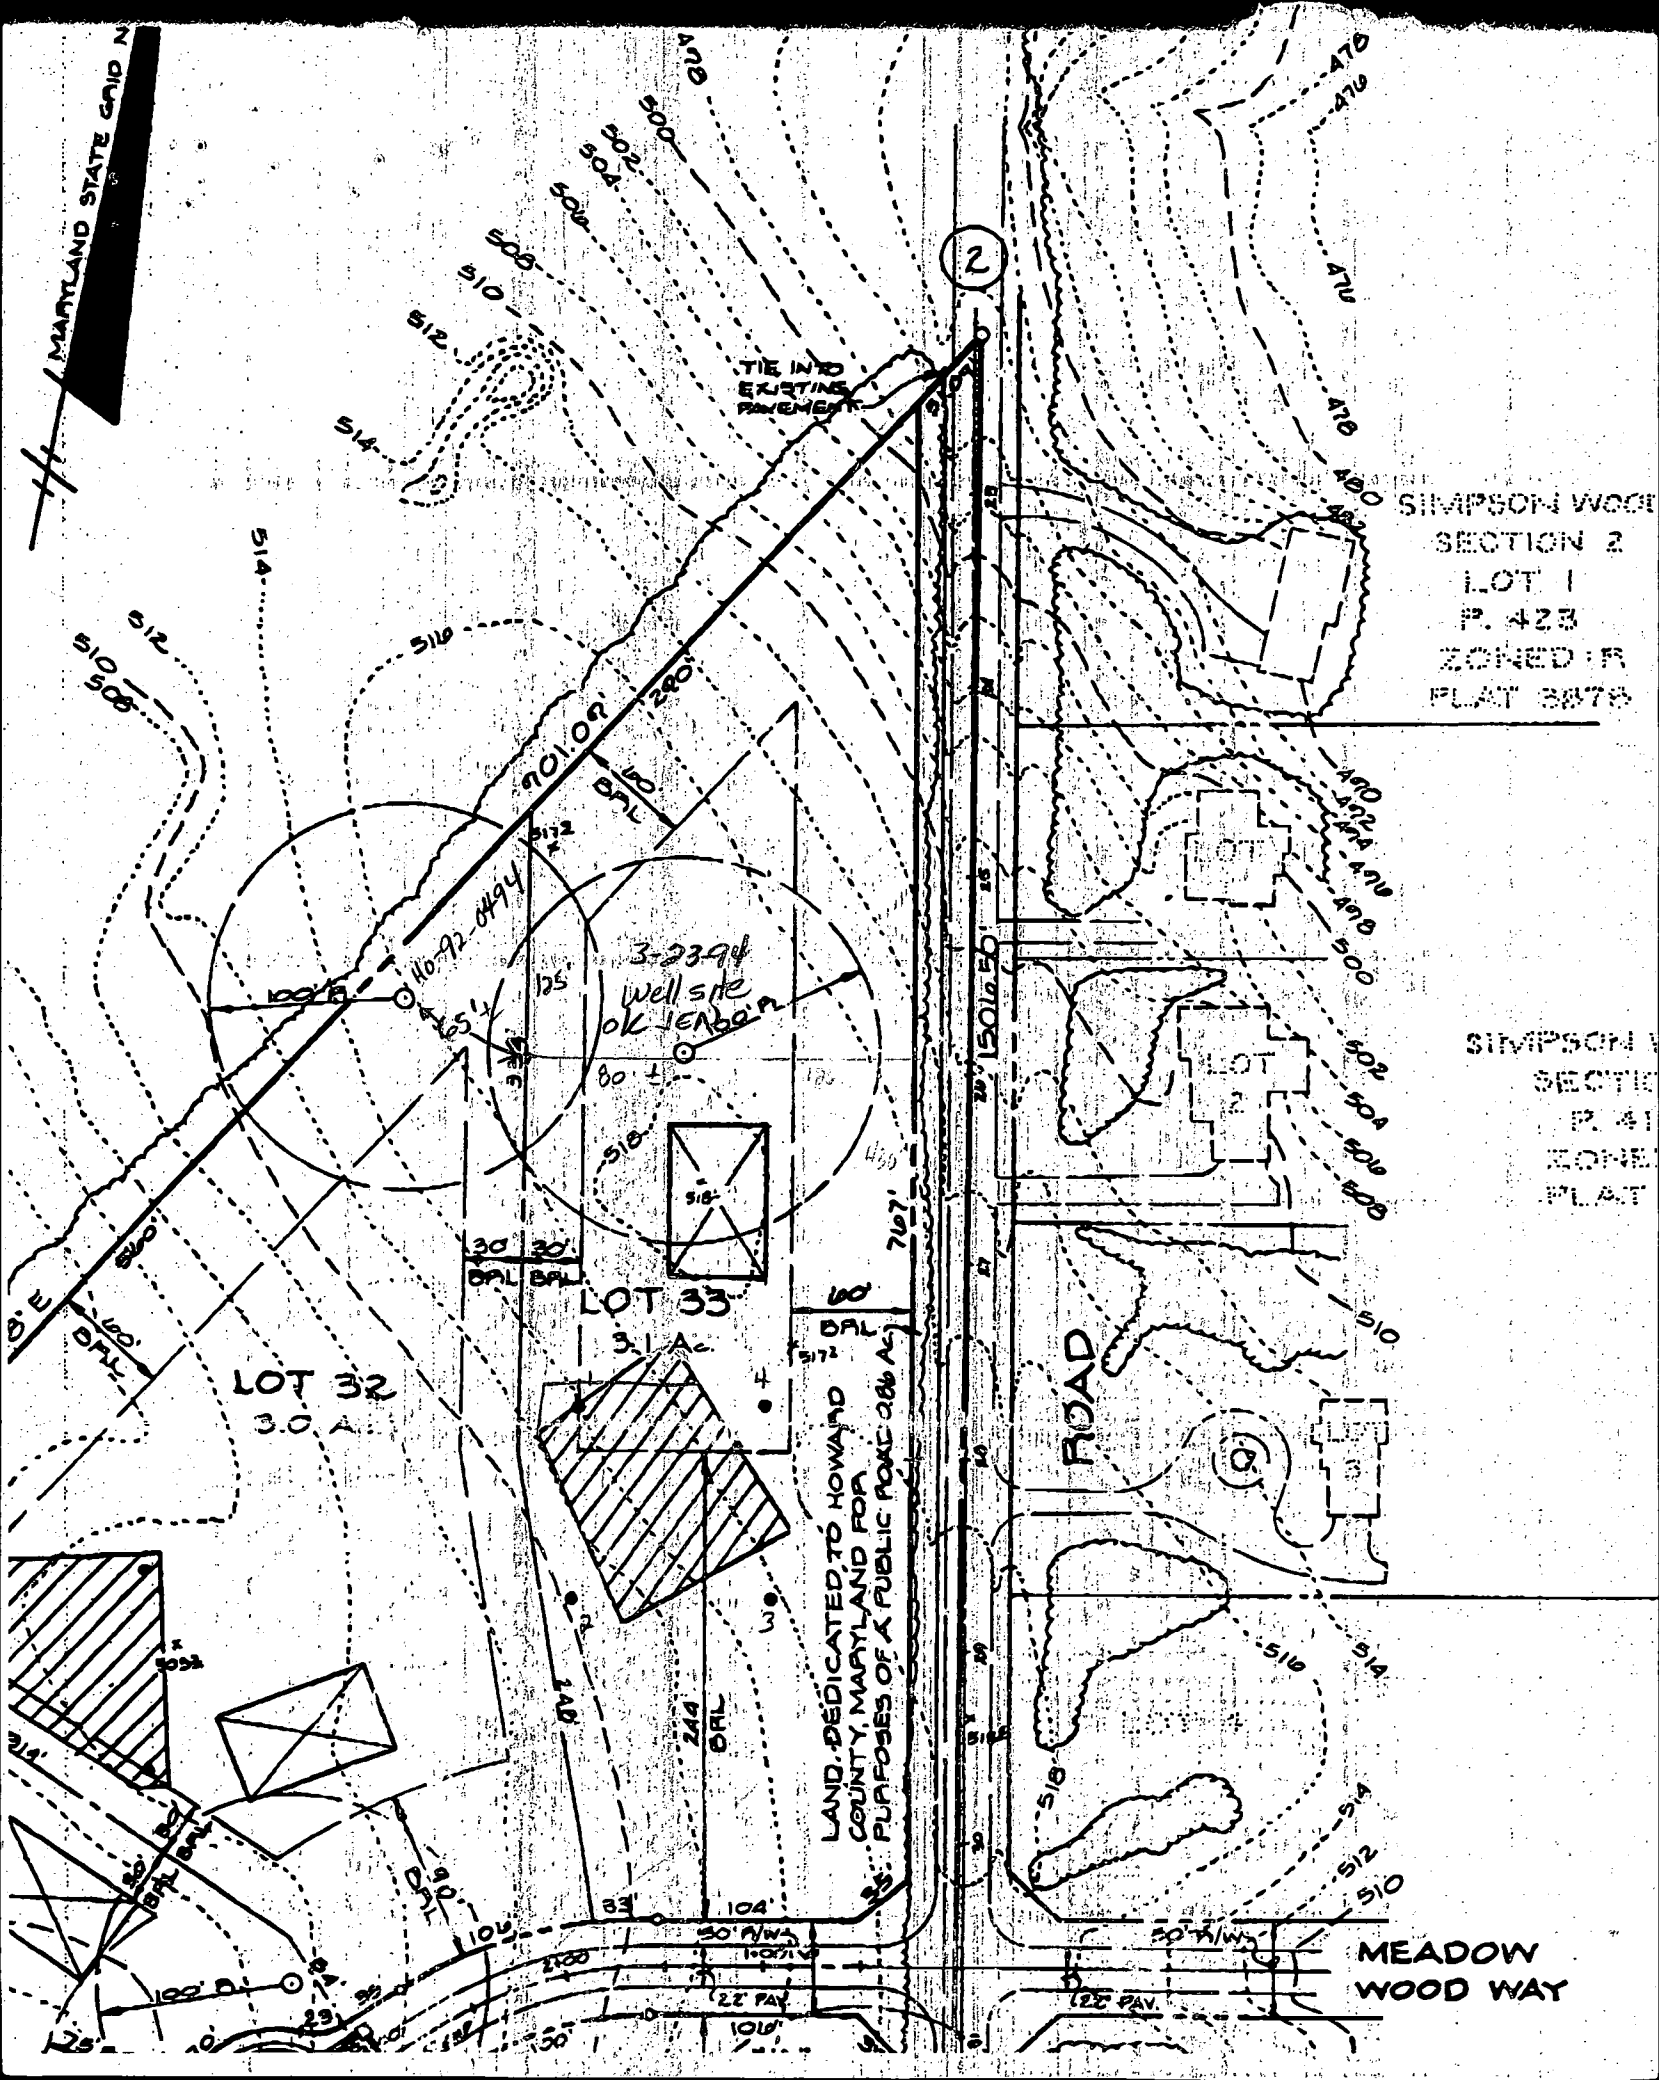



SIMPSON WOOD
SECTION 2
LOT 1
P. 423
ZONED R
PLAT 8878

SIMPSON
SECTION
P. 41
ZONED
PLAT



LAND DEDICATED TO HOWARD
COUNTY, MARYLAND FOR
PURPOSES OF A PUBLIC ROAD 266 AC

MEADOW
WOOD WAY

[illegible]

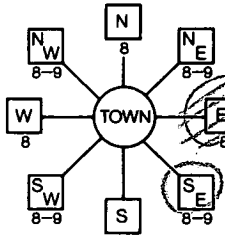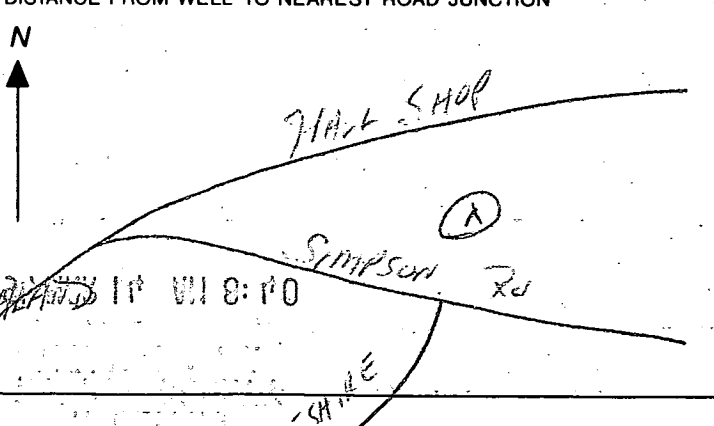B 1 05921 (THIS NUMBER IS TO BE PUNCHED IN COLS. 3-6 ON ALL CARDS)		SEQUENCE NO. (DP USE ONLY) STATE OF MARYLAND PERMIT TO DRILL WELL please print or type		STATE PERMIT NUMBER 10-74-0047 fill in this form completely	
Date Received (APA) 031494 OWNER INFORMATION WINCHESTER HOMES INC 6305 IVY LAKE ST GREENBELT MD 20770			B 3 LOCATION OF WELL HOWARD 8 COUNTY HSHLEIGH 23 SUBDIVISION SECTION 7 LOT 33 HIGHLAND 52 NEAREST TOWN MILES FROM TOWN (enter 0 if in town) 2 MI		
DRILLER INFORMATION George F. Easterday Driller's Name L. Franklin Eastreday, Inc., Firm Name 9265 Brown Church Rd., MT. Airy, Md. 21771 Address George F. Easterday 3-11-94 Signature Date			B 4 DIRECTION OF WELL FROM TOWN (CIRCLE BOX)  NEAR WHAT ROAD DOLLINGFORD CT ON WHICH SIDE OF ROAD (CIRCLE APPROPRIATE BOX) NORTH WEST EAST SOUTH 475 DISTANCE FROM ROAD ENTER FT or MI FT		
B 2 WELL INFORMATION APPROX. PUMPING RATE (GAL. PER MIN.) 5 AVERAGE DAILY QUANTITY NEEDED (GAL. PER DAY) 500			NOT TO BE FILLED IN BY DRILLER HEALTH DEPARTMENT APPROVAL Howard COUNTY NAME STATE SIGNATURE DATE ISSUED 032894 CO SIGNATURE NORTH GRID 187000 EAST GRID 0821000		
USE FOR WATER (CIRCLE APPROPRIATE BOX) ☒ HOME (SINGLE OR DOUBLE HOUSEHOLD UNIT ONLY) ☐ FARMING (LIVESTOCK WATERING & AGRICULTURAL IRRIGATION) ☐ INDUSTRIAL, COMMERCIAL, STATE AND FEDERAL GOV. OTHER (REQUIRES APPROPRIATION PERMIT) ☐ PUBLIC OR PRIVATE WATER COMPANY (REQUIRES APPROPRIATION PERMIT AND STATE HEALTH DEPARTMENT APPROVAL) ☐ TEST, OBSERVATION, MONITORING (MAY REQUIRE APPROPRIATION PERMIT)			SHOW MAJOR FEATURES OF BOX & LOCATE WELL WITH AN X SOURCES OF DRILLING WATER 1 Well 5 2. 3. WRITE THE BOX NUMBER FROM THE MAP HERE 870 480		
APPROXIMATE DEPTH OF WELL 200 FEET APPROXIMATE DIAMETER OF WELL 6 INCH METHOD OF DRILLING (circle one) BORED (or Augered) JETTED Jettied & DRIVEN AIR-ROTARY AIR-PERCussion ROTARY (Hydraulic Rotary) CABLE REVERSE-ROTARY Drive-POINT other			DRAW A SKETCH BELOW SHOWING LOCATION OF WELL IN RELATION TO NEARBY TOWNS AND ROADS AND GIVE DISTANCE FROM WELL TO NEAREST ROAD JUNCTION 		
REPLACEMENT OR DEEPEINED WELLS (CIRCLE APPROPRIATE BOX) ☒ THIS WELL WILL NOT REPLACE AN EXISTING WELL ☐ THIS WELL WILL REPLACE A WELL THAT WILL BE ABANDONED AND SEALED ☐ THIS WELL WILL REPLACE A WELL THAT WILL BE USED AS A STANDBY ☐ THIS WELL WILL DEEPEIN AN EXISTING WELL PERMIT NUMBER OF WELL TO BE REPLACED OR DEEPEINED (IF AVAILABLE)			Not to be filled in by driller (OEP USE ONLY) APPROP. PERMIT NUMBER GAP FORCE UN PERMIT No. 10-74-0047		
SPECIAL CONDITIONS					

COUNTY

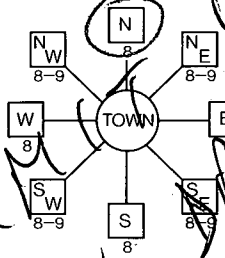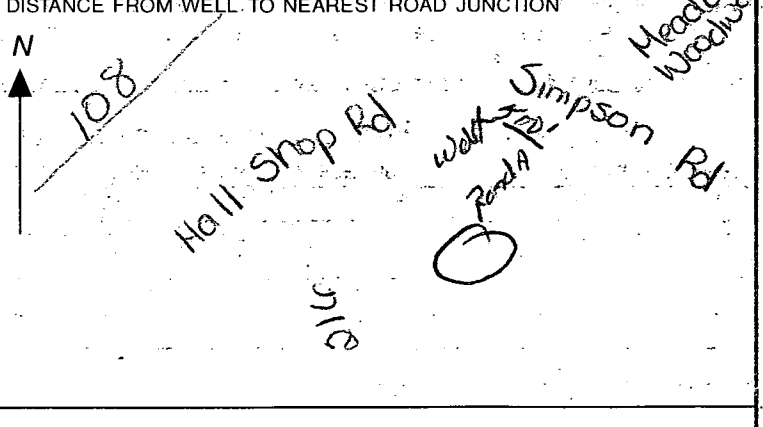B 1 6383 (THIS NUMBER IS TO BE PUNCHED IN COLS. 3-6 ON ALL CARDS)	SEQUENCE NO. (DP USE ONLY)	STATE OF MARYLAND PERMIT TO DRILL WELL please print or type	STATE PERMIT NUMBER 40-88-1284 fill in this form completely
Date Received (APA) 022290		B 3 3 LOCATION OF WELL	
OWNER INFORMATION Winchester Homes Inc 15 Last Name 21 First Name 6701 Rockledge Drive 36 Street or RFD 55 Bethesda Md 20817 57 Town 70 State 72 Zip 76		Howard 8 COUNTY 21 Ashleigh Green Sub 23 SUBDIVISION 42 SECTION 2 LOT 33 44 46 48 50 Clarksville 52 NEAREST TOWN 71 MILES FROM TOWN (enter 0 if in town) 2 M I 73 76 77 78	
DRILLER INFORMATION Frank Delph Driller's Name 77 License No. 80 Frank Delph Well Drillers Inc Firm Name 18234 Penn Shop Rd Mt Airy Md Address Frank Delph 2/19/90 Signature Date		B 4 4 DIRECTION OF WELL FROM TOWN (CIRCLE BOX)  NEAR WHAT ROAD Wallingford Ct 30 ON WHICH SIDE OF ROAD (CIRCLE APPROPRIATE BOX)  DISTANCE FROM ROAD 520 34 37 ENTER FT or MI FT 38 39	
B 2 2 WELL INFORMATION APPROX. PUMPING RATE (GAL. PER MIN.) 5 8 12 AVERAGE DAILY QUANTITY NEEDED (GAL. PER DAY) 500 14 20		NOT TO BE FILLED IN BY DRILLER HEALTH DEPARTMENT APPROVAL Howard 441347 COUNTY NAME COUNTY NO. STATE SIGNATURE Mark E. R. Kin 10/9/90 DATE ISSUED INSERT S 41 040990 0822000 43 48 50 SIGNATURE EXP. DATE NORTH GRID 487000 EAST GRID 0822000 50 55 57 63	
USE FOR WATER (CIRCLE APPROPRIATE BOX) ☒ D HOME (SINGLE OR DOUBLE HOUSEHOLD UNIT ONLY) ☐ F FARMING (LIVESTOCK WATERING & AGRICULTURAL IRRIGATION) ☐ I INDUSTRIAL, COMMERCIAL, STATE AND FEDERAL GOV. OTHER (REQUIRES APPROPRIATION PERMIT) ☐ P PUBLIC OR PRIVATE WATER COMPANY (REQUIRES APPROPRIATION PERMIT AND STATE HEALTH DEPARTMENT APPROVAL) ☐ T TEST, OBSERVATION, MONITORING (MAY REQUIRE APPROPRIATION PERMIT)		SHOW MAJOR FEATURES OF BOX & LOCATE WELL WITH AN X SOURCES OF DRILLING WATER 1. Well 2. 3. WRITE THE BOX NUMBER FROM THE MAP HERE E 822 N 487 000 000	
APPROXIMATE DEPTH OF WELL 20 FEET 24 28 APPROXIMATE DIAMETER OF WELL 6 INCH NEAREST INCH		METHOD OF DRILLING (circle one) BORED (or Augered) <u>JETTED</u> Jetted & DRIVEN AIR-ROTary AIR-PERCussion <u>ROTARY (Hydraulic Rotary)</u> CABLE REVERSE-ROTary Drive-POINT other _____	
REPLACEMENT OR DEEPEMED WELLS (CIRCLE APPROPRIATE BOX) ☒ N THIS WELL WILL NOT REPLACE AN EXISTING WELL ☐ Y THIS WELL WILL REPLACE A WELL THAT WILL BE ABANDONED AND SEALED ☐ S THIS WELL WILL REPLACE A WELL THAT WILL BE USED AS A STANDBY ☐ D THIS WELL WILL DEEPEMED AN EXISTING WELL PERMIT NUMBER OF WELL TO BE REPLACED OR DEEPEMED (IF AVAILABLE) 40-88-1284 41 52		DRAW A SKETCH BELOW SHOWING LOCATION OF WELL IN RELATION TO NEARBY TOWNS AND ROADS AND GIVE DISTANCE FROM WELL TO NEAREST ROAD JUNCTION 	
Not to be filled in by driller (OEP USE ONLY) APPROP. PERMIT NUMBER G A P 54 63 FORCE MA WRITE INITIALS IN BOX PERMIT No. 40-88-1284 67 68 70 71 72 73 74 75 76 77 78 79 SPECIAL CONDITIONS			

HOWARD COUNTY HEALTH DEPARTMENT
Bureau of Environmental Health
3525-H Ellicott Mills Drive
Ellicott City, MD 21043
461-9933

6/13
Fund
UKD

APPLICATION FOR PITLESS ADAPTER, WELL PUMP AND PRESSURE TANK INSTALLATION

New Installation ☒
Replacement ☐

Receipt # _____
Date _____

Name of Installer R.W.R. PLUMBING INC.

Telephone 531-2982

License Number 4605
Certified Well Pump Installer _____

Well Driller _____

Registered Plumber ☒

Name of Property Owner TINA & CHARLES JENNINGS

Telephone 236-5020

Subdivision ASHLEIGH GREENE Lot # 33

Well Tag # HO-94-0049

Site Address 11897 SIMPSON RD

Pump

1. Type

- a. Deep well jet _____
b. Shallow well jet _____
c. Submersible ☒

2. Make RED JACKET

3. Model # 805-015-5

4. Capacity 7 GPM

5. Pump exceeds well capacity Yes _____ No ☒

6. If Yes, is low pressure cutoff switch installed? Yes _____ No ☒

7. What methods are used to protect the pump and electrical wiring from vibrations? Torque arrestors ☒ Cable guards ☒ Other _____

Motor

1. Horsepower 3/4

2. RPM _____

3. Voltage 208/230

- a. 110 _____
b. 220 ☒

Pitless Adapter

1. Make CAMPBELL MARATHON

2. Model # B-300K

3. Depth 42"

Tank WELL & MOT

1. Capacity 203

2. Pressure relief valve? YES

Piping

1. Type BLACK TUBING

2. Size 1"

3. NSF and/or BOCA

Code approved YES

4. Depth of supply

line 4'

Well data

1. Depth 400 ft.

2. Yield 12 GPM

3. Static water level _____ ft.

4. Will water supply be disinfected by installer? NO

I understand that it is my responsibility to notify the Howard County Health Department when the installation is ready for inspection (otherwise this permit is null and void).

All information given above is true to the best of my knowledge.

Signature of Applicant: _____

Date: 6/8/95

Note: A sticker indicating approval/status of the installation will be placed on the well casing at the time of the inspection.

DEPARTMENT OF INSPECTIONS, LICENSES AND PERMITS 3430 COURT HOUSE DRIVE ELICOTT CITY, MD 21043 PERMITS (410) 313-2455 INSPECTIONS (410) 313-1810 AUTOMATED INFORMATION (410) 313-3800	HOWARD COUNTY PERMIT APPLICATION	PERMIT NUMBER B0120148
--	---	----------------------------------

Building Address <u>11895 Simpson Rd</u> <u>Clarksville MD 21029</u>	Property Owner's Name <u>Charles S. Jennings</u> Address <u>11895 Simpson Rd.</u> City <u>Clarksville</u> State <u>MD</u> Zip Code <u>21029</u>
Suite/Apt. # _____ SDP/WP/Patition # _____ Census Tract <u>6051.04</u> Subdivision <u>Delaney Greene</u> Section <u>2</u> Area <u>1</u> Lot <u>33</u> Tax Map <u>41</u> Parcel <u>174</u> Grid <u>8</u> Zoning <u>RR</u> Map Coordinates <u>18H1</u> Lot size _____	Home Phone <u>301-725-8665</u> Work Phone <u>410-515-0788</u> Applicant's Name & Mailing Address, (if other than stated hereon): <u>Kevin T. Delaney</u> <u>2419 Sunset Farm Rd</u> <u>E.C. MD 21042</u> Phone <u>410-461-1797</u> Fax <u>Same</u>
Existing Use <u>SFD</u> Proposed Use <u>SFD w/ room over Garage finished</u> Estimated Construction Cost \$ <u>9,000.00</u> Description of Work <u>Install bathroom and</u> <u>family room above existing</u> <u>garage</u>	Contractor Company <u>Delaney Construction</u> Contact Person <u>Kevin T. Delaney</u> Address <u>2419 Sunset Farm Rd</u> City <u>E.C.</u> State <u>MD</u> Zip Code <u>21042</u> License No. <u>28513</u> Phone <u>410-461-1797</u> Fax <u>410-461-1797</u>
Occupant or Tenant <u>Same as owner</u> Contact Name _____ Address _____ City _____ State _____ Zip Code _____ Phone _____ Fax _____	Engineer or Architect Company <u>Same as above</u> Contact Person _____ Address _____ City _____ State _____ Zip Code _____ Phone _____ Fax _____

BUILDING DESCRIPTION - COMMERCIAL		BUILDING DESCRIPTION - RESIDENTIAL	
Building Characteristics Height: _____ No. of stories: _____ Gross area, sq. ft. per floor: _____ Use group: _____ Construction type: ☐ Reinforced Concrete ☐ Structural Steel ☐ Masonry ☐ Wood Frame ☐ State Certified Modular	Utilities Water Supply: _____ ☒ Public ☒ Private Sewage Disposal: _____ ☒ Public ☒ Private Electric Yes ☒ No ☐ Gas Yes ☐ No ☐ Heating System: Electric ☒ Oil ☐ Natural Gas ☐ Propane Gas ☐ Sprinkler system: N/A ☐ ☐ Full ☐ Partial ☐ Other Suppression # of Heads _____	Building Characteristics SF Dwelling ☐ SF Townhouse ☐ Depth _____ Width _____ 1st floor: _____ 2nd floor: _____ Basement: _____ Finished Basement ☐ Unfinished Basement ☐ Crawl space ☐ Slab on Grade ☐ No. of Bedrooms: _____ Multi-family dwellings: No. of efficiency units: _____ No. of 1 BR units: _____ No. of 2 BR units: _____ No. of 3 BR units: _____ Other Structure: _____ Dimensions: _____ Footings: _____ Roof: _____ ☐ State Certified Modular ☐ Manufactured Home	Utilities Water Supply: _____ ☒ Public ☒ Private Sewage Disposal: _____ ☒ Public ☒ Private Electric Yes ☐ No ☐ Gas Yes ☐ No ☐ Heating System: Electric ☐ Oil ☐ Natural Gas ☐ Propane Gas ☐ Sprinkler system: N/A ☐ ☐ NFPA #13D ☐ NFPA #13R ☐ Other: _____

THE UNDERSIGNED HEREBY CERTIFIES AND AGREES AS FOLLOWS: (1) THAT HE/SHE IS AUTHORIZED TO MAKE THIS APPLICATION; (2) THAT THE INFORMATION IS CORRECT; (3) THAT HE/SHE WILL COMPLY WITH ALL REGULATIONS OF HOWARD COUNTY WHICH ARE APPLICABLE THEREON; (4) THAT HE/SHE WILL PERFORM NO WORK ON THE ABOVE REFERENCED PROPERTY NOT SPECIFICALLY DESCRIBED IN THIS APPLICATION; (5) THAT HE/SHE GRANTS COUNTY OFFICIALS THE RIGHT TO ENTER ONTO THIS PROPERTY FOR THE PURPOSE OF INSPECTING THE WORK PERMITTED AND POSTING NOTICES.

Applicant's Signature <u>Kevin T. Delaney</u> Title/Company <u>Owner of Delaney Construction</u>	Print Name <u>Kevin T. Delaney</u> Date <u>8/26/99</u>
---	---

Checks payable to: <u>DIRECTOR OF FINANCE OF HOWARD COUNTY</u> **PLEASE WRITE NEATLY AND LEGIBLY** FOR OFFICE USE ONLY	AGENCY <u>Land Development DPZ</u> DATE <u>8/26/99</u> SIGNATURE APPROVAL <u>[Signature]</u> State Highways _____ Building Official <u>[Signature]</u> Dev. Engineering DPZ <u>8/28/99</u> <u>[Signature]</u> Health _____ Fire Protection _____ Is Sediment Control approval required prior to issuance? YES ☐ NO ☒ CONTINGENCY CONSTRUCTION START: ☐ ONE STOP SHOP: ☐	DPZ SETBACK INFORMATION Front: _____ Rear: _____ Side: _____ Side St.: <u>SVF</u> All minimum setbacks met? YES ☐ NO ☐ Is Entrance Permit required? YES ☐ NO ☐ Historic District? YES ☐ NO ☐ Lot Coverage for New Town Zone _____ SDP/Red-line approval date _____	PROPERTY ID#: <u>10210</u> Filing fee \$ _____ Permit fee \$ <u>68</u> Excise tax \$ _____ Sub-total paid \$ _____ Add'l permit fee \$ _____ TOTAL FEES \$ <u>107</u> Balance due \$ _____ Check # <u>10000</u> Validation # <u>10000</u>
--	--	---	--

Distribution of Copies: _____	White: Building Official	Green: LDD, DPZ	Yellow: DED, DPZ	Pink: Health	Gold: SHA
-------------------------------	--------------------------	-----------------	------------------	--------------	-----------

Jennings Existing Conditions

Charles S. Jennings

8/26/09 Proposed addition

11895 Simpson Rd

of one bedroom may adversely impact life of ex septic system

Clarksville MD 2102

OK to proceed w/ this caution Mr. Delaney shall notify owner.

301-725-8665

APPROVED
SMOKE DETECTORS
SHALL BE PROVIDED IN ALL BEDROOMS.

