

2/7/00 2/8
213000

PERMIT

03-283569

SEWAGE DISPOSAL SYSTEM

DEPARTMENT OF HEALTH AND MENTAL HYGIENE

INDEXED

P 513205

A 41430

DISTRICT _____

DATE 1/3/00

DATE SYSTEM APPROVED 2/8/00

INSPECTOR CW

HOWARD COUNTY HEALTH DEPARTMENT

BUREAU OF ENVIRONMENTAL HEALTH

461-9933 313-2640

South Carroll Backhoe, Inc.

IS PERMITTED TO INSTALL X ALTER _____

ADDRESS 4410 Salem Bottom Road Westminster, MD 21757 PHONE (410) 875-4197

SUBDIVISION King's Gift LOT 26 ROAD 11616 WEST WINCHESTER LANE
11748 Frederick Road

PROPERTY OWNER David Farrell

ADDRESS _____

SEPTIC TANK CAPACITY 1500 GALLONS REQUESTED BY OWNER

NUMBER OF BEDROOMS 4

180 SQUARE FEET PER BEDROOM

LINEAR FEET OF TRENCH REQUIRED 240

TRENCHES - Trench to be 3 feet wide. Inlet 3 feet below original grade. Bottom maximum depth 5 feet below original grade. Effective area begins at 3 feet below original grade. 2 feet of stone below distribution pipe.

LOCATION - Starting from the lot corner at the end of the flagstem driveway, start the first trench 325 feet down the left (South) lot line and 250 feet off this same lot line. Trenches along contour in both directions.

NOTES - No trench to exceed 100 feet in length. Provide 6" - 8" diameter cleanout and cap to grade or above on septic tank.

PLANS APPROVED BY C. Williams/Mark Rifkin/Amy McMillen DATE 12/15/99

COVER NO WORK UNTIL INSPECTED AND APPROVED

NEITHER THE HOWARD COUNTY COUNCIL NOR THE HEALTH DEPARTMENT IS RESPONSIBLE FOR THE SUCCESSFUL OPERATION OF ANY SYSTEM

NOTE: CLEANOUT REQUIRED EVERY 70 FEET OF SEWER LINE AND/OR AT 90° SWEEPS IN LINES FROM HOUSE TO DRAIN FIELDS, 90° ELBOWS NOT ACCEPTABLE.

NOTE: ALL PARTS OF SEPTIC SYSTEMS (I.E. TANK, DISTRIBUTION BOX TRENCHES) TO BE 100 FEET FROM WELL (UNLESS OTHERWISE SPECIFICALLY AUTHORIZED)

NOTE: IF DEEP TRENCH(ES) ARE USED CALL FOR INSPECTION BEFORE AND AFTER PLACING GRAVEL IN TRENCH(ES)

NOTE: NO DRY WELL SHALL EXCEED 15 FOOT IN DIAMETER NO ABSORPTION TRENCH TO EXCEED 100 FEET IN LENGTH

NOTE: ALL PIPE FROM HOUSE TO SEPTIC TANK MUST BE CAST IRON OR SCHEDULE 35/40 PVC OR ABS

PERMIT VOID AFTER TWO YEARS

NOTE: INSTALL STAND PIPE ON SEPTIC TANK AND DRY WELL STAND PIPES MUST BE 6 INCHES IN DIAMETER CAST IRON, CONCRETE OR TERRA COTTA OR PVA OR ABS ACCEPTED. IF TOP OF SEPTIC TANK IS DEEPER THAN 3 FEET, MANHOLE TO GRADE REQUIRED.

NOTE: DISTRIBUTION BOXES MUST HAVE BAFFLES

*INSTALLER IS RESPONSIBLE FOR OBTAINING FINAL APPROVAL ON THIS PERMIT

41430

Wet Season
Retest
OK Deep Low Hole

APPLICATION

PERCOLATION TESTING

A 41430

P _____

HOWARD COUNTY HEALTH DEPARTMENT
BUREAU OF ENVIRONMENTAL HEALTH
P.O. BOX 476 ELLICOTT CITY, MARYLAND 21043
TELEPHONE: 461-9933

DISTRICT 3

DATE 4/6/88
10 March, 1988

TO: THE COUNTY HEALTH OFFICER
ELLICOTT CITY, MARYLAND

I HEREBY, APPLY FOR THE NECESSARY TEST IN ORDER TO CONSTRUCT OR RECONSTRUCT A SEWAGE DISPOSAL SYSTEM.

PROPERTY OWNER DAVID FARRELL
Jean R. Dickey, Individually; Jean R. Dickey, Trustee Jean R. Dickey Inter-Vivos
TRUST

ADDRESS 13850 Forsythe Rd., Sykesville, Md 21784 PHONE (301) 442-2226

PROSPECTIVE BUYER _____

ADDRESS _____ PHONE _____

PROPERTY LOCATION:

SUBDIVISION King's Gift LOT NO. 26

ROAD AND DESCRIPTION North on Route 144, East of Thompson Drive
(11748 FREDERICK ROAD)

TAX MAP 16 PARCEL # 343

SIZE OF LOT 5.259 Ac± TYPE BLDG. Single Family Dwelling
(SINGLE FAMILY DWELLING OR COMMERCIAL)

~~EXIST. PERMIT SIGNED~~
AND RETURNED 7-12-89
Serial # 218117989
4Bm

THE SYSTEM INSTALLED UNDER THIS APPLICATION IS ACCEPTABLE ONLY UNTIL PUBLIC FACILITIES BECOME AVAILABLE. I FULLY UNDERSTAND THE
FEE CONNECTED WITH THE FILING OF THIS PERC TEST APPLICATION IS NON-REFUNDABLE UNDER ANY CIRCUMSTANCES. I ALSO AGREE TO COMPLY
WITH ALL M.O.S.H.A. REQUIREMENTS IN TESTING THIS LOT. Richard F. Lane (Agent)
(SIGNATURE OF APPLICANT)

APPROVED BY _____ FOR _____ DATE _____

REJECTED BY _____ FOR _____ DATE _____

HOLD PENDING FURTHER TESTS _____ DATE _____

REASONS FOR REJECTION OR HOLDING 7/5/88 PERC OK HOLD FOR PLAT

& NOTE LOT LINES MUST BE CHANGED TO
SWIT AREA THAT PASSED PERC TEST R14

THIS IS NOT A PERMIT

[illegible]

to be
charged
from
original
test
plate

INDICATE NORTH - NAME ADJOINING ROADWAY AS
BASE LINE.

[illegible]

EH

APR 20 1964

REMARKS

TYPE OF SOI

TESTED BY

Held 1234 Not durch seinen Stolz.

TYPE OF SOIL *loamier to be changed to provide*
house *DAVE*
TECH BY *R. HODGES* ALSO PRESENT *O. KETTER*

ALSO PRESENT

O KETTERMAN

2008
HOLD WET SEASON
RETEST
ON DEEP COW HOLE

APPLICATION

PERCOLATION TESTING

A 41429

P _____

HOWARD COUNTY HEALTH DEPARTMENT
BUREAU OF ENVIRONMENTAL HEALTH
P.O. BOX 476 ELLICOTT CITY, MARYLAND 21043
TELEPHONE: 461-9933

DISTRICT 3

DATE 4/6/88
10 March, 1988

TO: THE COUNTY HEALTH OFFICER
ELLICOTT CITY, MARYLAND

I HEREBY APPLY FOR THE NECESSARY TEST IN ORDER TO CONSTRUCT (OR RECONSTRUCT) A SEWAGE DISPOSAL SYSTEM.

PROPERTY OWNER Jean R. Dickey, Individually; Jean R. Dickey, Trustee Jean R. Dickey Inter-Vivos
TRUST

ADDRESS 13850 Forsythe Rd., Sykesville, Md 21784 PHONE (301) 442-2226

PROSPECTIVE BUYER _____

ADDRESS _____ PHONE _____

PROPERTY LOCATION:

SUBDIVISION King's Gift LOT NO. 26

ROAD AND DESCRIPTION North on Route 144, East of Thompson Drive

TAX MAP 16 PARCEL # 342

SIZE OF LOT 5.067 Ac. ± TYPE BLDG. Single Family Dwelling
(SINGLE FAMILY DWELLING OR COMMERCIAL)

THE SYSTEM INSTALLED UNDER THIS APPLICATION IS ACCEPTABLE ONLY UNTIL PUBLIC FACILITIES BECOME AVAILABLE. I FULLY UNDERSTAND THE
FEE CONNECTED WITH THE FILING OF THIS PERC TEST APPLICATION IS NON-REFUNDABLE UNDER ANY CIRCUMSTANCES. I ALSO AGREE TO COMPLY
WITH ALL M.O.S.H.A. REQUIREMENTS IN TESTING THIS LOT. Richard M. Linn (Signature)
(SIGNATURE OF APPLICANT)

APPROVED BY _____ FOR _____ DATE _____

REJECTED BY _____ FOR _____ DATE _____






HOLD PENDING FURTHER TESTS _____ DATE _____

REASONS FOR REJECTION OR HOLDING 6/24/88 PERC OK HOLD FOR PLAT R/H

THIS IS NOT A PERMIT

KINGS GIFT LOT 25

SOIL PROFILE

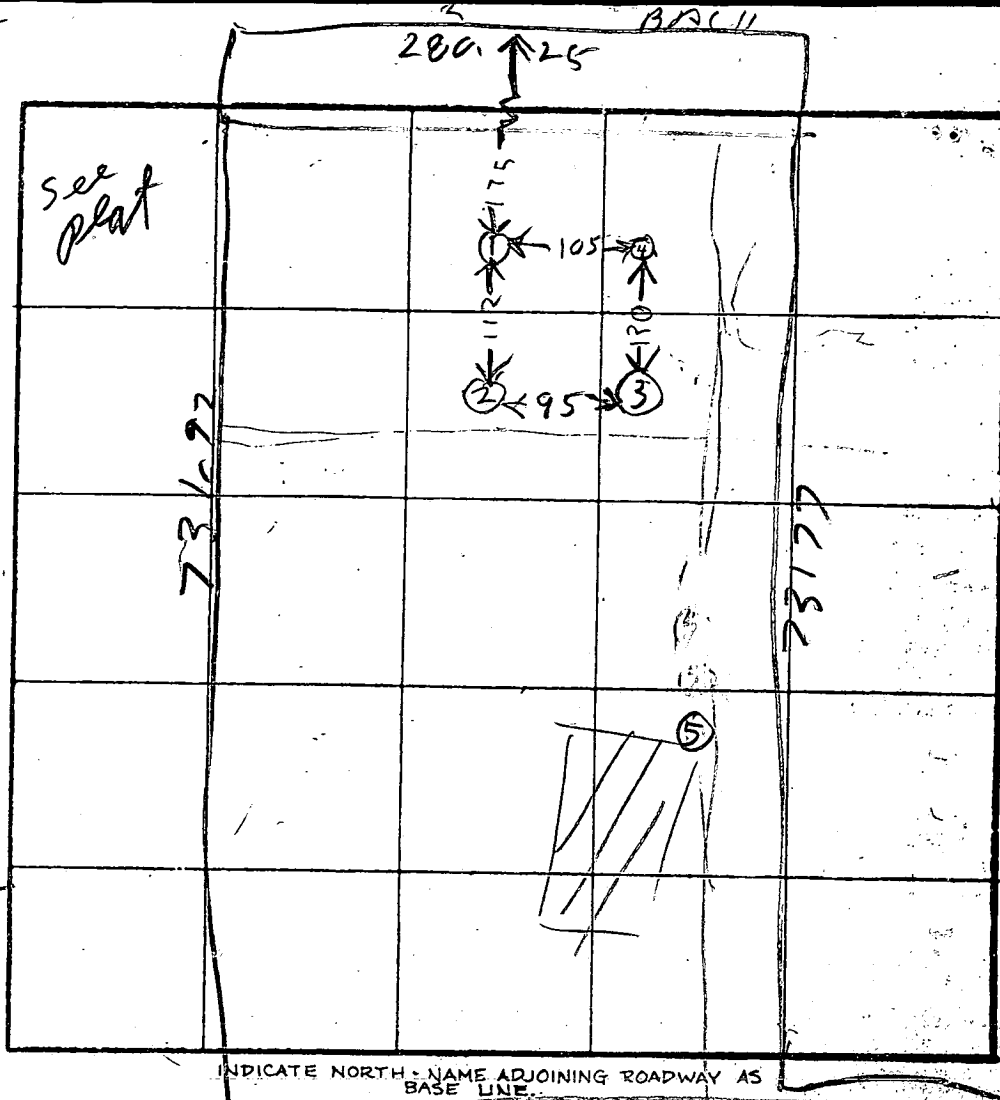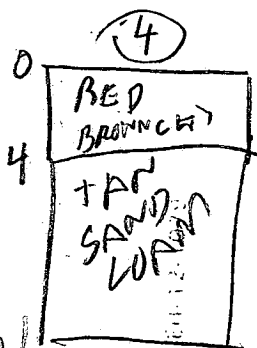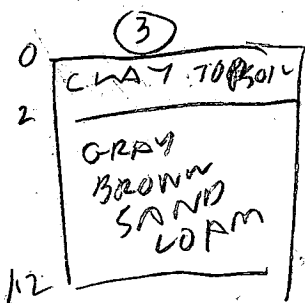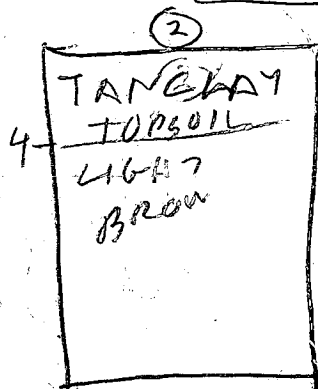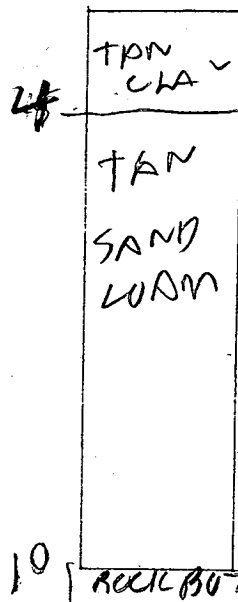


129
25
635
254
3175
X Penc
16 min
250 #/BA
INTER
3:5
BOTTOM
5.0'

DATE	TEST NO.	DEPTH	PRE-WET		TEST - 1" DROP		TIME
			START	STOP	START	STOP	
6/24/88	1S	5	1012	1033	1033	1058	25
	1N	7	1013	1016	1016	1021	5
6/24/88	1V	10	OK				
	2S	5	1014	1035	1035	1000	25
	2V	11	OK				
	3S	4	1025	1028	1028	1036	8
	3V	12	OK				
	4V	11	OK				
	5V	9	WATER	7 FT	UNSAT		


REMARKS: Holes ①②③④ not dug per surveyor plat to 4'
⑤ dug per surveyor plat

TYPE OF SOIL: R. HUGHES
TESTED BY: R. HUGHES
ALSO PRESENT: OKETTER MIN. CO.


KINGS GIFT LOT NEW 26

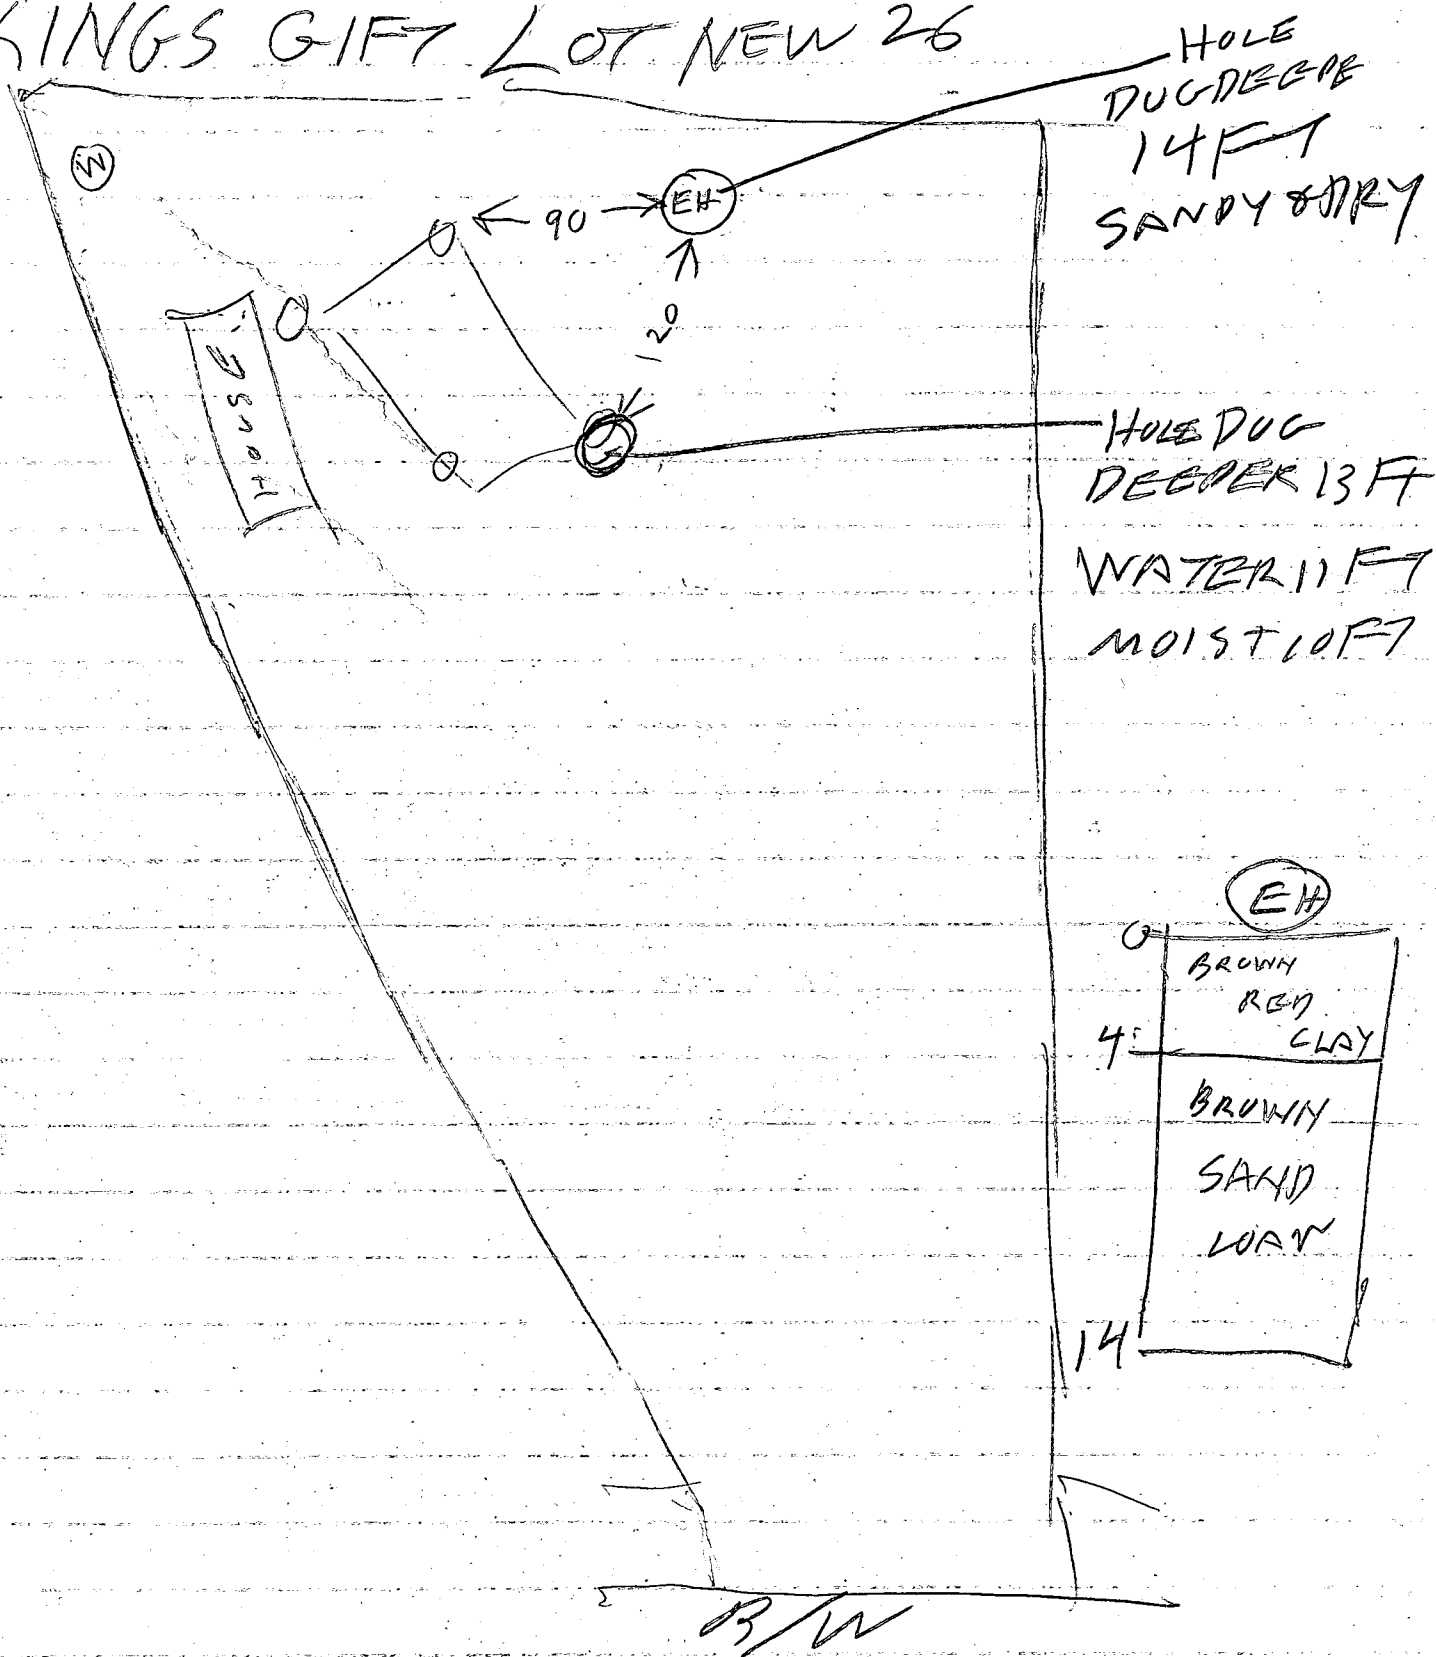

Test By R. Hodges also present O. Ketterman

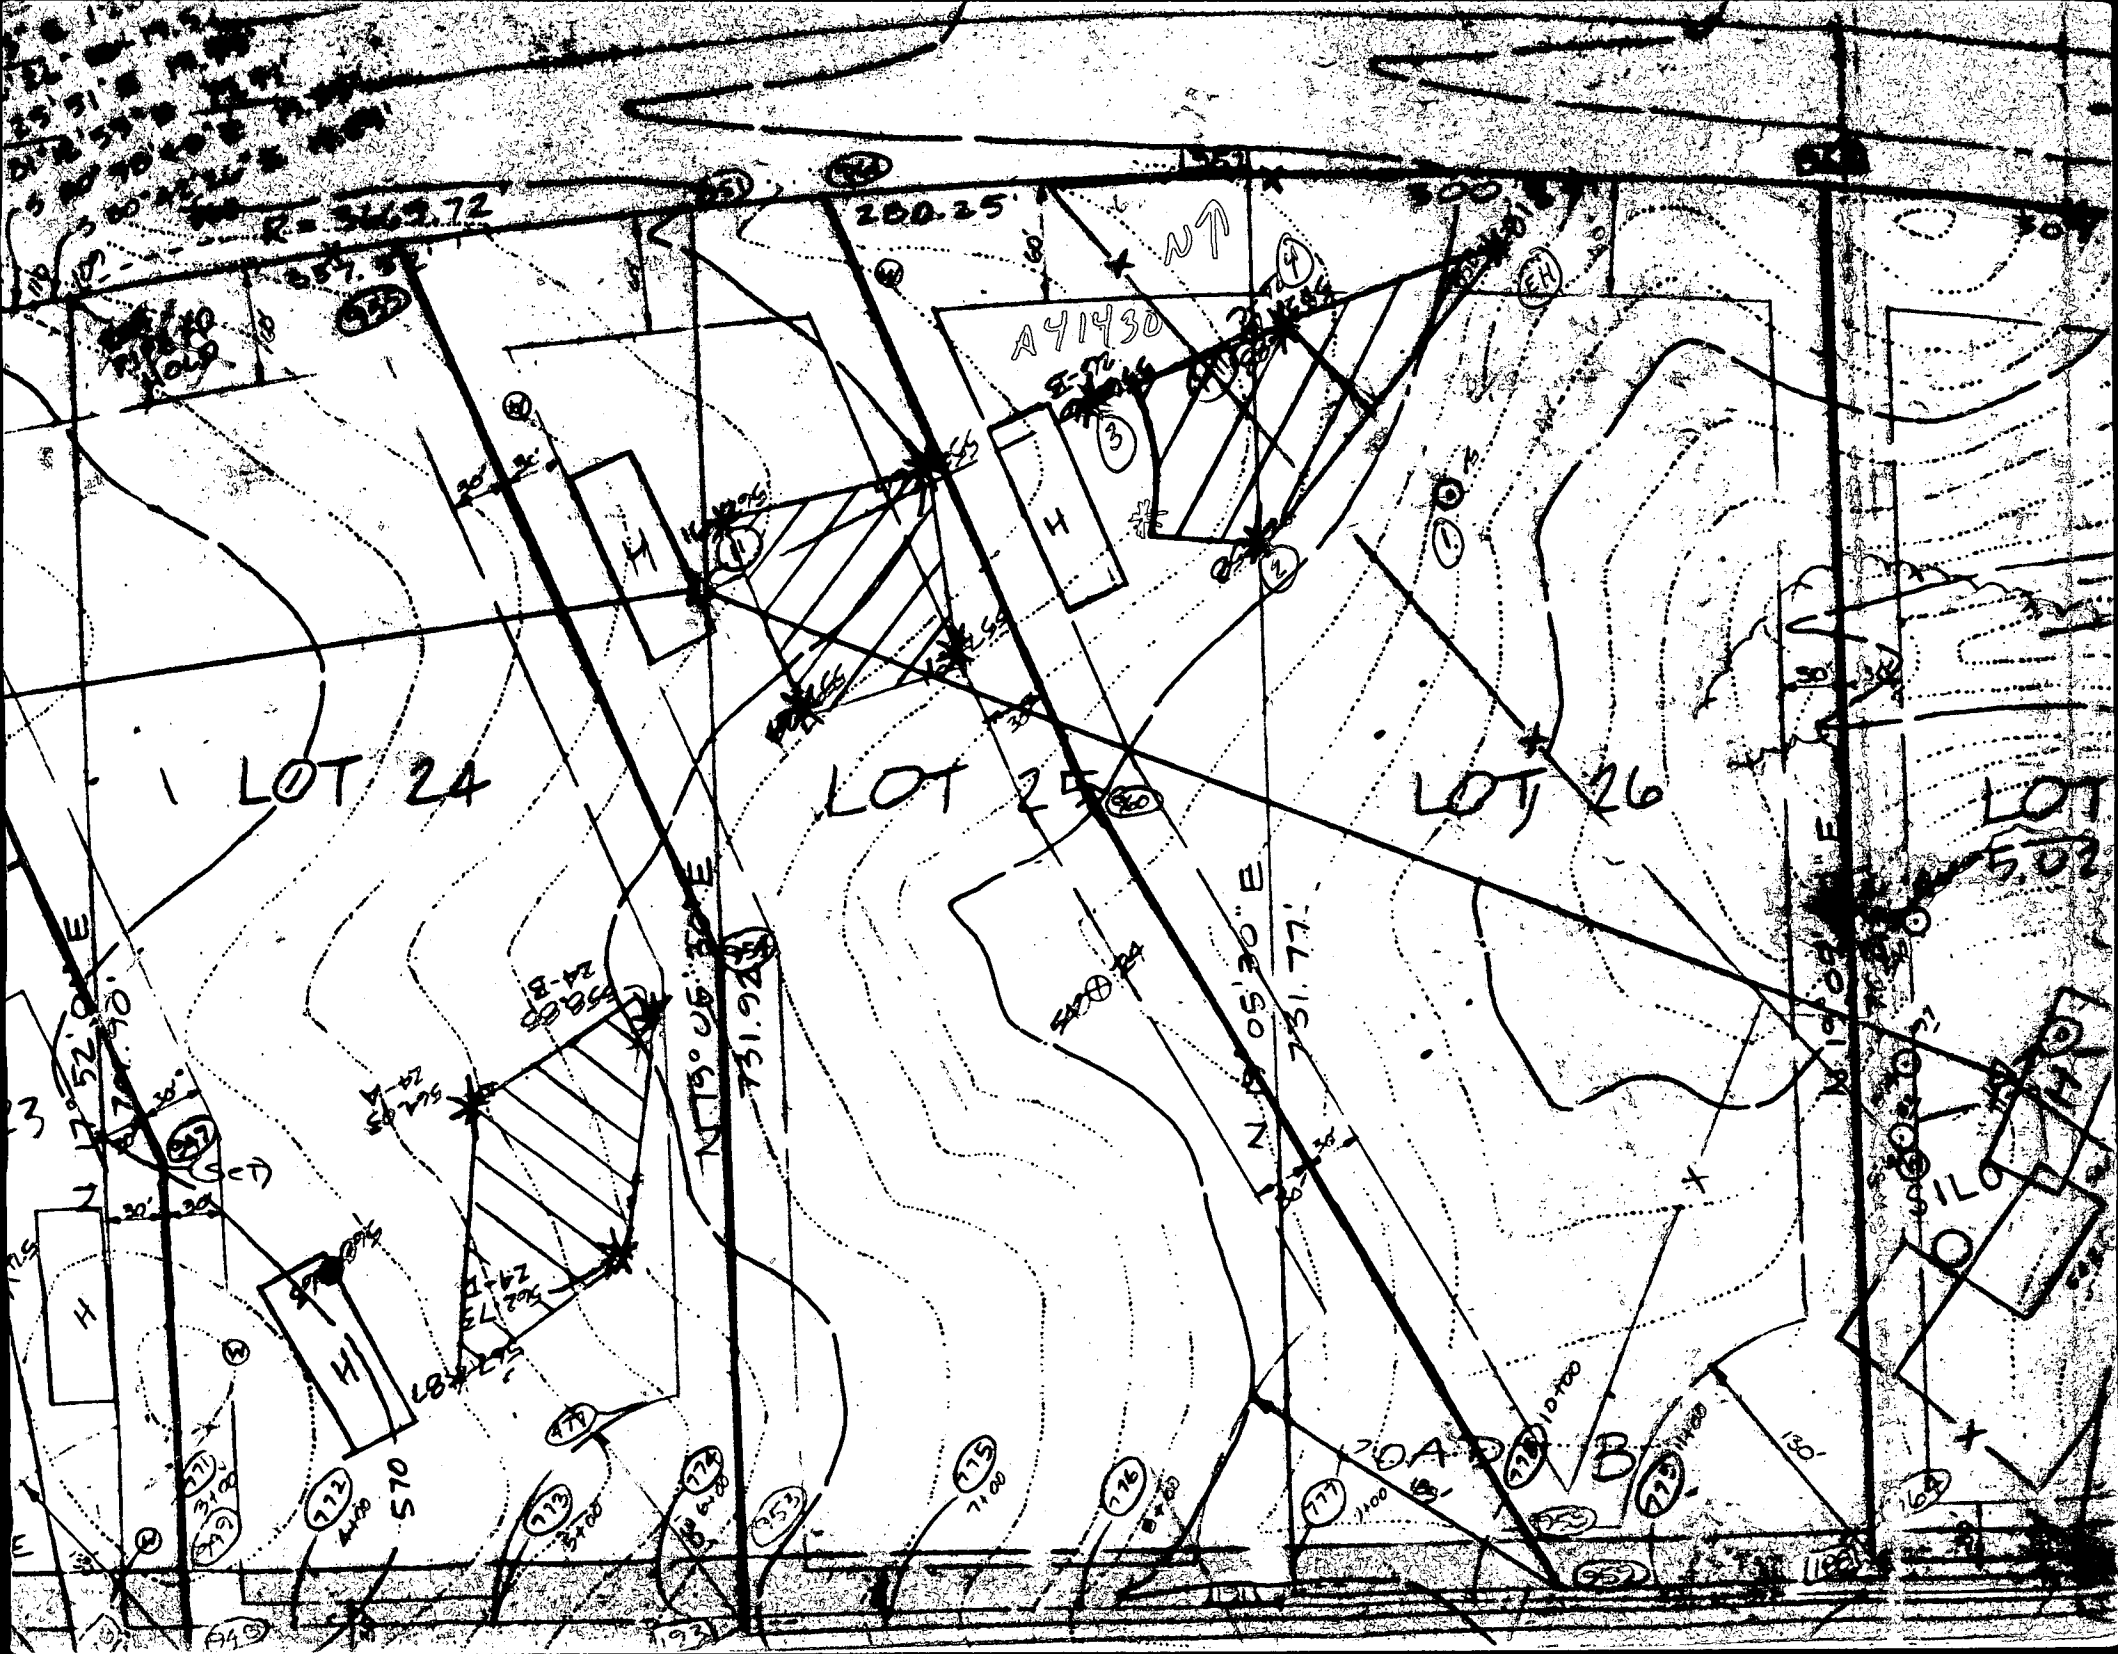

BING'S GIFT LOT NEW 25

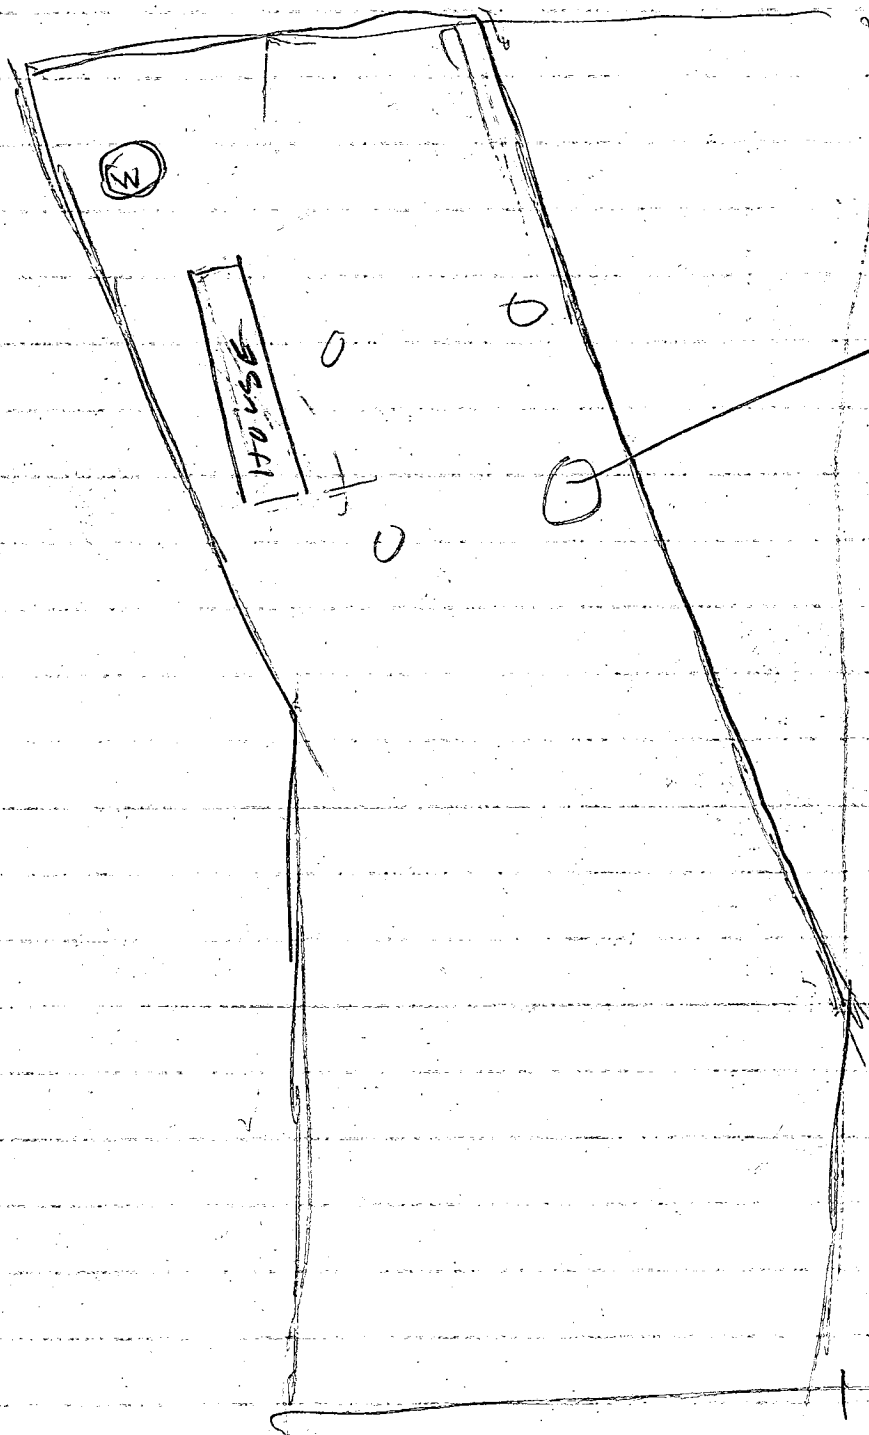

HOLE NO 6 - 14 FT DEEP
SANDY & DRY
10/5/88
RH

Test By R. Hodges

Also Present to Kellerman

Total linear feet of trench
required 240 feet

Width of trench(es) 75' 3.0 feet

Depth of trench(es) 5.0 feet

Depth of stone required below
distribution pipe 2.0 feet

$\Delta 1.191N$

A=743.10'

Ex Elev e 292'
Inn into DB 289'
Inn out ST 289.3'
In In st 289.6'
Inn out house 291.0'

416±

(26)

6.2015 acs.±

Approved Septic System Plan
Howard County Health Department
REVISED HOUSE LOCATION

Signature

Date

12/15/93 B.R.L.

S72°44'44"E

30' B.R.L.

117'

286

284

282

280

286

284

282

133'

286

284

282

0