

10/8/92 AM

Tax ID 05-412919

PERMIT

SEWAGE DISPOSAL SYSTEM

DEPARTMENT OF HEALTH AND MENTAL HYGIENE

P 48581

A 42058

DISTRICT 5th

DATE 10/8/92

DATE SYSTEM APPROVED 10/29/92

INSPECTOR C. W. H. H.

HOWARD COUNTY HEALTH DEPARTMENT BUREAU OF ENVIRONMENTAL HEALTH

461-9933 313-2640

INDEXED

Jack Fyock Septic Service

IS PERMITTED TO INSTALL X ALTER

ADDRESS 13775 Triadelphia Road, Glenelg, Maryland 21737 PHONE 988-9270

SUBDIVISION Rutherford LOT 13 ROAD 4512 Rutherford Way

PROPERTY OWNER Pulte Home Corporation / Hill / Kettner
BRADEN GIBSON

ADDRESS

SEPTIC TANK CAPACITY 1250 GALLONS

NUMBER OF BEDROOMS 4

180 SQUARE FEET PER BEDROOM

LINEAR FEET OF TRENCH REQUIRED 180

BUILDING PERMIT SIGNED
AND RETURNED 4/10/97
Serial # B0104931
detached garage

TRENCHES - Trench to be 2 feet wide. Inlet 4 feet below original grade. Bottom maximum depth 8 feet below original grade. Effective area begins at 4 feet below original grade. 4 feet of stone below distribution pipe.

LOCATION - Place the distribution box 160 feet from the front lot line and 125 feet from the right lot line. Run trenches along contour toward right lot line.

NOTES - No trench to exceed 100 feet in length. Provide 6" - 8" diameter cleanout and cap to grade or above on septic tank. OK 7/31/92

PLANS APPROVED BY Ronald J. Pinkley DATE 8/16/91

COVER NO WORK UNTIL INSPECTED AND APPROVED

NEITHER THE HOWARD COUNTY COUNCIL NOR THE HEALTH DEPARTMENT IS RESPONSIBLE FOR THE SUCCESSFUL OPERATION OF ANY SYSTEM

NOTE: CLEANOUT REQUIRED EVERY 70 FEET OF SEWER LINE AND/OR AT 90° SWEEPS IN LINES FROM HOUSE TO DRAIN FIELDS, 90° ELBOWS NOT ACCEPTABLE.

NOTE: ALL PARTS OF SEPTIC SYSTEMS (I.E. TANK, DISTRIBUTION BOX TRENCHES) TO BE 100 FEET FROM BUILDING (SEE SECTION 101.01) UNLESS OTHERWISE AUTHORIZED)

NOTE: IF DEEP TRENCH(ES) ARE USED CALL FOR INSPECTION BEFORE AND AFTER PLACING GRAVEL IN TRENCH(ES)

NOTE: NO DRY WELL SHALL EXCEED 15 FOOT IN DIAMETER NO ABSORPTION TRENCH TO EXCEED 100 FEET IN LENGTH

NOTE: ALL PIPE FROM HOUSE TO SEPTIC TANK MUST BE CAST IRON OR SCHEDULE 35/40 PVC OR ABS

PERMIT VOID AFTER TWO YEARS

NOTE: INSTALL STAND PIPE ON SEPTIC TANK AND DRY WELL STAND PIPES MUST BE 6 INCHES IN DIAMETER CAST IRON. CONCRETE OR TERRA COTTA OR PVA OR ABS ACCEPTED. IF TOP OF SEPTIC TANK IS DEEPER THAN 3 FEET. MANHOLE TO GRADE REQUIRED.

NOTE: DISTRIBUTION BOXES MUST HAVE BAFFLES

***INSTALLER IS RESPONSIBLE FOR OBTAINING FINAL APPROVAL ON THIS PERMIT**


HD-260(6-90)

*CALL 461-9933 FOR INSPECTION OF SEPTIC SYSTEM.

BUILDING PERMIT SIGNED
AND RETURNED

4/10/97 800/153041-FINISH BASEMENT

A
42058

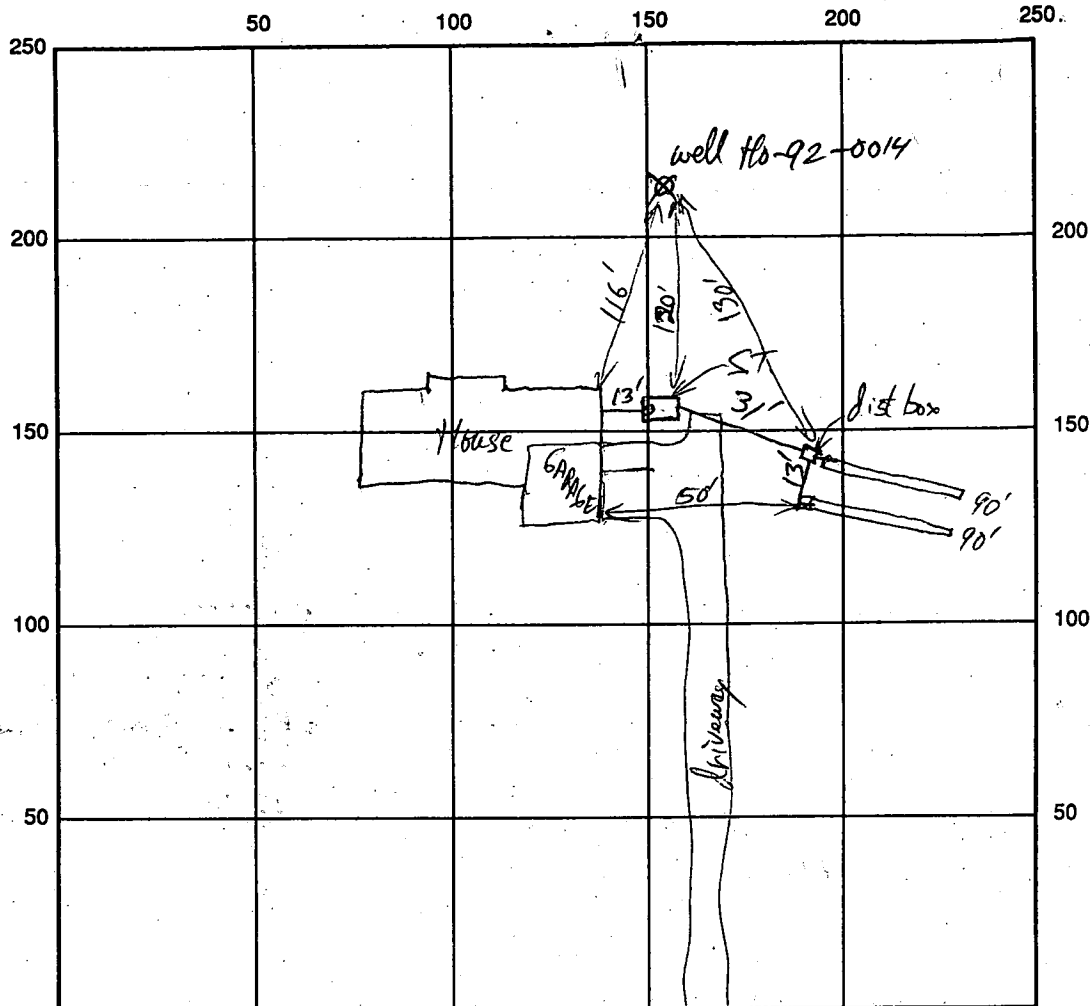

INDICATE NORTH - NAME ADJOINING ROADWAY AS BASE LINE

SEPTIC TANK LEVEL 1250 gnl CLEANOUTS ✓

DISTRIBUTION BOX LEVEL ✓

DRAIN FIELD/TITLE DEPTH 8 FT. TRENCH WIDTH 2 FT. INLET DEPTH 4 FT.

EFFECTIVE GRAVEL DEPTH 4 FT. TOTAL LENGTH 90' / 90' FT.

NUMBER OF TRENCHES 2 ONE SIDEWALL/BOTTOM AREA 220 SQ. FT.

DRYWALL INSIDE DIAMETER _____ FT. EFFECTIVE DEPTH BELOW INLET _____ FT.

ABSORBENT AREA _____ SQ. FT.

REMARKS: Trenches ok gravel fill + depth - ok to have trenches + S.T. - Still Need House Connection
10/29/92 House connection ok. CW
10/29/92

DATE SYSTEM APPROVED 10/29/92 INSPECTOR CW

BP 43066

ELEVATIONS OK

BASEMENT SERVICE NOT SPECIFIED
BUT MIGHT BE ACHIEVED
IF HOUSE ELEVATION
INCREASED SLIGHTLY,

6/30/92 CWL

RUTHERFORD

WAY

R=665.00'
L=138.92

L=116.74

R=675.00'

L=101.56

24" RECT

SEWAGE
UTILITY EASEMENT

180' L
TRENCH

SEPTIC
FIELD

DIST. BOX
INV.=49.5

INV.
50.6
SEPTIC
TANK
INV.=
50.8

INV.=50

FF=603
OF=515
ROSCROFT

LOT 13

LOT

LIMIT OF
DISTURBANCE

APPLICATION

PERCOLATION TESTING

A 42058

P _____

HOWARD COUNTY HEALTH DEPARTMENT
BUREAU OF ENVIRONMENTAL HEALTH
P.O. BOX 476 ELLICOTT CITY, MARYLAND 21043
TELEPHONE: 461-9933

DISTRICT 5TH

DATE 3/8/88

TO: THE COUNTY HEALTH OFFICER
ELLICOTT CITY, MARYLAND

I, HEREBY, APPLY FOR THE NECESSARY TEST IN ORDER TO CONSTRUCT (OR RECONSTRUCT) A SEWAGE DISPOSAL SYSTEM.

PROPERTY OWNER MARY C. HILL ET AL Rulte Home Corporation
644-5603

ADDRESS 6642 SEDECA DRIVE COLUMBIA PHONE 301-381-4444
MARYLAND 21044

PROSPECTIVE BUYER _____

ADDRESS _____ PHONE _____

PROPERTY LOCATION:

SUBDIVISION RUTHERFORD LOT NO. 15 13

ROAD AND DESCRIPTION WEST SIDE OF MD RTE 32, EAST SIDE OF TEN
OWNS ROAD (4512 Rutherford Way)

TAX MAP 28 PARCEL # 75

SIZE OF LOT 3.2 ACRES TYPE BLDG. SFD
(SINGLE FAMILY DWELLING OR COMMERCIAL)

THE SYSTEM INSTALLED UNDER THIS APPLICATION IS ACCEPTABLE ONLY UNTIL PUBLIC FACILITIES BECOME AVAILABLE. I FULLY UNDERSTAND THE

FEE CONNECTED WITH THE FILING OF THIS PERC TEST APPLICATION IS NON-REFUNDABLE UNDER ANY CIRCUMSTANCES. I ALSO AGREE TO COMPLY

WITH ALL M.O.S.H.A. REQUIREMENTS IN TESTING THIS LOT.

Mary C. Hill
(SIGNATURE OF APPLICANT)

APPROVED BY _____ FOR _____ DATE _____

REJECTED BY _____ FOR _____ DATE _____

HOLD PENDING FURTHER TESTS _____ DATE _____


REASONS FOR REJECTION OR HOLDING 10/21/88 PERC OK HOLD FOR PLAT

BLDG. PERMIT SIGNED
AND RETURNED 6/30/88
Serial # 43066-SFD
4 Bedrooms

THIS IS NOT A PERMIT


Phil & Phil Back 2e

F-90-25
Sheet 3

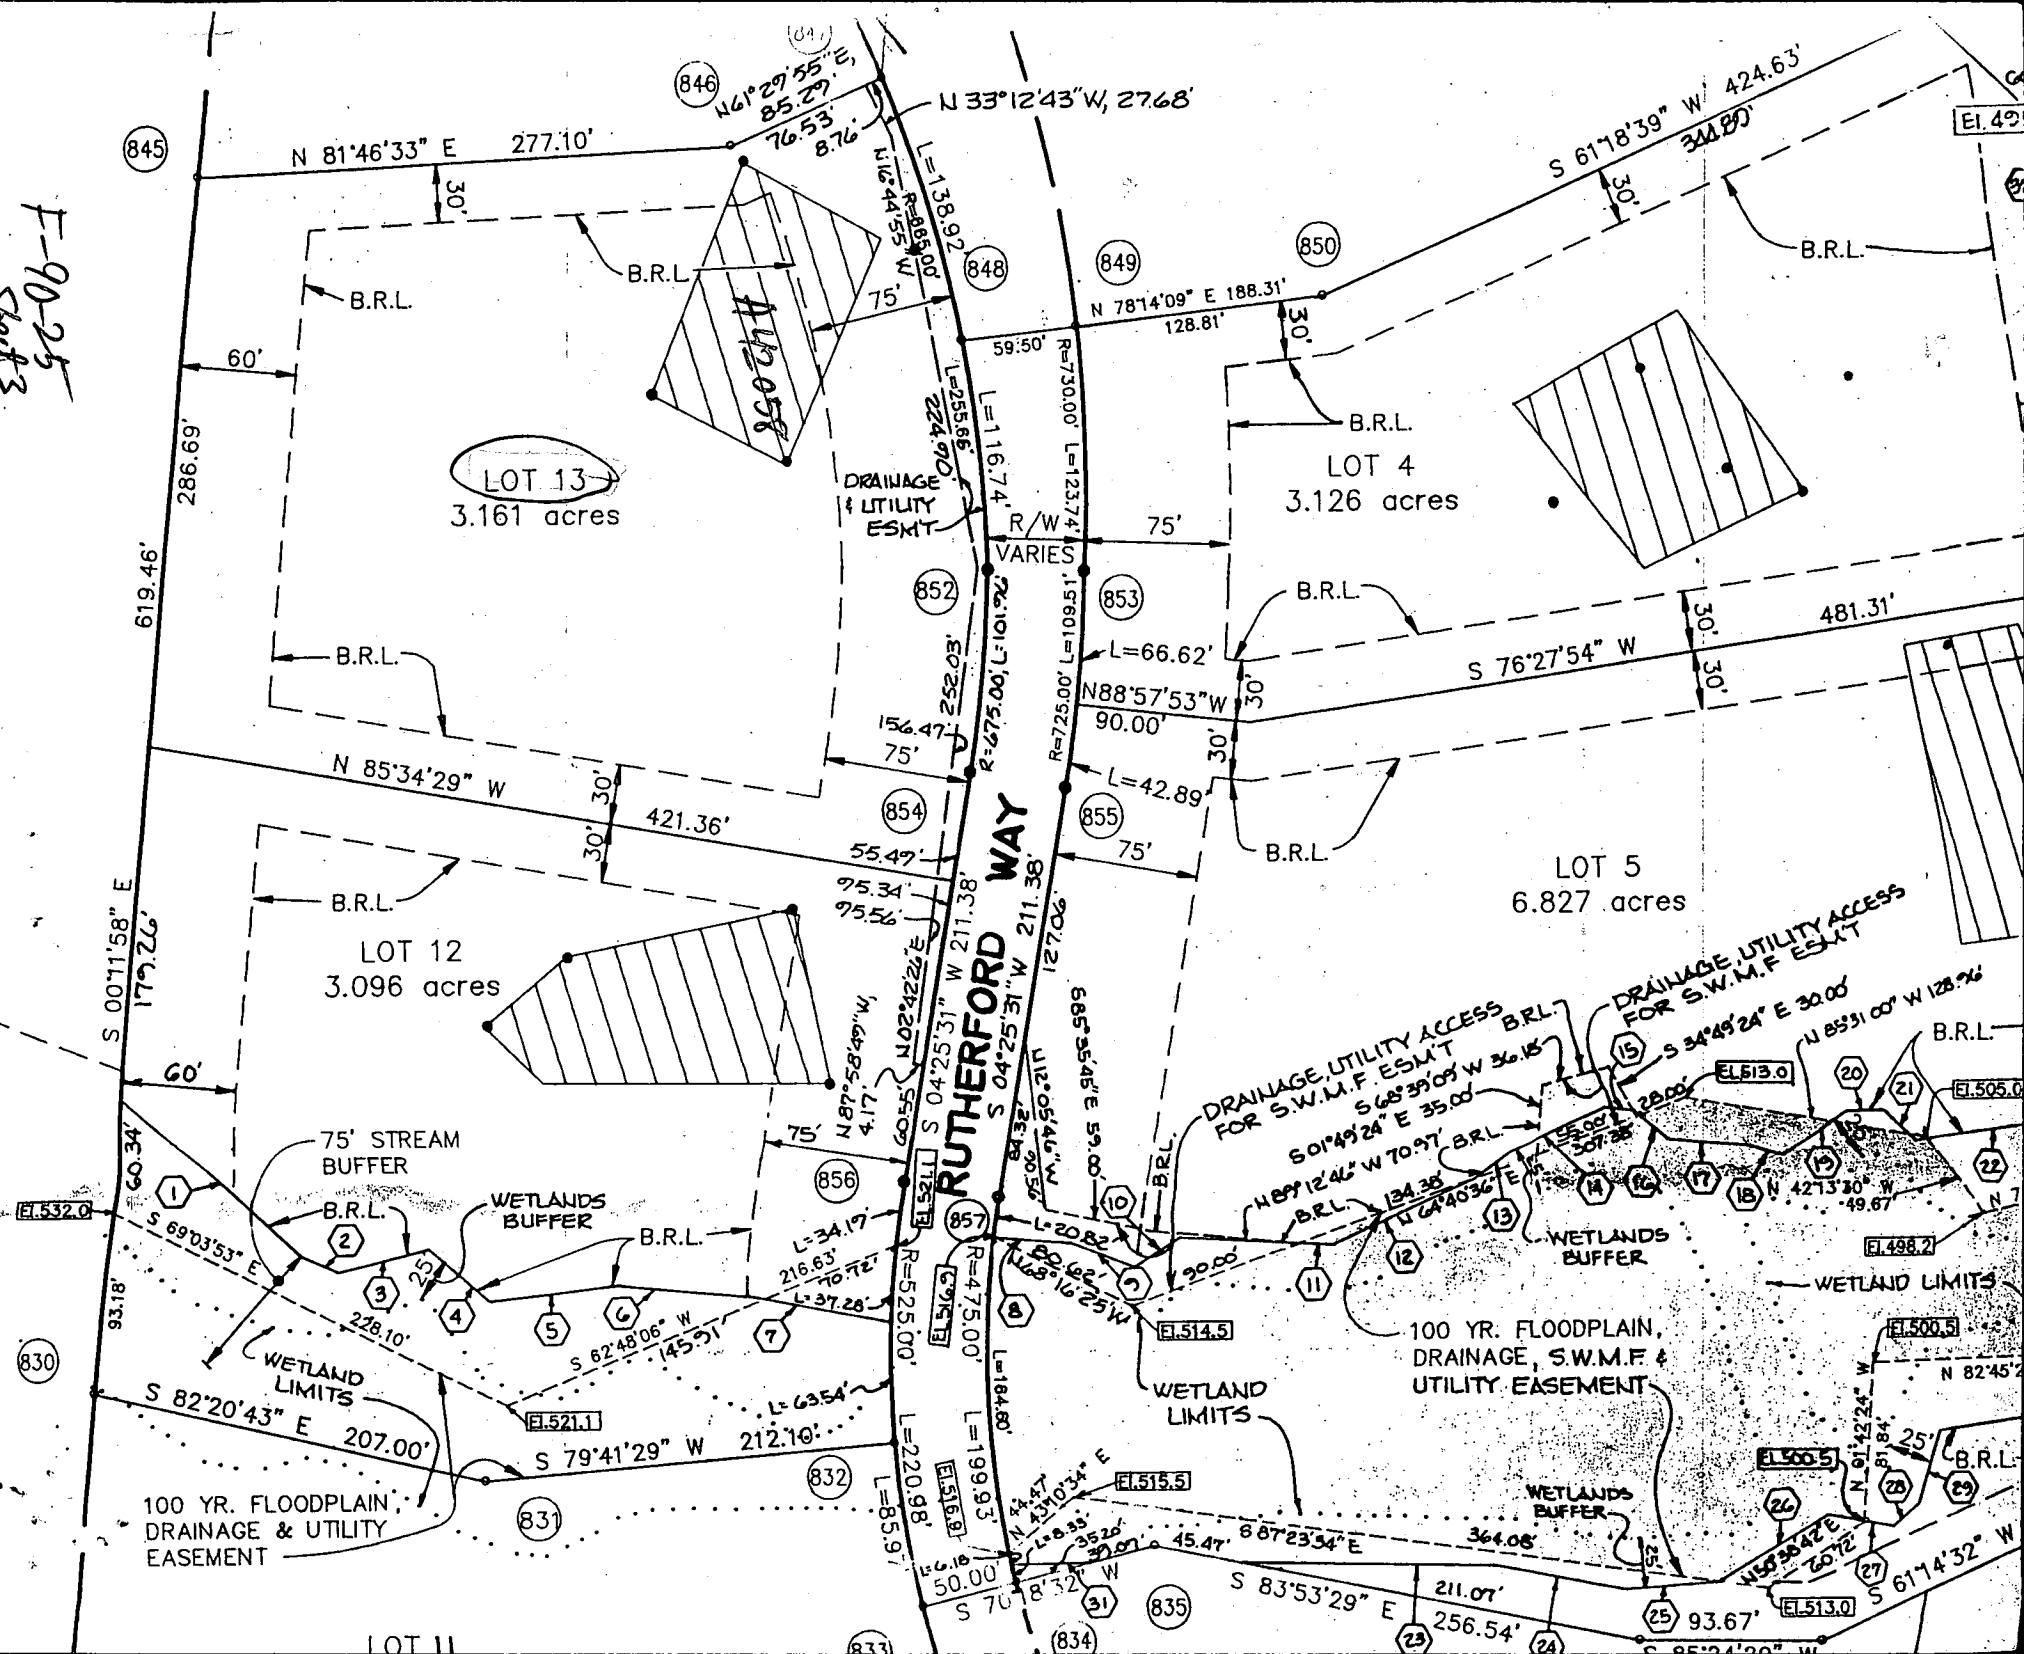

David Black
4512 Rutledge
Way
Dayton MD
2034

APPROVED
WALK-THRU BUILDING PERMIT
BP# 80053041 A# 42058
APP. SAN. PAY DATE: 4/7
DESC. OF WORK: Finish
Basement

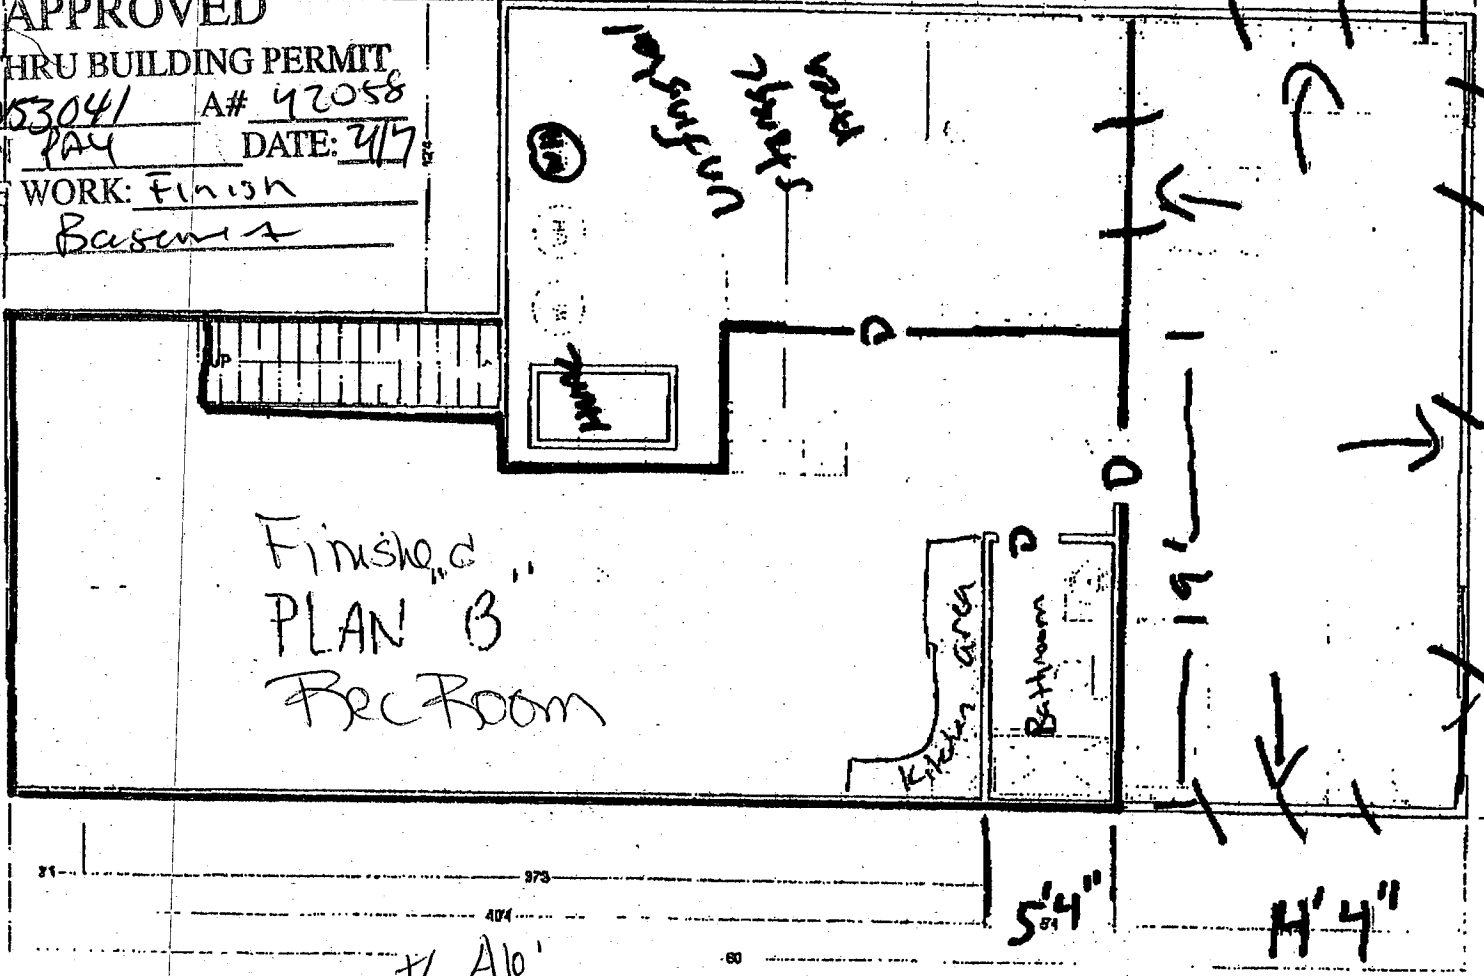

D-Door

Walls
to be
finished
with
drywall

31' 4"