

7/18/88 LATG

7/20/88 MIDDAY
TAX ID - 04-308778

14-10-32
MUST SEE PUMP IN OPERATION
PRIOR TO APPROVAL

PERMIT

P 42314

A REPAIR -

SEWAGE DISPOSAL SYSTEM

MARYLAND STATE DEPARTMENT OF HEALTH

DISTRICT _____

HOWARD COUNTY

BUREAU OF ENVIRONMENTAL HEALTH
461-9933

INDEXED

DATE 8/9/88

DATE SYSTEM APPROVED 7/20/88

INSPECTOR S.B.

NO RECORD OF REQUEST
FINAL INSPECTION
AS OF 8/21/95
PRESUME EFFLUENT PUMP
TO BE OPERATIONAL
INDEX AS COMPLETE
(CW)

Jack Fyock

IS PERMITTED TO INSTALL ☒ ALTER ☐

ADDRESS _____ PHONE 988-9270

SUBDIVISION _____ ROAD 2339 ⁶ Route 97 LOT _____

PROPERTY OWNER Cecil Jones

2339 ⁶ Route 97

ADDRESS _____

IF GARBAGE GRINDER IS USED INCREASE SEPTIC TANK CAPACITY BY 50% AND ABSORPTION AREA BY 22%.

GARBAGE GRINDER? YES _____ NO _____

SEPTIC TANK CAPACITY _____ GALLONS NUMBER OF BEDROOMS _____

REPAIR - CALL FOR INSPECTION WHEN GROUND IS OPENED UP SO SANITARIAN CAN RECOMMEND REPAIR.

PLANS APPROVED BY C. Williams DATE 6/27/88

COVER NO WORK UNTIL INSPECTED AND APPROVED.

NEITHER THE HOWARD COUNTY COUNCIL NOR THE HEALTH DEPARTMENT IS RESPONSIBLE FOR THE SUCCESSFUL OPERATION OF ANY SYSTEM.

NOTE: CLEANOUT REQUIRED EVERY 70 FEET OF SEWER LINE AND/OR AT 90° SWEEPS IN LINES FROM HOUSE TO DRAIN FIELDS.

NOTE: ALL PARTS OF SEPTIC SYSTEMS (I.E., TANK, DISTRIBUTION BOX, TRENCHES) TO BE 100 FEET FROM WELL (UNLESS OTHERWISE SPECIFICALLY AUTHORIZED)

NOTE: IF DEEP TRENCH(IES) ARE USED CALL FOR INSPECTION BEFORE AND AFTER PLACING GRAVEL IN TRENCH(IES).

NOTE: NO DRY WELL SHALL EXCEED 15 FOOT IN DIAMETER. NO ABSORPTION TRENCH TO EXCEED 100 FEET IN LENGTH.

NOTE: ALL PIPE FROM HOUSE TO SEPTIC TANK MUST BE CAST IRON OR SCHEDULE 40 PVC OR ABS.

PERMIT VOID AFTER TWO YEARS.

NOTE: INSTALL STAND PIPE ON SEPTIC TANK AND DRY WELL. STAND PIPES MUST BE 6 INCHES IN DIAMETER. CAST IRON, CONCRETE OR TERRA COTTA OR PVC OR ABS ACCEPTED. IF TOP OF SEPTIC TANK IS DEEPER THAN 3 FEET, MANHOLE TO GRADE REQUIRED.


NOTE: DISTRIBUTION BOXES MUST HAVE BAFFLES.

***INSTALLER IS RESPONSIBLE FOR OBTAINING FINAL APROVAL ON THIS PERMIT**

*CALL 461-9933 FOR INSPECTION OF SEPTIC SYSTEMS.

EH - 2-1186

A-142314

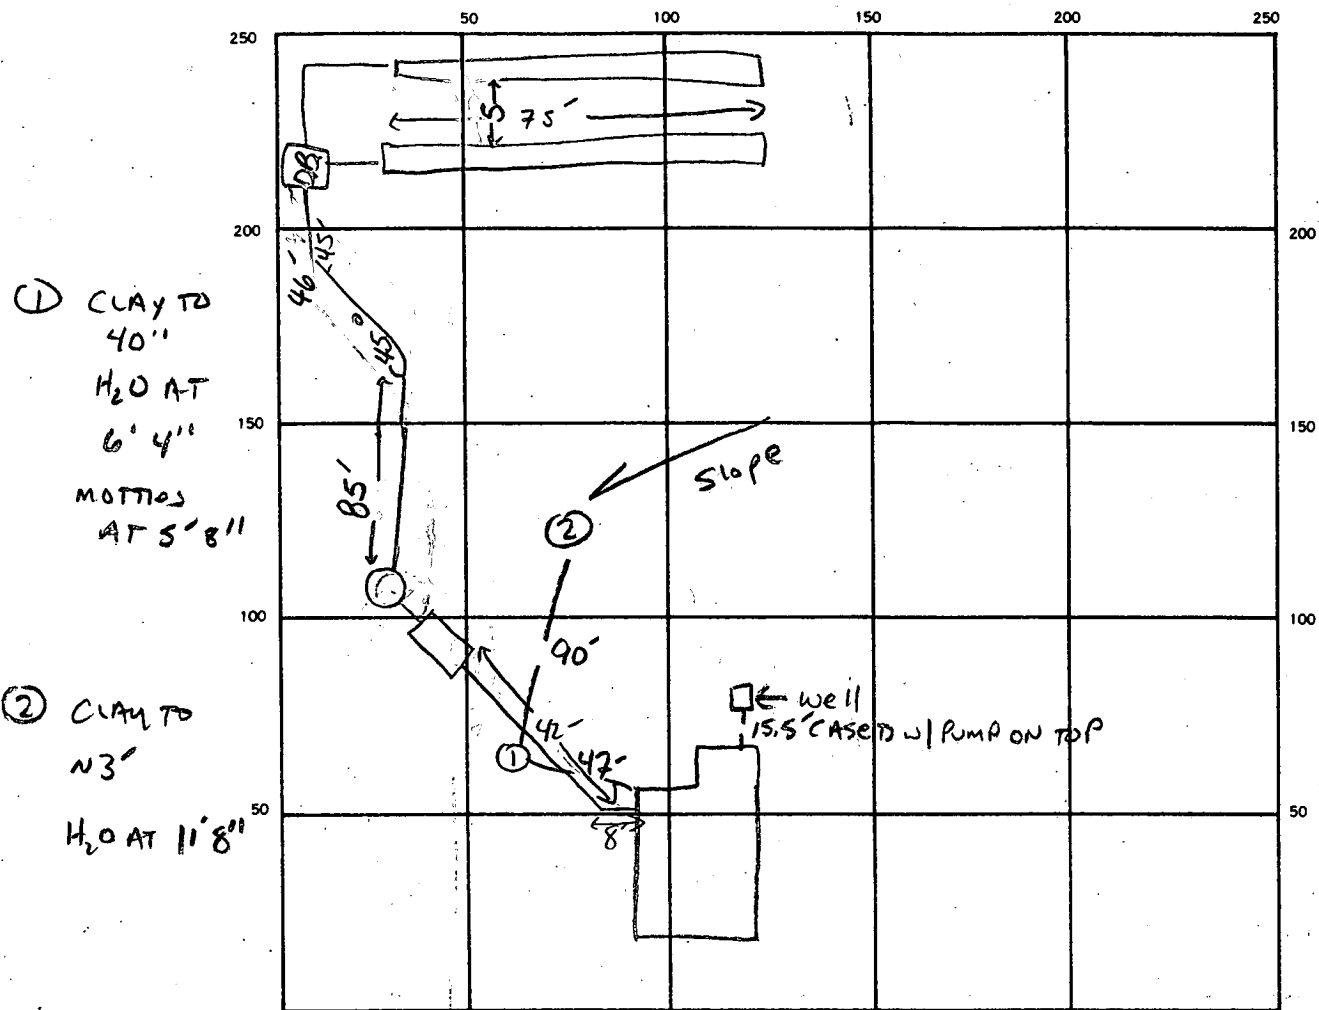

INDICATE NORTH. — NAME ADJOINING ROADWAY AS BASE LINE.

Rt 97

SEPTIC TANK, LEVEL ✓ 1000 CLEANOUTS _____

DISTRIBUTION BOX, LEVEL _____ Pump P.I.T w/ RING TO GRADE

DRAIN FIELD (TILE FIELD, DEPTH) 5.5 FT. TRENCH WIDTH 4 FT. INLET DEPTH 3 FT.

EFFECTIVE GRAVEL DEPTH 2.5 FT. TOTAL LENGTH ① 75 ② RF FT.

NUMBER OF TRENCHES 2 ONE SIDEWALL/BOTTOM AREA _____ SQ. FT.

DRYWELL INSIDE DIAMETER _____ FT. EFFECTIVE DEPTH BELOW INLET _____ FT.

ABSORBENT AREA _____ SQ. FT.

REMARKS Repair - Inlet 3 Bottom 5 3' wide - 200 D/GR House 3BR - Pump Syst.

1 1/2" - 2" Pipe to DB - 1/3 - 1/2 HP Pump (single) w/ Alarm - Cycle 50-75 GPR Pump

KIPP SYSTEM TO LEFT SIDE AND 75-100 Higher THAN Hole # 2. S.M.

7-2088 Repair - Pump Not installed, TRENCHES Complete, House

connection Made. OK to cover all work. -SB

DATE SYSTEM APPROVED _____ INSPECTOR _____