

Tax ID - 05-414768

PERMIT

SEWAGE DISPOSAL SYSTEM

DEPARTMENT OF HEALTH AND MENTAL HYGIENE

INDEXED

P 510586

A 43089

DISTRICT 5th

DATE 7.30.98

HOWARD COUNTY HEALTH DEPARTMENT

BUREAU OF ENVIRONMENTAL HEALTH

XX45XG9H33X 410-313-2640

DATE SYSTEM APPROVED 8-6-98

INSPECTOR AN

Fogle's Septic Clean, Inc.

IS PERMITTED TO INSTALL ☒ ALTER

ADDRESS 580 Obrecht Rd, Sykesville, MD 21784

PHONE 410-795-5674

SUBDIVISION Brierly LOT 15 ROAD 13824 Russell Zepp Drive

PROPERTY OWNER Sabapathy Sengottuvelu

ADDRESS

SEPTIC TANK CAPACITY 1250 GALLONS

NUMBER OF BEDROOMS 4

210 SQUARE FEET PER BEDROOM

LINEAR FEET OF TRENCH REQUIRED **280**

TRENCHES - Trench to be 3 feet wide. Inlet 4.5 feet below original grade. Bottom maximum depth 6.5 feet below original grade. Effective area begins at 4½ feet below original grade. 2 feet of stone below distribution pipe.

LOCATION - Starting from the intersection of the 357.91' and 358.73' lot lines, start the first trench 90 feet down the 358.73' lot line and 60 feet off this same lot line. Run trenches on contour towards the 358.73' lot line.

NOTES - No trench to exceed 100 feet in length. Provide 6" - 8" diameter cleanout and cap to grade or above on septic tank. *OK/MR*

PLANS APPROVED BY: Mark Rifkin/Donna K. Soe

DATE 02/10/98

COVER NO WORK UNTIL INSPECTED AND APPROVED

NEITHER THE HOWARD COUNTY COUNCIL NOR THE HEALTH DEPARTMENT IS RESPONSIBLE FOR THE SUCCESSFUL OPERATION OF ANY SYSTEM

NOTE: CLEANOUT REQUIRED EVERY 70 FEET OF SEWER LINE AND/OR AT 90° SWEEPS IN LINES FROM HOUSE TO DRAIN FIELDS, 90° ELBOWS NOT ACCEPTABLE.

NOTE: ALL PARTS OF SEPTIC SYSTEMS (I.E. TANK, DISTRIBUTION BOX TRENCHES) TO BE 100 FEET FROM WELL (UNLESS OTHERWISE SPECIFICALLY AUTHORIZED)

NOTE: IF DEEP TRENCH(ES) ARE USED CALL FOR INSPECTION BEFORE AND AFTER PLACING GRAVEL IN TRENCH(ES)

NOTE: NO DRY WELL SHALL EXCEED 15 FOOT IN DIAMETER NO ABSORPTION TRENCH TO EXCEED 100 FEET IN LENGTH

NOTE: ALL PIPE FROM HOUSE TO SEPTIC TANK MUST BE CAST IRON OR SCHEDULE 35/40 PVC OR ABS

PERMIT VOID AFTER TWO YEARS

NOTE: INSTALL STAND PIPE ON SEPTIC TANK AND DRY WELL STAND PIPES MUST BE 6 INCHES IN DIAMETER CAST IRON. CONCRETE OR TERRA COTTA OR PVA OR ABS ACCEPTED. IF TOP OF SEPTIC TANK IS DEEPER THAN 3 FEET. MANHOLE TO GRADE REQUIRED.


NOTE: DISTRIBUTION BOXES MUST HAVE BAFFLES

***INSTALLER IS RESPONSIBLE FOR OBTAINING FINAL APPROVAL ON THIS PERMIT**

*CALL 461-9933 FOR INSPECTION OF SEPTIC SYSTEM.

HD-260(6-90)

A 43089

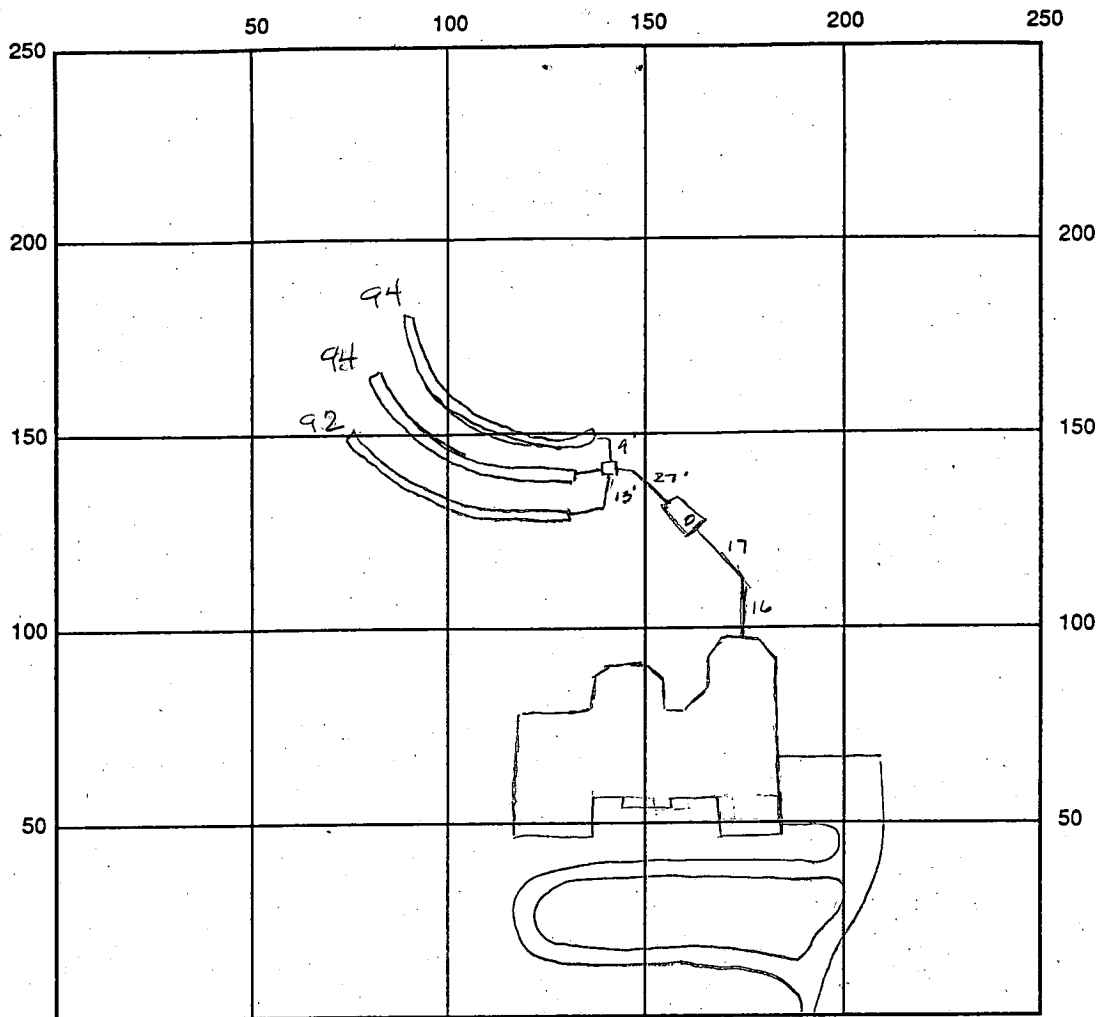

INDICATE NORTH - NAME ADJOINING ROADWAY AS BASE LINE

SEPTIC TANK LEVEL OK 1250 gal CLEANOUTS OK

DISTRIBUTION BOX LEVEL OK baffle is in

DRAIN FIELD/TITLE DEPTH 6.5 FT. TRENCH WIDTH 30 FT. INLET DEPTH 45 FT.

EFFECTIVE GRAVEL DEPTH 2.0 FT. TOTAL LENGTH 280 FT.

NUMBER OF TRENCHES 3 ONE SIDEWALL/BOTTOM AREA 280 SQ. FT.

DRYWALL INSIDE DIAMETER — FT. EFFECTIVE DEPTH BELOW INLET — FT.

ABSORBENT AREA — SQ. FT.

REMARKS: 8/6/98 OK to cover all work final

DATE SYSTEM APPROVED 8/6/98 INSPECTOR A. M. Miller

APPLICATION

PERCOLATION TESTING

A 43089

P _____

HOWARD COUNTY HEALTH DEPARTMENT
BUREAU OF ENVIRONMENTAL HEALTH
P.O. BOX 476 ELLICOTT CITY, MARYLAND 21043
TELEPHONE: 461-9933

DISTRICT 5TH

DATE 9-20-88

TO: THE COUNTY HEALTH OFFICER
ELLICOTT CITY, MARYLAND

I, HEREBY, APPLY FOR THE NECESSARY TEST IN ORDER TO CONSTRUCT (OR RECONSTRUCT) A SEWAGE DISPOSAL SYSTEM.

PROPERTY OWNER RUSSELL ZEPP Sabapathy Sengottuvelu

ADDRESS 13790 HIGHLAND RD PHONE 854-2797

PROSPECTIVE BUYER HENRY L. BLEVINS

ADDRESS 3600 WATERSVILLE RD. PHONE 795-2337
MT. AIRY, MD 21771

PROPERTY LOCATION:

SUBDIVISION ZEPP SUBDIVISION LOT NO. 18 15 on final

ROAD AND DESCRIPTION HIGHLAND ROAD HOWARD CO

ZIP: 21029 (13824 Russell Zepp Drive) BLDG. PERMIT SIGNED
AND RETURNED 2-10-98
Serial # B0709756-4Bim

TAX MAP 34 PARCEL # 7

SIZE OF LOT 3.25 AC ± TYPE BLDG. SINGLE FAMILY
(SINGLE FAMILY DWELLING OR COMMERCIAL)

THE SYSTEM INSTALLED UNDER THIS APPLICATION IS ACCEPTABLE ONLY UNTIL PUBLIC FACILITIES BECOME AVAILABLE. I FULLY UNDERSTAND THE
FEE CONNECTED WITH THE FILING OF THIS PERC TEST APPLICATION IS NON-REFUNDABLE UNDER ANY CIRCUMSTANCES. I ALSO AGREE TO COMPLY
WITH ALL M.O.S.H.A. REQUIREMENTS IN TESTING THIS LOT.

Henry L. Blevins
(SIGNATURE OF APPLICANT)

APPROVED BY _____ FOR _____ DATE _____

REJECTED BY _____ FOR _____ DATE _____

HOLD PENDING FURTHER TESTS _____ DATE _____

REASONS FOR REJECTION OR HOLDING 3-9-89 Per Satisfactory - hold for Subd. Plat. San


HD-216

THIS IS NOT A PERMIT

A 43089

SOIL PROFILE

811	AP
	Yell RED Silt Clay Lm. 10-15% Frag
3.5	Yellow BL TO STRONG Brown Highly micaceous Silt loam 15-20% Frag
12.5	

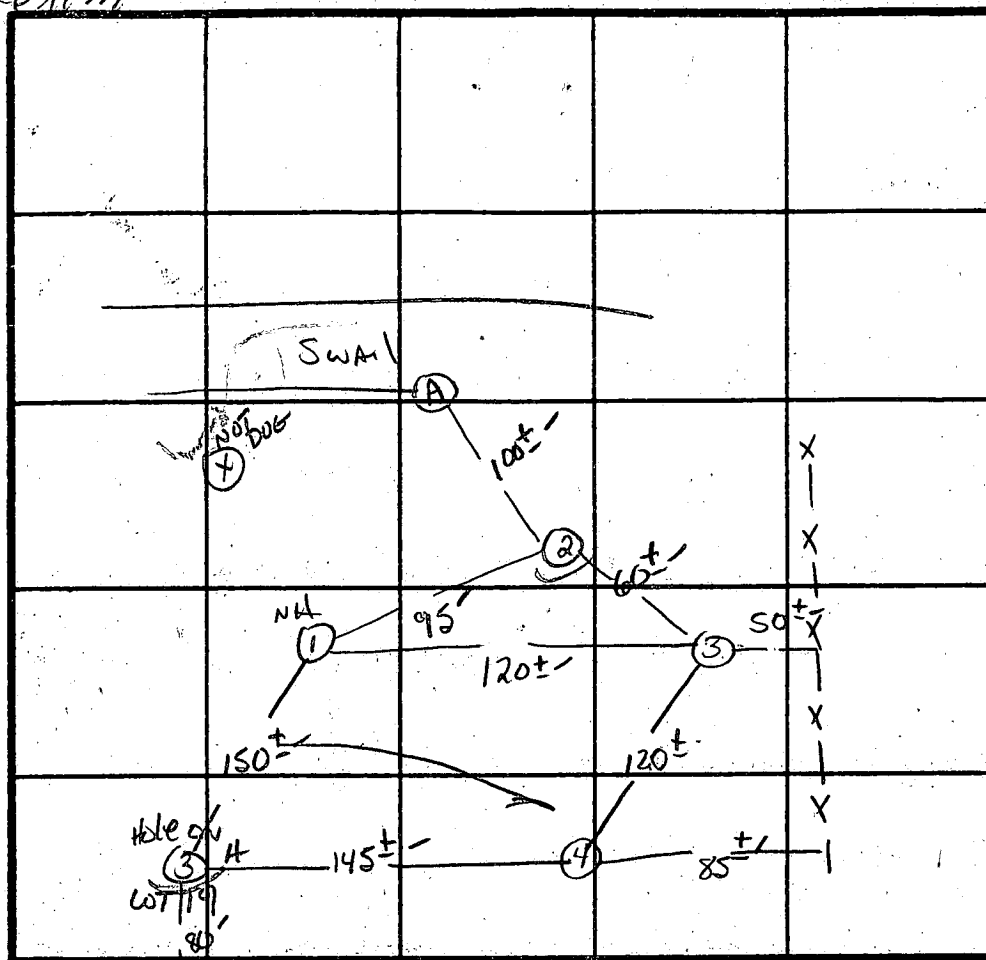

$\bar{X} = 15 \text{ MIN}$
210 ~~4~~
INLET 4
BOTTOM 6

INDICATE NORTH - NAME ADJOINING ROADWAY AS BASE LINE

⑤ Lot 19 Highland Rd.

DATE	TEST NO.	DEPTH	PRE-WET		TEST - 1" DROP		TIME
			START	STOP	START	STOP	
2/9/89	1 S M	4.5- 8.5-	11:25 11:26	11:28 11:28	11:28 11:28	11:33 11:31	5 MIN 3 MIN
	1 V	12.5-	As profiled				
	2 S	4.5- 12.0-	11:47	11:57	11:57	12:18	21 MIN
	3 S	4.5-	11:33	11:37	11:37	11:47	10 MIN
	3 V	13-	Similar to profile w/ less frags				
			H ₂ O AT 13" clay to 3.5-		4.0-		
3/9/89	Lot 19 3 S	5- 13-	11:50	11:51	11:51	11:53	2 MIN
			Similar to #2 = lower profile more				than colored
	A- Clay to 7.5-						

REMARKS Table 1, 2, A Per stakes USING ①③④③
40T19

TYPE OF SOIL _____

TESTED BY J. Abel ALSO PRESENT Dave Hopkins

APPLICATION

PERCOLATION TESTING

A 43088

P _____

HOWARD COUNTY HEALTH DEPARTMENT
BUREAU OF ENVIRONMENTAL HEALTH
P.O. BOX 476 ELLICOTT CITY, MARYLAND 21043
TELEPHONE: 461-9933

DISTRICT SD

DATE 9-20-88

TO: THE COUNTY HEALTH OFFICER
ELLICOTT CITY, MARYLAND

I, HEREBY, APPLY FOR THE NECESSARY TEST IN ORDER TO CONSTRUCT (OR RECONSTRUCT) A SEWAGE DISPOSAL SYSTEM.

PROPERTY OWNER RUSSELL ZEPP

ADDRESS 13790 HIGHLAND RD PHONE 854-2797

PROSPECTIVE BUYER HENRY L. BLEVINS

ADDRESS 3600 WATERSVILLE RD PHONE 795-2337
MT. AIRY, MD 21771

PROPERTY LOCATION:
SUBDIVISION ZEPP SUBDIVISION LOT NO. IT IS on final

ROAD AND DESCRIPTION HIGHLAND ROAD HOWARD CO
ZIP: 21029

TAX MAP 34 PARCEL # 7

SIZE OF LOT 3.50 AC ± TYPE BLDG. SINGLE FAMILY
(SINGLE FAMILY DWELLING OR COMMERCIAL)

THE SYSTEM INSTALLED UNDER THIS APPLICATION IS ACCEPTABLE ONLY UNTIL PUBLIC FACILITIES BECOME AVAILABLE. I FULLY UNDERSTAND THE
FEE CONNECTED WITH THE FILING OF THIS PERC TEST APPLICATION IS NON-REFUNDABLE UNDER ANY CIRCUMSTANCES. I ALSO AGREE TO COMPLY
WITH ALL M.O.S.H.A. REQUIREMENTS IN TESTING THIS LOT.

[Signature]
(SIGNATURE OF APPLICANT)

APPROVED BY _____ FOR _____ DATE _____

REJECTED BY _____ FOR _____ DATE _____

HOLD PENDING FURTHER TESTS _____ DATE _____

REASONS FOR REJECTION OR HOLDING 3-9-89 Purchaser's Factory - Hold for Subd. Plat. scan
Insufficient area remaining to test. See

HD-216


THIS IS NOT A PERMIT

Lot 17 part of 15
on prelin

A 43088

SOIL PROFILE

0

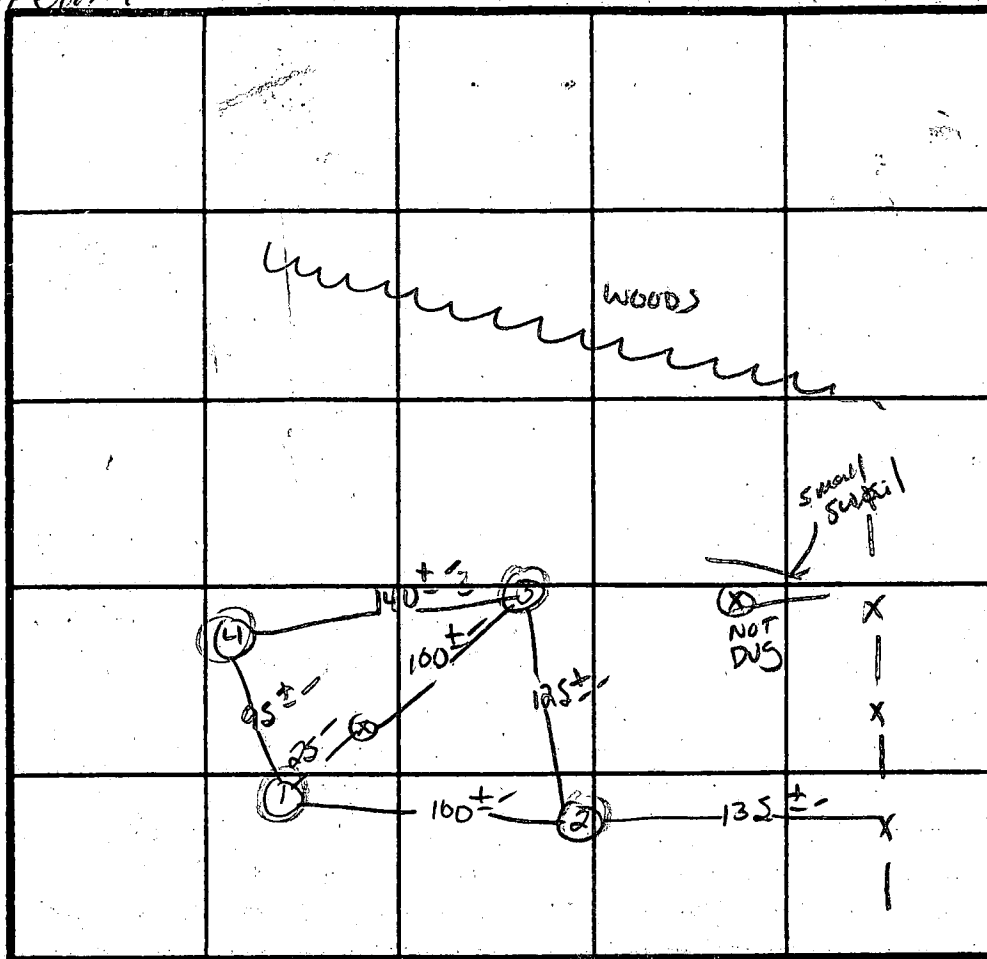

INDICATE NORTH - NAME ADJOINING ROADWAY AS BASE LINE.

Highland Rd.

DATE	TEST NO.	DEPTH	PRE-WET		TEST - 1" DROP		TIME
			START	STOP	START	STOP	
3/9/89	1 S	8.0'	Refusal -	STRUCTURED AT	7.5'	Clay to 4.0'	
	2 S	9.5'	Refusal -	Clay to ~ 4.0'	STRUCTURED AT	9'	
	3 S	10'	Clay -	NO permeable soil NOTED			
	4 S	9'	Clay to 9'	NO percable soil			
	4 V						

REMARKS #2+3 PER STAKES OTHERS DIFF - INSUFFICIENT AREA REMAINS TO TEST

TYPE OF SOIL

TESTED BY


S. Abel

ALSO PRESENT

DAVID HOPKINS

410-313-2648

7.30.98
Wall check ok
House moved
forward 20'
AM

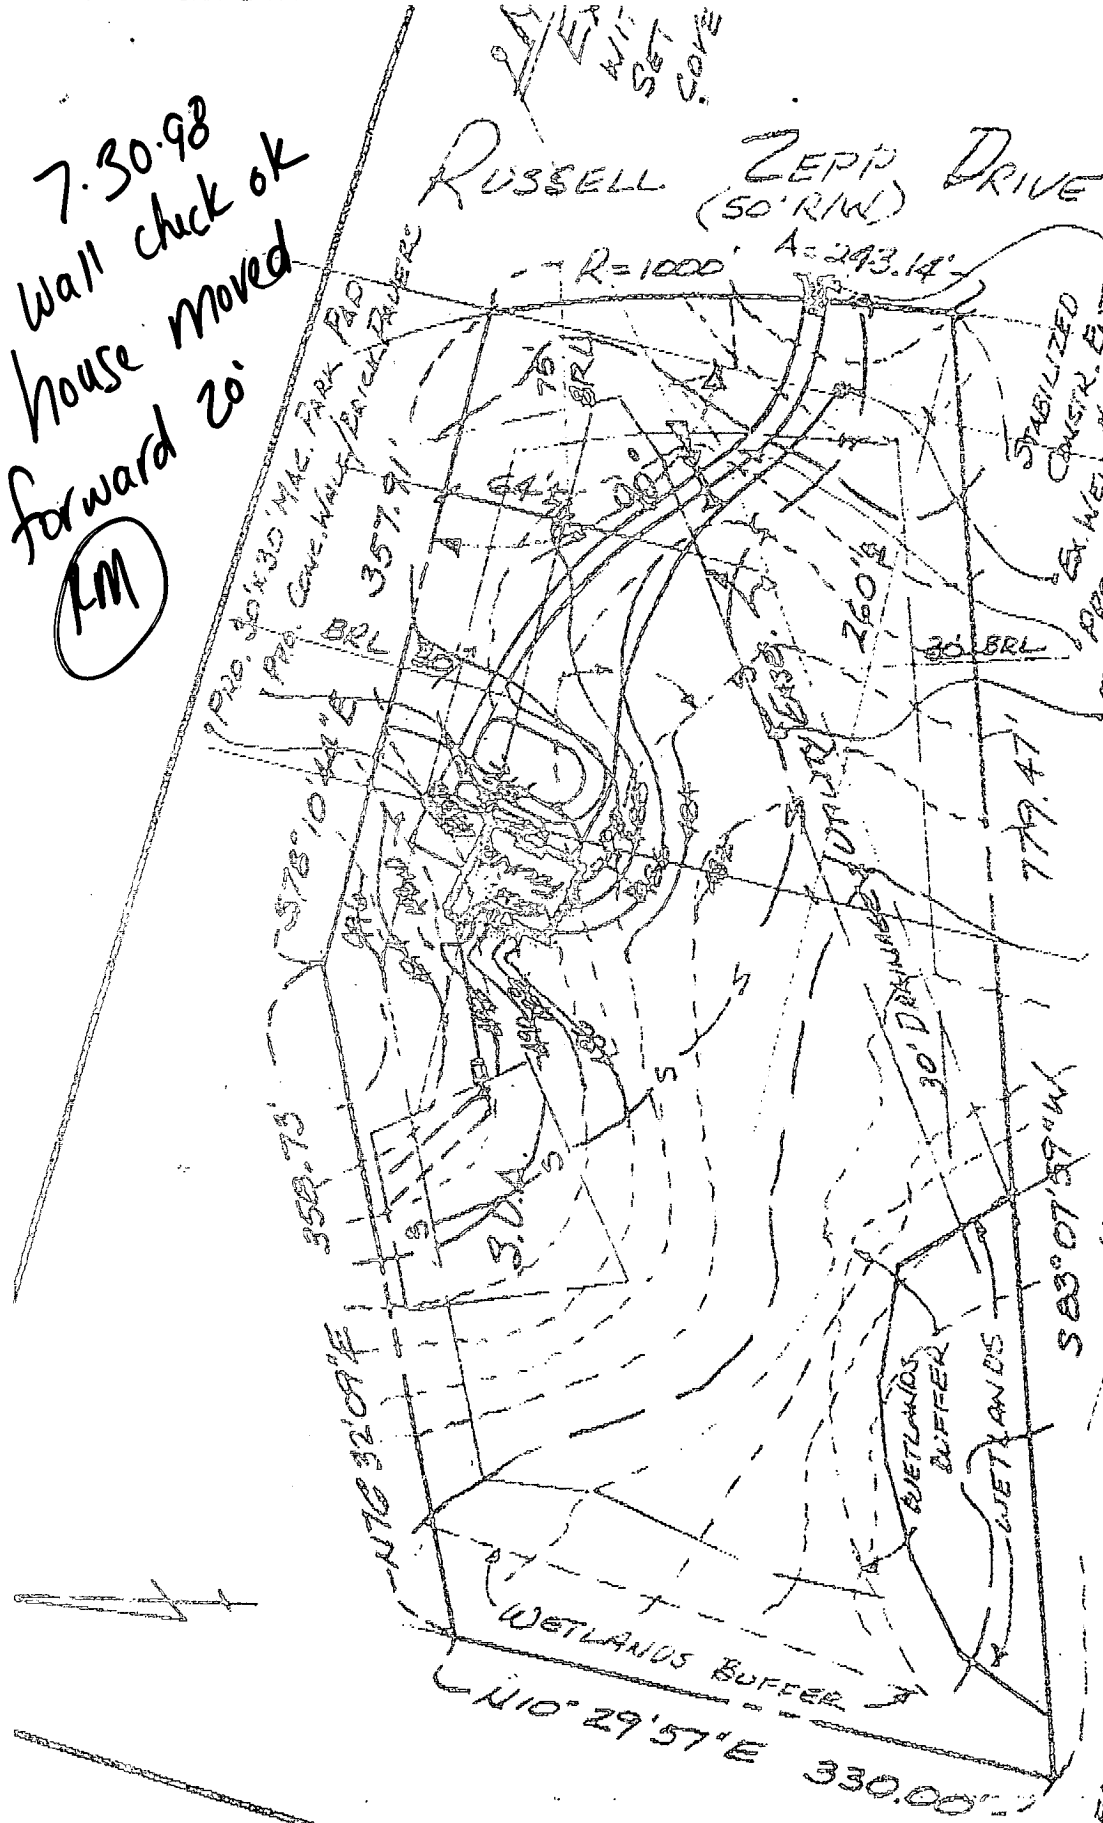

STABILIZED
CANAL. EX. 10'
PRO. 10' MAX. DRIVE
EX. SILT FENCE

SCALE: 1" = 100'

NOTES:

1. GRADINGS AROUND HOME MAY VARY DUE TO FIELD CONDITIONS.
2. NO. CANAL. STOCKPILING OF MATERIAL IN EXCESS MATERIAL SHALL BE FORWARDED IN SEPTIC CASEMENT.
3. EX. WELL LOCATED BY HIGHER PLANNING WHEN EXCAVATED AS PER PLAN.
4. INSTALL SED. CATCHER BY HIGHER PLANNING WHEN EXCAVATED AS PER PLAN.
5. LENGTH OF SEPTIC PIPE TO BE DETERMINED BY HIGHER PLANNING.


NOTES:

DISTURBED AREA = 18,000.0
BF = 485.7942
INV. FROM HOME = 493.44
INV. @ SEPTIC = 490.0
INV. FA = 489.4
EX. ELEV. = 489.1
V. @ DITCH TOP = 492.0
ELEV. @ " = 492.0
" = 488.5
" = 492.0

Approved Septic System Plan
Howard County Health Department

Donna K. See
Signature

11078
10/18/98

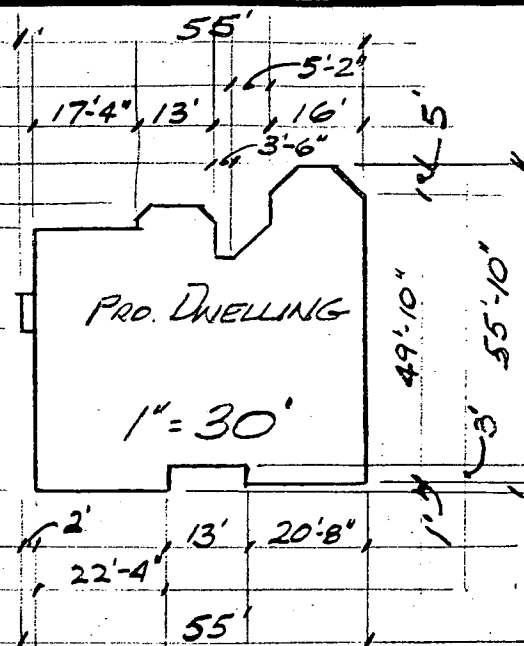

Total linear feet of trench
required 280 feet

Width of trench(es) 3 feet


Depth of trench(es) 6.5 feet

Depth of stone required below
distribution pipe 2 feet

SITE PLAN


LOT 15
BRIERLY

5TH ELECT. DIST. HOWARD CO. MD.

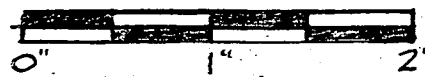

		SCALE: AS SHOWN	APPROVED BY JPH	DRAWN BY JPH
		DATE: 1-22-98		
13824 RUSSELL ZEPP DRIVE				
LOT 15 - BRIERLY - 5.42 AC				DRAWING NUMBER SP-592

PERMIT # _____ DATE FILED: _____

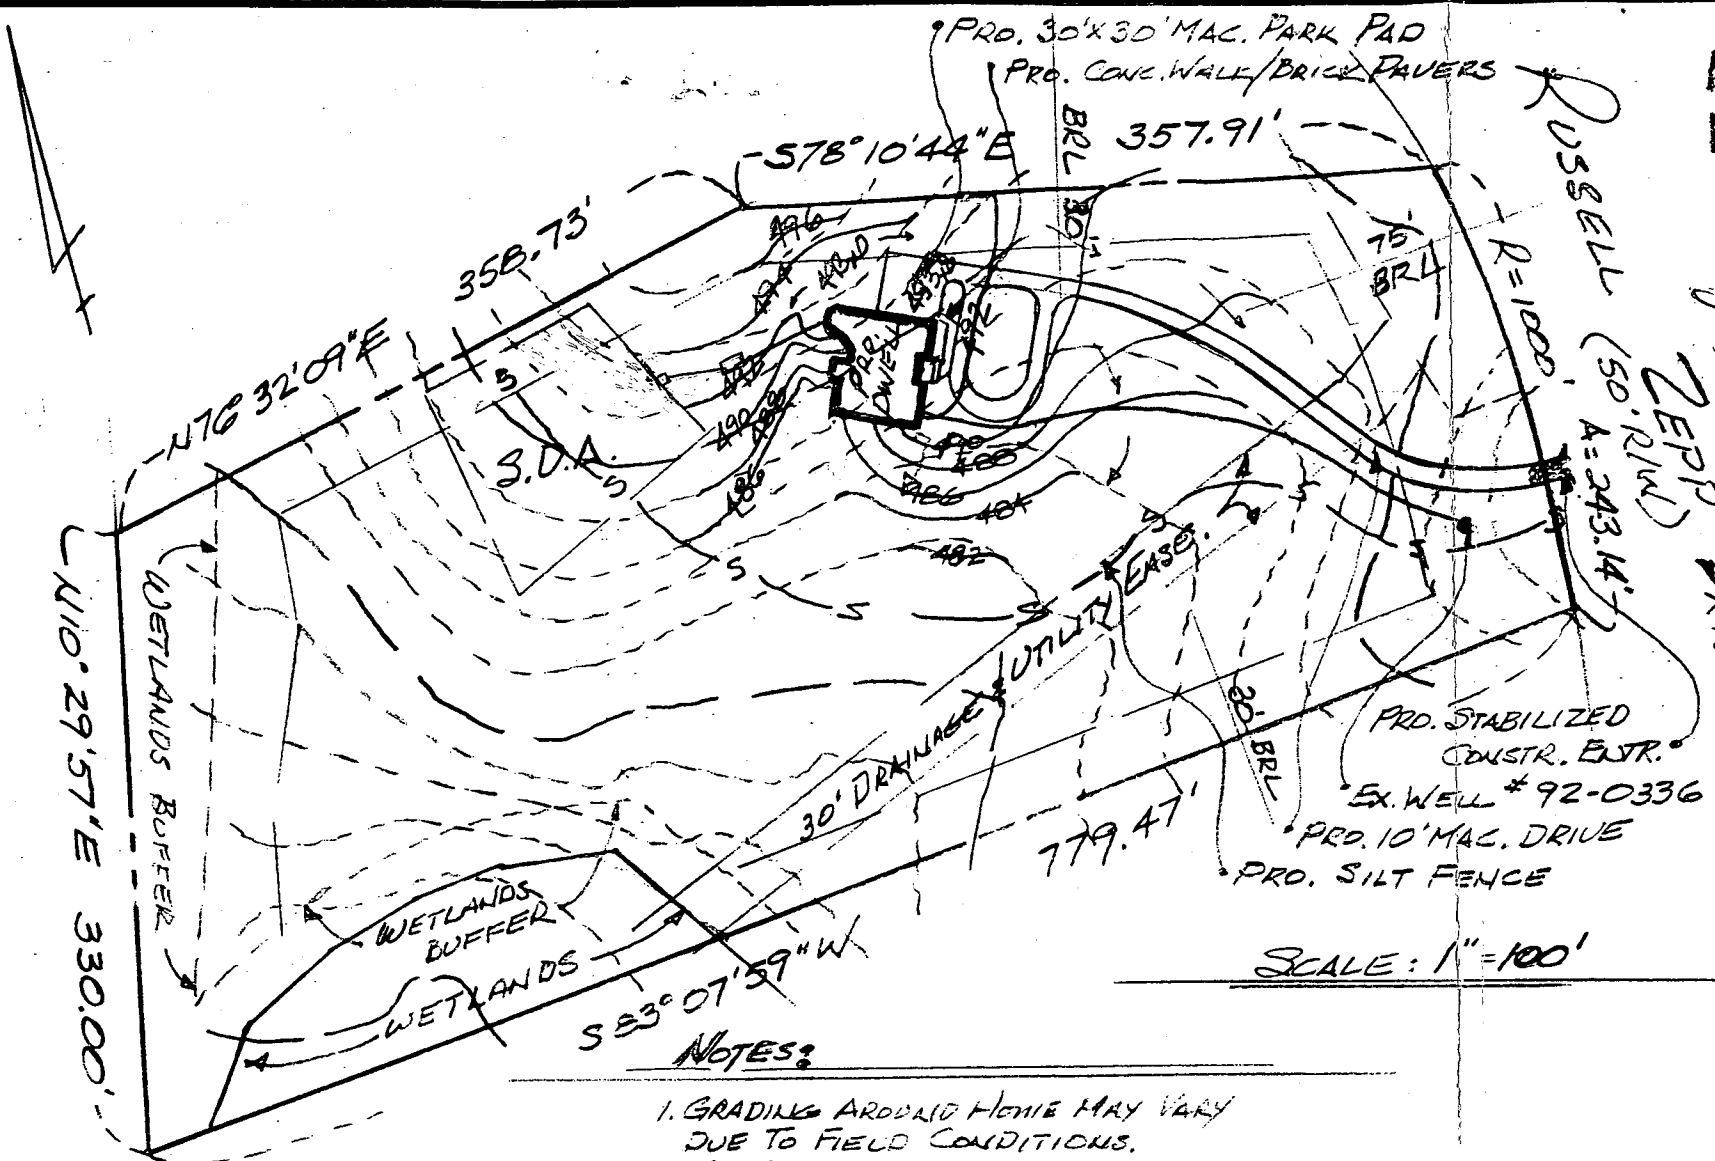

SCALE: 1"=100'

NOTES:

1. GRADING AROUND HOME MAY VARY DUE TO FIELD CONDITIONS.
2. NO. CONSTR, STOCKPILING OF REFUSE OR EXCESS MATERIAL SHALL BE BURIED IN SEPTIC EASEMENT.
3. EX. WELL LOCATED BY HAGAN & HAMILTON.
4. INSTALL SED. CONTROL AS REQ. BY SITE INSPECT.
5. FILL EXCAVATED MAT. ON HIGH SIDE OF TRENCH WHEN INSTALL. SEPTIC
6. LENGTH OF SEPTIC FIELD TRENCH TO BE DETERMINED BY H.C.H.D.

DISTURBED AREA = 18,000 sq ft
BF = 485.7 GAR = 494.3 FF = 495.0
INV. FROM HOME = 490.0
INV. @ SEPTIC = 489.25
INV. FR " = 489.0
EX. ELEV. 2 " = 493.0
PRO. " " " = 492.0
INV. @ DISTR. BOX = 488.5
EX. ELEV. @ " " = 493.0


OWNER:



SABAPATHY SENGOTTUVELU
ARUNA D. SENGOTTUVELU
9056 MANORWOOD ROAD
LAUREL, MD. 20723-1390

7685 806,990.6250
 1356 806,341.7105
 5853 806,810.3961
 7827 806,932.1673
 2814, 806,947.6086
 3498 806,569.1964
 3166 806,539.4994

NET LOT AREA 3.0592 AC.

ES ARE BASED ON
 STATE GRID
 E SYSTEM.

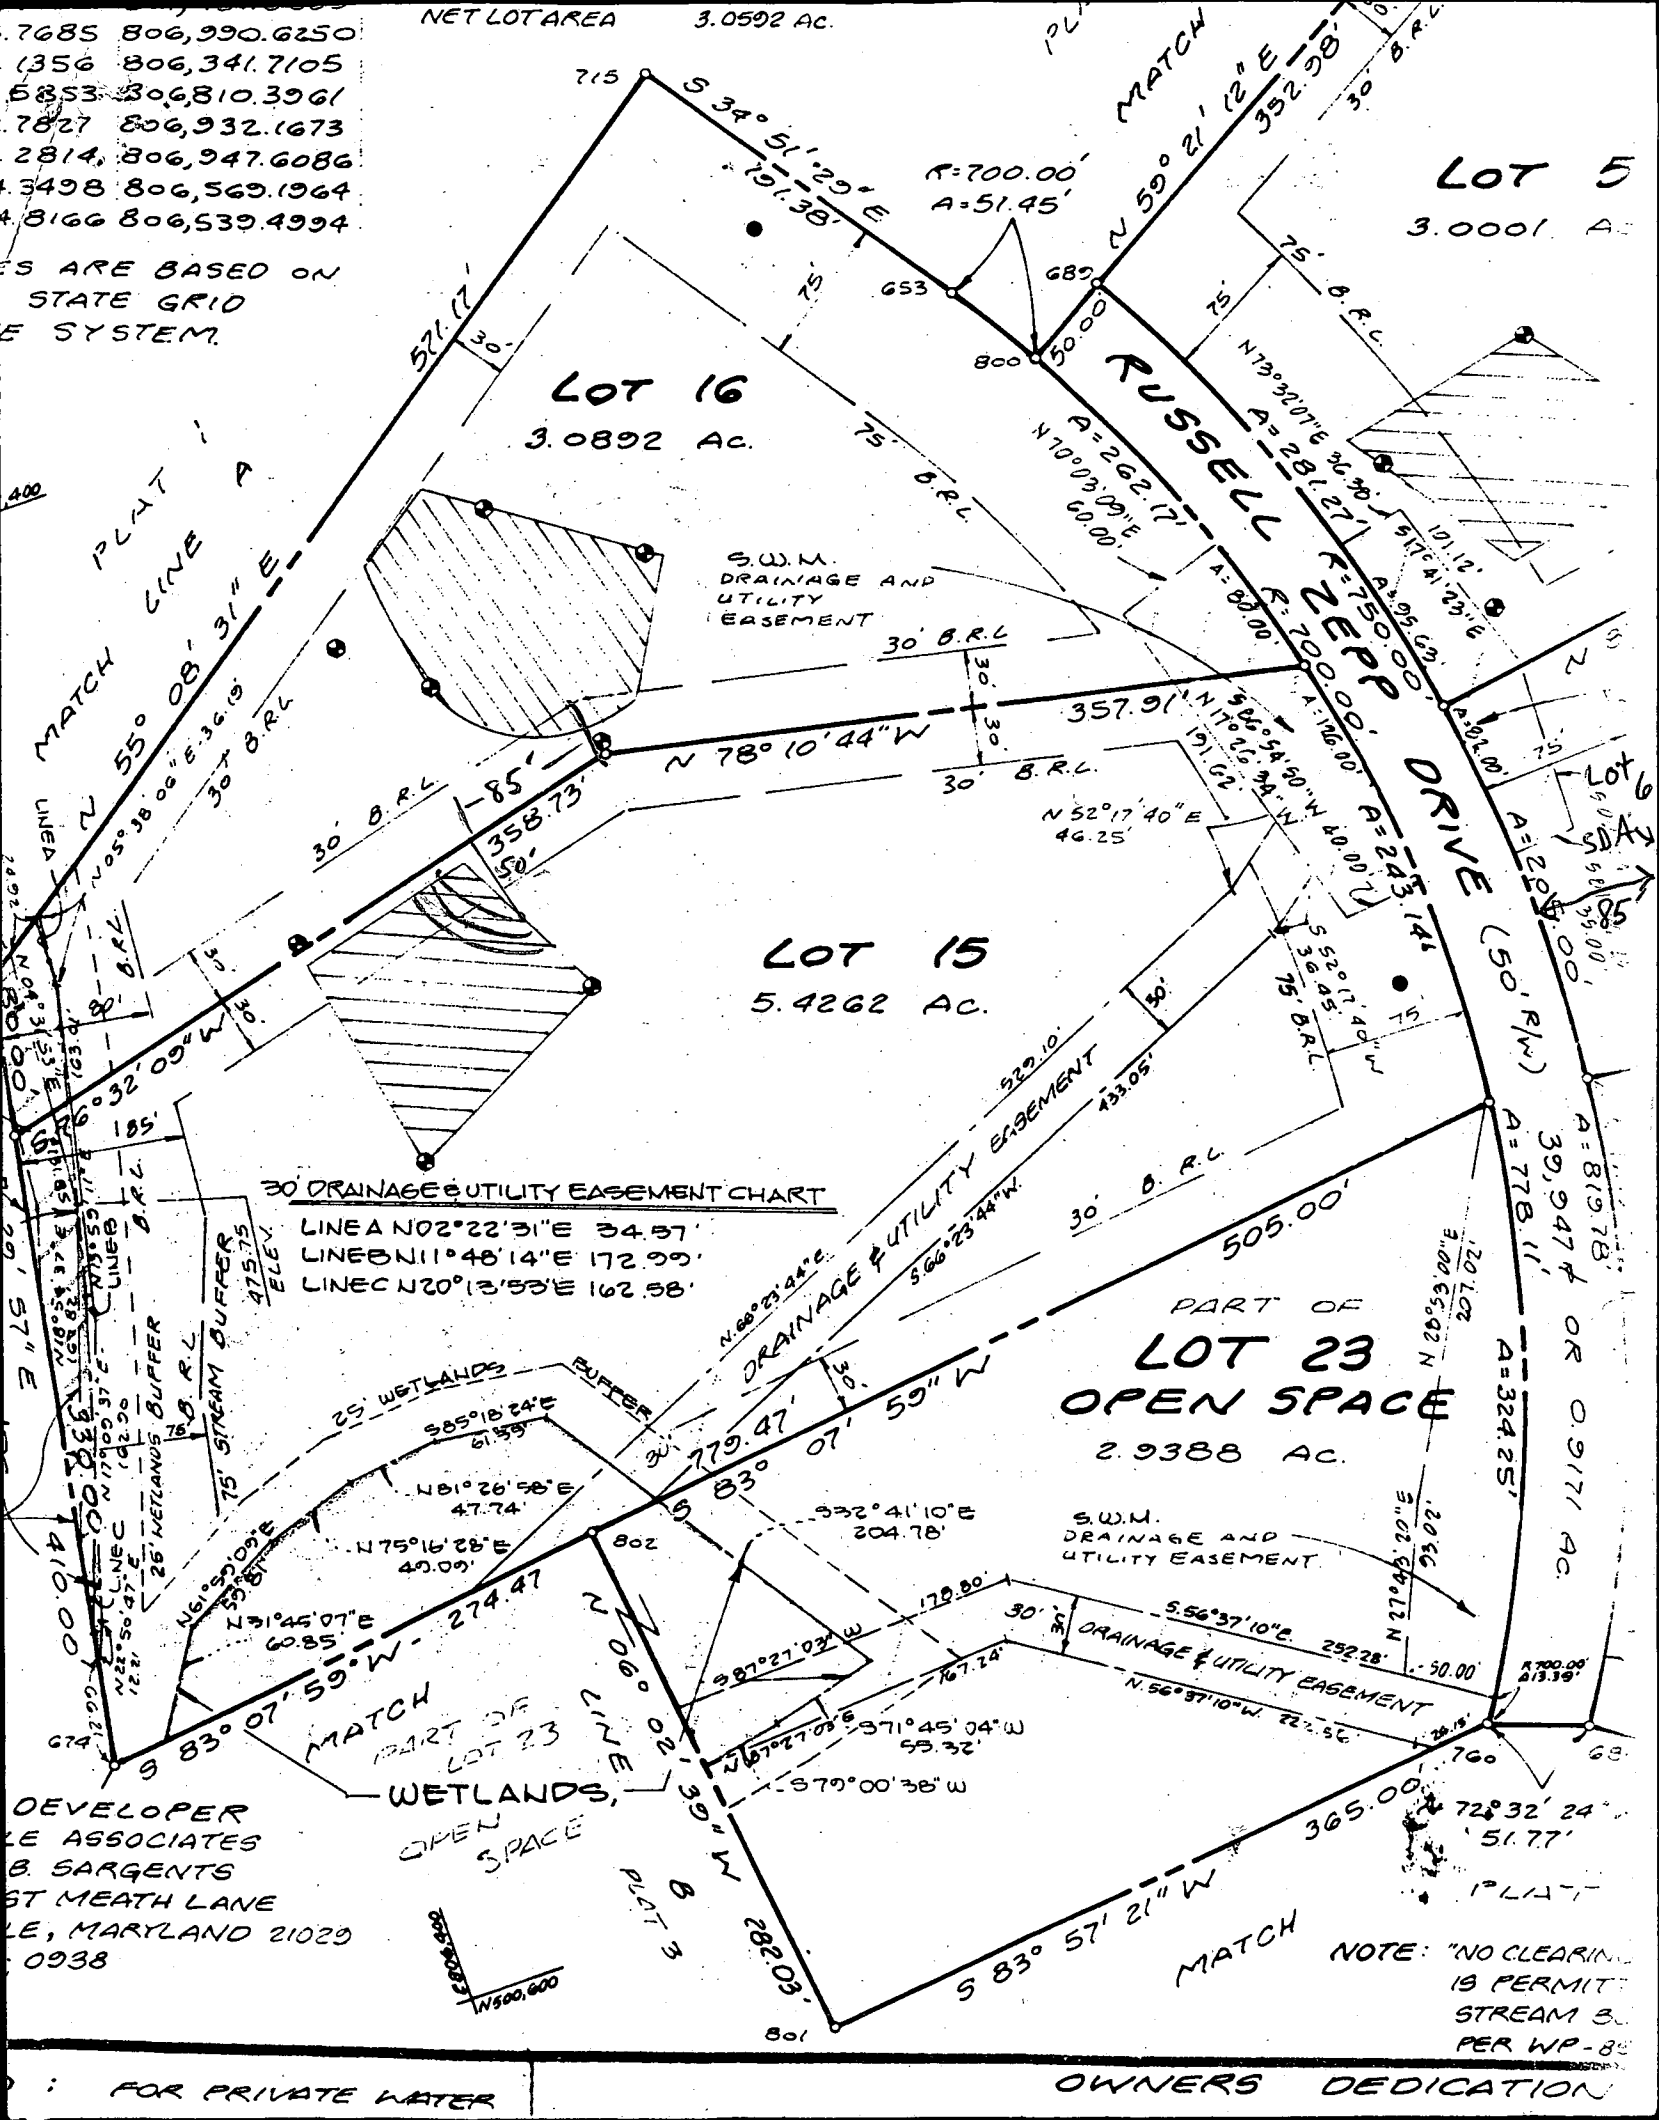

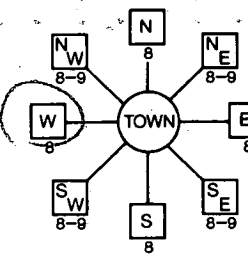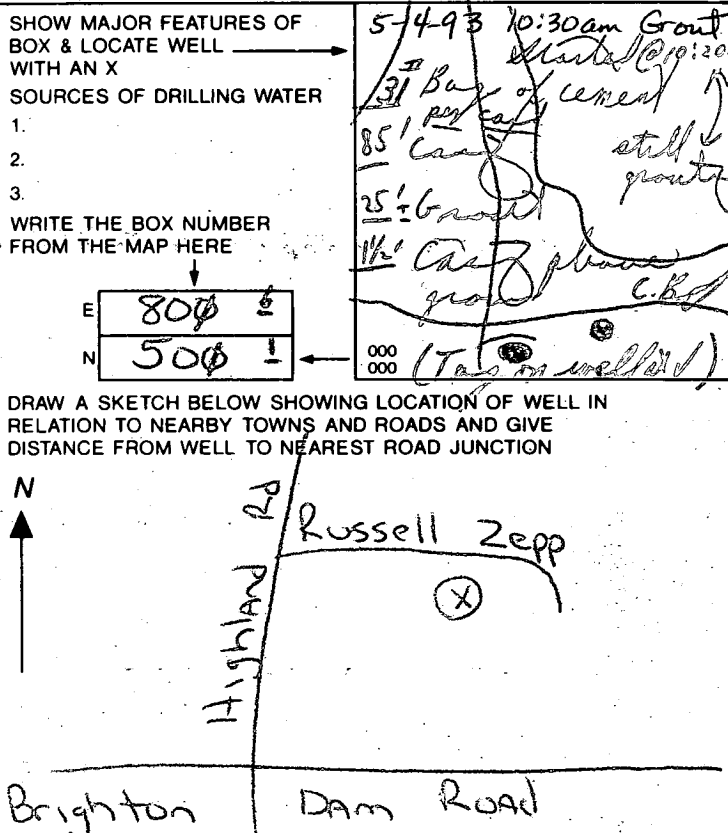B 1 01731 (THIS NUMBER IS TO BE PUNCHED IN COLS. 3-6 ON ALL CARDS)	SEQUENCE NO. (DP USE ONLY)	STATE OF MARYLAND PERMIT TO DRILL WELL please print or type	STATE PERMIT NUMBER H0-92-0336 ✓ fill in this form completely
Date Received (APA) 03 03 93 OWNER INFORMATION 15 Last Name 34 Owner First Name 36 Street or RFD 55 57 Town 70 State 72 Zip 76 CLARKSONVILLE ASSOCIATES 13243 Westmeath Lane CLARKSONVILLE MD 21029		B 3 LOCATION OF WELL 8 COUNTY 21 23 SUBDIVISION 42 SECTION 44 46 LOT 15 48 50 CLARKSONVILLE 52 NEAREST TOWN 71 MILES FROM TOWN (enter 0 if in town) 2 73 76 77 78 MI	
DRILLER INFORMATION Driller's Name Paul M. Fabiszak 399 77 License No. 80 Firm Name G. Edgar Harr Sons' Corp. Address 12047 Falls Rd Cockeysville MD 21030 Signature <i>Paul M. Fabiszak</i> 3/1/93 Date		B 4 DIRECTION OF WELL FROM TOWN (CIRCLE BOX)  ON WHICH SIDE OF ROAD (CIRCLE APPROPRIATE BOX) NORTH WEST 32 EAST SOUTH 34 100 37 DISTANCE FROM ROAD ENTER FT or MI FT 38 39	
B 2 WELL INFORMATION APPROX. PUMPING RATE (GAL. PER MIN.) 2 8 12 AVERAGE DAILY QUANTITY NEEDED (GAL. PER DAY) 150 14 20		NOT TO BE FILLED IN BY DRILLER HEALTH DEPARTMENT APPROVAL HOWARD A 43089 COUNTY NAME COUNTY NO. STATE SIGNATURE DATE ISSUED INSERT S 090293 x Charles Zapp <i>10/1/93</i> 43 CO SIGNATURE 48 EXP. DATE NORTH GRID 501000 EAST GRID 0806000 50 55 57 63	
USE FOR WATER (CIRCLE APPROPRIATE BOX) ☒ D HOME (SINGLE OR DOUBLE HOUSEHOLD UNIT ONLY) ☐ F FARMING (LIVESTOCK WATERING & AGRICULTURAL IRRIGATION) ☐ I INDUSTRIAL, COMMERCIAL, STATE AND FEDERAL GOV. OTHER (REQUIRES APPROPRIATION PERMIT) ☐ P PUBLIC OR PRIVATE WATER COMPANY (REQUIRES APPROPRIATION PERMIT AND STATE HEALTH DEPARTMENT APPROVAL) ☐ T TEST, OBSERVATION, MONITORING (MAY REQUIRE APPROPRIATION PERMIT)		SHOW MAJOR FEATURES OF BOX & LOCATE WELL WITH AN X SOURCES OF DRILLING WATER 1. 2. 3. WRITE THE BOX NUMBER FROM THE MAP HERE E 800 N 500 000 000 (Tap on well)	
APPROXIMATE DEPTH OF WELL 200 24 28 FEET APPROXIMATE DIAMETER OF WELL 6 INCH NEAREST INCH		DRAW A SKETCH BELOW SHOWING LOCATION OF WELL IN RELATION TO NEARBY TOWNS AND ROADS AND GIVE DISTANCE FROM WELL TO NEAREST ROAD JUNCTION 	
METHOD OF DRILLING (circle one) BORED (or Augered) JETTED Jetted & DRIVEN 30 AIR-ROTARY 37 AIR-PERCussion ROTARY (Hydraulic Rotary) CABLE REVERSE-ROTARY Drive-POINT other		REPLACEMENT OR DEEPEMED WELLS (CIRCLE APPROPRIATE BOX) ☒ N THIS WELL WILL NOT REPLACE AN EXISTING WELL ☐ Y THIS WELL WILL REPLACE A WELL THAT WILL BE ABANDONED AND SEALED 39 ☐ S THIS WELL WILL REPLACE A WELL THAT WILL BE USED AS A STANDBY ☐ D THIS WELL WILL DEEPEN AN EXISTING WELL PERMIT NUMBER OF WELL TO BE REPLACED OR DEEPEMED (IF AVAILABLE) 41 52	
Not to be filled in by driller (OEP USE ONLY) APPROX. PERMIT NUMBER 54 GAP 63 FORCE 10 WRITE INITIALS IN BOX 67 68 PERMIT No. H0-94-0336 70 71 72 73 74 75 76 77 78 79		SPECIAL CONDITIONS <i>[Signature]</i>	

C1	7820	SEQUENCE NO. (DENV USE ONLY)	STATE OF MARYLAND WELL COMPLETION REPORT FILL IN THIS FORM COMPLETELY PLEASE PRINT OR TYPE		THIS REPORT MUST BE SUBMITTED WITHIN 45 DAYS AFTER WELL IS COMPLETED.		
					COUNTY NUMBER	A# 43089	
ST/CO USE ONLY DATE Received		DATE WELL COMPLETED		Depth of Well		PERMIT NO.	
[] [] [] [] [] [] [] []		[] [] [] [] [] [] [] []		[] [] [] [] [] [] [] []		FROM "PERMIT TO DRILL WELL"	
8 13		15 20		22 26		28 29 30 31 32 33 34 35 36 37	
		(TO NEAREST FOOT)					

OWNER CLARKSVILLE ASSOC.
STREET OR RFD last name RUSSELL BPP first name CLARKSVILLE
SUBDIVISION BRIERLY SECTION 15 LOT 15

WELL LOG			
Not required for driven wells			
STATE THE KIND OF FORMATIONS PENETRATED, THEIR COLOR, DEPTH, THICKNESS AND IF WATER BEARING			
DESCRIPTION (Use additional sheets if needed)	FEET		Check if water bearing
	FROM	TO	
Overburden	0	20	
Mud & Shale	20	82	
Gray Rock	82	300	X

GROUTING RECORD	
WELL HAS BEEN GROUTED (Circle Appropriate Box)	
TYPE OF GROUTING MATERIAL	
CEMENT <u>C</u>	BENTONITE CLAY <u>B</u>
NO. OF BAGS <u>31</u>	NO. OF POUNDS <u>3100</u>
GALLONS OF WATER <u>186</u>	
DEPTH OF GROUT SEAL (to nearest foot)	
from <u>0</u> ft.	to <u>85</u> ft.
(enter 0 if from surface)	
TOP 52 BOTTOM 58	
Casing types insert appropriate code below	
STEEL <u>ST</u> CONCRETE <u>CO</u>	
PLASTIC <u>PL</u> OTHER <u>OT</u>	
MAIN CASING TYPE	
Nominal diameter top (main) casing (nearest inch)	
Total depth of main casing (nearest foot)	
<u>ST</u> <u>6</u> <u>85</u>	
60 61 63 64 66 70	

OTHER CASING (if used)	
diameter inch	depth (feet) from to
[] []	[] [] [] []
[] []	[] [] [] []

SCREEN RECORD	
screen type or open hole	
insert appropriate code below	
STEEL <u>ST</u> BRASS <u>BR</u> OPEN HOLE <u>HO</u>	
BRONZE <u>PL</u> PLASTIC <u>OT</u>	
DEPTH (nearest ft.)	
<u>HO</u> <u>85</u> <u>300</u>	
8 9 11 15 17 21	
23 24 26 30 32 36	
38 39 41 45 47 51	
SLOT SIZE 1 2 3	
DIAMETER OF SCREEN (NEAREST INCH)	
[] [] [] [] [] []	
56 60	
from to	
GRAVEL PACK IF WELL DRILLED WAS FLOWING WELL INSERT F IN BOX 68	
[]	
68	

CIRCLE APPROPRIATE LETTER
A A WELL WAS ABANDONED AND SEALED WHEN THIS WELL WAS COMPLETED
E ELECTRIC LOG OBTAINED
P TEST WELL CONVERTED TO PRODUCTION WELL

I HEREBY CERTIFY THAT THIS WELL HAS BEEN CONSTRUCTED IN ACCORDANCE WITH COMAR 26.04.04 "WELL CONSTRUCTION" AND IN CONFORMANCE WITH ALL CONDITIONS STATED IN THE ABOVE CAPTIONED PERMIT, AND THAT THE INFORMATION PRESENTED HEREIN IS ACCURATE AND COMPLETE TO THE BEST OF MY KNOWLEDGE.

DRILLERS IDENT. NO. 399

DRILLERS SIGNATURE (MUST MATCH SIGNATURE ON APPLICATION)
Marty Dixon

SITE SUPERVISOR (sign. of driller or journeyman responsible for sitework if different from permittee)

OEP USE ONLY (NOT TO BE FILLED IN BY DRILLER)

T (E.R.O.S.) W Q

70 [] 72 [] 74 [] 75 [] 76 []

TELESCOPE CASING LOG INDICATOR OTHER DATA

PUMPING TEST		
HOURS PUMPED (nearest hour)	<u>3</u>	
PUMPING RATE (gal. per min. to nearest gal.)	<u>6</u>	
METHOD USED TO MEASURE PUMPING RATE	<u>Submersible</u>	
WATER LEVEL (distance from land surface)		
BEFORE PUMPING	<u>14</u>	
WHEN PUMPING	<u>238</u>	
TYPE OF PUMP USED (for test)		
<u>A</u> air	<u>P</u> piston	<u>T</u> turbine
<u>C</u> centrifugal	<u>R</u> rotary	<u>O</u> other (describe below)
<u>J</u> jet	<u>S</u> submersible	

PUMP INSTALLED	
DRILLER WILL INSTALL PUMP (CIRCLE) (YES OR NO)	YES <u>()</u> NO <u>()</u>
IF DRILLER INSTALLS PUMP, THIS SECTION MUST BE COMPLETED FOR ALL WELLS EXCEPT HOME USE	
TYPE OF PUMP INSTALLED	
PLACE (A,C,J,P,R,S,T,O) IN BOX - SEE ABOVE:	
CAPACITY: GALLONS PER MINUTE (to nearest gallon)	
PUMP HORSE POWER	
PUMP COLUMN LENGTH (nearest ft.)	
CASING HEIGHT (circle appropriate box and enter casing height)	
LAND SURFACE	
(nearest foot)	

LOCATION OF WELL ON LOT

SHOW PERMANENT STRUCTURE SUCH AS BUILDING, SEPTIC TANKS, AND/OR LANDMARKS AND INDICATE NOT LESS THAN TWO DISTANCES (MEASUREMENTS TO WELL)

Russell 2002 Drive

59'

60'

Property Line