

PERMIT

SEWAGE DISPOSAL SYSTEM

DEPARTMENT OF HEALTH AND MENTAL HYGIENE

P 50315B

A 43321

DISTRICT 4th

DATE 10/07/94

DATE SYSTEM APPROVED

INSPECTOR

HOWARD COUNTY HEALTH DEPARTMENT

BUREAU OF ENVIRONMENTAL HEALTH

X 313-2640

INDEXED

South Carroll Backhoe, Inc.

IS PERMITTED TO INSTALL ☒ ALTER

ADDRESS 4410 Salem Bottom Road, Westminster, Maryland 21157 PHONE 875-4197

SUBDIVISION Pleasant Hills LOT 1 ROAD 2023 Watkins Way

PROPERTY OWNER William Becraft

ADDRESS

SEPTIC TANK CAPACITY 1000 GALLONS

NUMBER OF BEDROOMS 3

240 SQUARE FEET PER BEDROOM

LINEAR FEET OF TRENCH REQUIRED 240

TRENCHES - Trench to be 3 feet wide. Inlet 3.5 feet below original grade. Bottom maximum depth 5.5 feet below original grade. Effective area begins at 3.5 feet below original grade. 2 feet of stone below distribution pipe.

LOCATION - Starting from the right front lot corner, place the distribution box 140 feet down the right lot line and 105 feet off this same lot line. Run trenches on contour in toward the front lot line while maintaining 100 feet from the well.

NOTES - No trench to exceed 100 feet in length. Provide 6" - 8" diameter cleanout and cap to grade or above on septic tank. OK 10/13/94 DKS

PLANS APPROVED BY Mark Rifkin

DATE 11/29/93

COVER NO WORK UNTIL INSPECTED AND APPROVED

NEITHER THE HOWARD COUNTY COUNCIL NOR THE HEALTH DEPARTMENT IS RESPONSIBLE FOR THE SUCCESSFUL OPERATION OF ANY SYSTEM

NOTE: CLEANOUT REQUIRED EVERY 70 FEET OF SEWER LINE AND/OR AT 90° SWEEPS IN LINES FROM HOUSE TO DRAIN FIELDS, 90° ELBOWS NOT ACCEPTABLE.

NOTE: ALL PARTS OF SEPTIC SYSTEMS (I.E. TANK, DISTRIBUTION BOX TRENCHES) TO BE 100 FEET FROM WELL (UNLESS OTHERWISE SPECIFICALLY AUTHORIZED)

NOTE: IF DEEP TRENCH(ES) ARE USED CALL FOR INSPECTION BEFORE AND AFTER PLACING GRAVEL IN TRENCH(ES)

NOTE: NO DRY WELL SHALL EXCEED 15 FOOT IN DIAMETER NO ABSORPTION TRENCH TO EXCEED 100 FEET IN LENGTH

NOTE: ALL PIPE FROM HOUSE TO SEPTIC TANK MUST BE CAST IRON OR SCHEDULE 35/40 PVC OR ABS

PERMIT VOID AFTER TWO YEARS

NOTE: INSTALL STAND PIPE ON SEPTIC TANK AND DRY WELL STAND PIPES MUST BE 6 INCHES IN DIAMETER CAST IRON, CONCRETE OR TERRA COTTA OR PVA OR ABS ACCEPTED. IF TOP OF SEPTIC TANK IS DEEPER THAN 3 FEET. MANHOLE TO GRADE REQUIRED.

NOTE: DISTRIBUTION BOXES MUST HAVE BAFFLES

***INSTALLER IS RESPONSIBLE FOR OBTAINING FINAL APPROVAL ON THIS PERMIT**BLDG. PERMIT SIGNED
AND RETURNED

Serial # 58439

Storage Shed

A 43321

APPLICATION

PERCOLATION TESTING

HOWARD COUNTY HEALTH DEPARTMENT
BUREAU OF ENVIRONMENTAL HEALTH
P.O. BOX 476 ELLICOTT CITY, MARYLAND 21043
TELEPHONE: 461-9933

A Repair

P 43321

DISTRICT 4TH

DATE 1-4-89

TO: THE COUNTY HEALTH OFFICER
ELLICOTT CITY, MARYLAND

I, HEREBY, APPLY FOR THE NECESSARY TEST IN ORDER TO CONSTRUCT (OR RECONSTRUCT) A SEWAGE DISPOSAL SYSTEM.

PROPERTY OWNER Netvon M. Watkins William Becraft

ADDRESS 26311 Howard Chapel Road PHONE 910-997-9331
Damascas, MD 20878 (301) 859-0563

PROSPECTIVE BUYER Standard Management Corporation

ADDRESS 10324-B Baltimore National Pike PHONE (301) 461-6777
Ellicott City, MD 21043

PROPERTY LOCATION:

SUBDIVISION Pleasant Hills LOT NO. LOT 1 ☒ EXISTING HOUSE

ROAD AND DESCRIPTION Off Long Corner Road (2023 Watkins Way)

TAX MAP 12 PARCEL # 5

SIZE OF LOT 4.0 Ac. TYPE BLDG. Single Family
(SINGLE FAMILY DWELLING OR COMMERCIAL)

THE SYSTEM INSTALLED UNDER THIS APPLICATION IS ACCEPTABLE ONLY UNTIL PUBLIC FACILITIES BECOME AVAILABLE. I FULLY UNDERSTAND THE
FEE CONNECTED WITH THE FILING OF THIS PERC TEST APPLICATION IS NON-REFUNDABLE UNDER ANY CIRCUMSTANCES. I ALSO AGREE TO COMPLY
WITH ALL M.O.S.H.A. REQUIREMENTS IN TESTING THIS LOT. Ferd K...

(SIGNATURE OF APPLICANT)

APPROVED BY _____ FOR _____ DATE _____

REJECTED BY _____ FOR _____ DATE _____

HOLD PENDING FURTHER TESTS _____ DATE _____

REASONS FOR REJECTION OR HOLDING 1-26-89 PERC SATISFACTORY - Hold for Subcl. Plat. Sale

BLDG. PERMIT SIGNED

AND RETURNED 8/17/94


Serial # 55679-SFD-3 Ben

THIS IS NOT A PERMIT

A-43321

SOIL PROFILE

0-6'	AP yellow Red silty clay w/m 10-20% Frnp
3-35'	yellow Bn silt sand w/m 20-40% Frnp
12'	

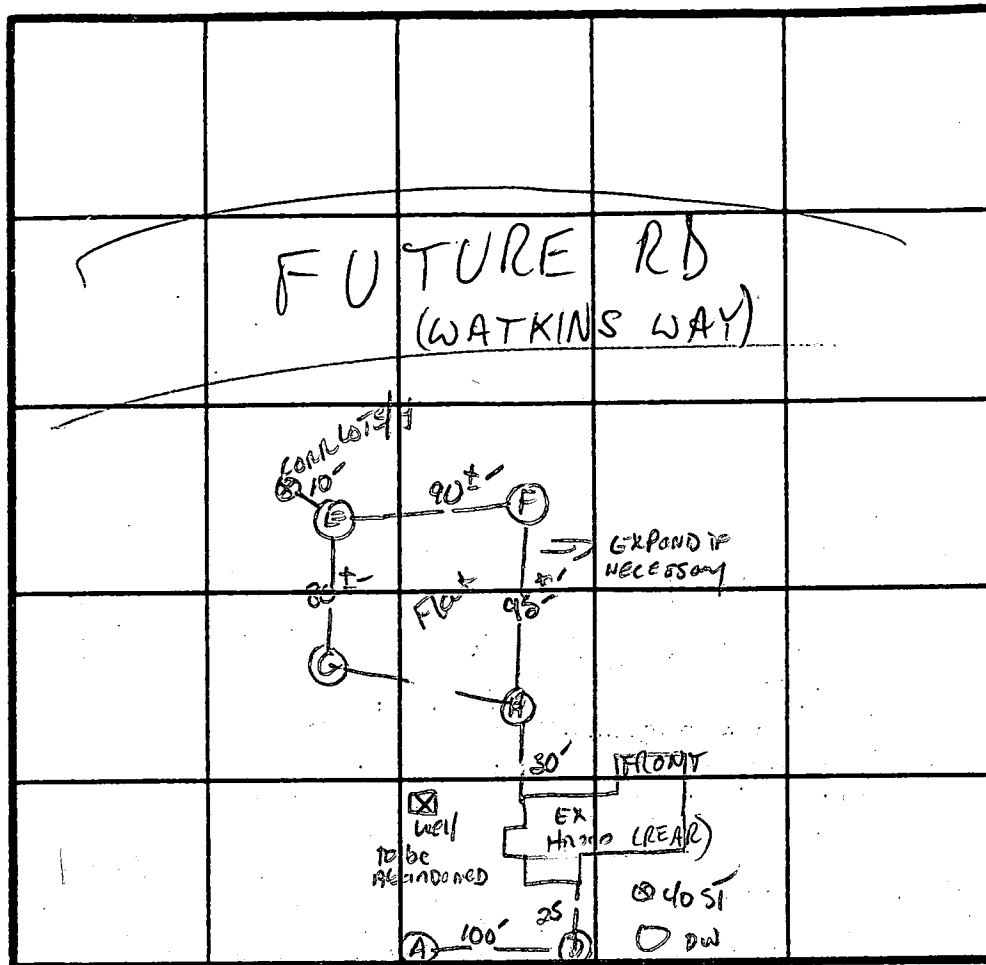

X PERC 19 MIN
240 # 1BR

INLET 3.5
BOTTOM 5.5

INDICATE NORTH - NAME ADJOINING ROADWAY AS BASE LINE.

LONG CORNER Rd.

DATE	TEST NO.	DEPTH	PRE-WET		TEST - 1" DROP		TIME
			START	STOP	START	STOP	
1/24/89	ES	3.5	11:49	11:50	11:50	11:53	3 MIN
	EV	11.5	95	As Profiled			
	FS	3.0	11:50	12:05	12:05	12:30	25 MIN
	FV	11.5	6	Similar to Profile			
	GS	3.5	11:51	11:57	11:57	12:10	13 MIN
	GV	12-		Similar to Profile			
	HS	3.0	11:59	12:10	12:10	12:40	30 MIN
	HM	7.0	11:57	12:08	12:08	12:30	22 MIN
	HV	13-		Similar to Profile			
	A-	STRUCTURED	AT 7.5"				
	B-	STRUCTURED	AT 7.5" Refusal AT 9"				
	C-	CLAY TO 6'					
	D-	STRUCTURED	Rock AT 8" Refusal AT 10"				

BEST TEST AT 3.5-4.0'

REMARKS A, B, D AS STAKED OTHERS DIFF - Shallow - Syst only Rock Found

TYPE OF SOIL Glenelg

TESTED BY S. Abel

ALSO PRESENT J. Fyork 3rd
Rock Miller

C 1 8782

SEQUENCE NO.
(DENY USE ONLY)STATE OF MARYLAND
WELL COMPLETION REPORT
FILL IN THIS FORM COMPLETELY
PLEASE PRINT OR TYPETHIS REPORT MUST BE SUBMITTED WITHIN
45 DAYS AFTER WELL IS COMPLETED.COUNTY
NUMBER A 43321ST/CO USE ONLY
DATE Received

DATE WELL COMPLETED

Depth of Well

PERMIT NO.
FROM "PERMIT TO DRILL WELL"

8 13

121393

22 400 26
(TO NEAREST FOOT)28 29 30 31 32 33 34 35 36 37
40-92-0493OWNER Zickie Robert
last name first name
STREET OR RFD WATKINS WAY TOWN MT. AIR
SUBDIVISION PLEASANT HILLS SECTION LOT 1

WELL LOG

Not required for driven wells

STATE THE KIND OF FORMATIONS
PENETRATED, THEIR COLOR, DEPTH,
THICKNESS AND IF WATER BEARINGDESCRIPTION (Use
additional sheets if needed)FEET
FROM TOCheck
if water
bearing

Grain
Green Shell

0 45
45 400

✓

GROUTING RECORD

WELL HAS BEEN GROUTED
(Circle Appropriate Box)yes no
Y N
44 44

TYPE OF GROUTING MATERIAL

CEMENT CM BENTONITE CLAY BC

NO. OF BAGS 15 NO. OF POUNDS 1410

GALLONS OF WATER 105

DEPTH OF GROUT SEAL (to nearest foot)

from 0 ft. to 63 ft.
(enter 0 if from surface)

CASING RECORD

casing
types
insert
appropriate
code
belowST CO
STEEL CONCRETE
PL OT
PLASTIC OTHERMAIN
CASING
TYPENominal diameter
top (main) casing
(nearest inch)Total depth
of main casing
(nearest foot)

60 61 63 64 66 67 68 69 70

E
A
C
H
C
A
S
I
N
G

OTHER CASING (if used)

diameter depth (feet)
inch from to

60 61 63 64 66 67 68 69 70

screen type
or open hole
insert
appropriate
code
below

SCREEN RECORD

ST BR HO
STEEL BRASS OPEN
BRONZE HOLE
PL OT
PLASTIC OTHERC 2
E
A
C
H
S
C
R
E
E
N

DEPTH (nearest ft.)

1 HO 43 400
8 9 11 15 17 21
2 23 24 26 30 32 36
3 38 39 41 45 47 51

SLOT SIZE 1 2 3

DIAMETER OF SCREEN (NEAREST INCH)

from to

GRAVEL PACK

IF WELL DRILLED WAS
FLOWING WELL INSERT
F. IN BOX 68.DRILLERS IDENT. NO. 101
DRILLERS SIGNATURE
(MUST MATCH SIGNATURE ON APPLICATION)SITE SUPERVISOR (sign of driller or journeyman
responsible for sitework if different from permittee)TELESCOPE
CASINGLOG
INDICATOR

OTHER DATA

C 3

PUMPING TEST

HOURS PUMPED (nearest hour)

PUMPING RATE (gal. per min.
to nearest gal.)METHOD USED TO
MEASURE PUMPING RATE

WATER LEVEL (distance from land surface)

BEFORE PUMPING

WHEN PUMPING

TYPE OF PUMP USED (for test)

A air P piston T turbine
C centrifugal R rotary O other
J jet S submersible
(describe below)

PUMP INSTALLED

DRILLER WILL INSTALL PUMP YES NO

(CIRCLE) (YES or NO)

IF DRILLER INSTALLS PUMP, THIS SECTION

MUST BE COMPLETED FOR ALL WELLS

EXCEPT HOME USE

TYPE OF PUMP INSTALLED

PLACE (A,C,J,P,R,S,T,O)

IN BOX - SEE ABOVE:

CAPACITY:

GALLONS PER MINUTE

(to nearest gallon)

PUMP HORSE POWER

PUMP COLUMN LENGTH

(nearest ft.)

CASING HEIGHT (circle appropriate box

and enter casing height)

LAND SURFACE

(nearest foot)

LOCATION OF WELL ON LOT

SHOW PERMANENT STRUCTURE SUCH AS
BUILDING, SEPTIC TANKS, AND/OR
LANDMARKS AND INDICATE NOT LESS
THAN TWO DISTANCES
(MEASUREMENTS TO WELL)

B 1 02928 (THIS NUMBER IS TO BE PUNCHED IN COLS. 3-6 ON ALL CARDS)	SEQUENCE NO. (DP USE ONLY)	STATE OF MARYLAND PERMIT TO DRILL WELL please print or type	STATE PERMIT NUMBER 40-92-0493 fill in this form completely
OWNER INFORMATION Date Received (APA) 101993 ZIRKLE Robert 5300 West View Dr Enderick Md 21701		B 3 LOCATION OF WELL Howard Pleasant Hills SECTION 44 46 LOT 48 50 52 NEAREST TOWN MILES FROM TOWN (enter 0 if in town) 4 MI	
DRILLER INFORMATION LEO R. Holland The A. H. Drilling Company 7524 Shoppers Pk. Bonnersburg, Mo. Leo R. Holland Jr 10-13-93		B 4 DIRECTION OF WELL FROM TOWN (CIRCLE BOX) 	
B 2 WELL INFORMATION APPROX. PUMPING RATE (GAL. PER MIN.) 10 AVERAGE DAILY QUANTITY NEEDED (GAL. PER DAY) 200		LOCATION OF WELL WATKINS WAY NEAR WHAT ROAD ON WHICH SIDE OF ROAD (CIRCLE APPROPRIATE BOX) NORTH WEST EAST SOUTH DISTANCE FROM ROAD 125 FT ENTER FT OR MI FT	
USE FOR WATER (CIRCLE APPROPRIATE BOX) ☒ HOME (SINGLE OR DOUBLE HOUSEHOLD UNIT ONLY) ☐ FARMING (LIVESTOCK WATERING & AGRICULTURAL IRRIGATION) ☐ INDUSTRIAL, COMMERCIAL, STATE AND FEDERAL GOV. OTHER (REQUIRES APPROPRIATION PERMIT) ☐ PUBLIC OR PRIVATE WATER COMPANY (REQUIRES APPROPRIATION PERMIT AND STATE HEALTH DEPARTMENT APPROVAL) ☐ TEST, OBSERVATION, MONITORING (MAY REQUIRE APPROPRIATION PERMIT)		NOT TO BE FILLED IN BY DRILLER HEALTH DEPARTMENT APPROVAL Howard COUNTY NAME STATE SIGNATURE Mark E. Riffin 11/24/94 DATE ISSUED CO SIGNATURE NORTH GRID 539000 EAST GRID 0755000 50 55 57 63	
APPROXIMATE DEPTH OF WELL 200 FEET APPROXIMATE DIAMETER OF WELL 6 INCH NEAREST INCH		SHOW MAJOR FEATURES OF BOX & LOCATE WELL WITH AN X SOURCES OF DRILLING WATER 1. Well 2. 3. WRITE THE BOX NUMBER FROM THE MAP HERE E 755 N 539 000 000	
METHOD OF DRILLING (circle one) BORED (or Augered) JETTED Jettied & DRIVEN AIR-ROTARY AIR-PERCussion ROTARY (Hydraulic Rotary) CABLE REVERSE-ROTARY DRIVE-POINT other		REPLACEMENT OR DEEPEINED WELLS (CIRCLE APPROPRIATE BOX) ☒ THIS WELL WILL NOT REPLACE AN EXISTING WELL ☐ THIS WELL WILL REPLACE A WELL THAT WILL BE ABANDONED AND SEALED ☐ THIS WELL WILL REPLACE A WELL THAT WILL BE USED AS A STANDBY ☐ THIS WELL WILL DEEPEIN AN EXISTING WELL PERMIT NUMBER OF WELL TO BE REPLACED OR DEEPEINED (IF AVAILABLE) Not to be filled in by driller (OEP USE ONLY) APPROP. PERMIT NUMBER GAP FORCE MK WRITE INITIALS IN BOX PERMIT No. 40-92-0493 67 68 70 71 72 73 74 75 76 77 78 79	
SPECIAL CONDITIONS "Note - well is near building at top of hill." COUNTY 6 Cbs			

12/13/93 @ 10 AM per well puller

15' Bags of cement

63' of casing

62' of open ground

1' of casing above ground C.B.D.

Long corner Watkins way

23001 to 2311:23

11-7-94
WPE am

HOWARD COUNTY HEALTH DEPARTMENT
Bureau of Environmental Health
3525-H Ellicott Mills Drive
Ellicott City, MD 21043
461-9933

OK 11/7/94
C.B.C.
FINAL

APPLICATION FOR PITLESS ADAPTER, WELL PUMP AND PRESSURE TANK INSTALLATION

New Installation ☒
Replacement ☐

Receipt #

Date

Name of Installer

Telephone

License Number

Certified Well Pump Installer

Well Driller

Registered Plumber

Name of Property Owner

Telephone

Subdivision

Lot #

Well Tag #

Site Address

Pump

1. Type

a. Deep well jet

b. Shallow well jet

c. Submersible

2. Make

3. Model #

4. Capacity

GPM

5. Pump exceeds well capacity

Yes

No

6. If Yes, is low pressure cutoff switch installed?

Yes

No

7. What methods are used to protect the pump and electrical wiring from vibrations?

Torque arrestors

Cable guards

Other

Motor

1. Horsepower

2. RPM

3. Voltage

a. 110

b. 220

Pitless Adapter

1. Make

2. Model #

3. Depth

Tank

1. Capacity

2. Pressure relief

valve?

Piping

1. Type

2. Size

3. NSF and/or BOCA

Code approved

4. Depth of supply

line

Well data

1. Depth

2. Yield

3. Static water

level

4. Will water supply

be disinfected by

installer?

I understand that it is my responsibility to notify the Howard County Health Department when the installation is ready for inspection (otherwise this permit is null and void).

All information given above is true to the best of my knowledge.

Signature of Applicant:

Date:

Note: A sticker indicating approval/status of the installation will be placed on the well casing at the time of the inspection.

Septic Abandonment

SITE INSPECTION SHEET

OWNER: _____

DATE REQUESTED: 8/25/94

ADDRESS: Pleasant Hills lot 1

DRILLER: _____


Watkins way

WELL TAG # HO-92-0493

COUNTY # Howard

PROPOSAL: _____

LOCATION DIAGRAM

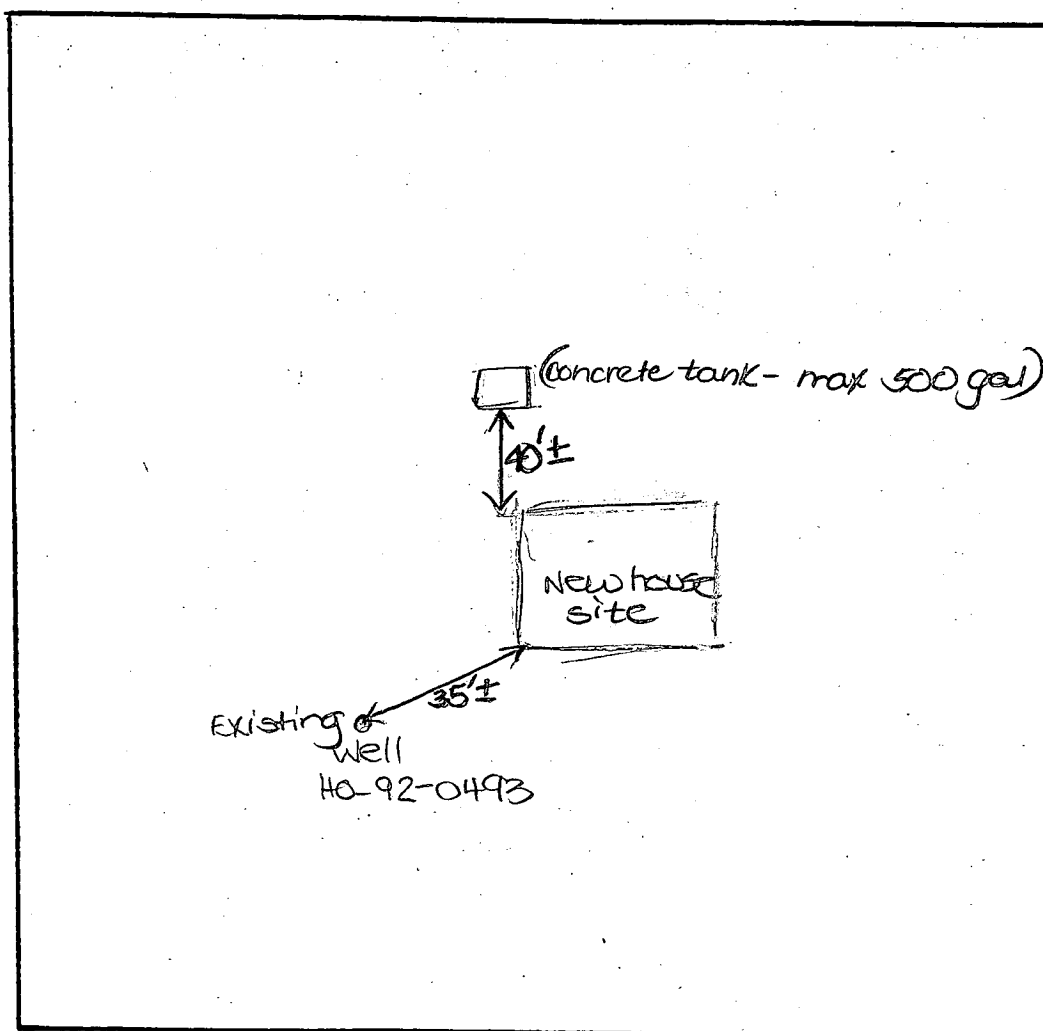

COMMENTS: Watkins way

8/25/94 ~11:30 a.m. Septic tank seen and filled.

DATE: 8/25/94

INSPECTOR: [Signature]

MARYLAND DEPARTMENT OF THE ENVIRONMENT, WATER MANAGEMENT ADMINISTRATION
2500 BROENING HIGHWAY, BALTIMORE, MARYLAND 21224, (410) 631-3784

WATER WELL ABANDONMENT-SEALING REPORT FORM

SUBMIT COPIES OF COMPLETED FORM TO:

- * COUNTY ENVIRONMENT AGENCY (contact MDE, WMA if address needed)
- * WELL OWNER
- * MDE, WATER MANAGEMENT ADMINISTRATION, WELL PROGRAM

DATE WELL ABANDONED: 8-16-94 (month/day/year)

* PERMIT NUMBER OF ABANDONED WELL (if any) NONE

* PERMIT NUMBER OF REPLACEMENT WELL 1

* PERSON ABANDONING WELL: DAVID SWANN

* OWNER'S NAME: William Beecraft

* WELL LOCATION:

COUNTY: Howard
NEAREST TOWN: Mt. Airy
TAX MAP 12 BLOCK PARCEL 5
SUBDIVISION: PLEASANT HILLS
SECTION: LOT: 1

MARYLAND GRID COORDINATES

BOX NUMBER E 755
N 539

* TYPE OF WELL BEING ABANDONED:

DRILLED JETTED
BORED/AUGURED X HAND DUG
OTHER (specify)

* USE CODE:

X DOMESTIC MUNICIPAL/PUBLIC
IRRIGATION INDUSTRIAL
TEST/OBSERVATION

* TYPE OF CASING:

STEEL PLASTIC
CONCRETE X OTHER (specify)
Ferrallotta

* SIZE OF CASING: 8 INCHES IN DIAMETER

* DEPTH OF WELL: UNKNOWN FEET DEEP EST 50'

* WAS ANY CASING REMOVED? YES X NO
if yes, length removed, in feet:

* WAS CASING RIPPED OR PERFORATED? YES X NO

SIGNATURE: (Signature) (observed after completion)
MASTER WELL DRILLER OR SUPERVISING SANITARIAN

DENV 828 JULY 1993

--	--	--	--	--	--	--	--	--	--

H	0	-	9	2	-	0	4	9	3
---	---	---	---	---	---	---	---	---	---

WELL DRILLERS LICENSE NUMBER:

<u>X</u>	
000	
000	


SHOW WELL LOCATION
BY X WITHIN BOX

LOG OF SEALING MATERIAL


MATERIAL	FEET	
	FROM	TO
3/4" STONE	50	13
Concrete	13	3
Dirt	3	0

DATE: 8/16/94

LICENSE #

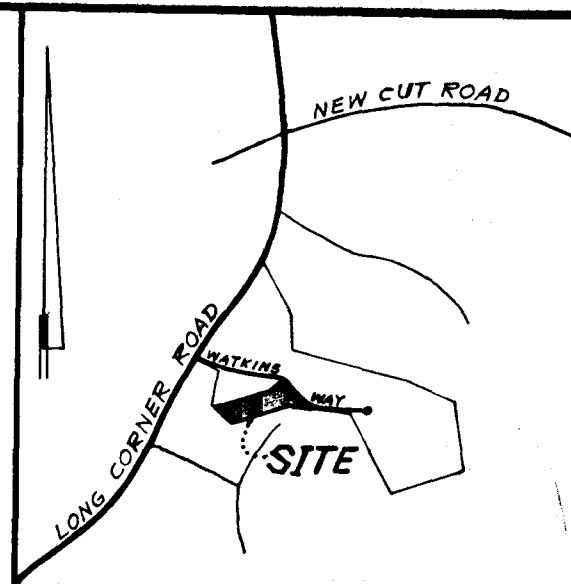

VICINITY MAP
SCALE 1"=2000'

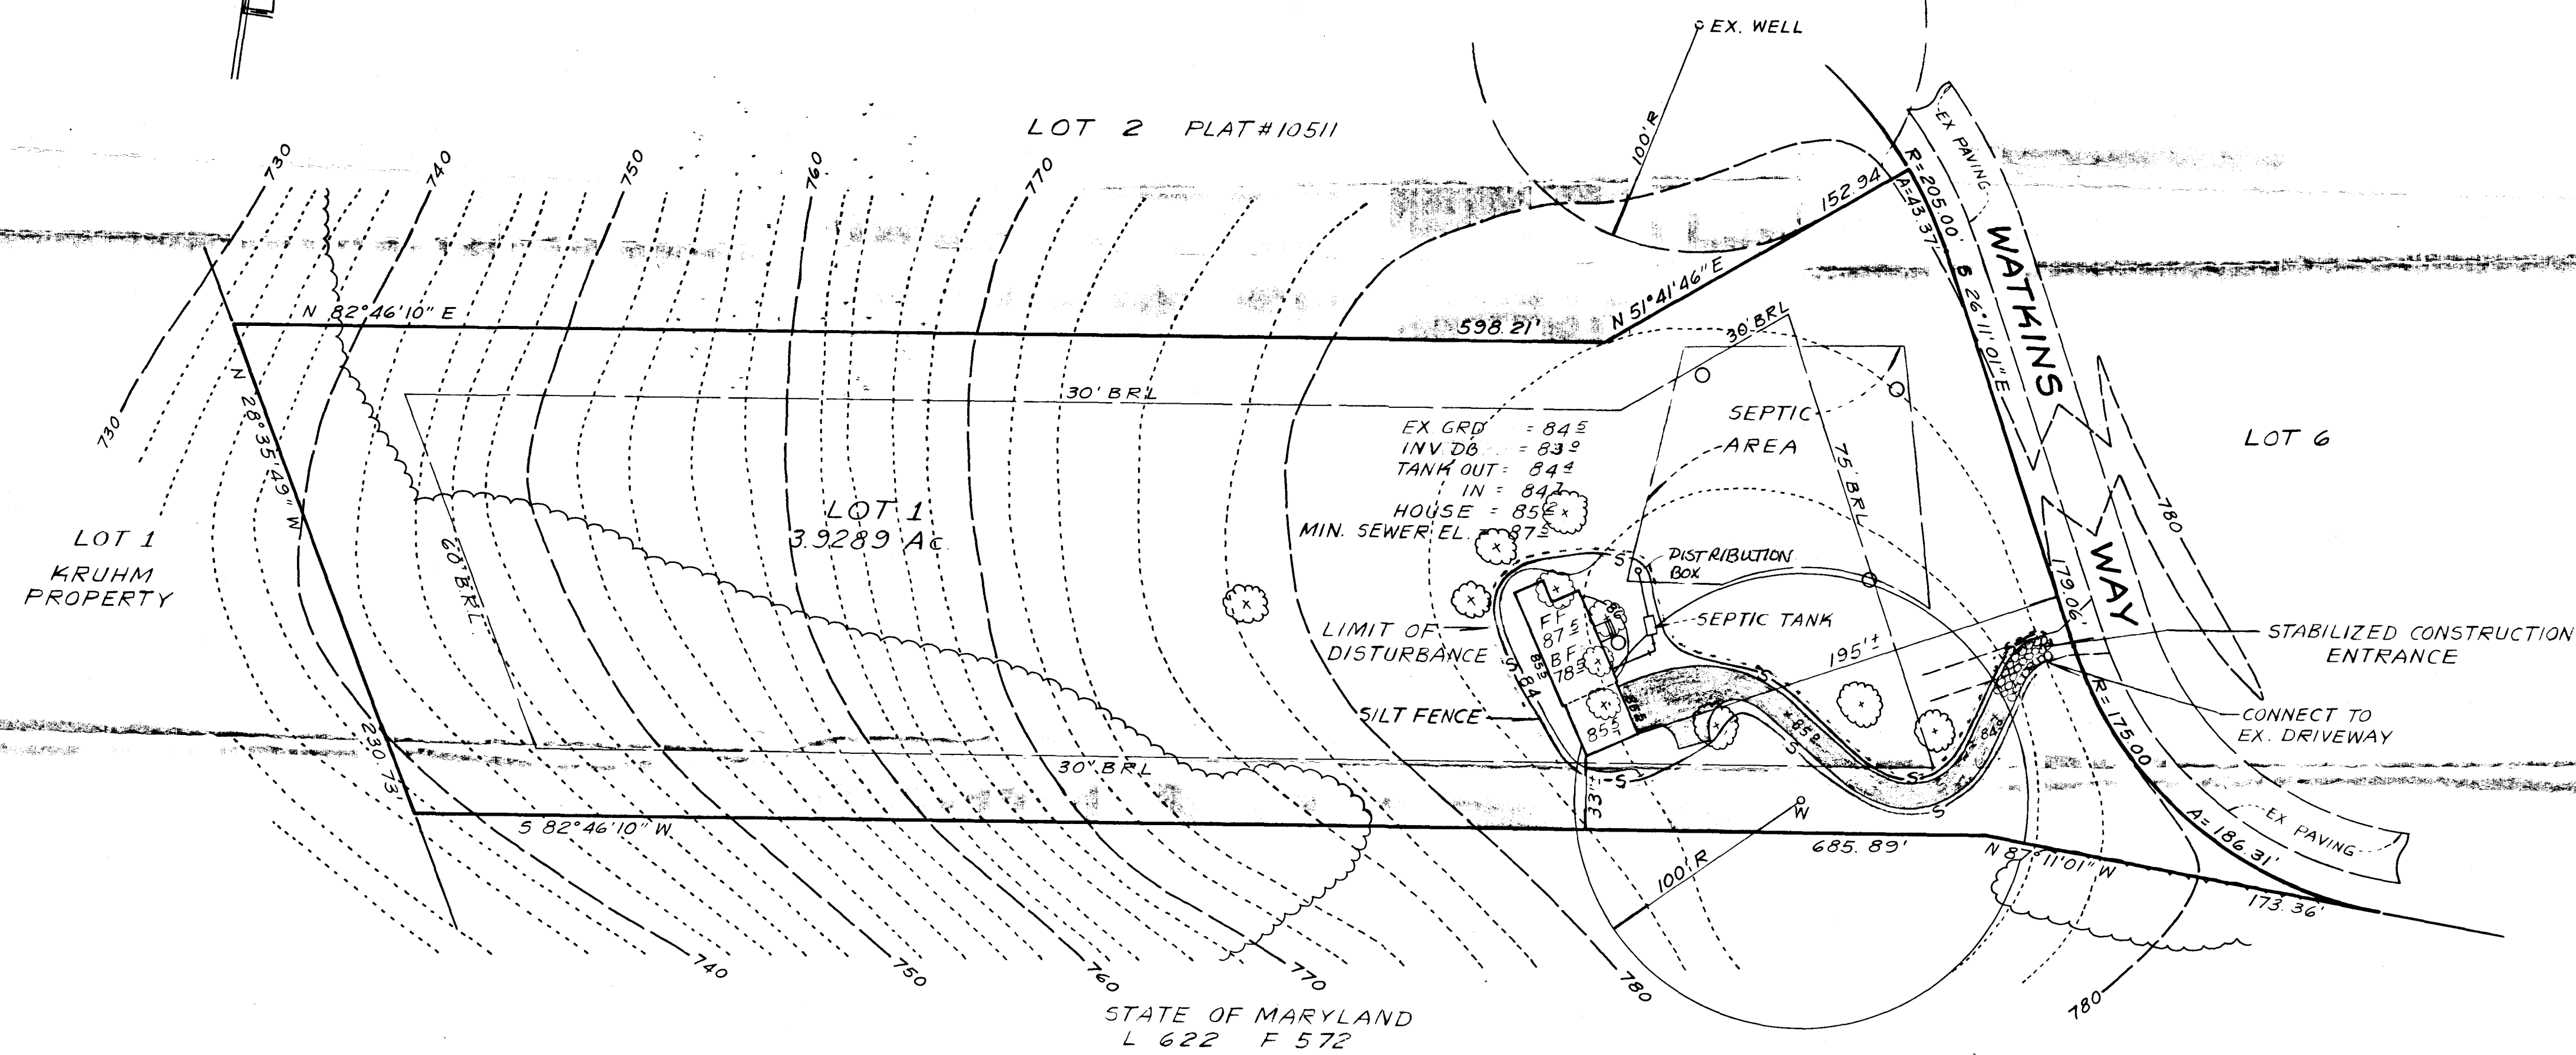

- Minimum 18" cover
- Existing septic must be abandoned prior to septic permit issuance.
- Septic tank must be placed a minimum of 25' off of existing well location.

Approved Septic System Plan
Howard County Health Department

Signature: *[Signature]* Date: 8/17/94

ALL WELL AND SEPTIC SYSTEMS
WITHIN 100' OF THIS PROPERTY
ARE SHOWN ON THIS PLAN.

SURVEYOR'S CERTIFICATE

I HEREBY CERTIFY THAT TO THE BEST OF MY
KNOWLEDGE AND BELIEF, THAT THE INFORMATION
SHOWN HEREON IS CORRECT.

[Signature] 6/28/94
JEFFERSON D. LAWRENCE
PROFESSIONAL LAND SURVEYOR
MARYLAND REGISTRATION 5216


APPROVED FOR PRIVATE WATER AND
PROVATE SEWAGE SYSTEMS.
HOWARD COUNTY HEALTH DEPARTMENT

DATE _____


HOWARD COUNTY HEALTH OFFICER

SITE DEVELOPMENT PLAN LOT 1			
PLEASANT HILLS 4TH ELECTION DISTRICT HOWARD COUNTY, MARYLAND			
PLAT No. 10511			
O'CONNELL & LAWRENCE INC. 17904 GEORGIA AVENUE SUITE OLNEY MARYLAND 20832 301-924-4570 FAX 301-924-5872		DESIGNER W. H. A.	SHEET 1
		DRAWN E.F.M.	DATE JUNE, 94
		SCALE 1"=50'	JOB No. 22-16

SEE APPROVED PRELIMINARY PLAN No. 89-65 FOR SEPTIC INFORMATION

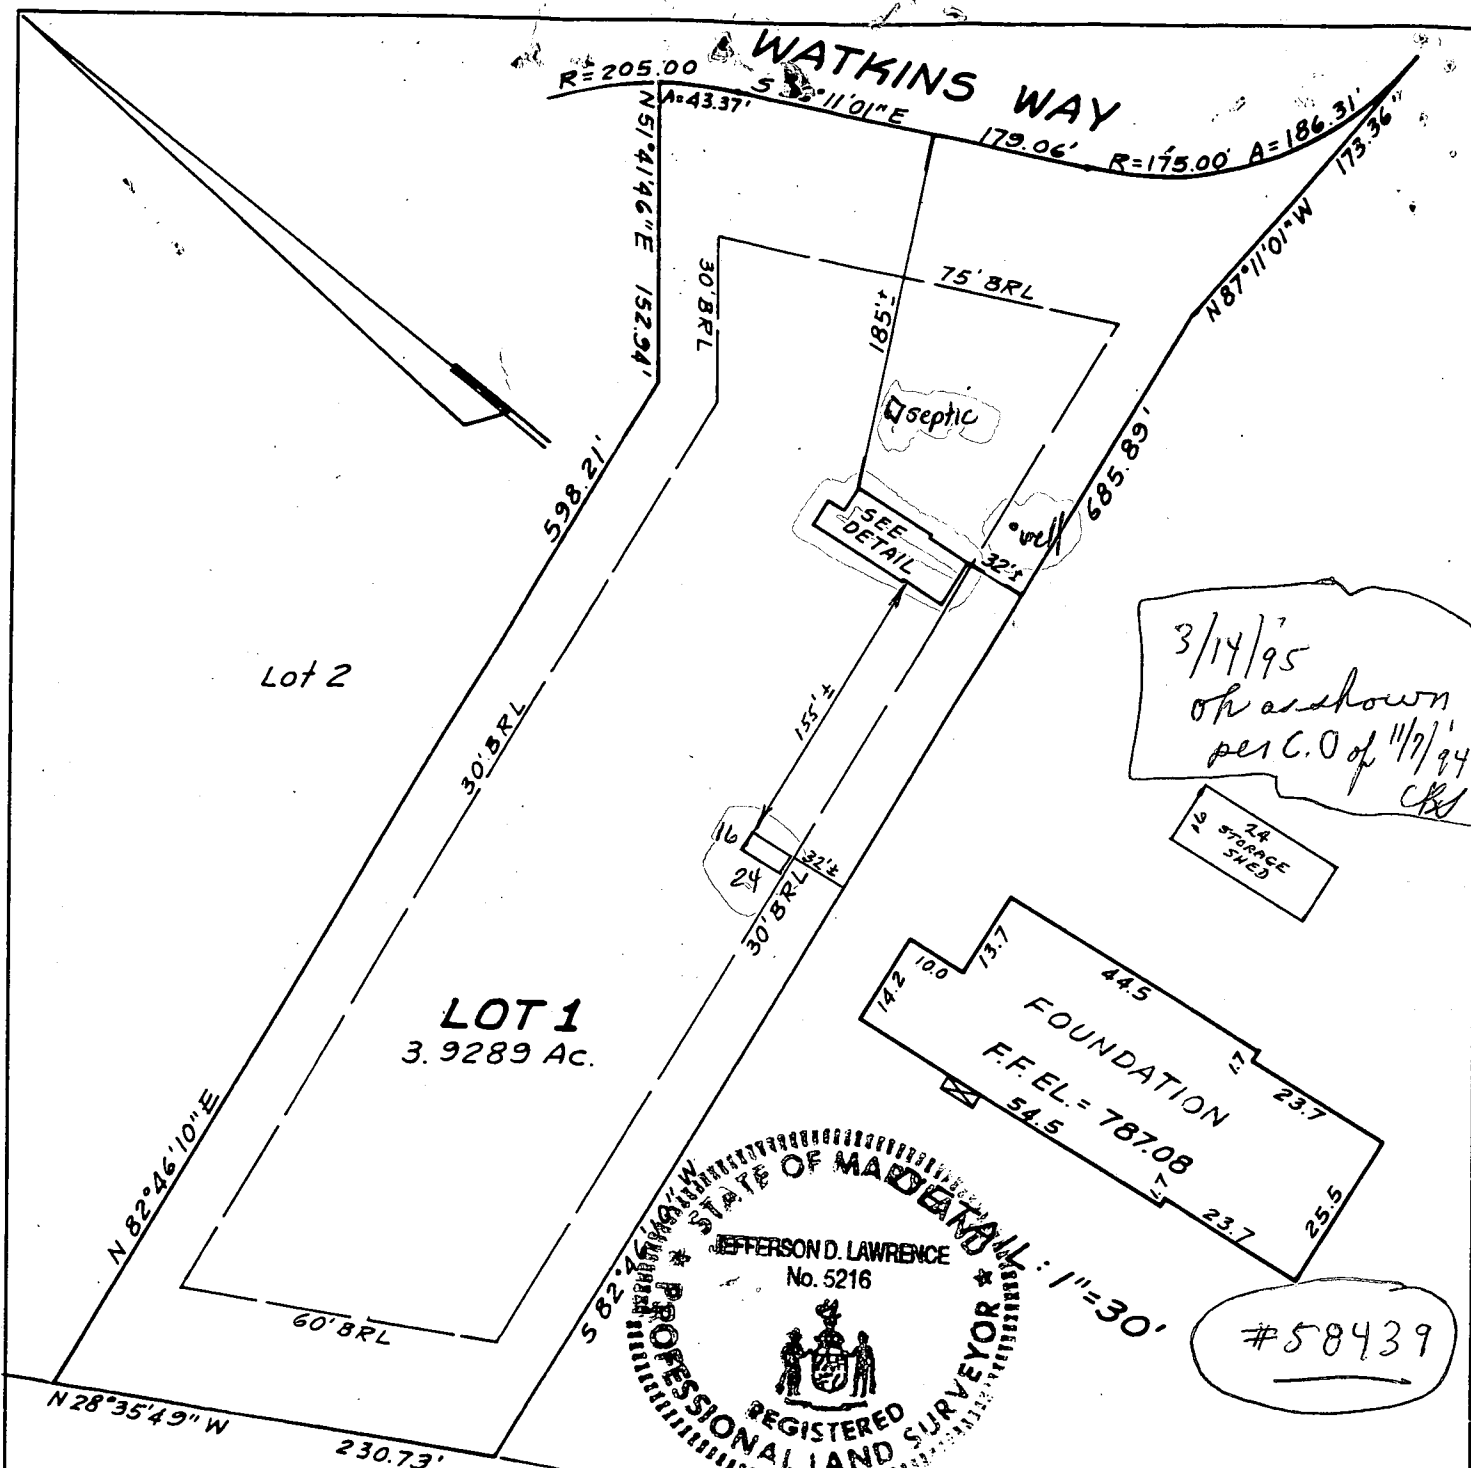

Property shown hereon is not in a flood plain per existing records unless otherwise noted.

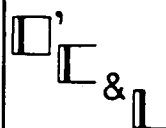

O'CONNELL & LAWRENCE, INC.
SURVEYORS, ENGINEERS & LAND PLANNERS

17904 Georgia Avenue, Suite 302
Olney Maryland 20832
(310) 924-4570 Fax (301) 924-5872

HOUSE LOCATION

LOT 1

PLEASANT HILLS
HOWARD COUNTY, MARYLAND
TAX MAP: 6 & 12 - PLAT # 10511

SURVEYOR'S CERTIFICATION

I hereby certify to the best of my knowledge and belief that the property delineated hereon is in accordance with the Plat of Subdivision and/or deed of record, that the improvements were located by accepted field practices and include permanent visible structure and encroachments, if any. This Plat is not for determining property lines, but prepared for the exclusive use of present owners of property and also those who purchase, mortgage, or guarantee the title thereto, within six months from the date hereof, and as to them I warrant the accuracy of this Plat. No title report furnished.

NOTE: EXISTENCE OF PROPERTY CORNERS NOT GUARANTEED BY THIS PLAT. DO NOT ATTEMPT TO ERECT FENCES FROM INFORMATION CONTAINED ON THIS DRAWING.

Jefferson D. Lawrence
Md. Reg. Professional Land Surveyor - Jefferson D. Lawrence

Job No	22-16
Scale	1" = 100'
DATES	
Wall Ck	9-14-94
Final Loc	
Recert	

CONSUMER INFORMATION NOTES:

1. This plan is a benefit to a consumer insofar as it is required by a lender or a title insurance company or its agent in connection with contemplated transfer, financing or re-financing.
2. This plan is not to be relied upon for the establishment or location of fences, garages, buildings, or other existing or future improvements.
3. This plan does not provide for the accurate identification of property boundary lines, but such identification may not be required for the transfer of title or securing financing or re-financing.
4. Building line and/or Flood Zone information is taken from available sources and is subject to interpretation of originator.

Notes:


- 1) Flood zone "C" per H.U.D. panel No. 240044-0008 B
- 2) Setback distances as shown to the principal structure from property lines are approximate. The level of accuracy for this drawing should be taken to be no greater than plus or minus 5 Feet.

STATE OF
MARYLAND
L.622 F.572

LOT 1
KRUHM PROPERTY

LOT 1
3.9289 AC.

LOT 2

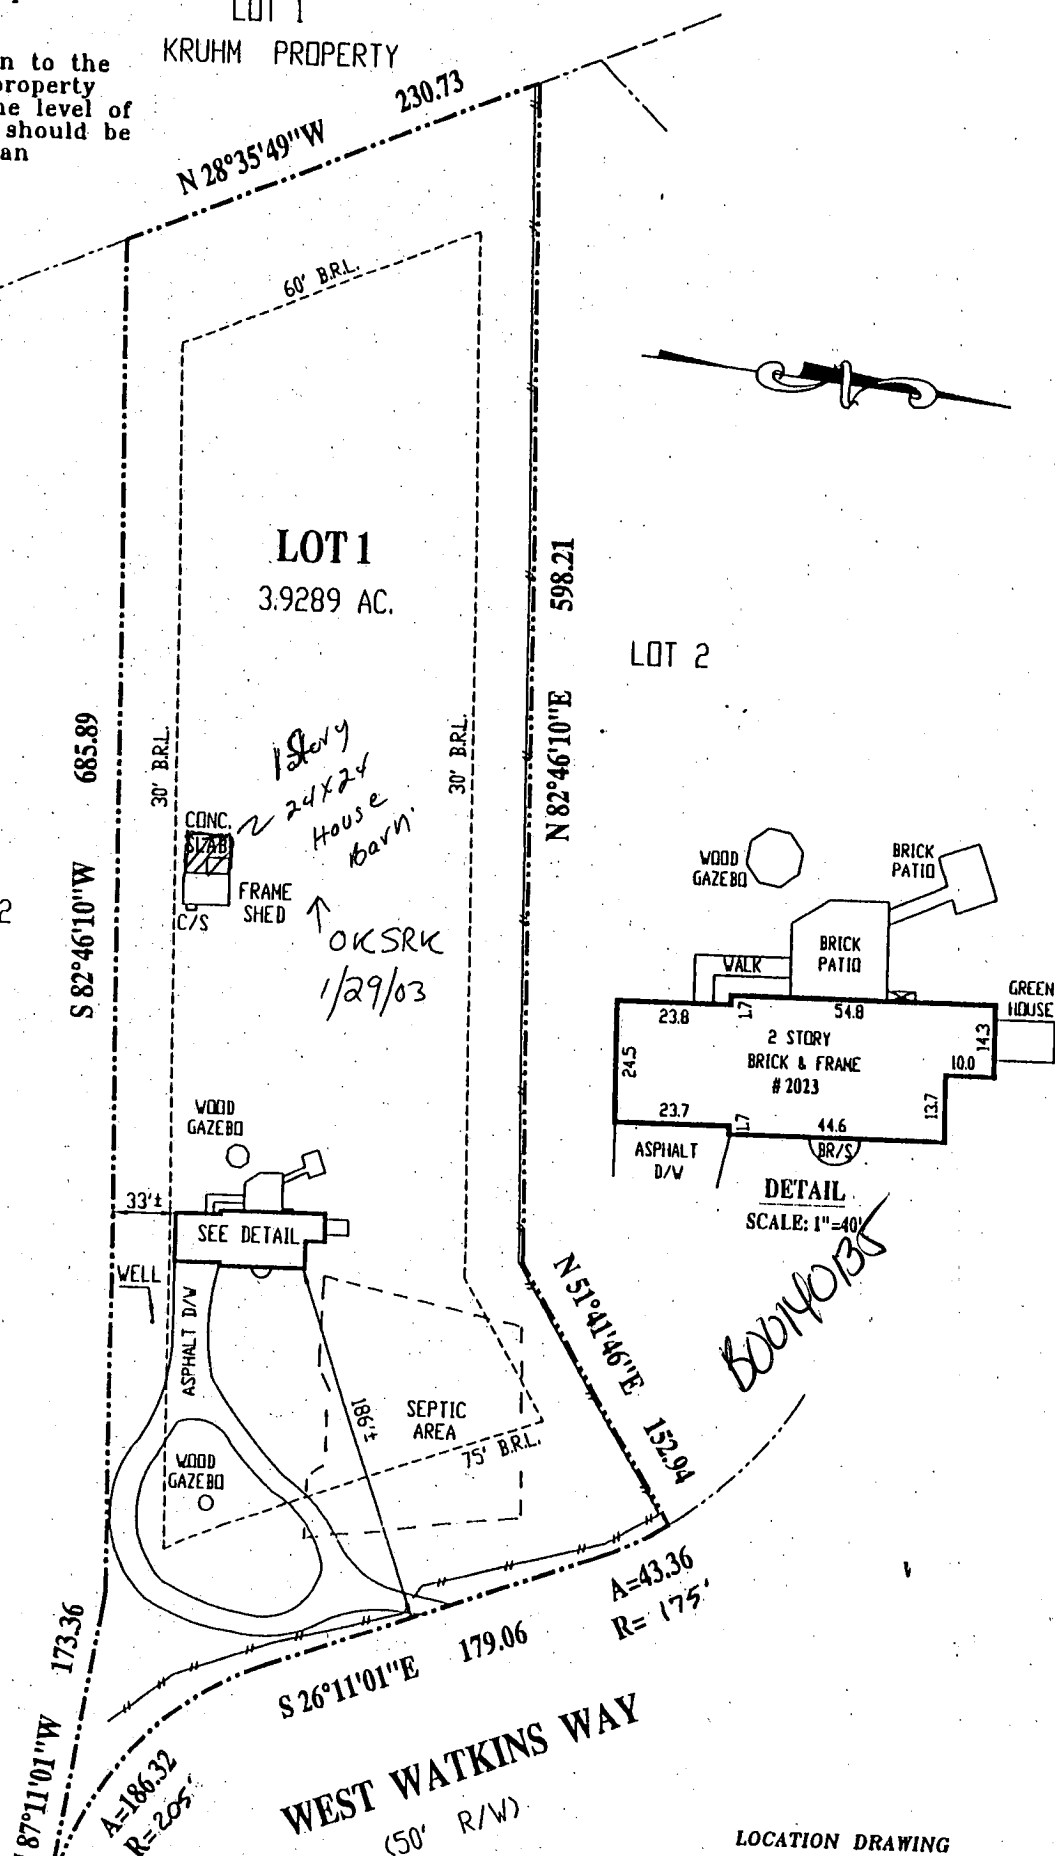

WEST WATKINS WAY
(50' R/W)

LOCATION DRAWING

LOT 1

PLEASANT HILLS

HOWARD COUNTY, MARYLAND

SURVEYOR'S CERTIFICATE

"THE INFORMATION SHOWN HEREON HAS BEEN BASED UPON THE RESULTS OF A FIELD INSPECTION PURSUANT TO THE DEED OR PLAT OF RECORD. EXISTING STRUCTURES SHOWN HAVE BEEN FIELD LOCATED BASED UPON MEASUREMENTS FROM PROPERTY MARKERS FOUND OR FROM EVIDENCE OF LINES OF APPARENT OCCUPATION."

Jeffrey A. Foster
MARYLAND PROPERTY LINE SURVEYOR REG. NO. 587

REFERENCES

PLAT BK.
PLAT NO. 10511

LIBER
FOLIO



SNIDER & ASSOCIATES
SURVEYORS - ENGINEERS
LAND PLANNING CONSULTANTS
2 Professional Drive, Suite 218
Gaithersburg, Maryland 20879
301/948-5100, Fax 301/948-1288

DATE OF LOCATIONS

WALL CHECK:

HSE. LOC.: 11-28-02

SCALE: 1" = 120'

DRAWN BY: E.M.G.

JOB NO.: 2002-7452